


# COLLEGE OF SAN MATEO BUILDING 5N

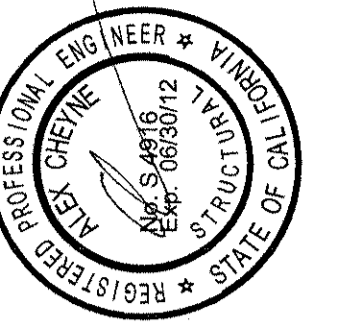


REVISION	DATE	DATE
1	10/09/08	
2	5/05/08	
3		
4		
### ABBREVIATIONS FOR LIGHT GAUGE GENERAL NOTES

- AD. - ARCHITECTURAL DRAWINGS
- ADDL. - ADDITIONAL
- ALT. - ALTERNATE
- BM - BEAM
- B.O. - BOTTOM OF
- BLDG - BUILDING
- BLKG - BLOCKING
- BTWN - BETWEEN
- CL OR CLR - CLEAR
- CLG - CEILING
- COL - COLUMN
- CONC. - CONCRETE
- CONN. - CONNECTION
- CONT. - CONTINUOUS
- CRC - COLD ROLLED CHANNEL
- C/W - CURTAINWALL
- DBL. - DOUBLE
- DEFL. - DEFLECTION
- DIAG. - DIAGONAL
- DM - DIMENSION
- DIV ANG OR DA - DIVERTER ANGLE
- DLY - DEEP LEG TRACK
- DWG - DRAWING
- EA - EACH
- ED. - EDGE DISTANCE
- EL OR ELEV. - ELEVATION
- EX. - EXISTING
- EOD. - EDGE OF DECK
- EOB. - EDGE OF SLAB
- EQ - EQUAL
- FO. - FACE OF
- FLG - FLANGE
- FLR. - FLOOR
- FS. - FAR SIDE
- GA - GAUGE
- G.C. - GENERAL CONTRACTOR
- HDR - HEADER
- HGT. - HEIGHT
- HORIZ OR HOR. - HORIZONTAL
- H86 - HOLLOW STRUCTURAL SECTION
- HWC - HIGH WIND CORNER PER UBC AREA
- EXTENDING FROM BUILDING CORNERS 10 FEET
- OR 2 TIMES THE LEAST WIDTH OF THE
- BUILDING, WHICHEVER IS LESS.
- I.L.O. - IN LINE OF
- INV. - INVERTED
- JT. - JOINT
- LG. - LONG
- LOCN. - LOCATION
- LLH - LONG LEG HORIZONTAL
- LLV - LONG LEG VERTICAL
- LVF. - LOW VELOCITY FASTENER (SEE GENERAL
- NOTES FOR SIZE & TYPE).
- LVL. - LEVEL
- LWC - LIGHT WEIGHT CONCRETE
- MAX. - MAXIMUM
- MFG. - MANUFACTURER
- MIN. - MINIMUM
- (N) - NEW
- NBD. - NOT BY DEVCO
- NTS. - NOT TO SCALE
- N/A - NOT APPLICABLE
- NS. - NEAR SIDE
- NWC - NORMAL WEIGHT CONCRETE
- O.C. - ON CENTER
- OH. - OPPOSITE HAND
- OHD. - OVERHEAD DOOR
- OPNG. - OPENING
- OJJ. - OPEN WEB JOIST
- PC. - PIECE
- PERP. - PERPENDICULAR
- PT. - POINT
- REINF. - REINFORCING
- REF. - REFERENCE
- REQ'D. - REQUIRED
- RFI. - REQUEST FOR INFORMATION
- R.O. - ROUGH OPENING
- SD. - STRUCTURAL DRAWINGS
- SECT. - SECTION
- SIM. - SIMILAR
- SPLC BRK. - SPECIAL BRAKE
- SQ. - SQUARE
- ST. - STEEL
- SU. - SHEARWALL
- T/B. - TOP & BOTTOM
- T.O. - TOP OF
- T.S. - TUBE STEEL
- TYP. - TYPICAL
- UNO. - UNLESS NOTED OTHERWISE
- VERT. - VERTICAL
- WB. - WEDGE BOLT
- WDU. - WINDOW
- WF. - WIDE FLANGE
- W. - WITH
- W/N. - WITHIN
- W/O. - WITHOUT
- W.P. - WORK POINT


### COLD FORMED STEEL GENERAL NOTES

- DESIGN CRITERIA  
WIND 85 MPH EXP. C I=115  
SEISMIC ZONE: S<sub>1</sub>-ZII, SITE CLASS B, I=10  
IBC 2006  
DEFL. LIMITS: PLASTER: L/360  
GLASS PANELS: L/360  
METAL PANELS: L/240
- ALL COLD FORMED STEEL STUDS, JOIST, TRACK & MISC. SHAPES  
MILL CERTIFIED STEEL TO MEET:  
A. ASTM A653 55 GRD 30 34 - 97 MIL GALV. STEEL  
B. ASTM A653 55 GRD 33 18 - 43 MIL GALV. STEEL  
EXTERIOR MEMBERS - 660 MINIMUM
- ALL STEEL STUDS, JOIST & TRACK SHALL HAVE A LEGIBLE LABEL,  
STAMP OR EMBOSSEMENT, AT A MAXIMUM OF 48" O.C., INDICATING THE  
MANUFACTURER'S NAME, LOGO OR INITIALS, ICBO EVALUATION SERVICE  
REPORT NUMBER, THE MATERIAL GRADE METAL THICKNESS (UNCOATED)  
IN 201 IN. AND THE YIELD STRENGTH IF DIFFERENT THAN 33 KSI.
- MILL CERTIFICATES FROM THE COIL PRODUCER SHALL BE MADE  
AVAILABLE IF REQUESTED. MILL CERTIFICATE TO INCLUDE AS A  
MINIMUM THE CHEMICAL COMPOSITION, YIELD STRENGTH, TENSILE  
STRENGTH, ELONGATION, AND COATING THICKNESS.
- MINIMUM SECTION PROPERTIES: (PER 585A, ICBO ER 4943-P)
- STUDS AND TRACKS THAT COMPRISE A HEADER, STRONGBACK  
OR BILL SHALL NOT BE SPLICED.
- EXTERIOR AND INTERIOR FINISH MATERIAL SHALL NOT BRIDGE  
DEFLECTION JOINTS (COMPENSATION CHANNEL).

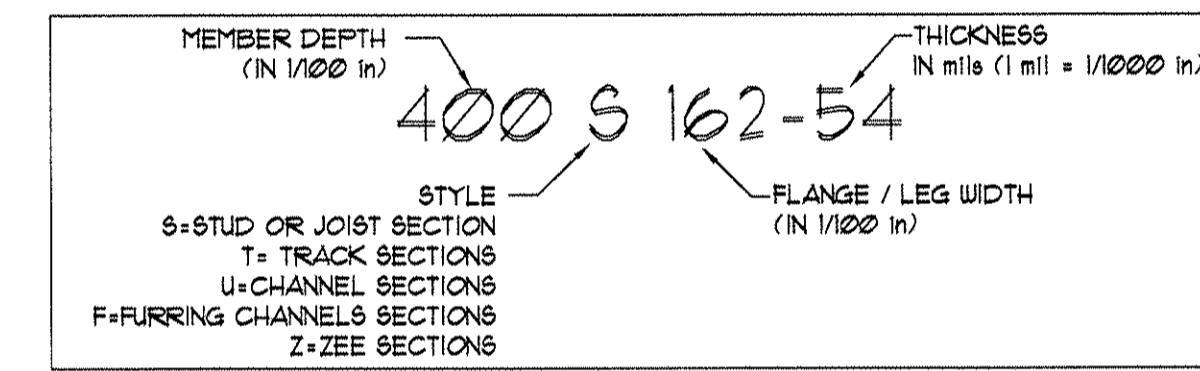

MINIMUM DELIVERABLE THICKNESS (MILS)	GAUGE	DESIGN THICKNESS (INCHES)
18	25	2/100
21	22	2/85
33	20	2/46
43	18	2/41
54	16	2/36
66	14	2/13
91	12	1/11
118	10	1/42


8. SCREW VALUES USED IN DESIGN MEET THE A193 SPECIFICATION E4 FOR SCREW CONNECTIONS. SCREWS TO CONFORM TO SAE JTB.

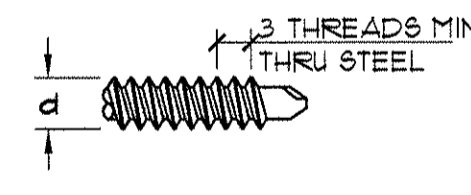

THE NOMINAL STRENGTH OF THE SCREWS TESTED IN ACCORDANCE WITH SECTION F1 (A) OF THE 1986 EDITION OF THE A193 SPECIFICATION FOR THE DESIGN OF COLD-FORMED STEEL STRUCTURAL MEMBERS SHALL NOT BE LESS THAN:

SHEAR	TENSION	
	1/2	1/2
1280	1388	514

9. SCREWS PER GRABBER - ICBO ER 5780 UNO, WHERE SPECIFIED FOR CONNECTIONS TO STEEL GREATER 1/8" THICK, USE HILTI KWIK-FLEX.

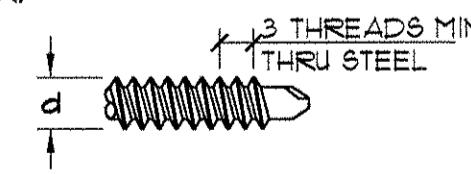

### SHEET INDEX

- SF 4.00 COVER SHEET
- SF 4.05 FLOOR PLAN
- SF 4.10 ELEVATIONS
- SF 4.20 WALL SECTIONS
- SF 4.21 WALL SECTIONS
- SF 4.22 WALL SECTIONS
- SF 4.23 WALL SECTIONS
- SF 4.42 DETAILS
- SF 4.41 DETAILS
- SF 4.42 INTERIOR DETAILS
- SF 5.00 SKETCHES
- SF 5.01 SKETCHES
- SF 5.02 SKETCHES
- SF 5.03 SKETCHES
- SF 5.04 SKETCHES
- SF 5.05 SKETCHES

Corvallis  
Oregon  
DEVCO  
Engineering Inc.  
(541) 757-8991  
245 NE CONIFER, P.O. BOX 1211  
CORVALLIS, OR 97339  
WWW.DEVCOENGINEERING.COM  
© COPYRIGHT 2010  
DEVCO ENGINEERING, INC.  
ALL RIGHTS RESERVED.

PROJECT:  
COLLEGE OF SAN MATEO  
BUILDING 5N  
PROJECT LOCATION:  
SAN MATEO, CA  
CLIENT:  
NORTHBAY DRYWALL


SHEET TITLE:  
COVER SHEET AND GENERAL NOTES

JOB NO. 08-013  
DRAWN BY: DEVCO  
DRAWING:  
SF 4.00







FILE No. J:\V\0813 College of San Mateo\11-11-10\TEMP\0813410 EXTERIOR ELEVATIONS.dwg 11/17/10 08:49 - Ben

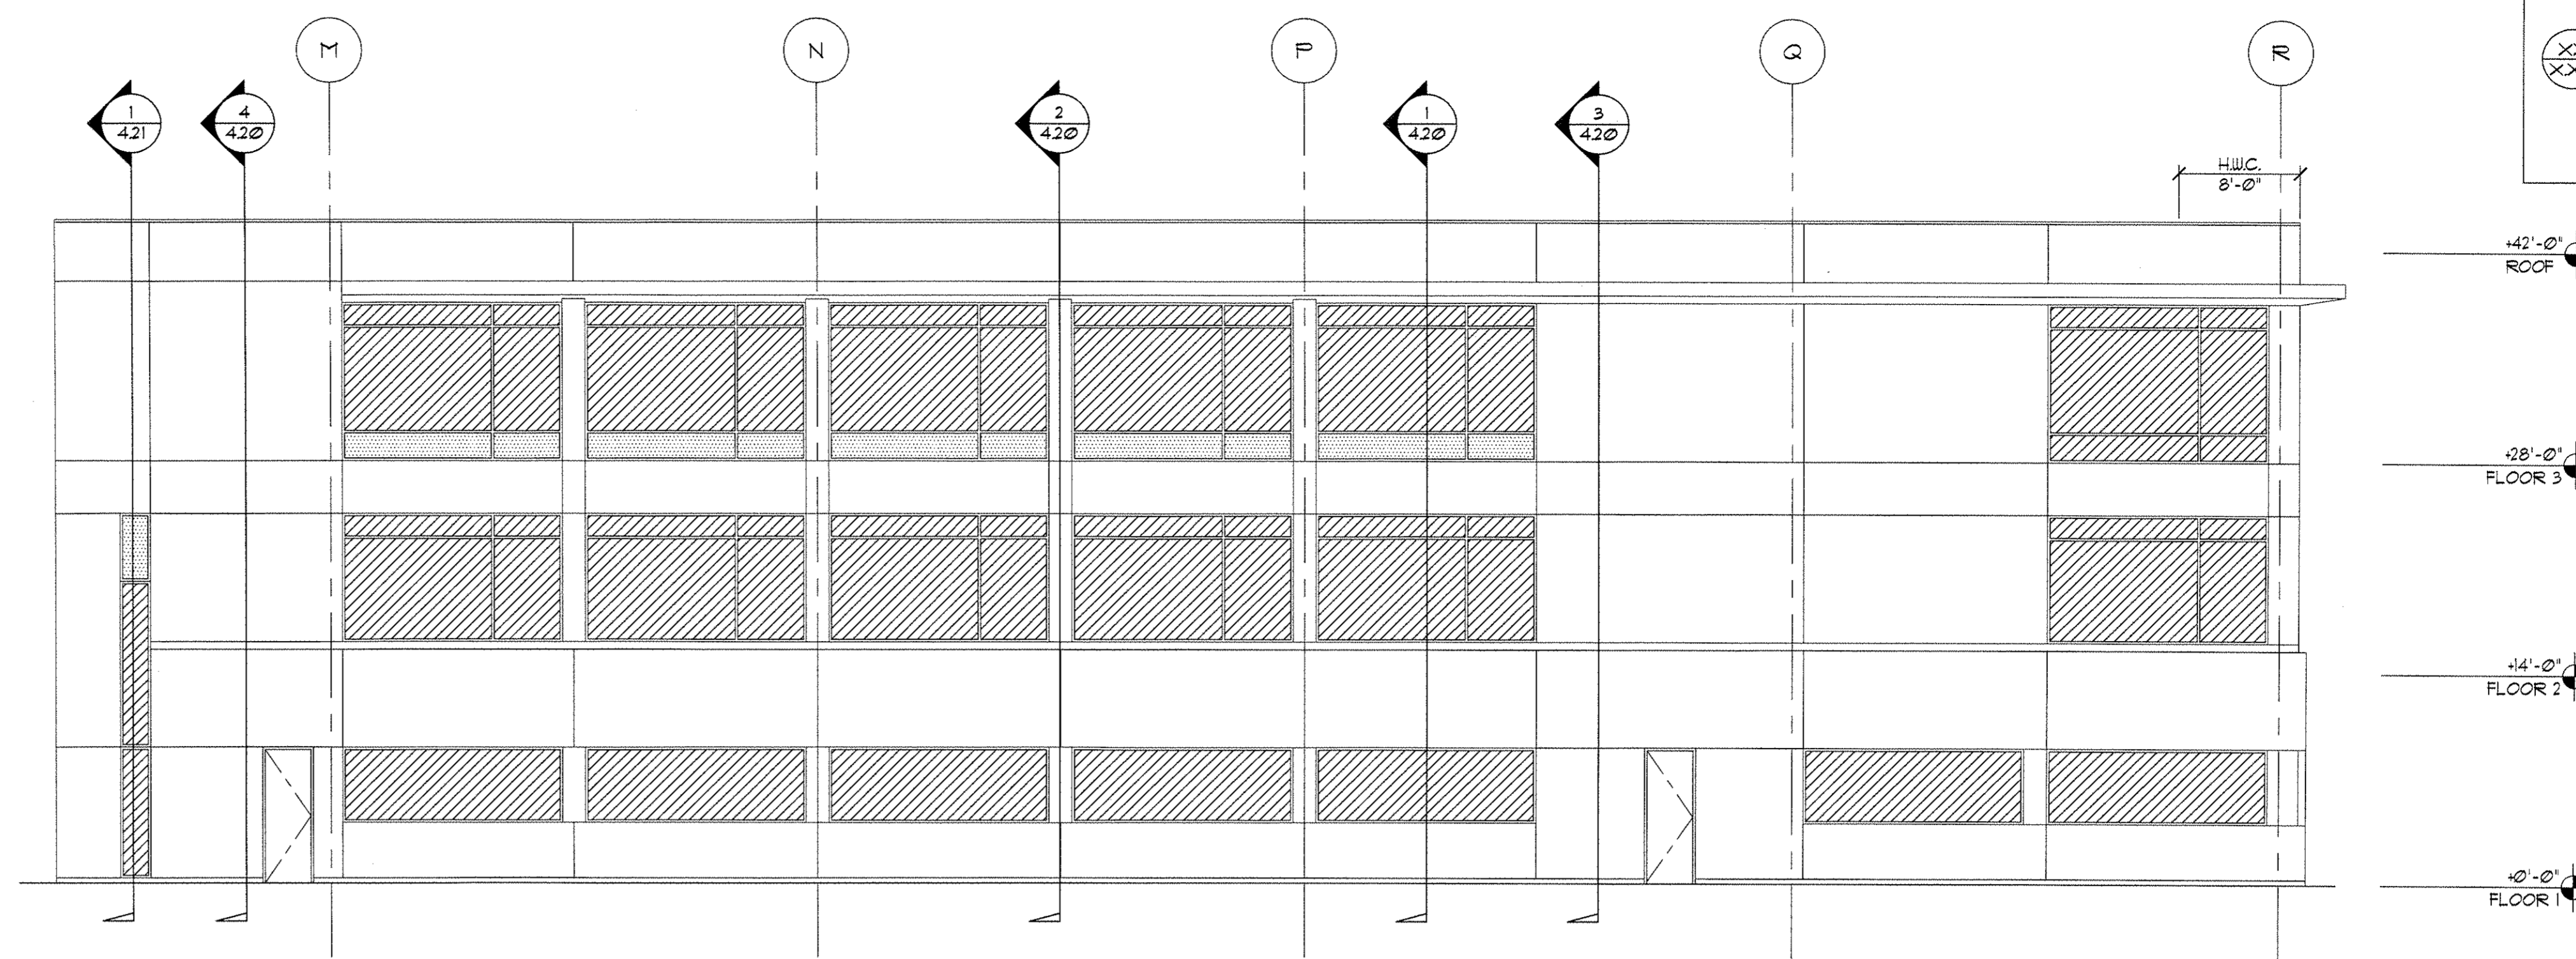


3 SOUTH ELEVATION  
SCALE: 1/8" = 1'-0" REF. 1/A3.11

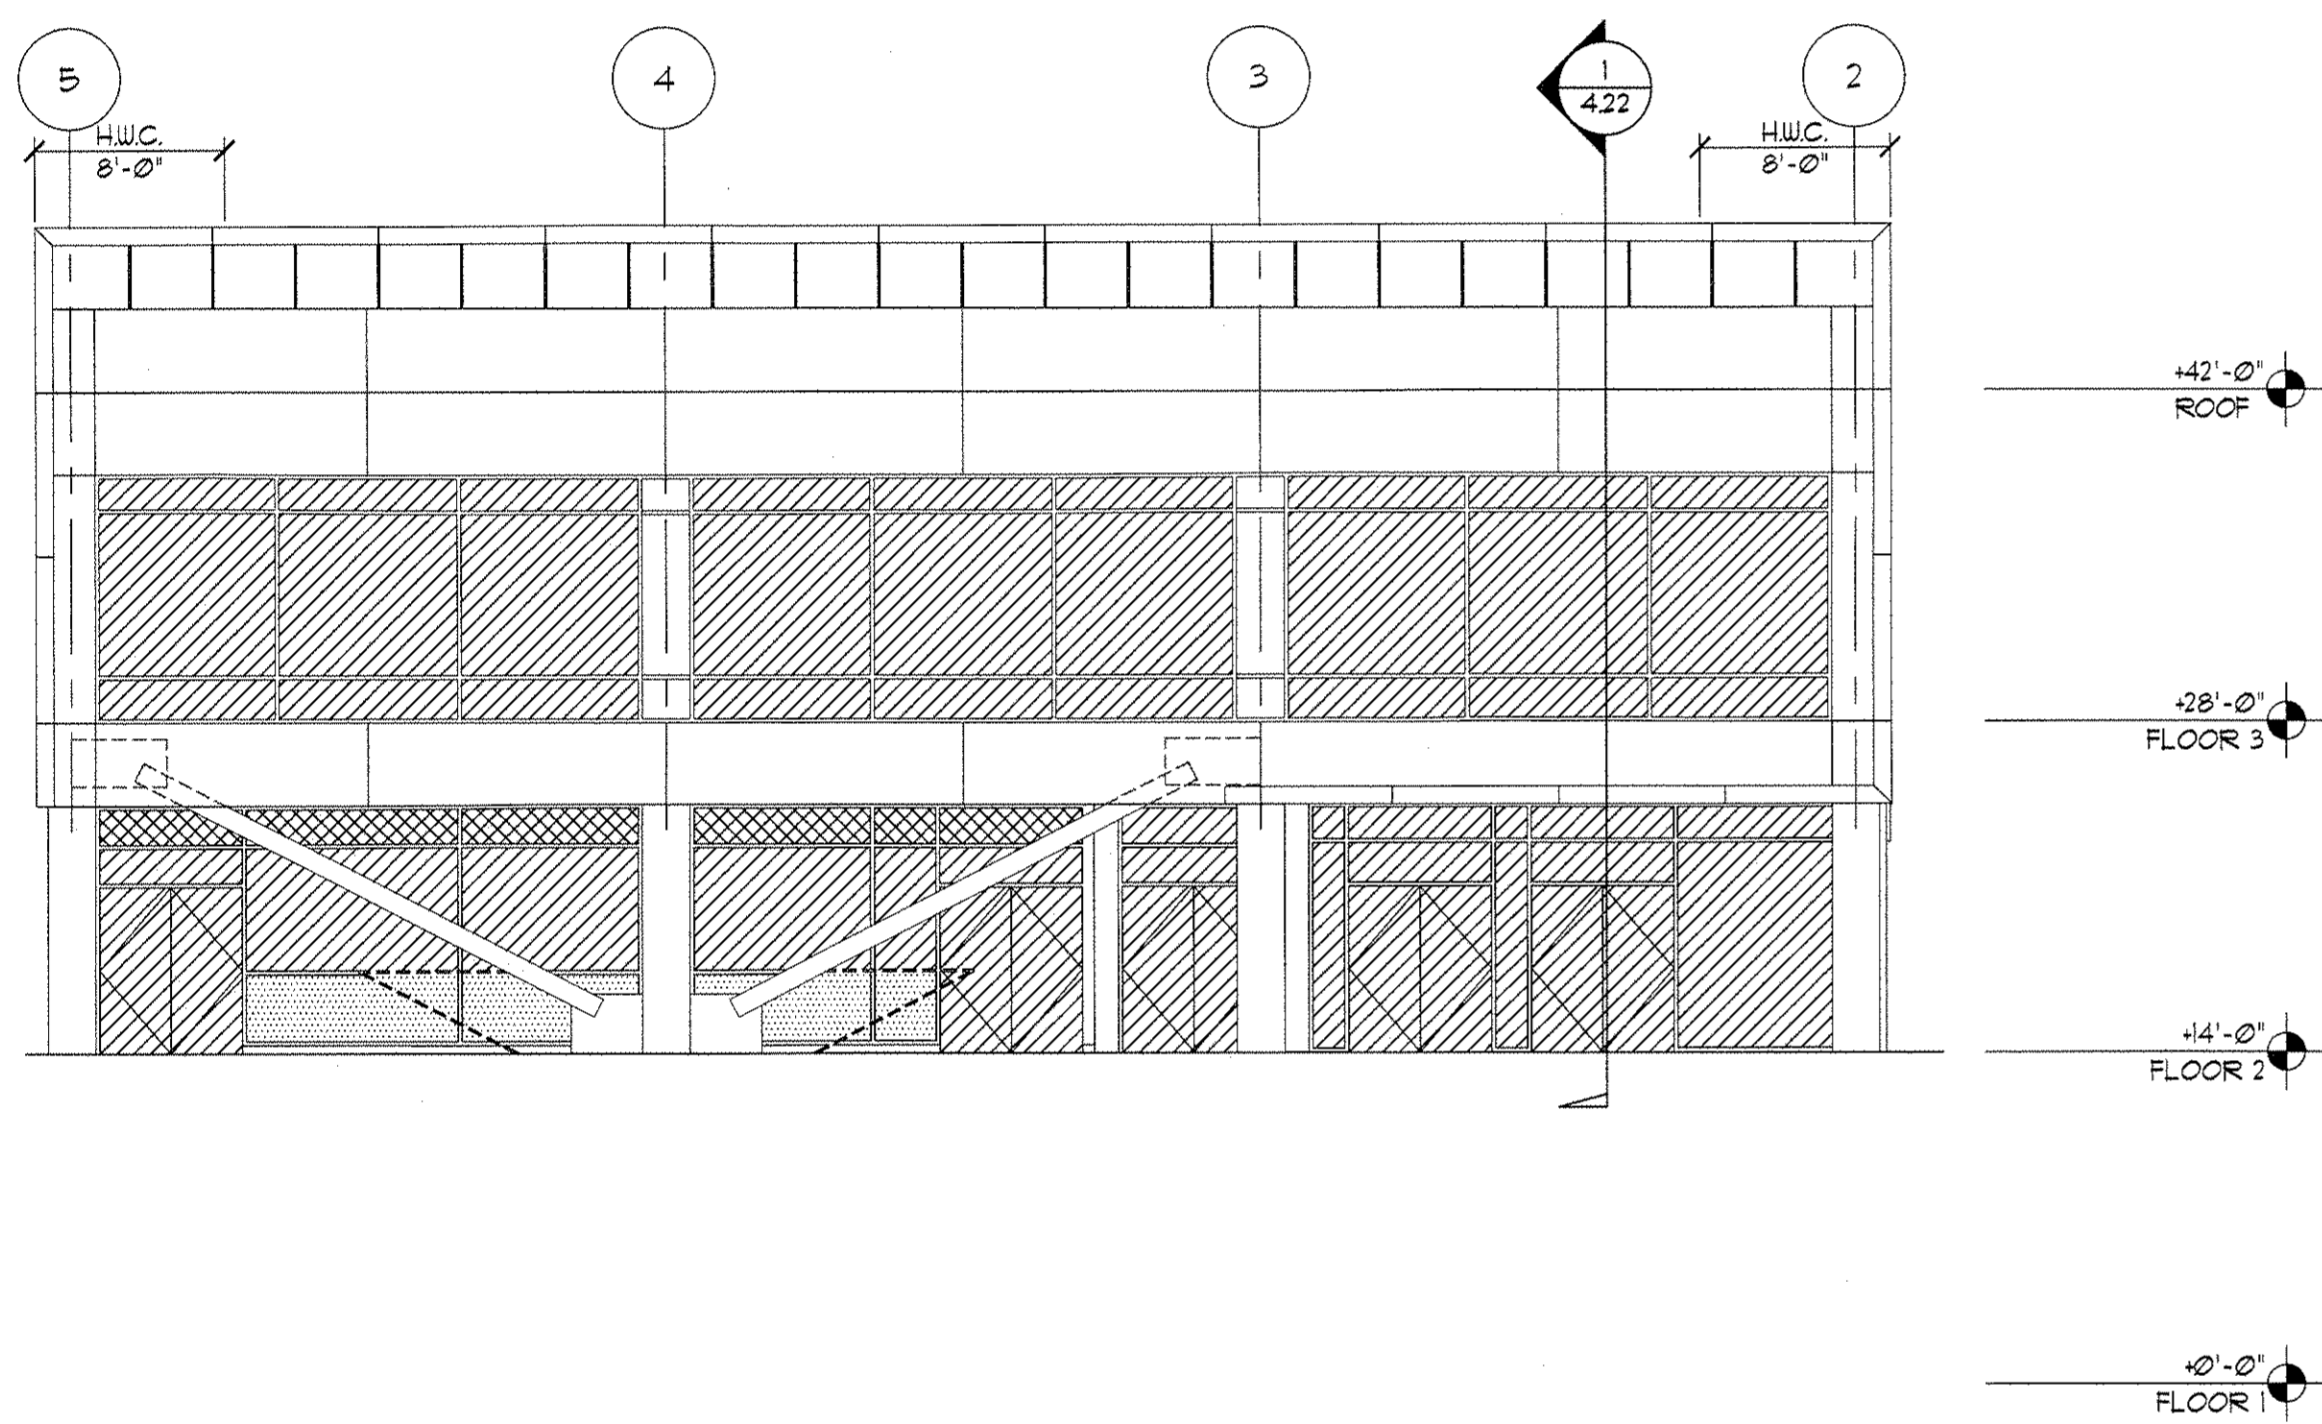


5 NORTHWEST ELEVATION  
SCALE: 1/8" = 1'-0" REF. 2/A3.13

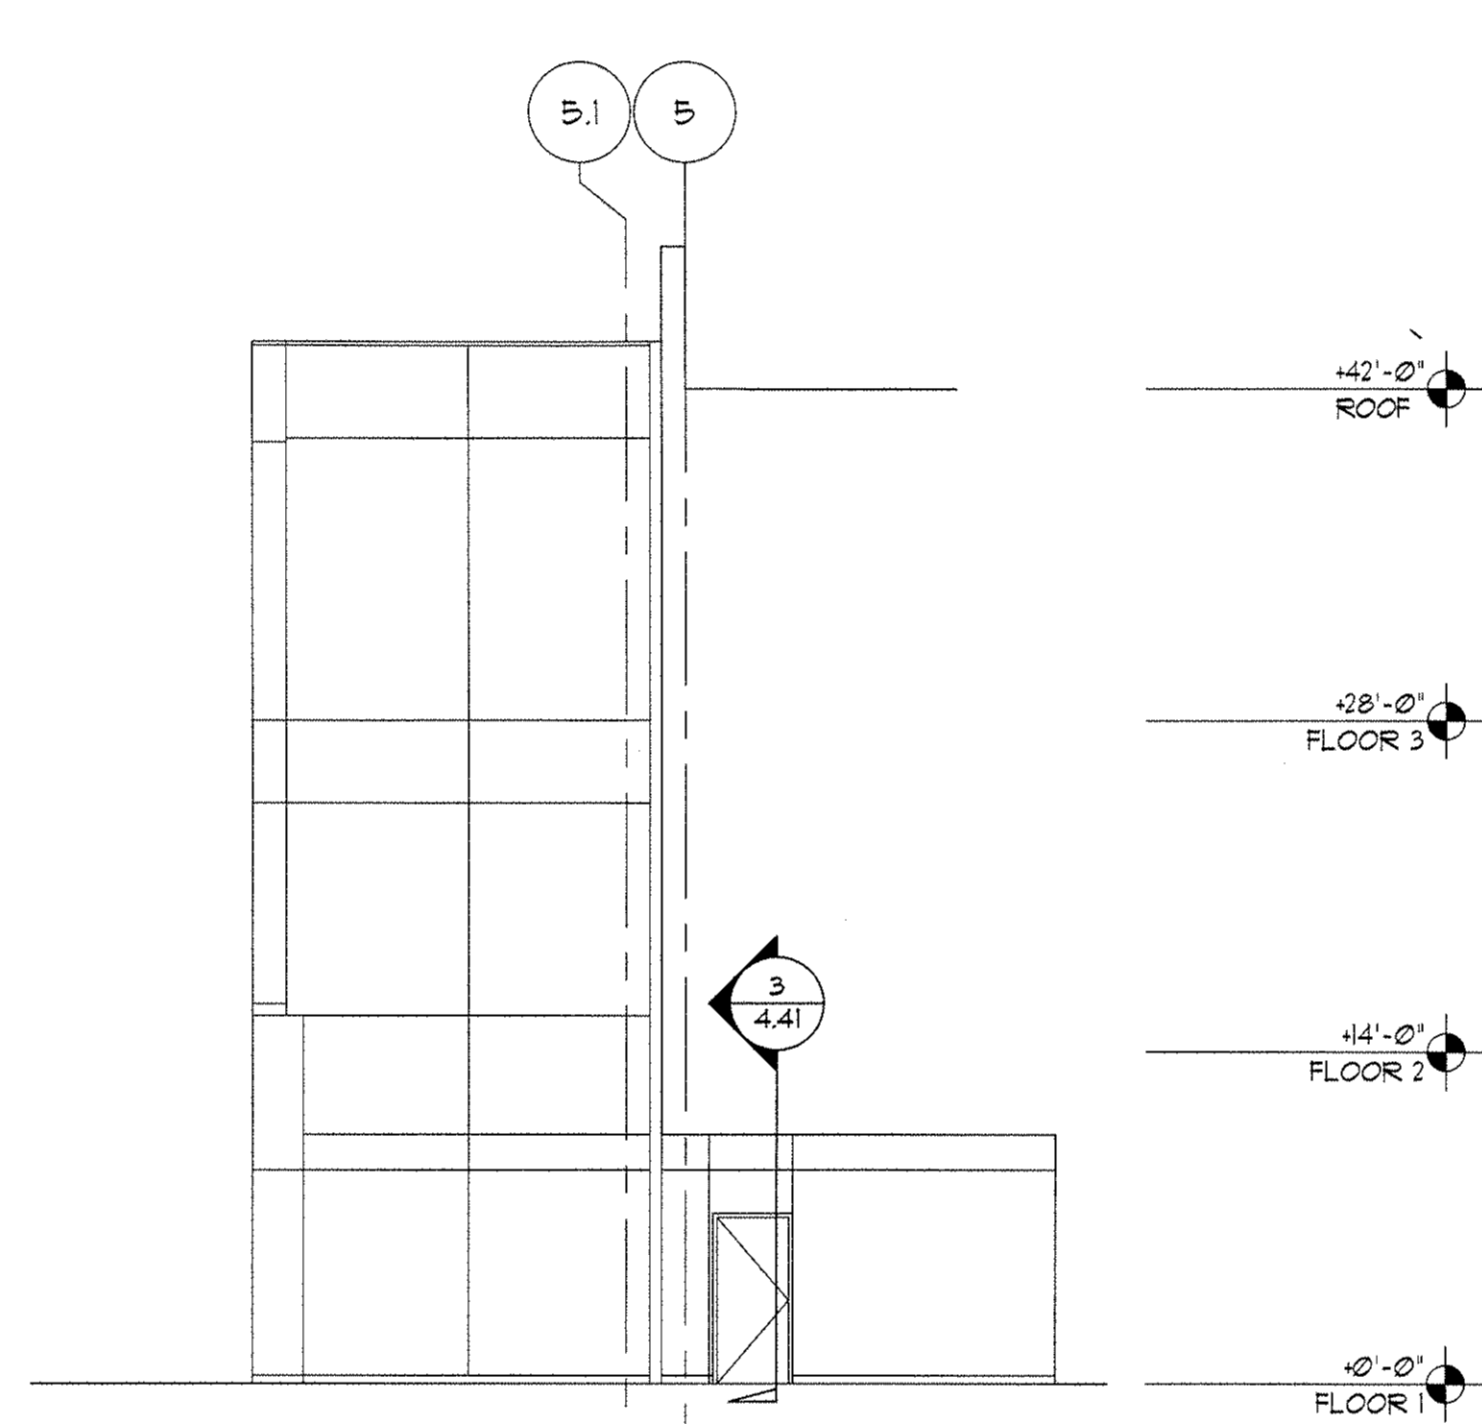

4 NORTHWEST ELEVATION 4 FACADE  
SCALE: 1/8" = 1'-0" REF. 2/A3.12

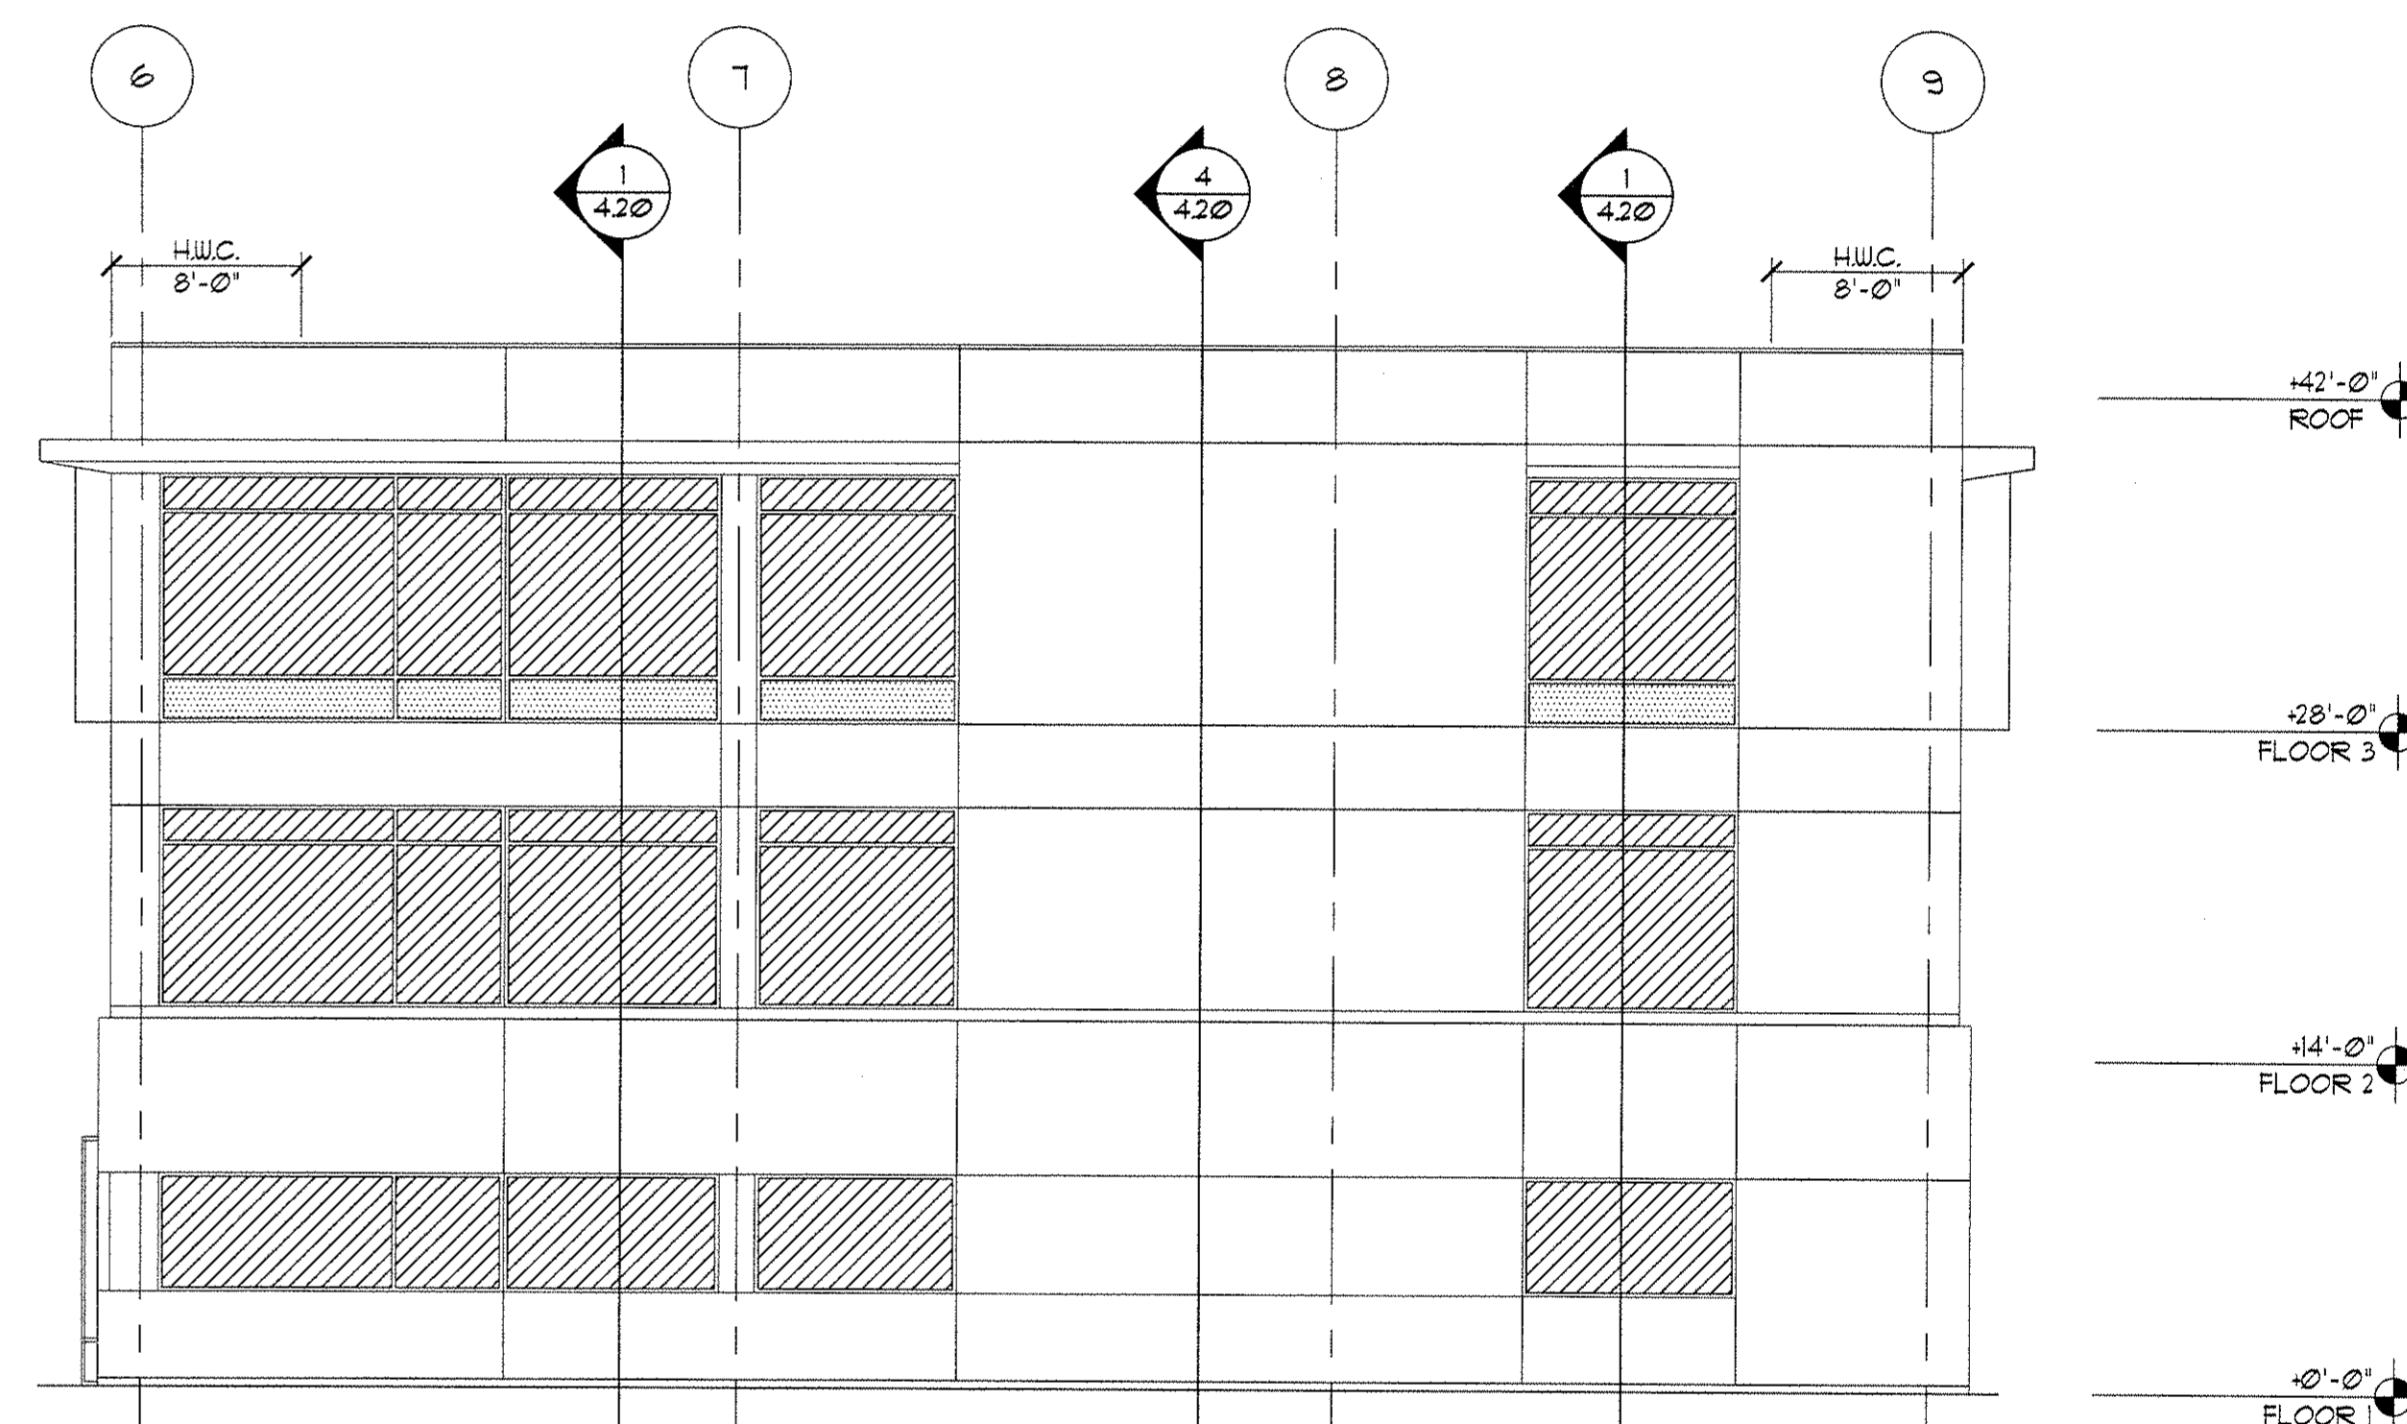


2 EAST ELEVATION  
SCALE: 1/8" = 1'-0" REF. 2/A3.11

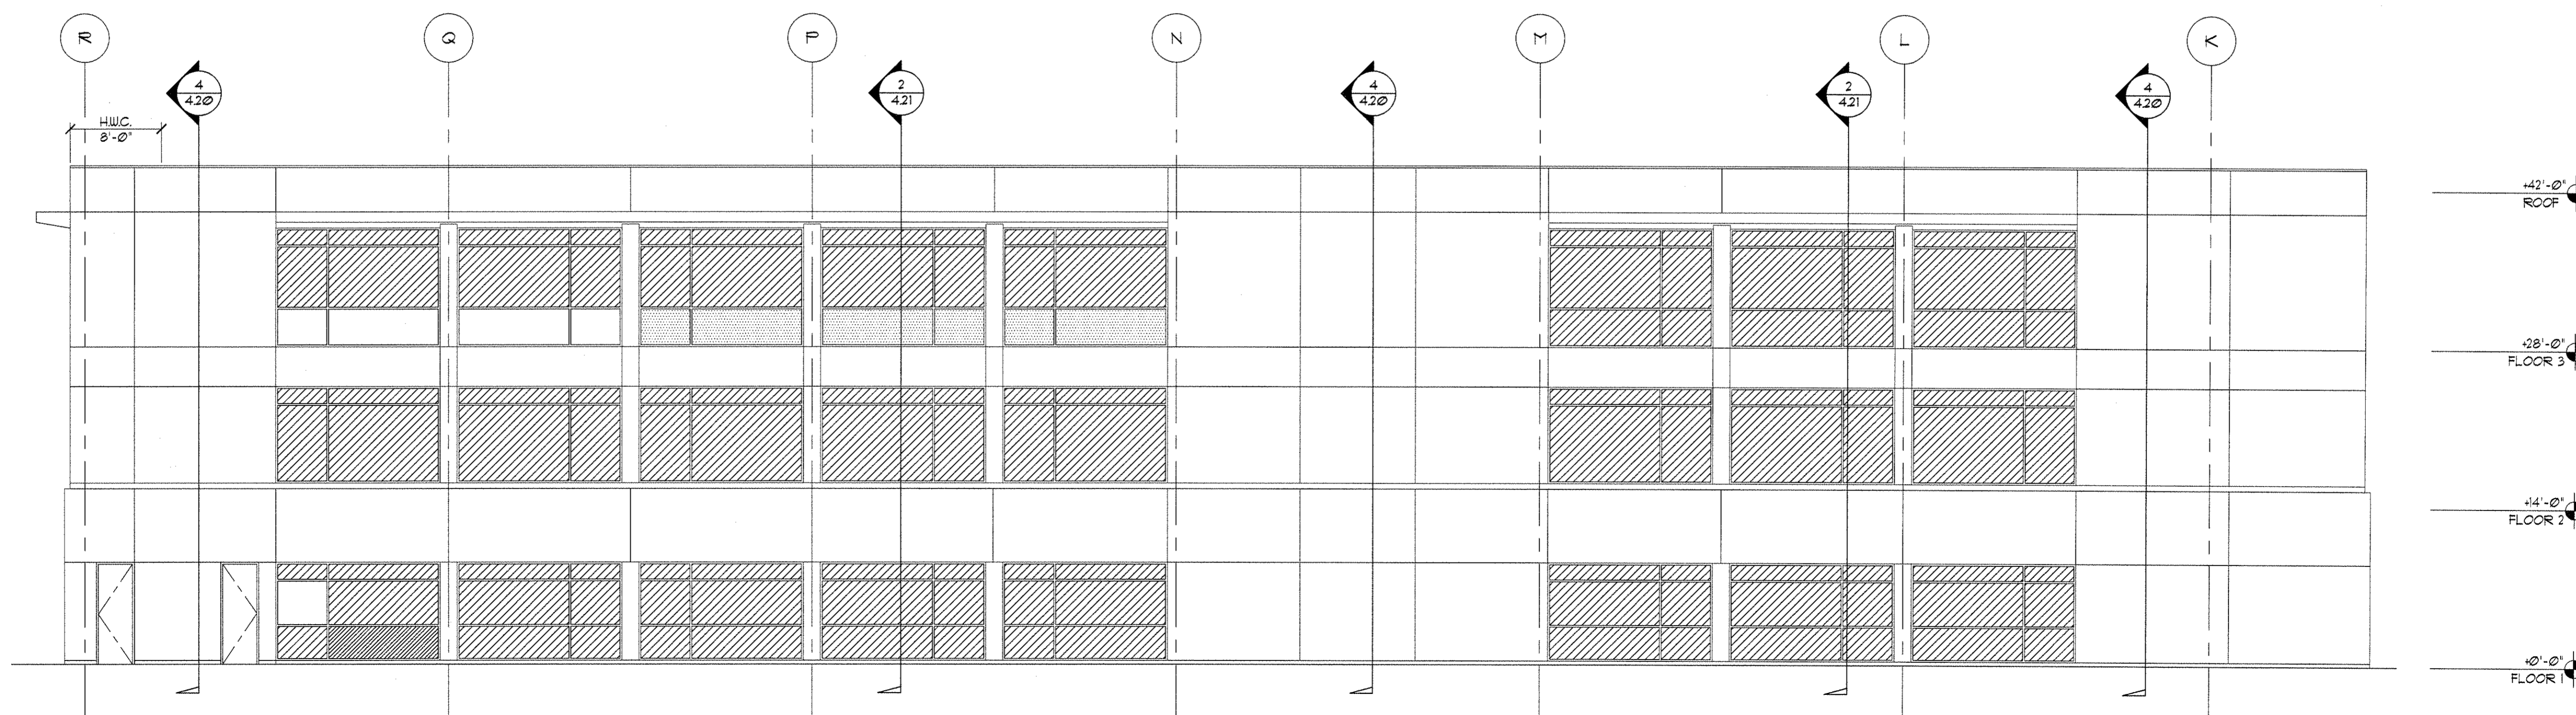

1 NORTH ELEVATION  
SCALE: 1/8" = 1'-0" REF. 1/A3.12

DETAIL NUMBER  
PAGE NUMBER  
(ADD PREFIX SF  
FOR COMPLETE  
PAGE NUMBER)

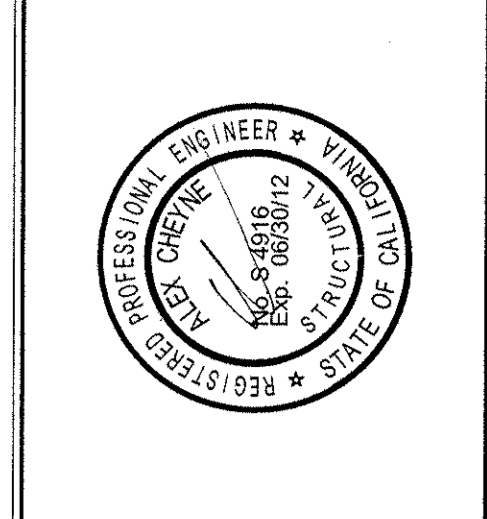

DRAWING STATUS	DATE	NO.	REVISION
<input type="checkbox"/> PRELIMINARY			
<input checked="" type="checkbox"/> SUBMITTED	8/05/08	1	SET ISSUED PER CSA REVIEW
<input type="checkbox"/> BID SET			
<input type="checkbox"/> PERMIT SET			
<input type="checkbox"/> CONST. SET			
<input checked="" type="checkbox"/> RECORD DRAWING	11/11/10		

**DEVCO**  
 engineering inc.  
 245 NE CONIFER, P.O. BOX 1281  
 CORVALLIS, OR 97339  
 WWW.DEVCOENGINEERING.COM  
 © COPYRIGHT 2010  
 DEVCO ENGINEERING, INC.  
 ALL RIGHTS RESERVED.


PROJECT: COLLEGE OF SAN MATEO  
 BUILDING 5N  
 PROJECT LOCATION: SAN MATEO, CA  
 CLIENT: NORTHBAY DRYWALL

SHEET TITLE:  
 EXTERIOR ELEVATIONS


JOB NO. 08-013  
 DRAWN BY: DEVCO  
**SF 4.10**




FILE No. J:\08\08013 College of San Mateo\10-13-10\REVISED 11-11-10\DWG\08013A11 EXTERIOR ELEVATIONS.dwg 11/12/10 08:48 - Ben

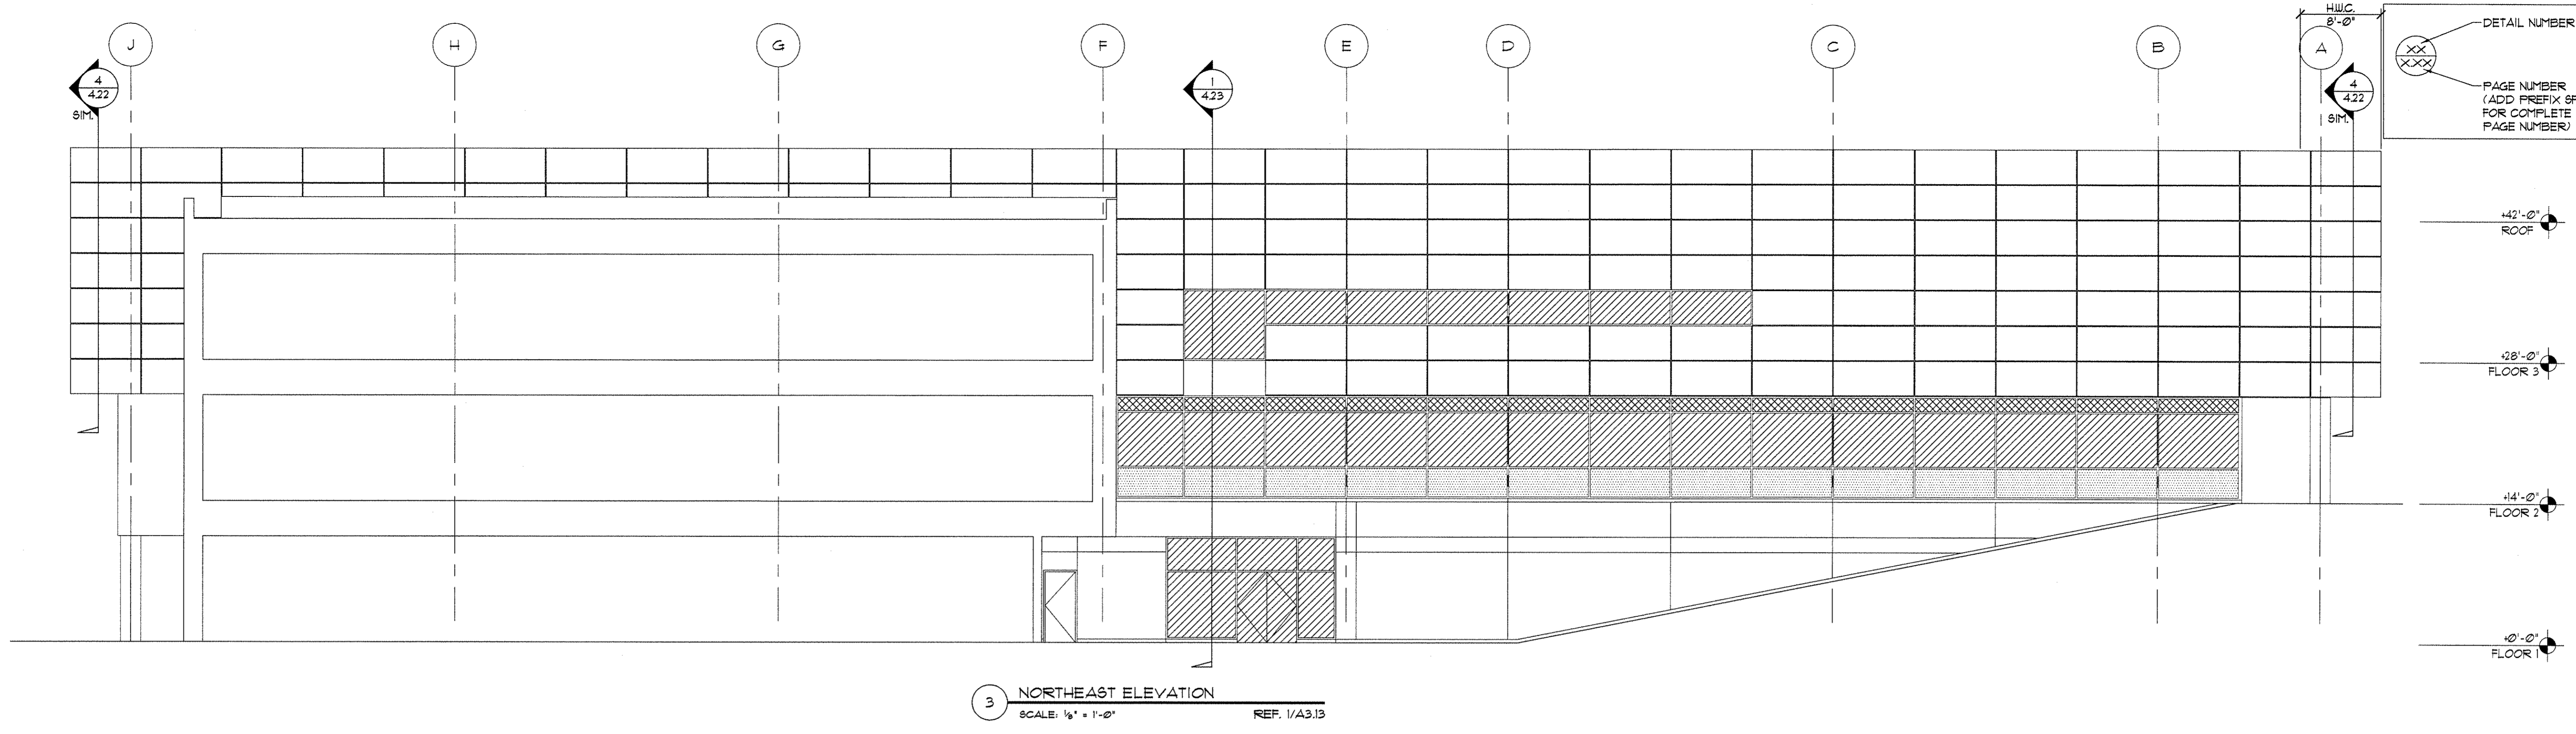


3 NORTHEAST ELEVATION  
SCALE: 1/8" = 1'-0" REF. 1/A3.13

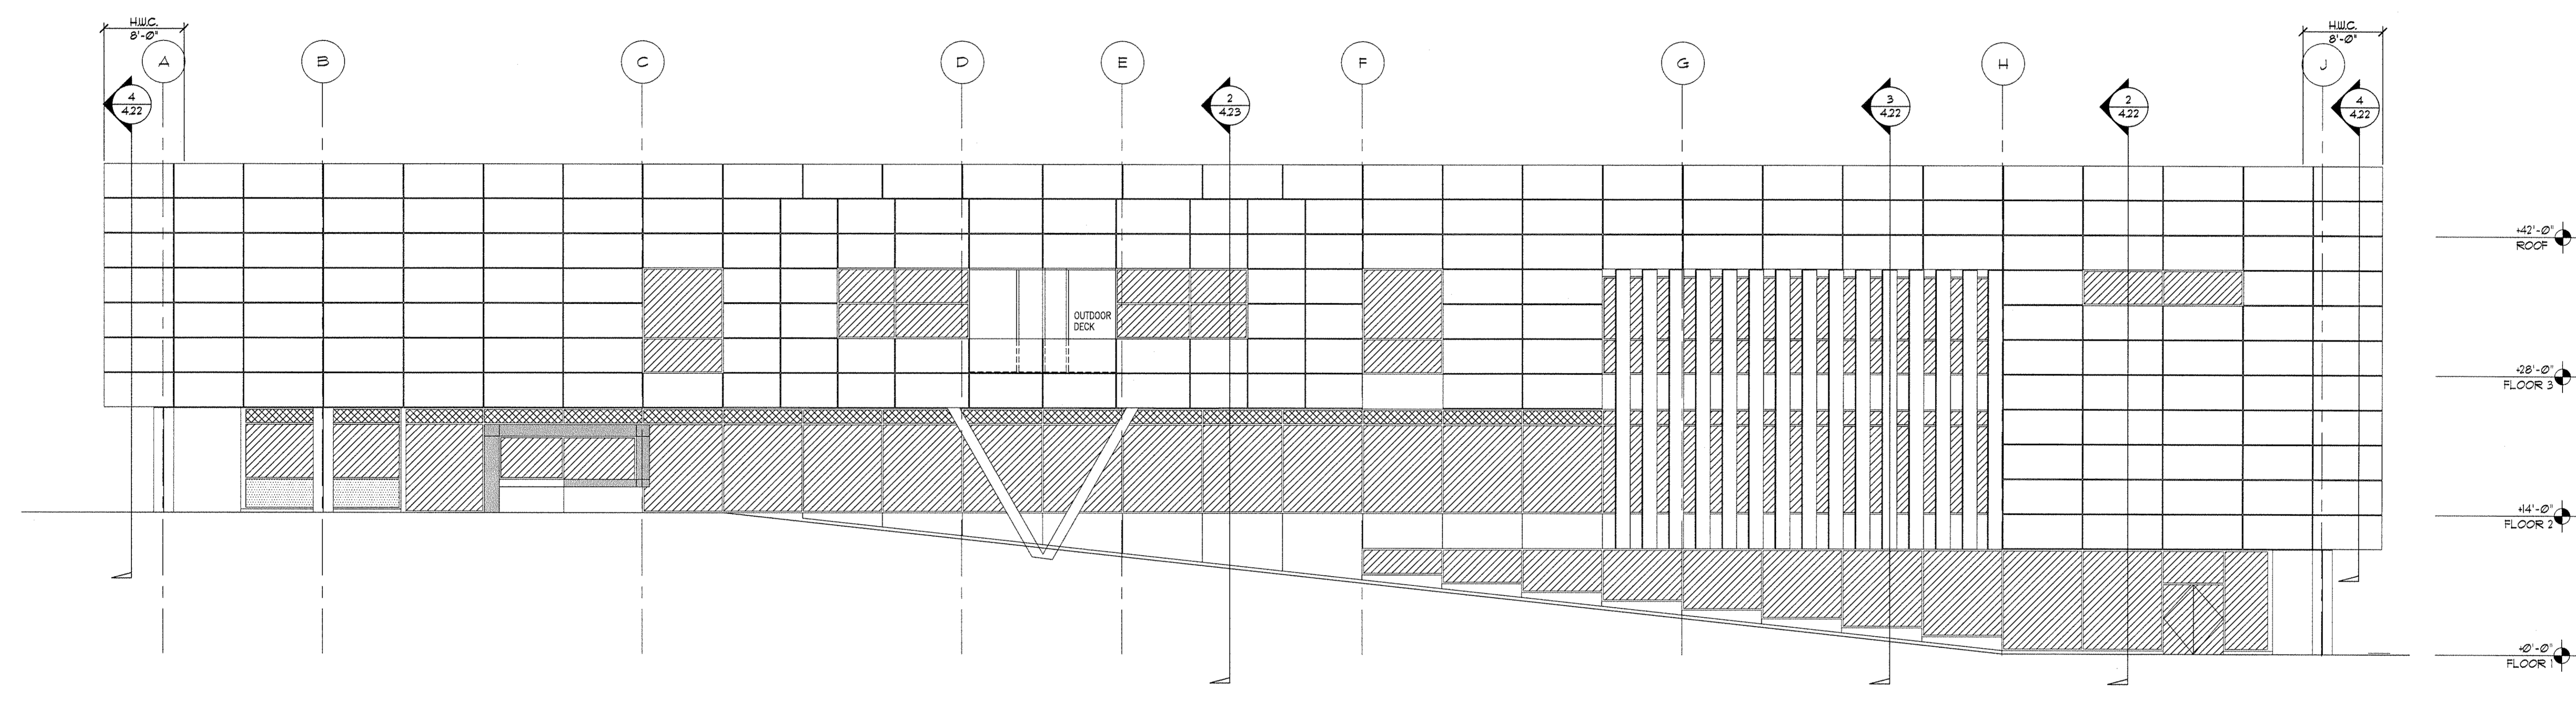


2 SOUTHWEST ELEVATION  
SCALE: 1/8" = 1'-0" REF. 1/A3.14

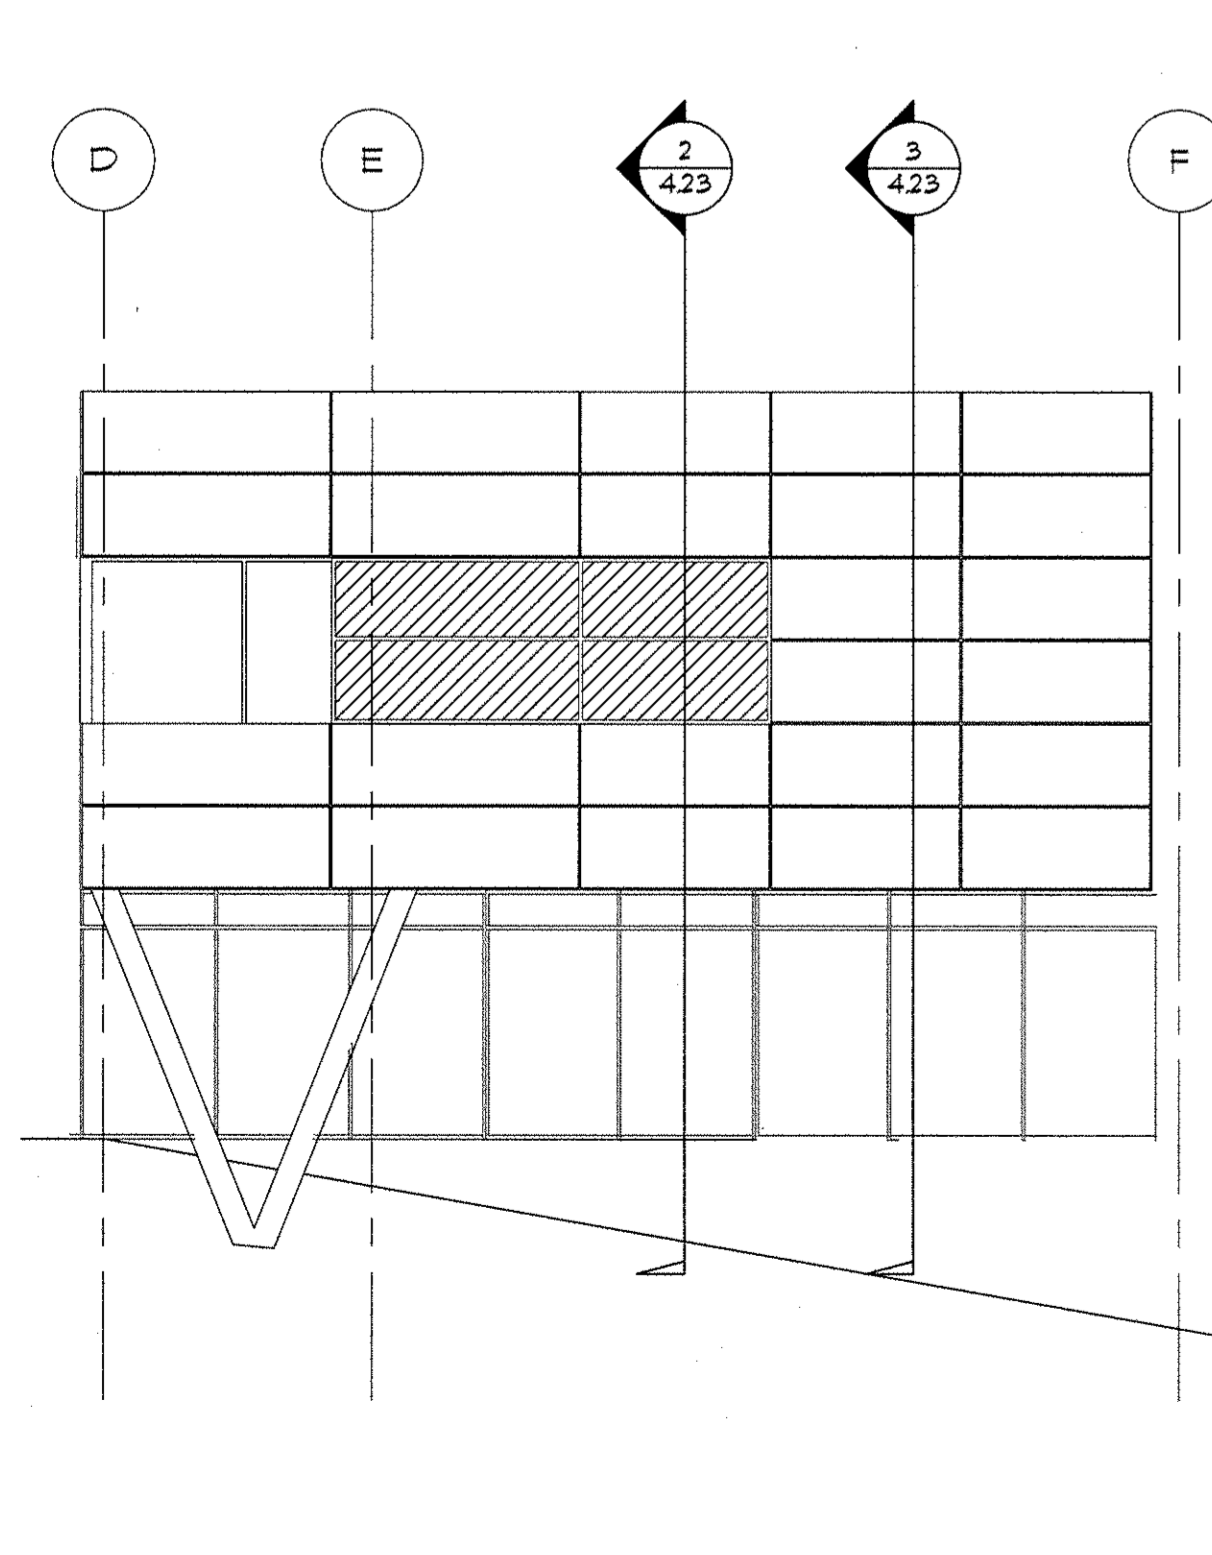

5 SOUTH ELEVATION  
SCALE: 1/8" = 1'-0" REF. 3/A3.14

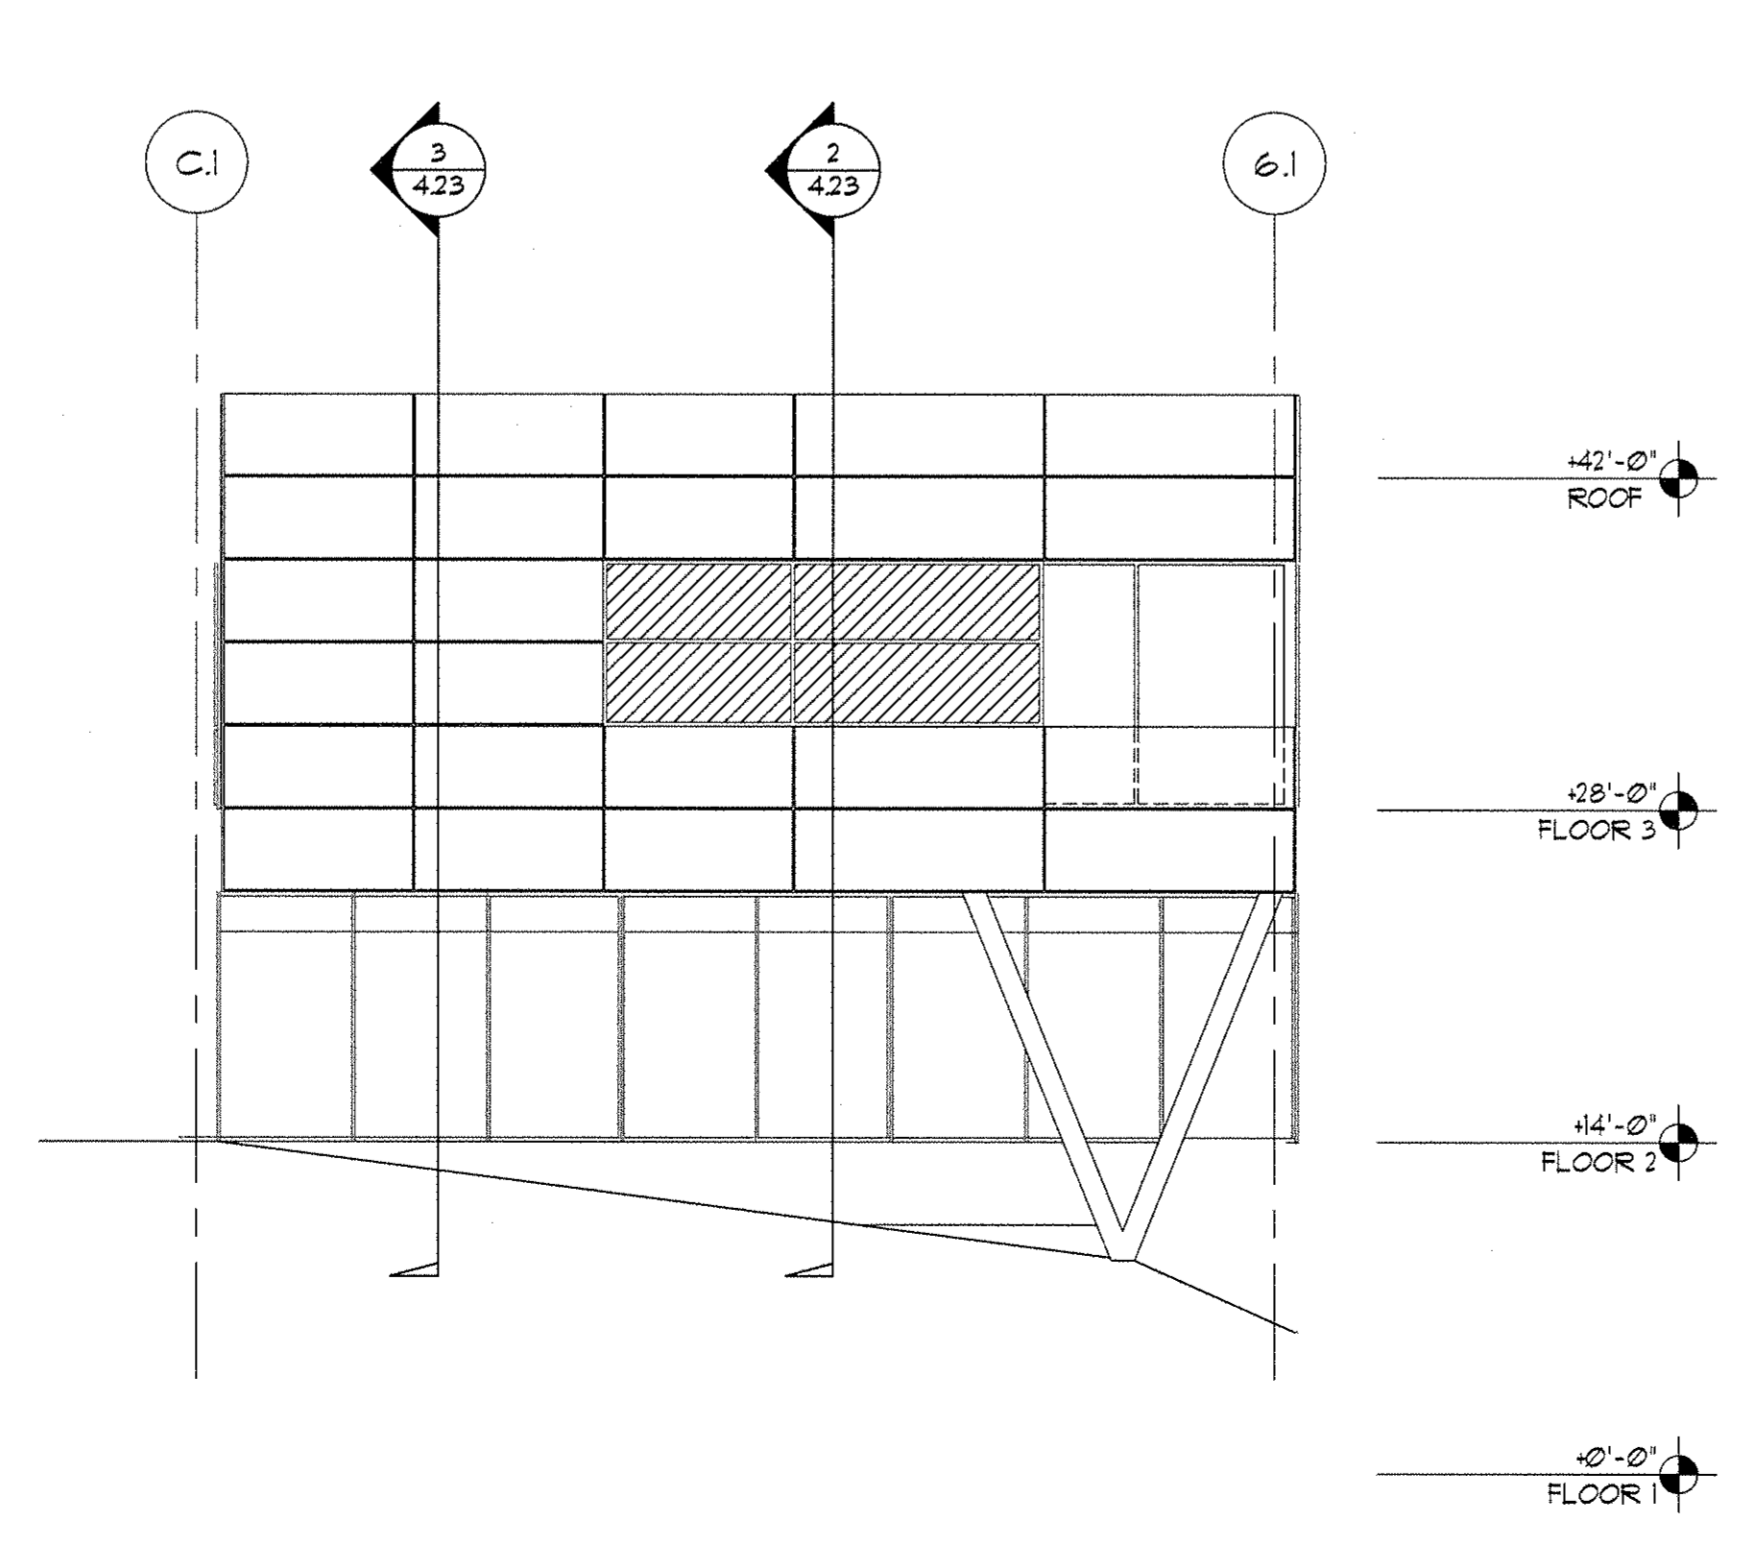


4 WEST ELEVATION  
SCALE: 1/8" = 1'-0" REF. 2/A3.14

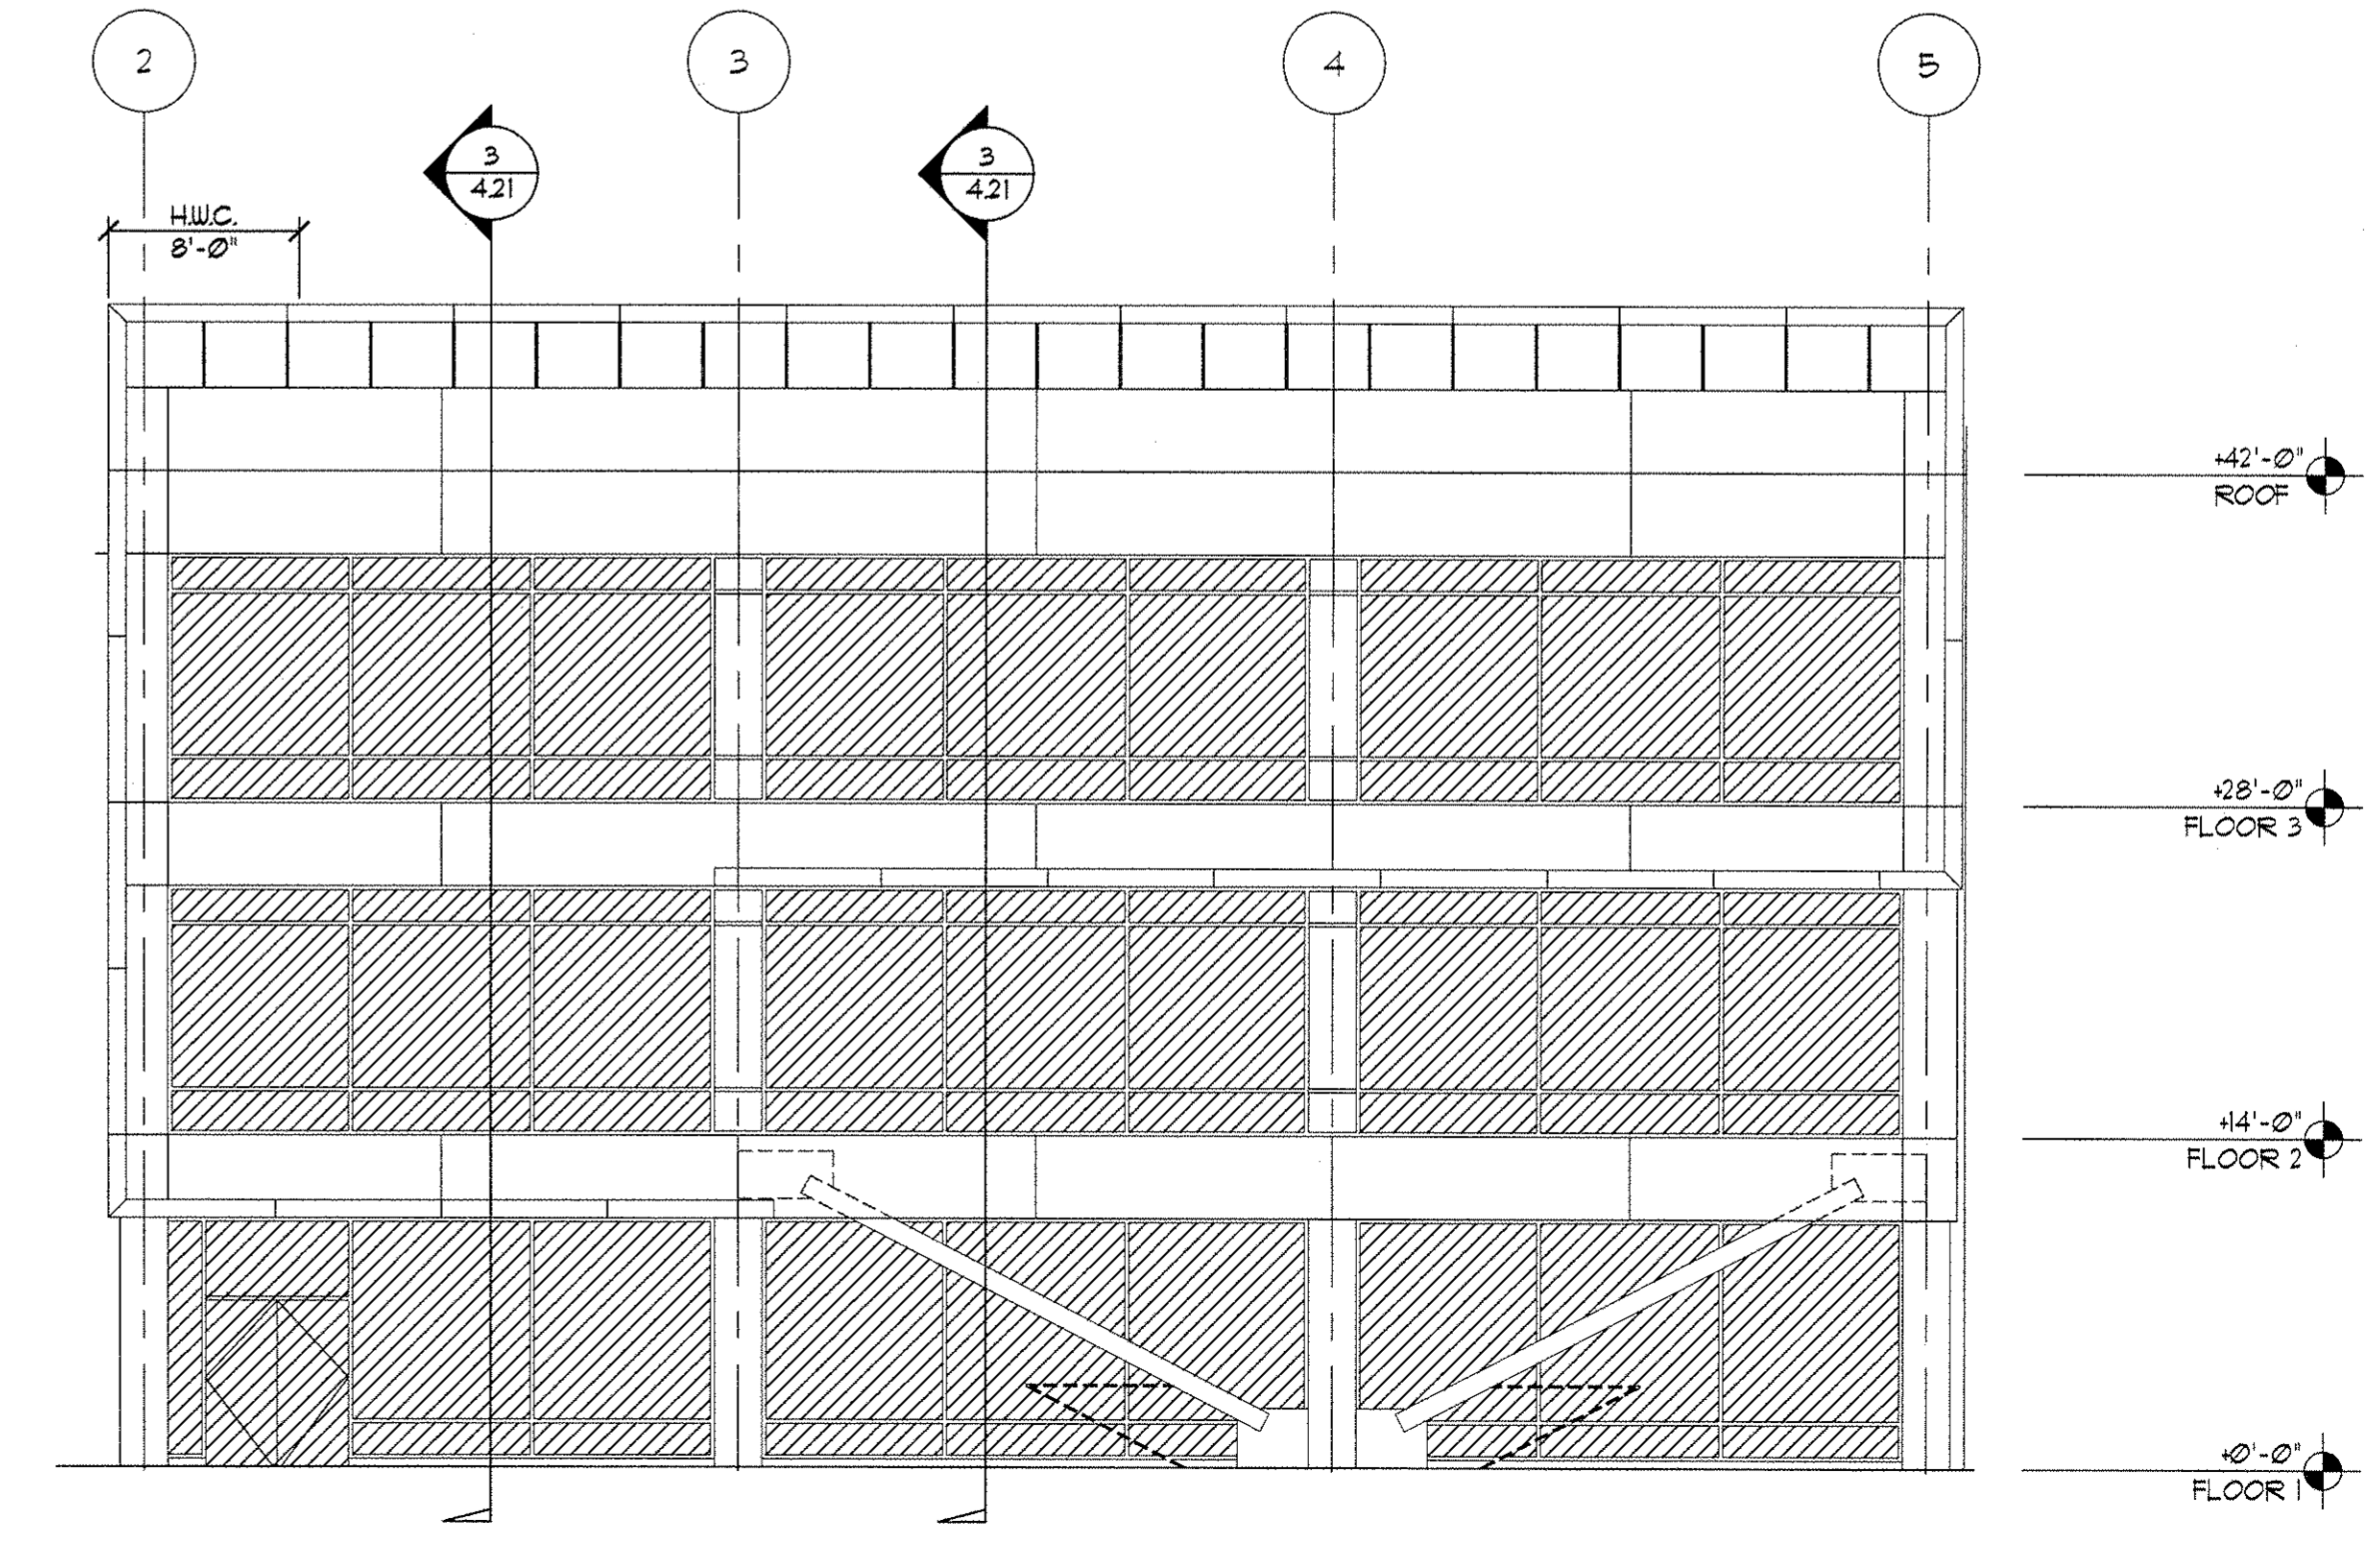

1 SOUTHEAST ELEVATION  
SCALE: 1/8" = 1'-0" REF. 4/A3.14

DETAIL NUMBER  
PAGE NUMBER (ADD PREFIX SF FOR COMPLETE PAGE NUMBER)

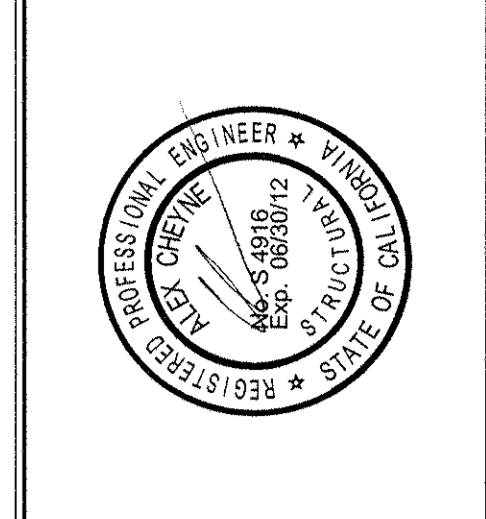

DRAWING STATUS	DATE	NO.	REVISION	DATE
<input type="checkbox"/> PRELIMINARY				
<input checked="" type="checkbox"/> SUBMITTED	8/05/08	1	SET ISSUED PER DSA REVIEW	10/09/08
<input type="checkbox"/> BID SET				
<input type="checkbox"/> PERMIT SET				
<input type="checkbox"/> CONST. SET				
<input checked="" type="checkbox"/> RECORD DRAWING	11/11/10	1		

Corvallis Oregon  
**DEVCO**  
 engineering inc.  
 245 NE CONIFER, P.O. BOX 1211  
 CORVALLIS, OR 97339  
 WWW.DEVCOENGINEERING.COM  
 © COPYRIGHT 2010  
 DEVCO ENGINEERING, INC.  
 ALL RIGHTS RESERVED.


PROJECT: COLLEGE OF SAN MATEO  
 BUILDING 5N  
 PROJECT LOCATION: SAN MATEO, CA  
 CLIENT: NORTHBAY DRYWALL

SHEET TITLE:  
**EXTERIOR ELEVATIONS**

JOB NO. 08-013  
 DRAWN BY: DEVCO  
 DRAWING:  
**SF 4.11**



DETAIL NUMBER  
 XXX  
 XXX  
 PAGE NUMBER  
 (ADD PREFIX IF  
 FOR COMPLETE  
 PAGE NUMBER)

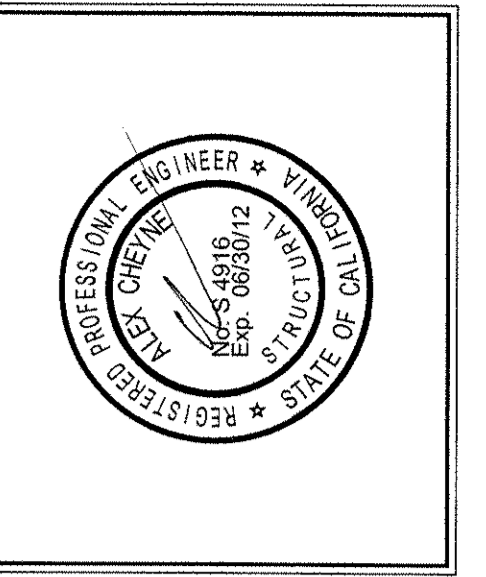


DRAWING STATUS	DATE	REVISION
PRELIMINARY		
SUBMITTED	8/05/08	SET ISSUED PER DSA REVIEW
BID SET		GENERAL REVIEW
PERMIT SET		
CONST. SET		
RECORD DRAWING	11/11/10	

**DEVCO**  
 engineering inc.  
 245 NE CONIFER, P.O. BOX 1231  
 CORVALLIS, OR 97331  
 WWW.DEVCOENGINEERING.COM  
 © COPYRIGHT 2010  
 DEVCO ENGINEERING, INC.  
 ALL RIGHTS RESERVED.


PROJECT: COLLEGE OF SAN MATEO  
 BUILDING 5N  
 PROJECT LOCATION: SAN MATEO, CA  
 CLIENT: NORTHBAY DRYWALL

SHEET TITLE:  
**WALL SECTIONS**


JOB NO. 08-013  
 DRAWN BY: DEVCO  
 DRAWING:  
**SF 4.20**

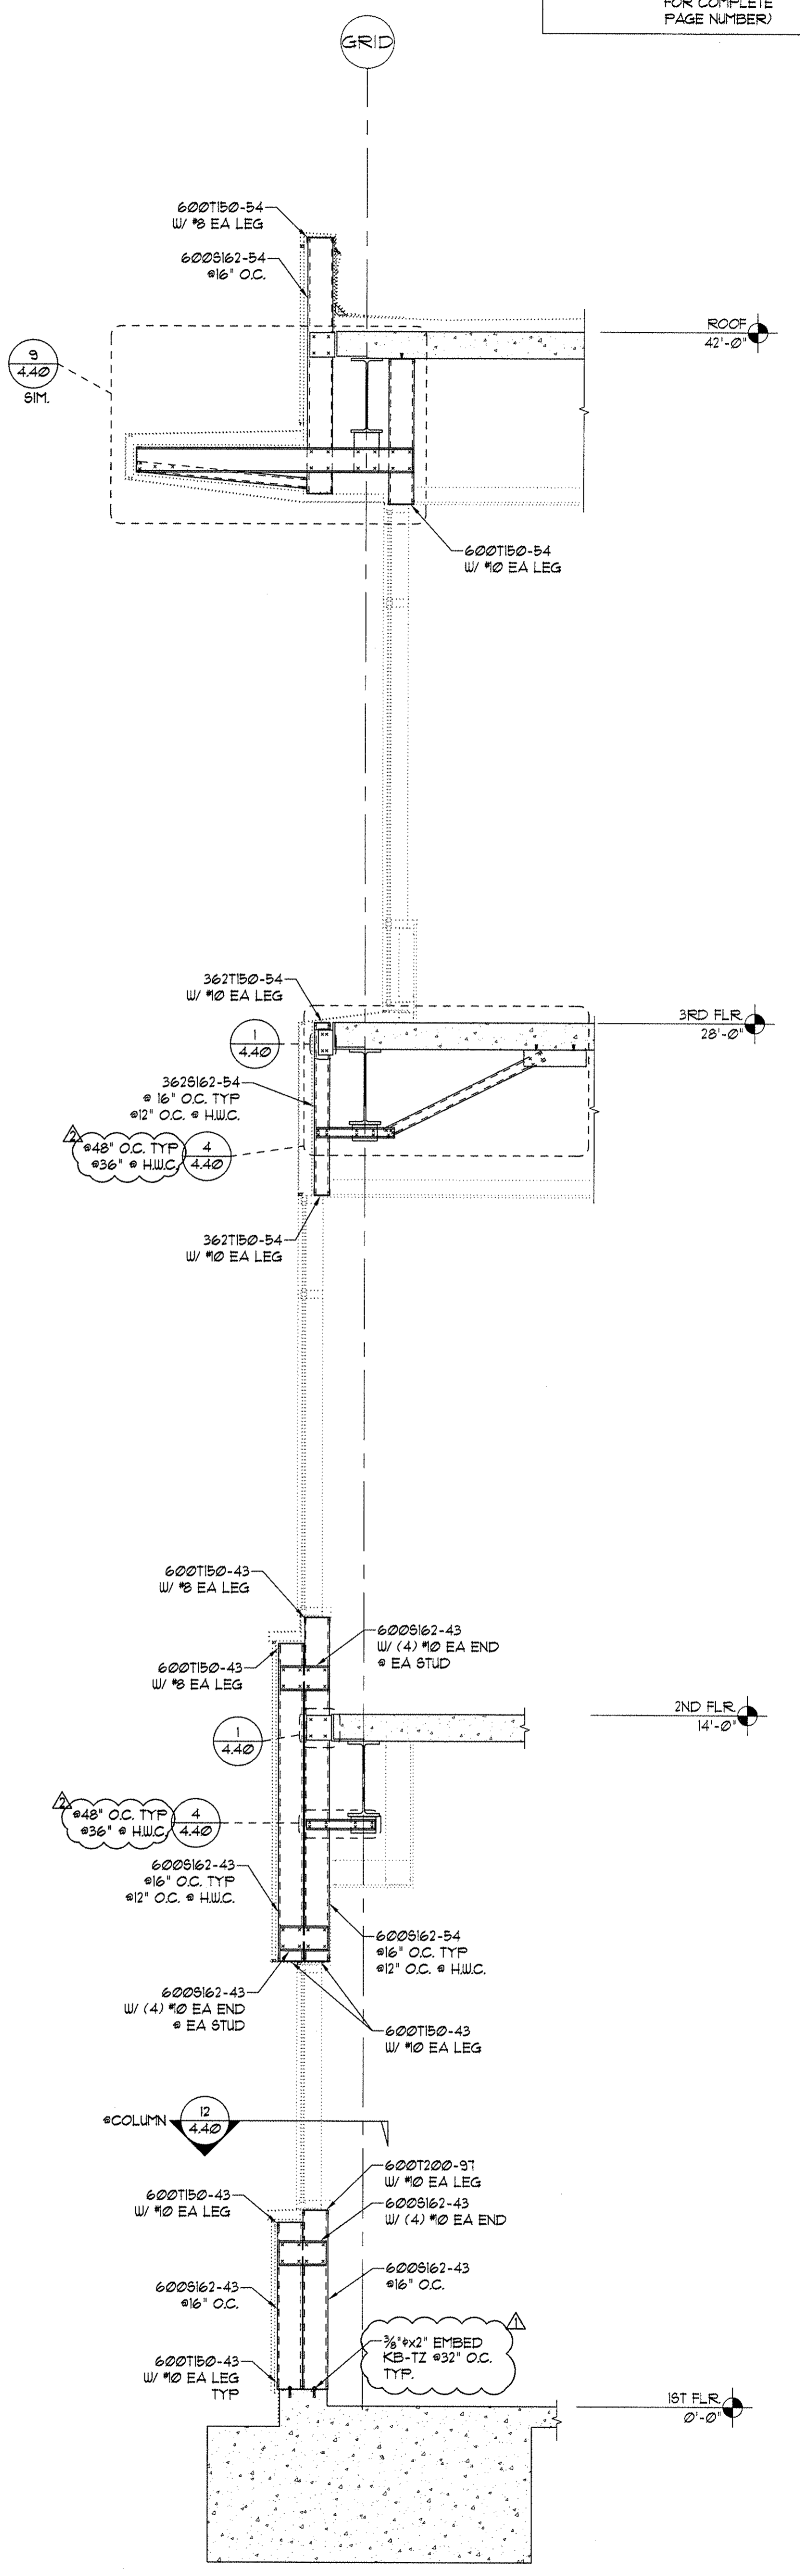


1 WALL SECTION  
 SCALE: 1/2"=1'-0"  
 REF. 3/A3.31

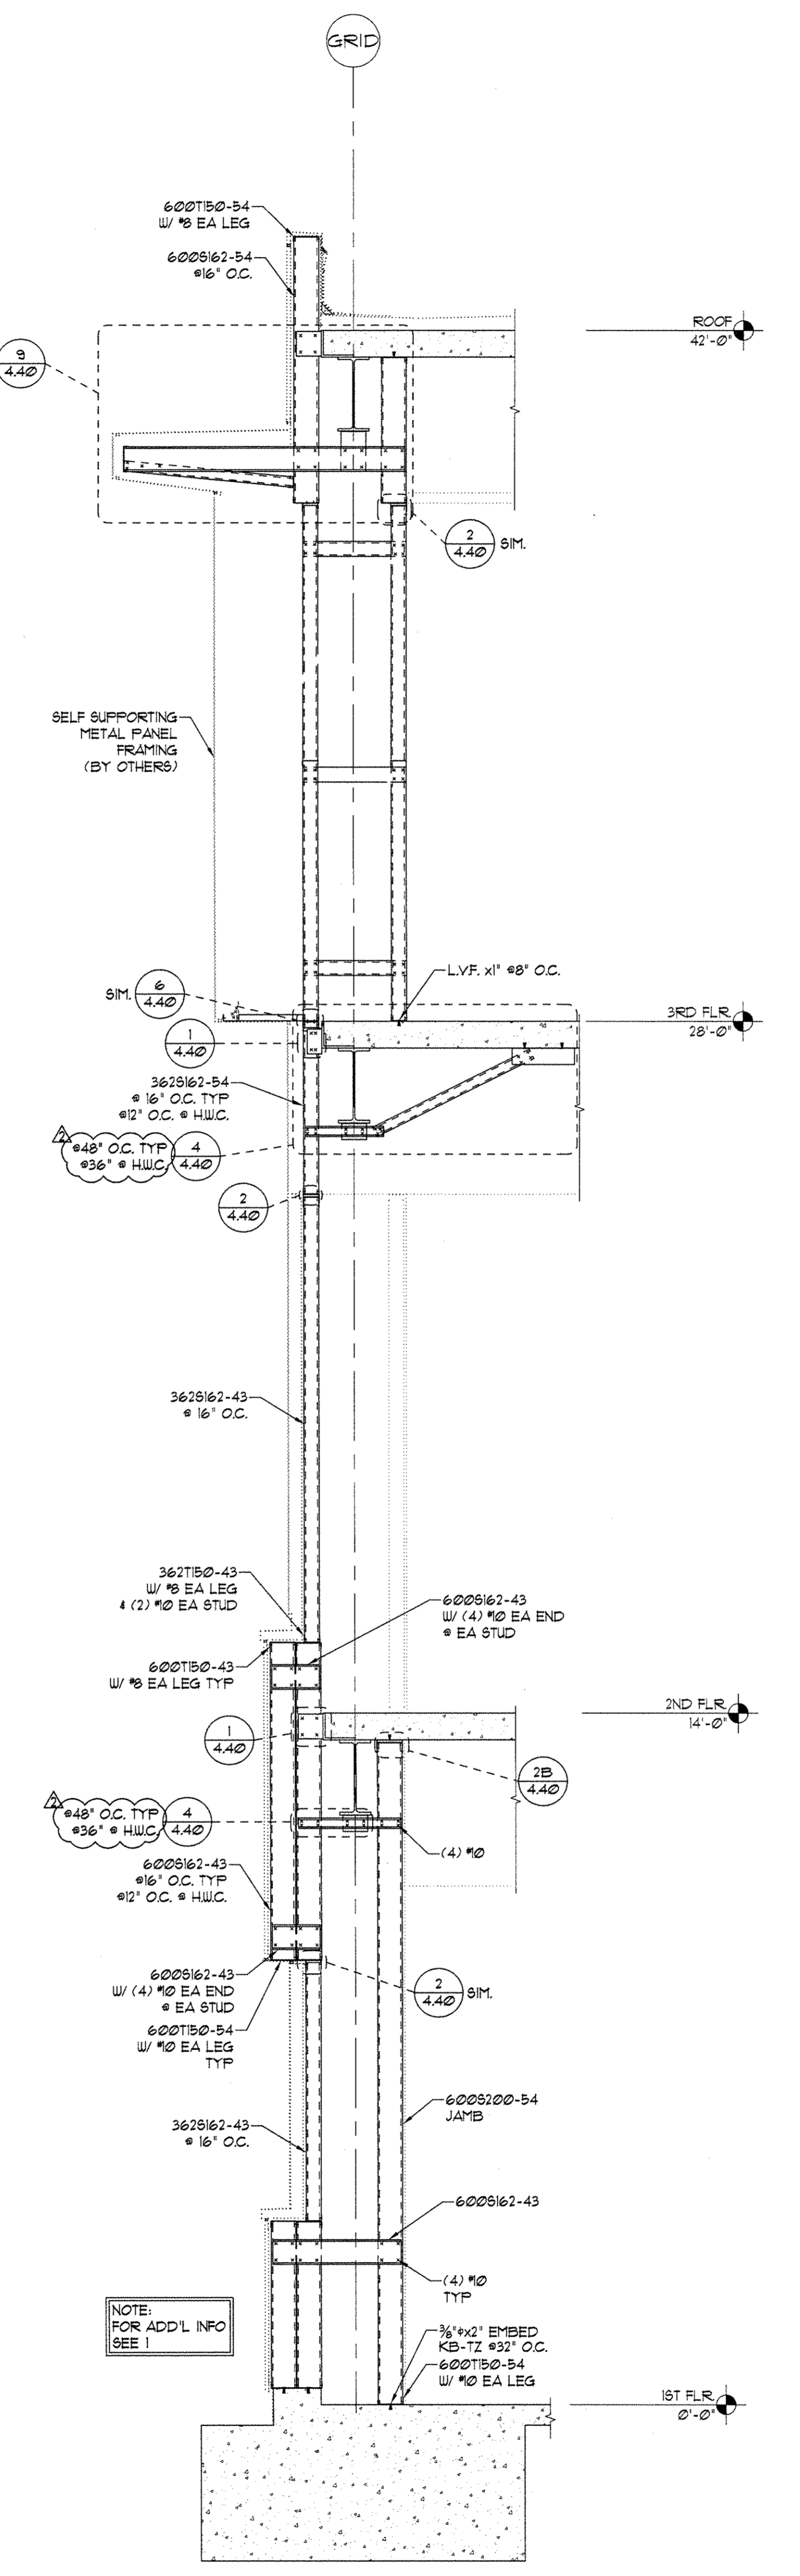

2 WALL SECTION  
 SCALE: 1/2"=1'-0"  
 REF. 2/A3.31

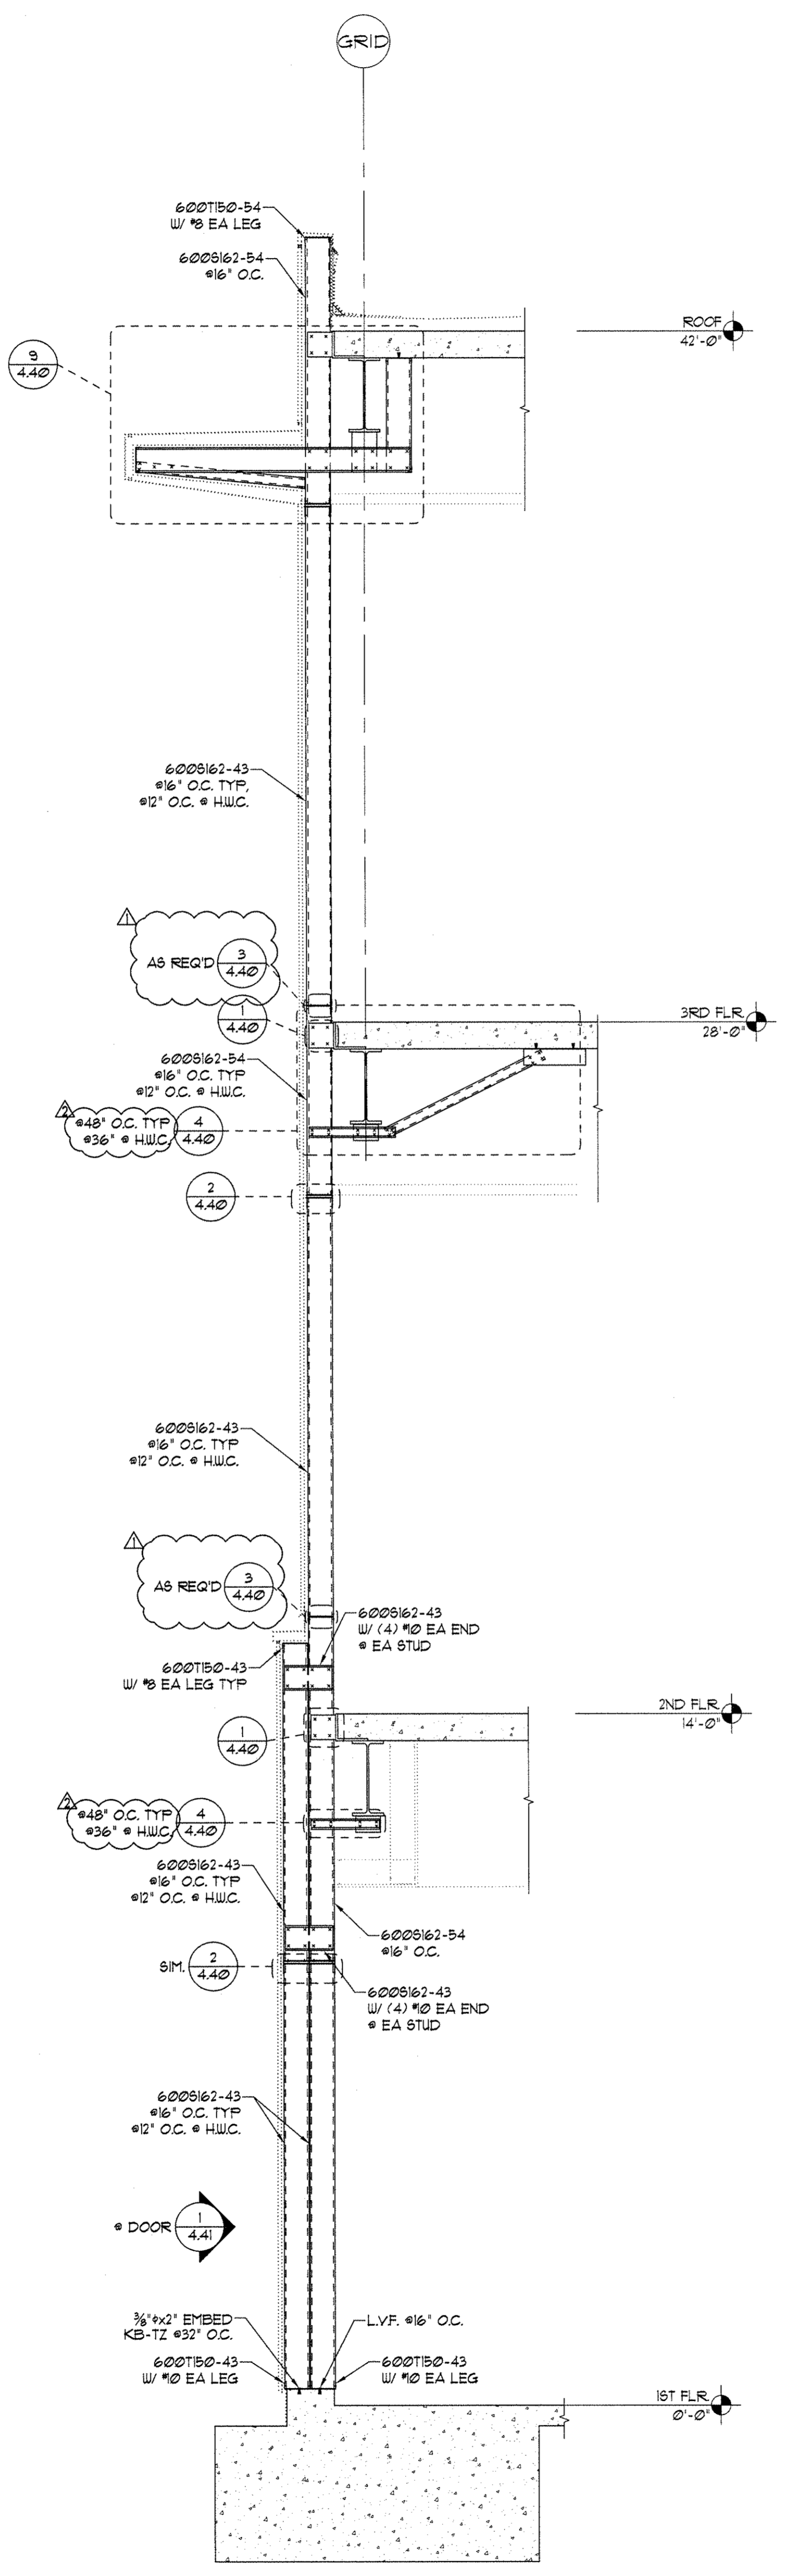


3 WALL SECTION  
 SCALE: 1/2"=1'-0"  
 REF. 1/A3.31

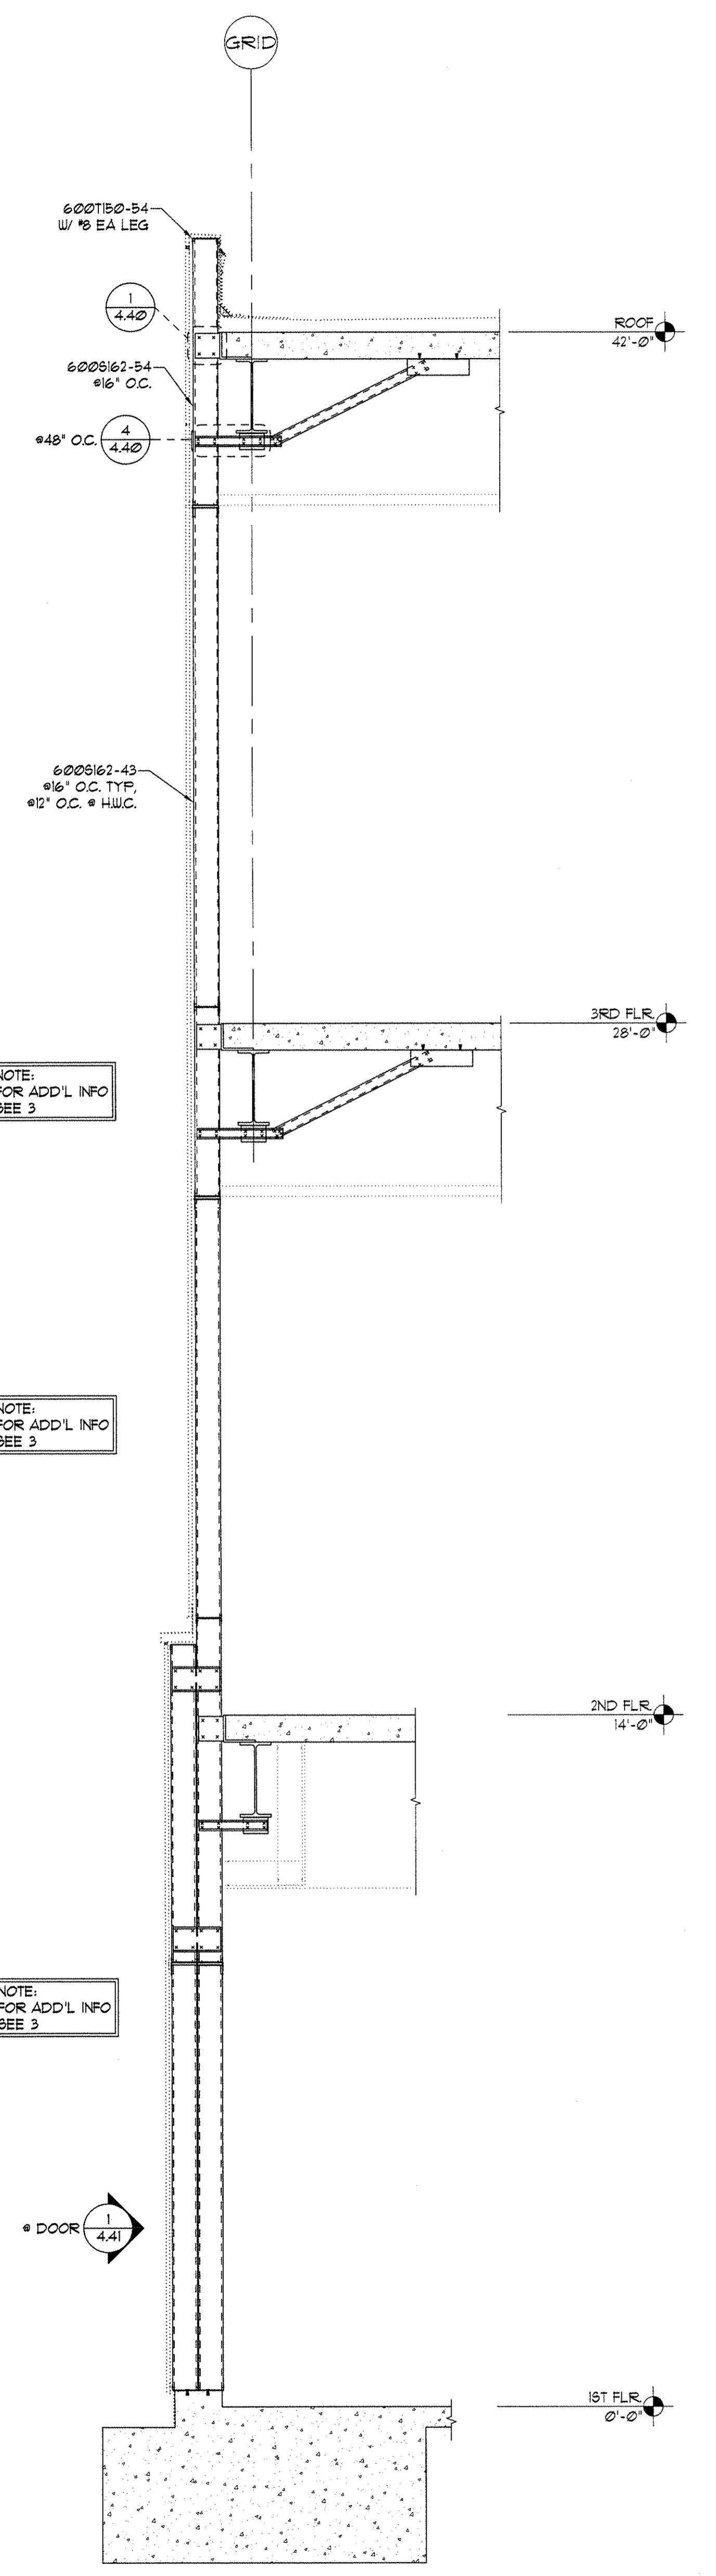


4 WALL SECTION  
 SCALE: 1/2"=1'-0"  
 REF. SIM 1/A3.31

FILE: s:\08\08013 College of San Mateo\10-11-10\TEMP\08013420 WALL SECTIONS.dwg 11/17/10 08:48 - Ben


FILE No. J:\08\08013 College of San Mateo\10-13-10 Sem\REVISED 11-11-10\TEMP\08013\08013.dwg WALL SECTIONS.dwg 11/12/10 08:47 - Ben

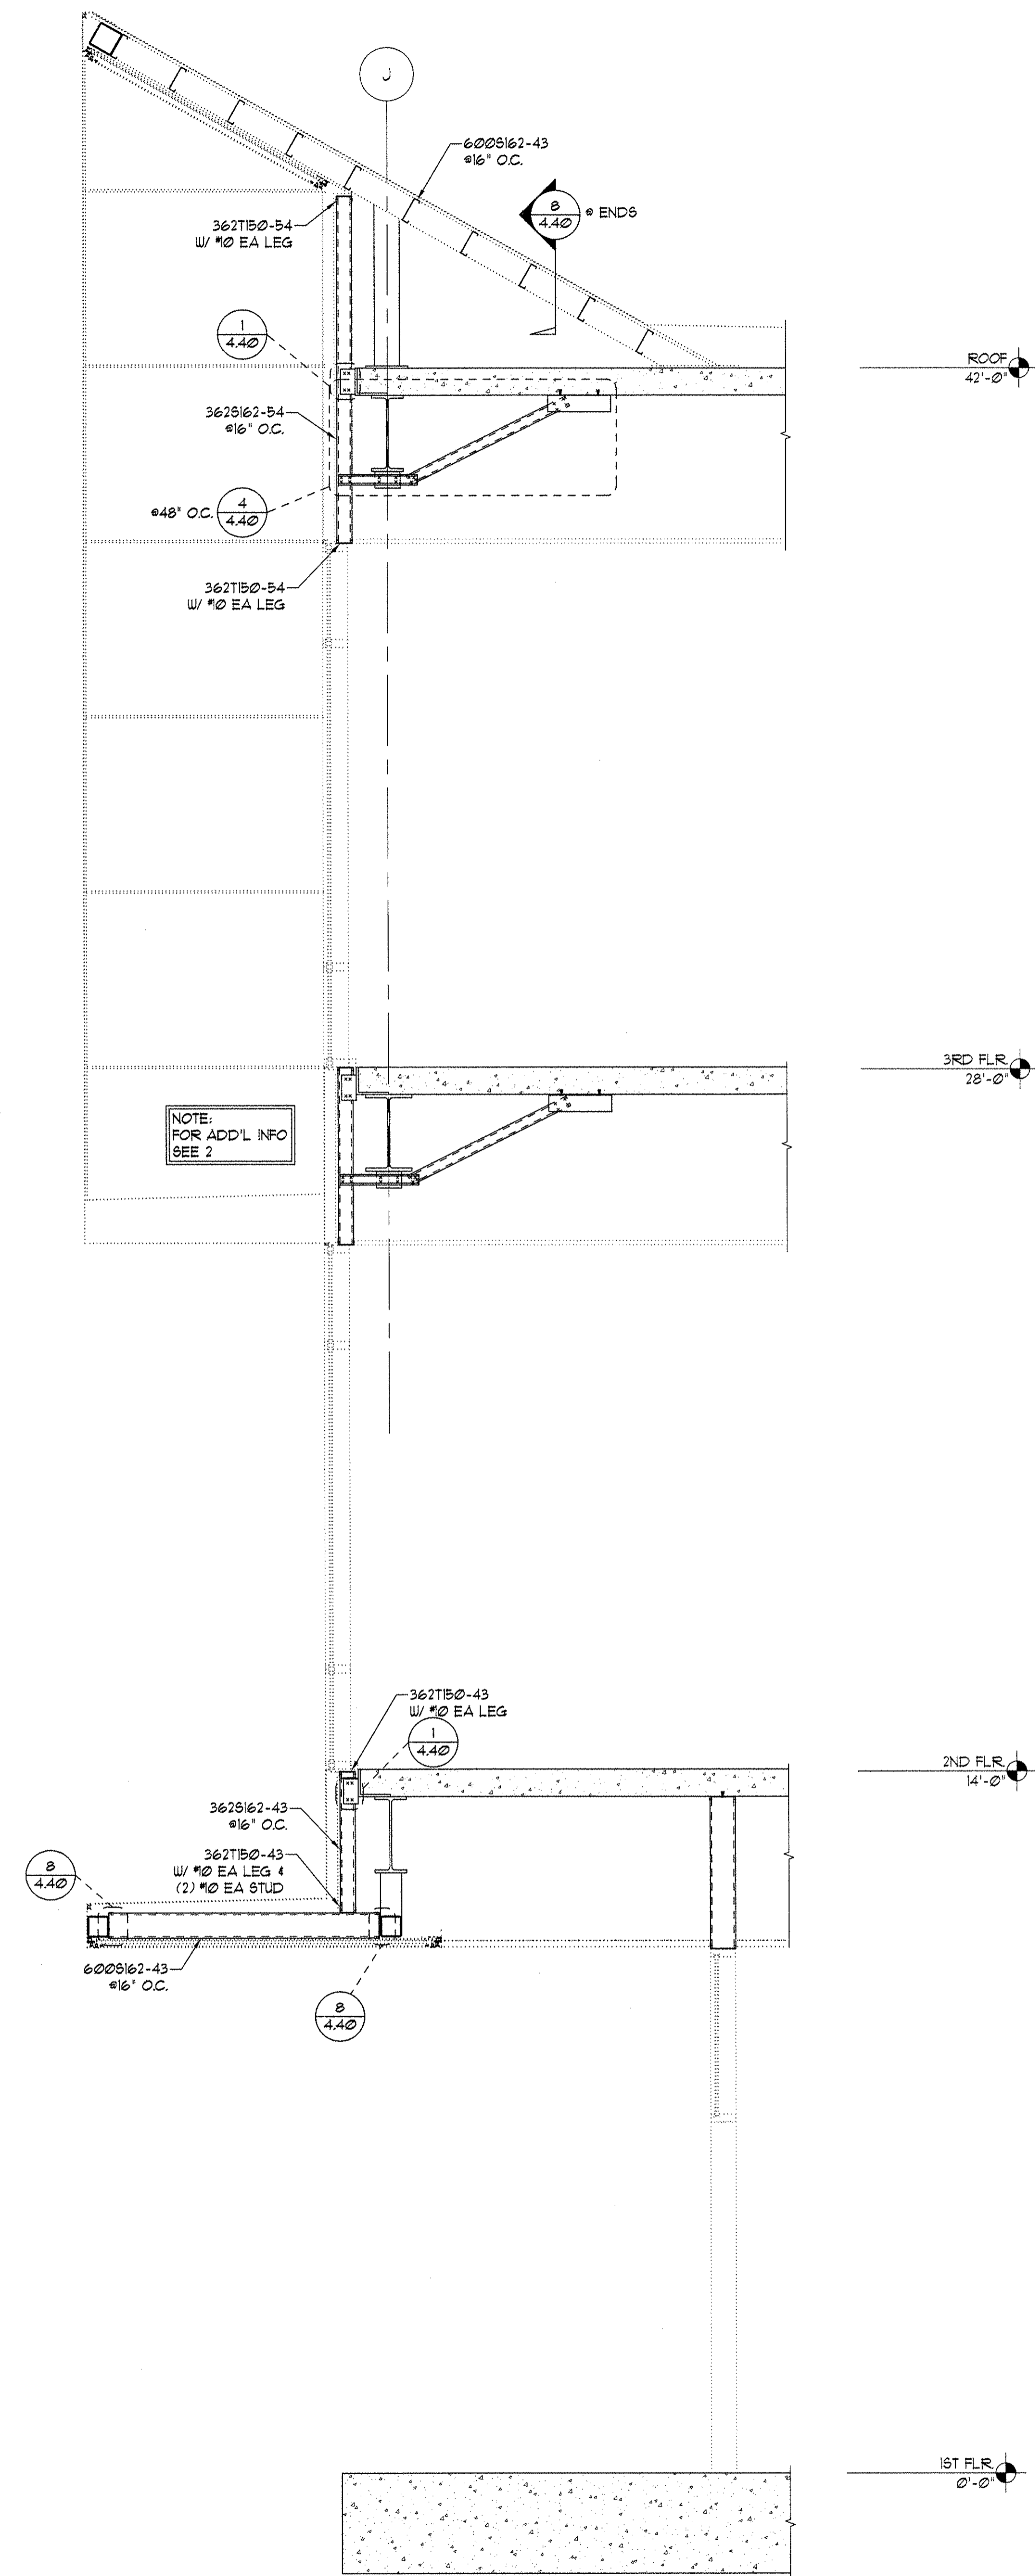

3 WALL SECTION  
SCALE: 1/4"=1'-0"  
REF. 2/A3.32

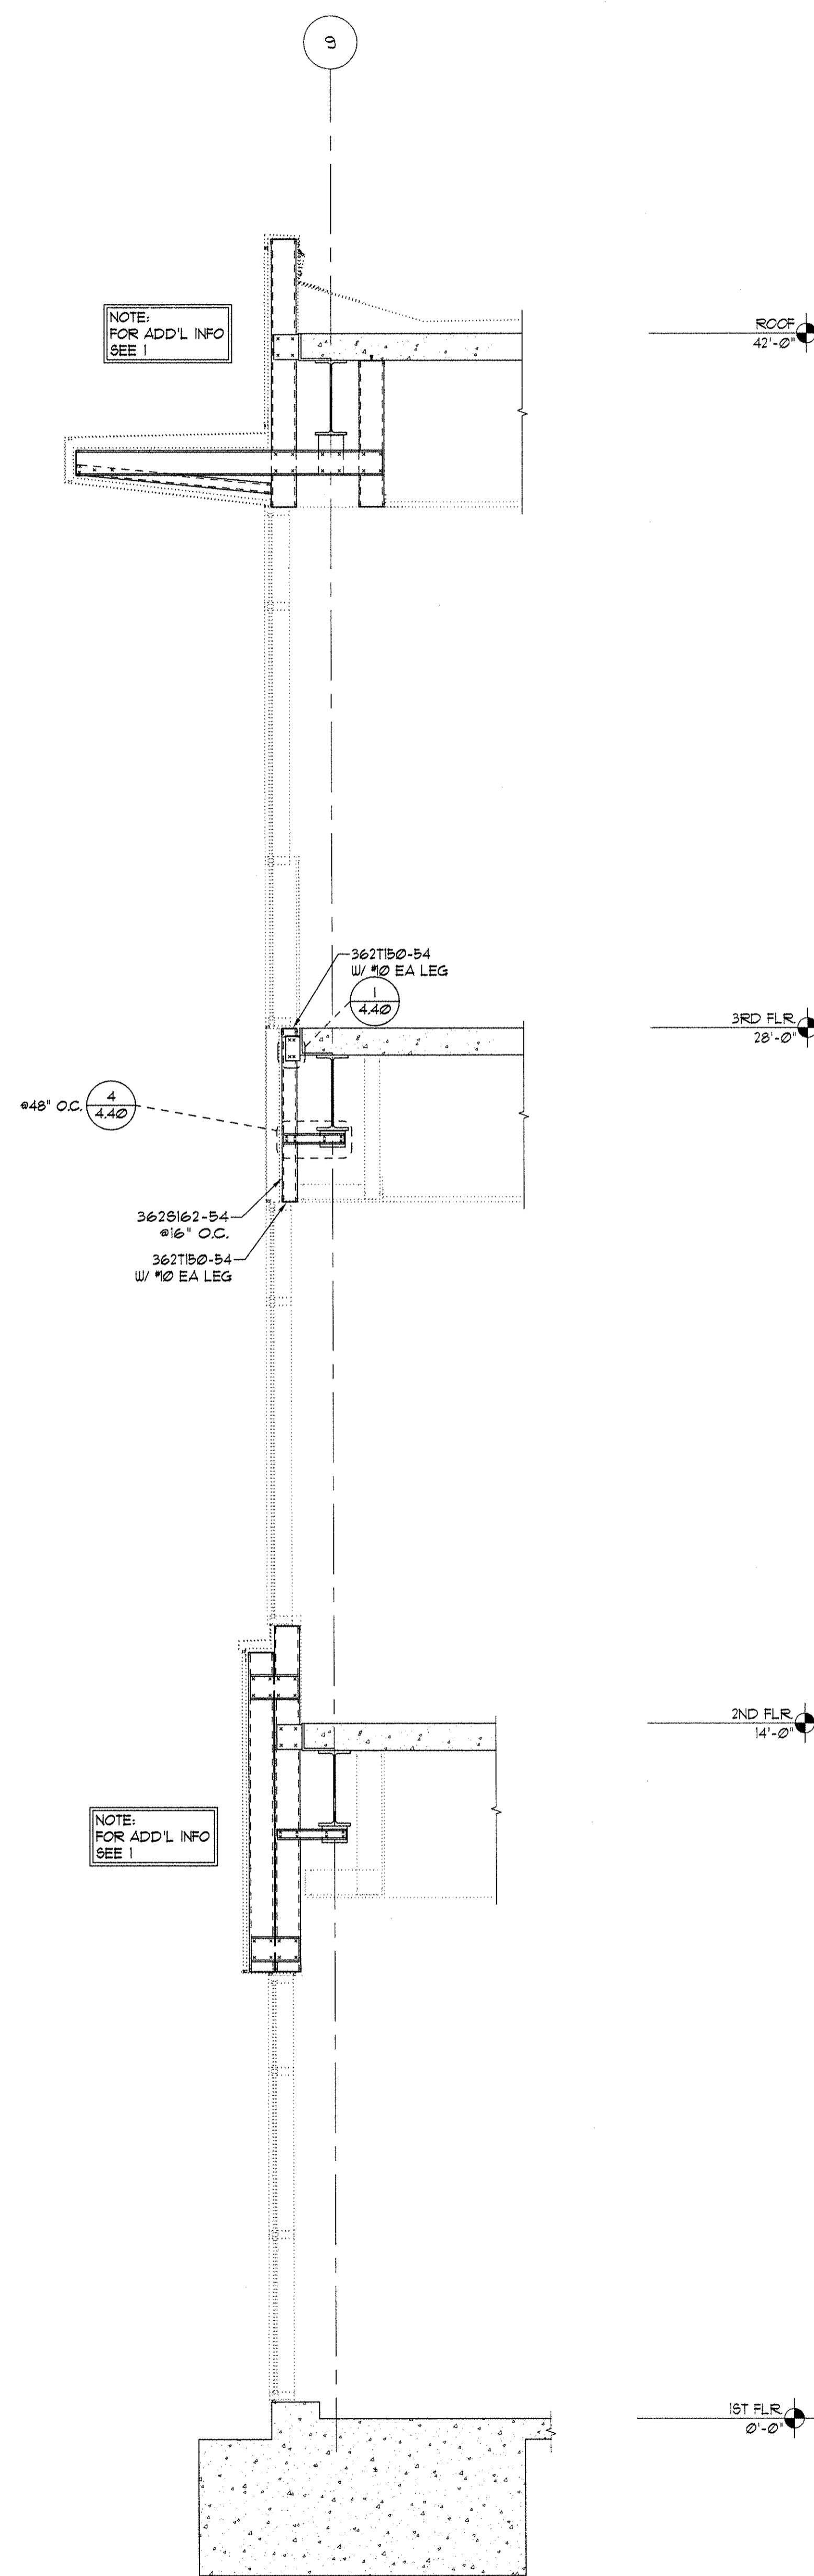


2 WALL SECTION  
SCALE: 1/4"=1'-0"  
REF. 4/A3.31

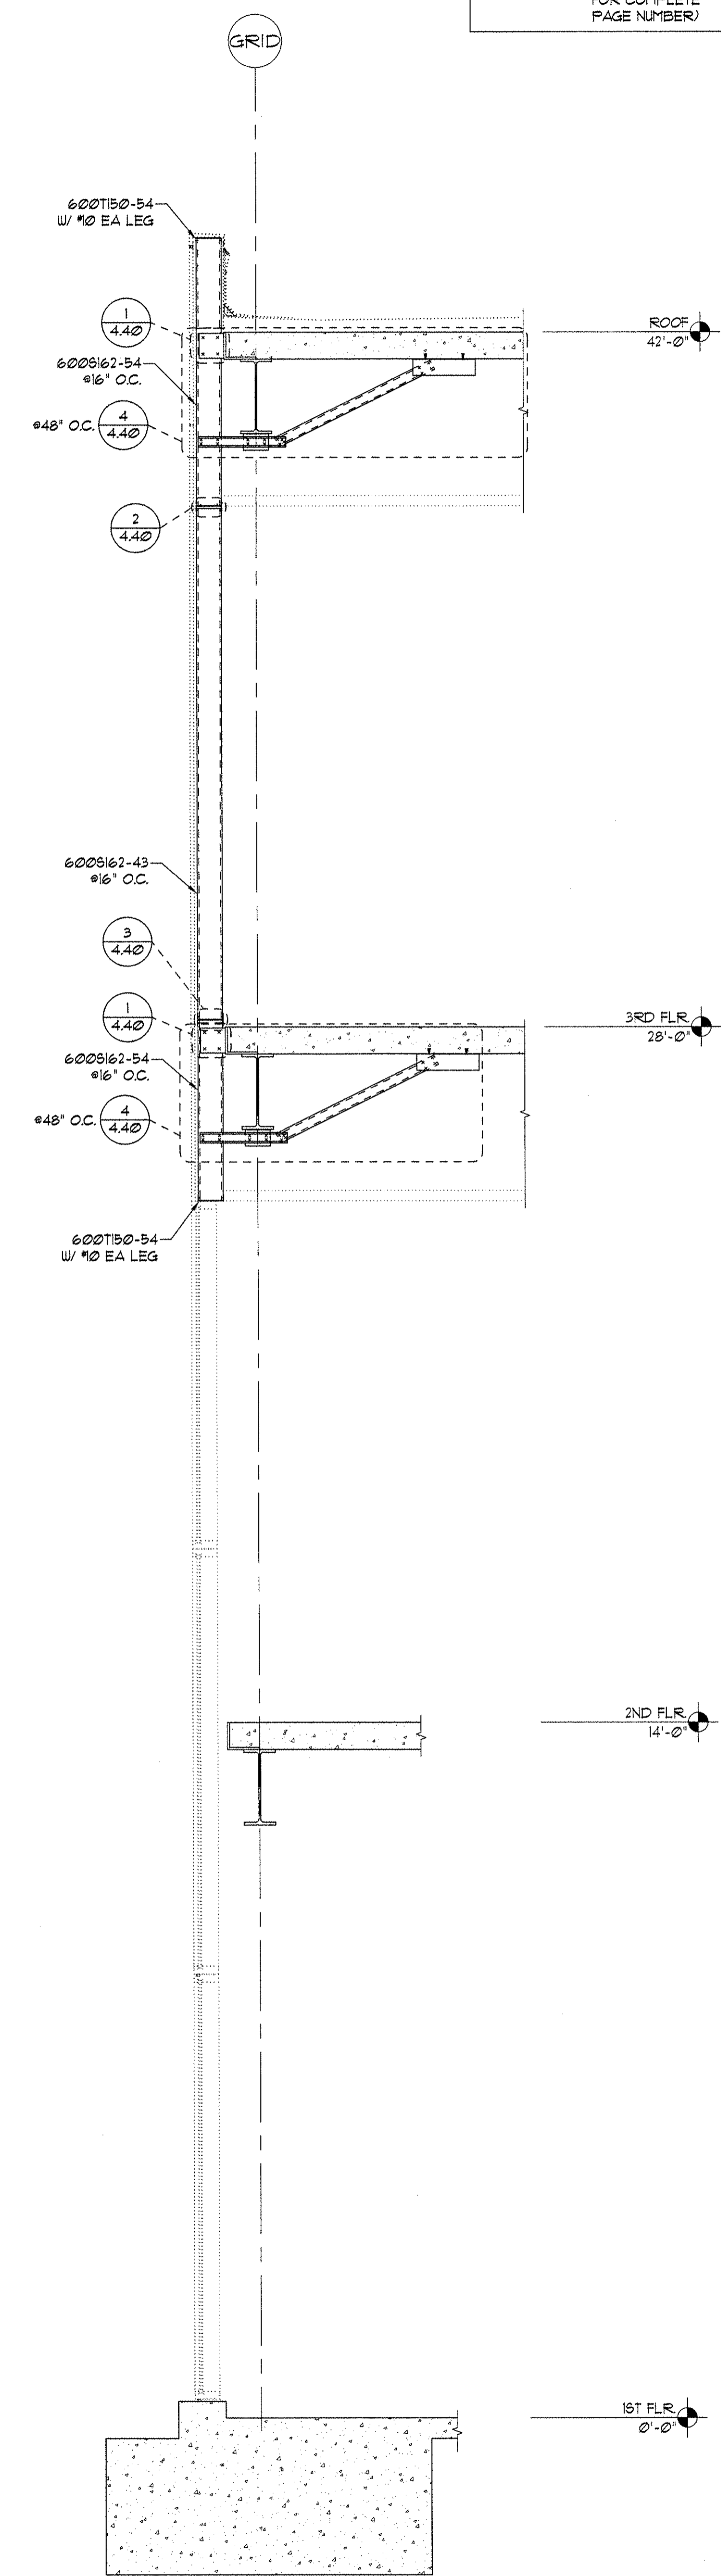


1 WALL SECTION  
SCALE: 1/4"=1'-0"  
REF. 61M 3/A3.31

DETAIL NUMBER  
XX  
XXX  
PAGE NUMBER  
(ADD PREFIX OF  
FOR COMPLETE  
PAGE NUMBER)

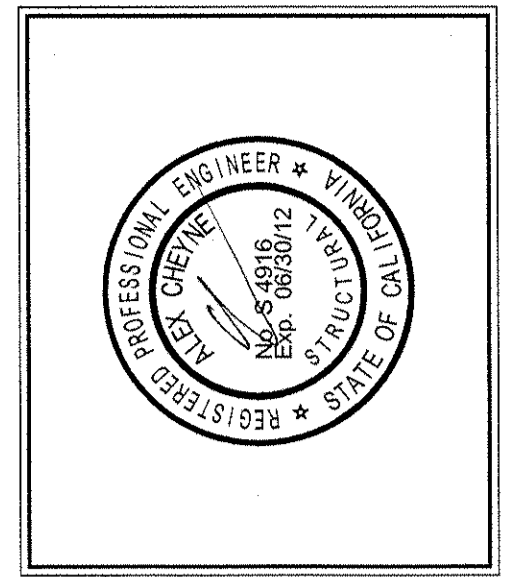

DRAWING STATUS	DATE	NO.	REVISION	DATE	REVISION
<input type="checkbox"/> PRELIMINARY					
<input checked="" type="checkbox"/> SUBMITTED	5/05/08	1	SET ISSUED PER DSA REVIEW	10/09/08	
<input type="checkbox"/> BID SET					
<input type="checkbox"/> PERMIT SET					
<input type="checkbox"/> CONST. SET					
<input checked="" type="checkbox"/> RECORD DRAWING	11/11/10				


**devco**  
 engineering inc.  
 246 NE CORVALLIS, OR 97339  
 CORVALLIS, OR 97339  
 WWW.DEVCOENGINEERING.COM  
 © COPYRIGHT 2010  
 DEVCO ENGINEERING, INC.  
 ALL RIGHTS RESERVED.

PROJECT: COLLEGE OF SAN MATEO  
 BUILDING 5N  
 PROJECT LOCATION:  
 SAN MATEO, CA  
 CLIENT: NORTHBAY DRYWALL

SHEET TITLE:  
 WALL SECTIONS

JOB NO. 08-013  
 DRAWN BY: DEVCO  
 DRAWING:  
**SF 4.21**







FILE No. 23.05.02013 College of San Mateo \11-12-10\_SanMateo\08013423 WALL SECTIONS.dwg 11/27/10 08:46 - Ben

NOTE:  
FOR ADD'L INFO  
SEE 2


NOTE:  
FOR ADD'L INFO  
SEE 2

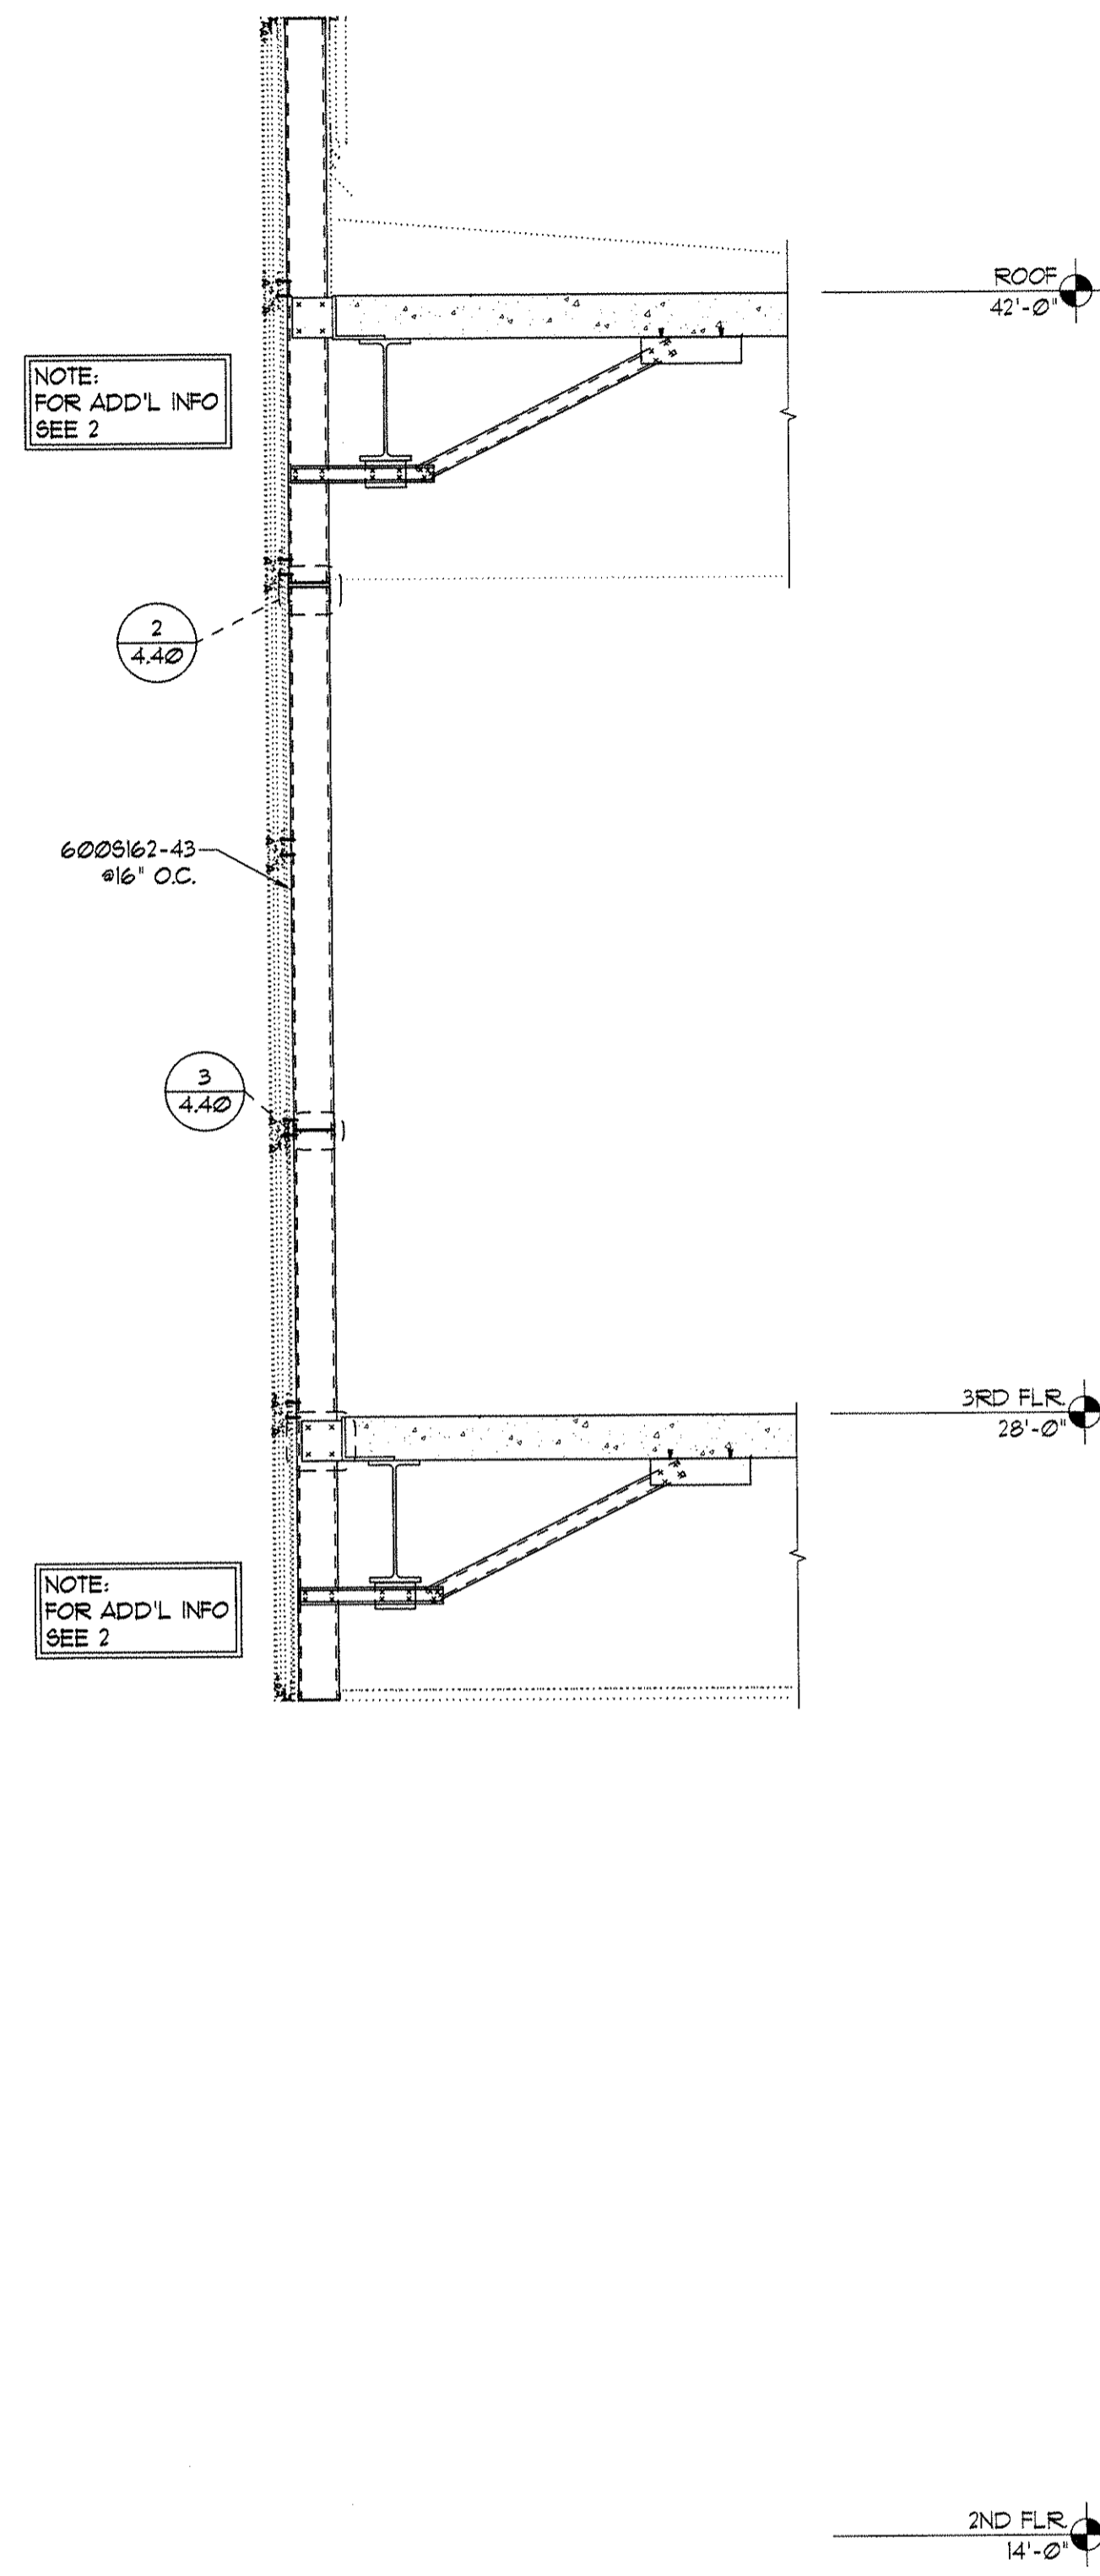


3 WALL SECTION  
SCALE: 1/2"=1'-0" REF. 511/A3.34

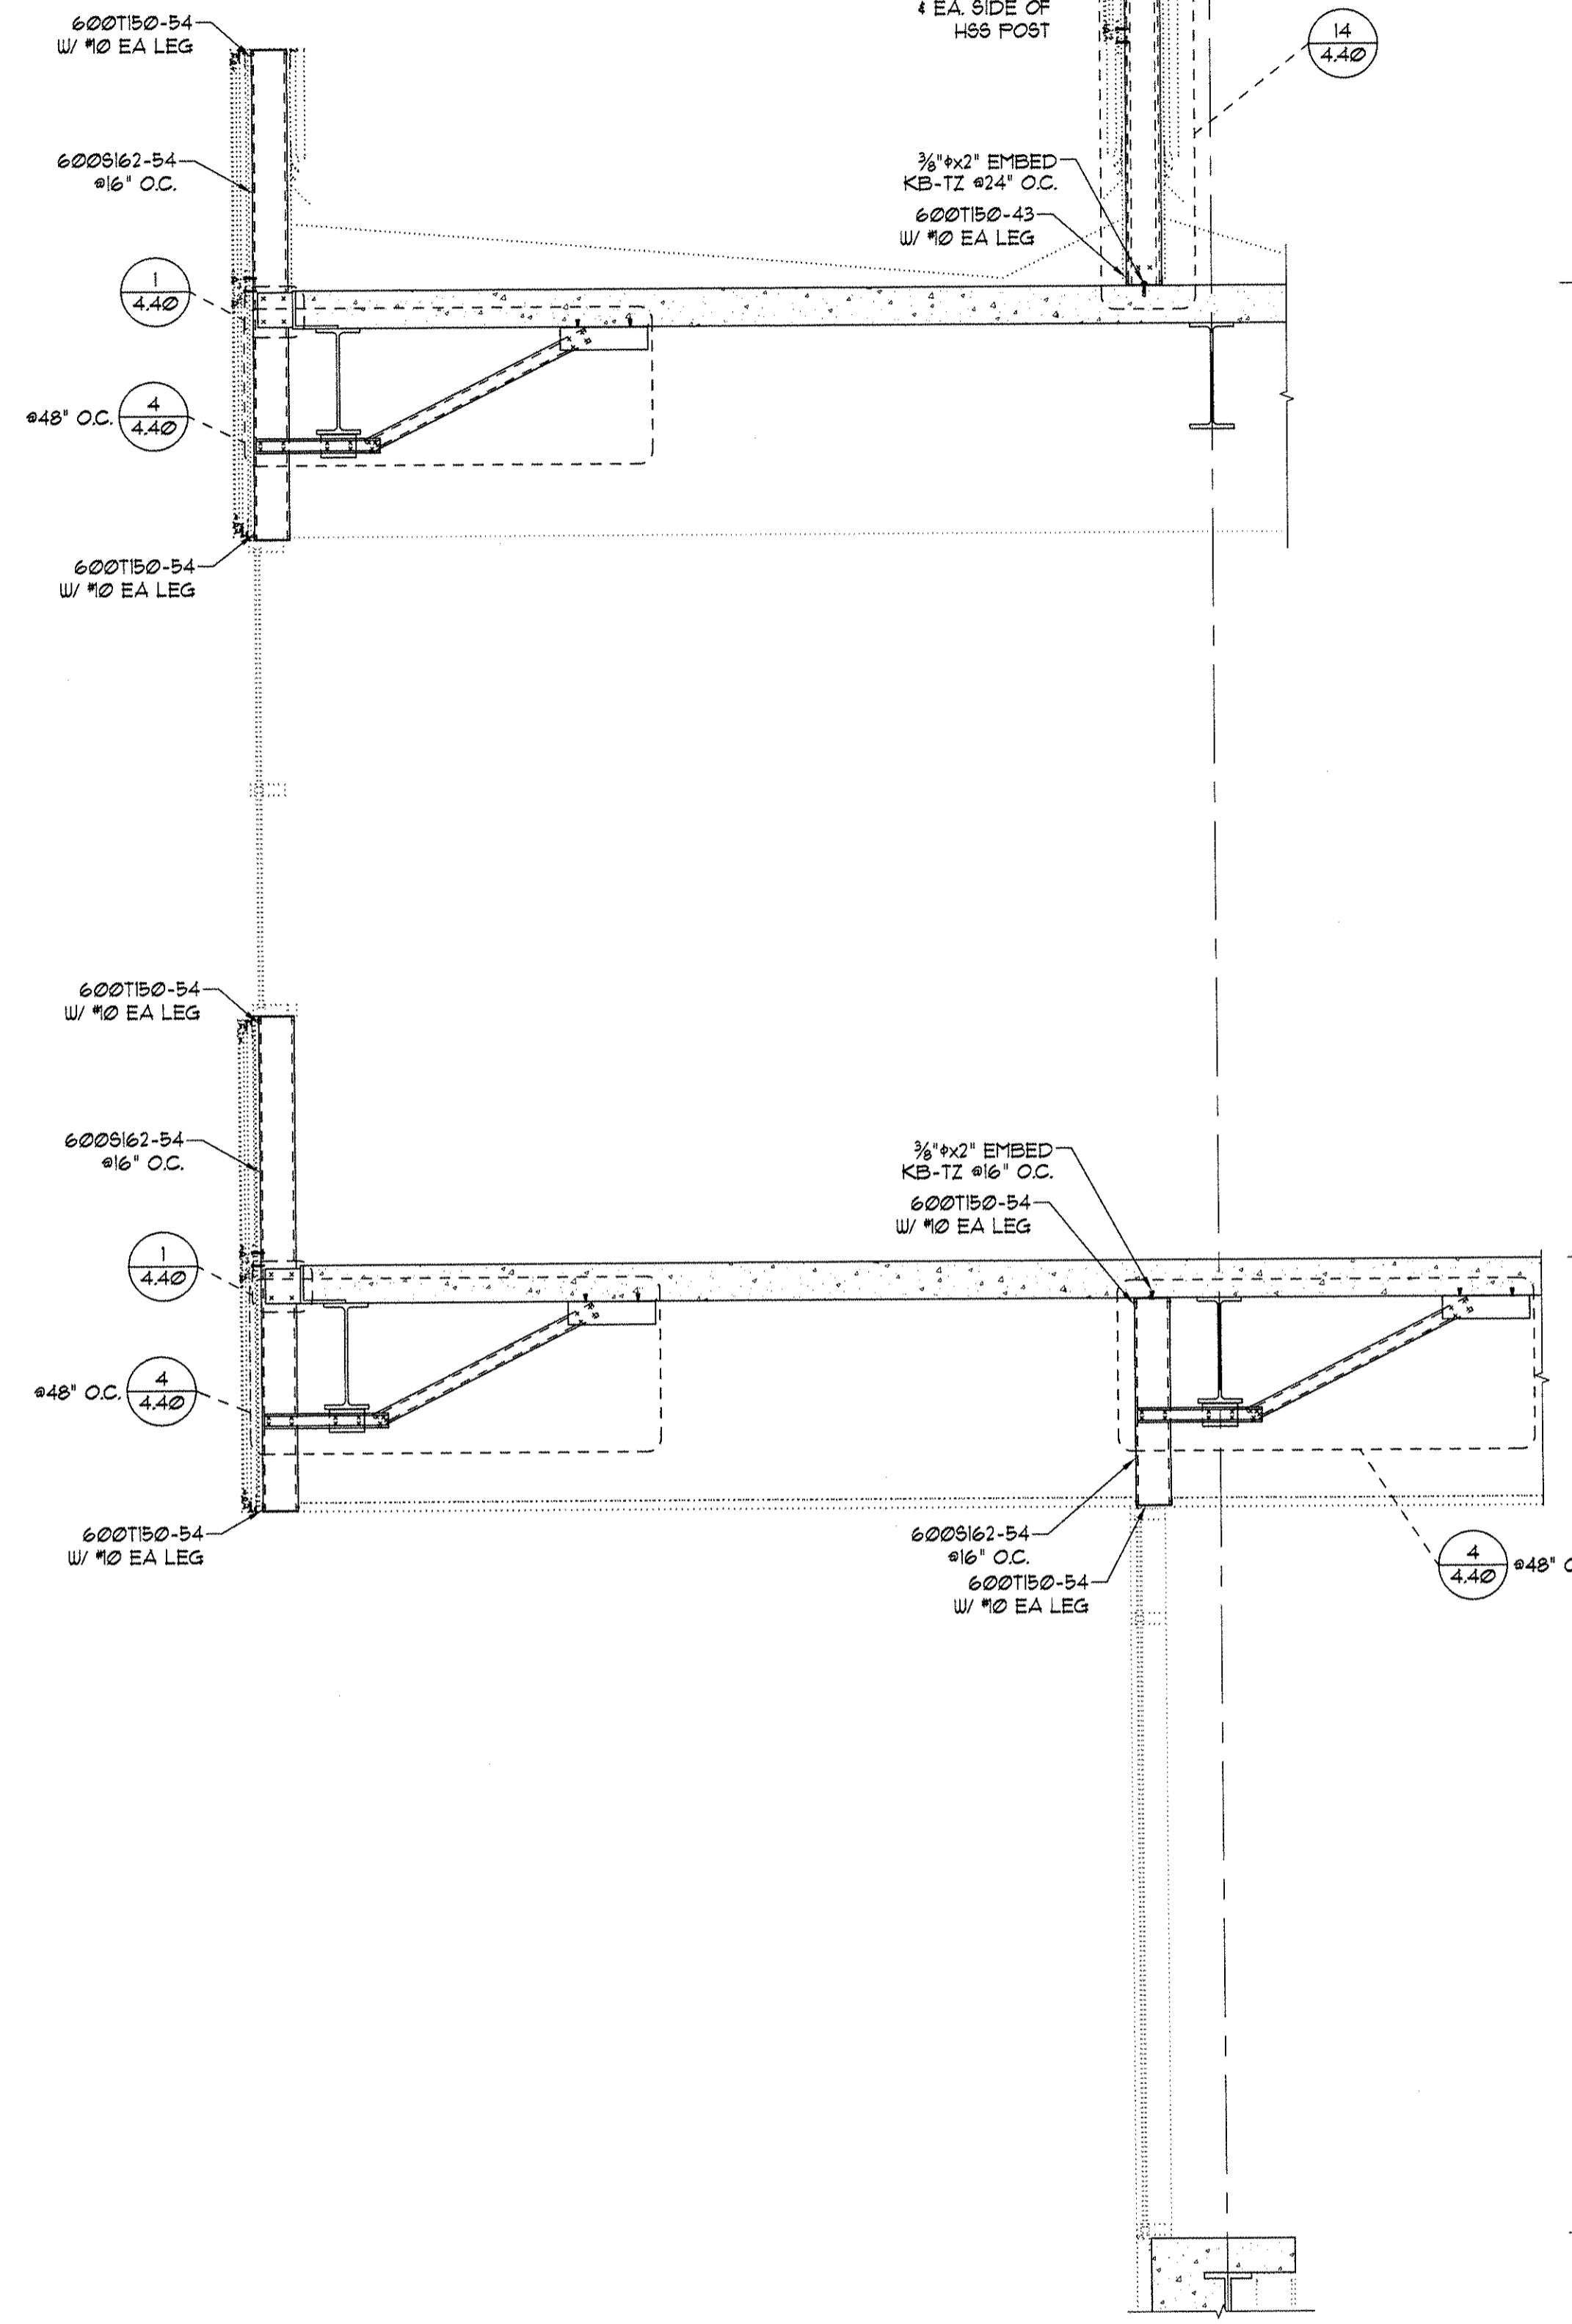

2 WALL SECTION  
SCALE: 1/2"=1'-0" REF. 1/A3.34

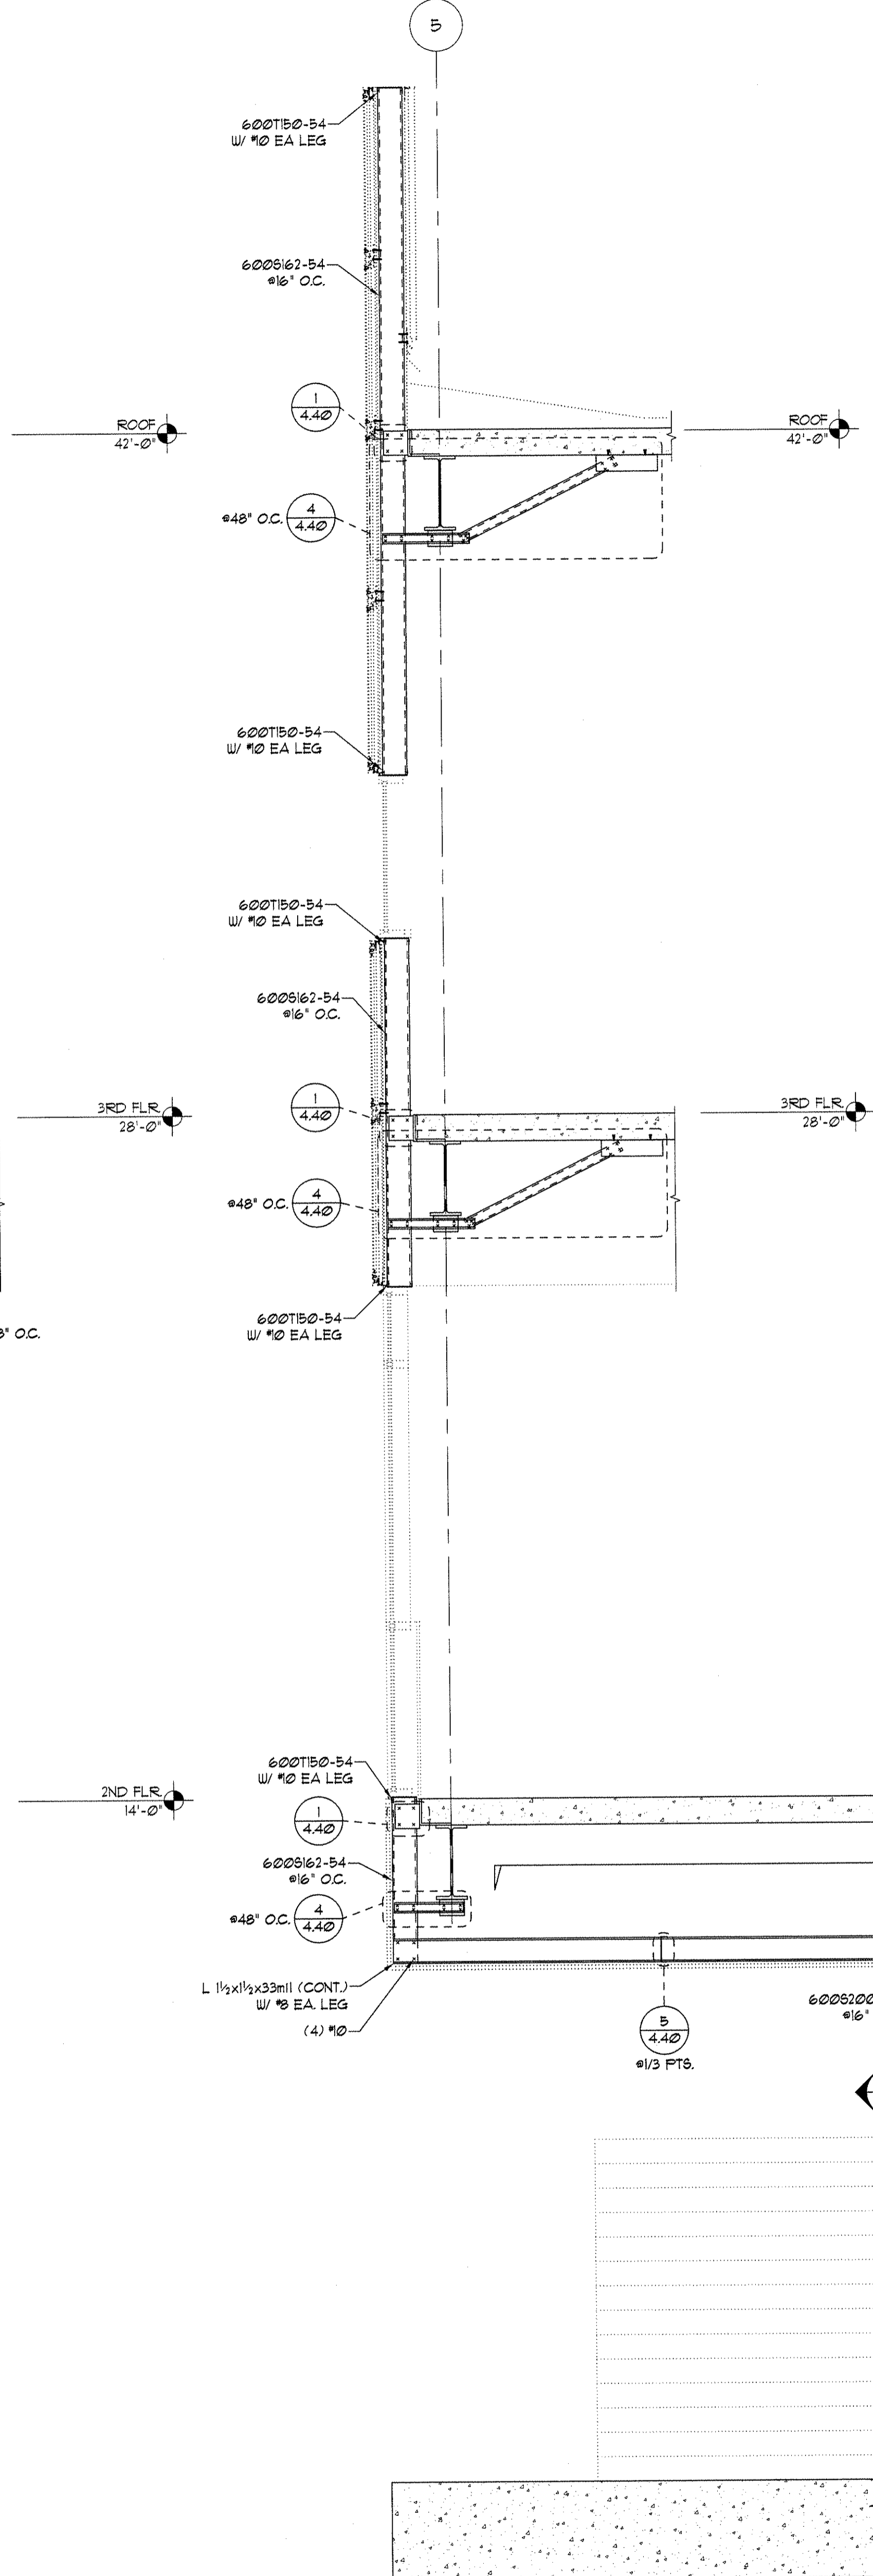


1 WALL SECTION  
SCALE: 1/2"=1'-0" REF. 3/A3.33

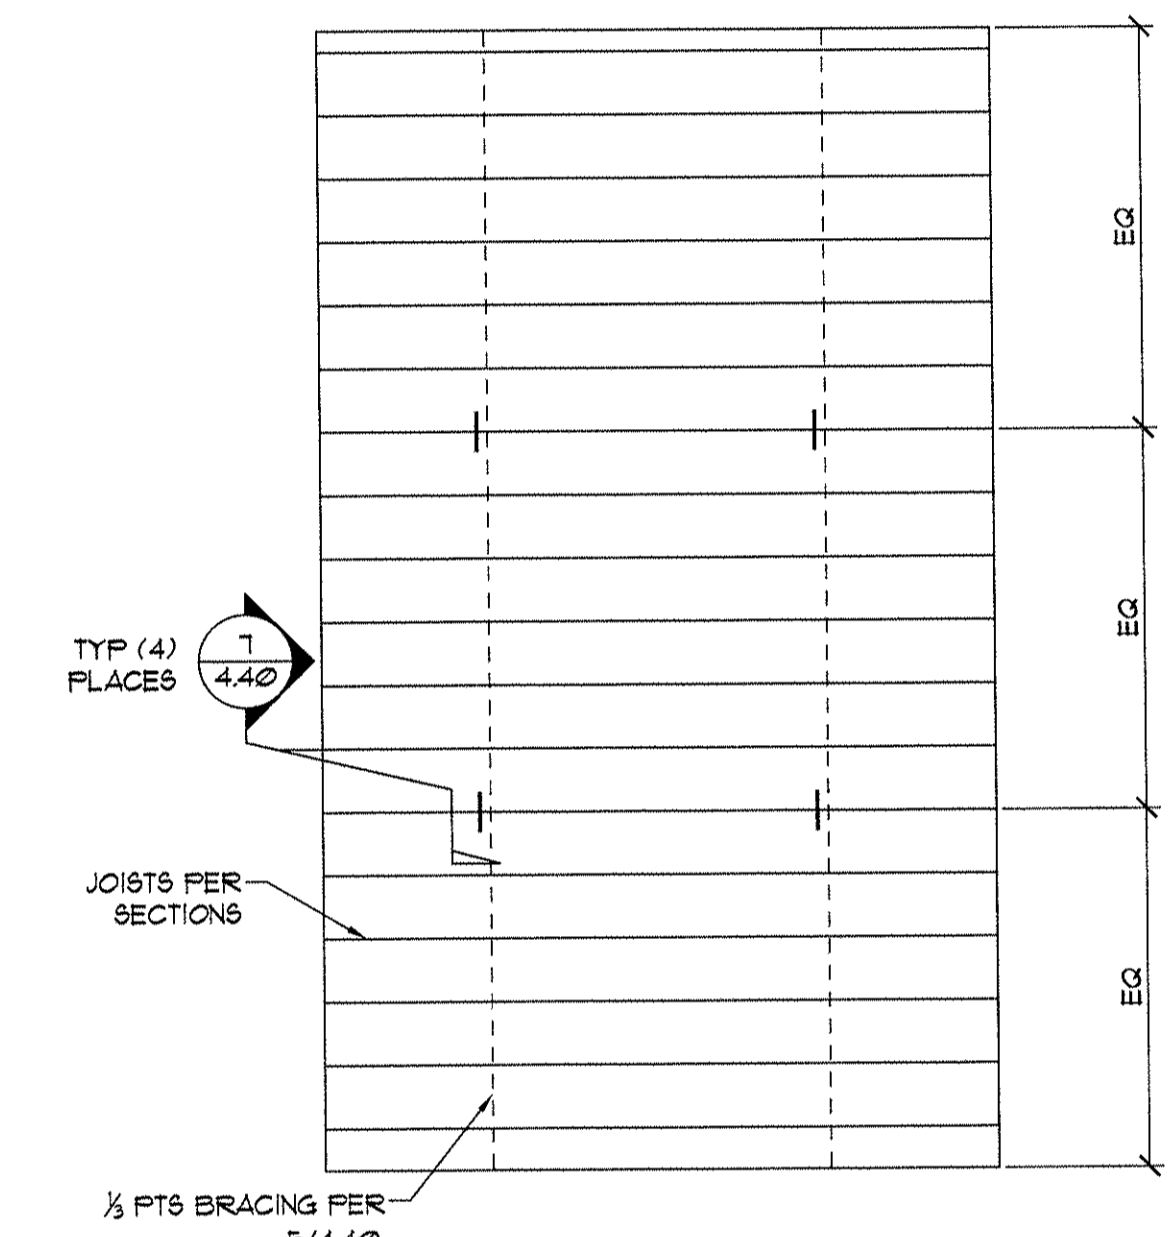

1A SOFFIT PLAN  
SCALE: N.T.S.

DETAIL NUMBER  
XX  
XXX  
PAGE NUMBER  
(ADD PREFIX 5P  
FOR COMPLETE  
PAGE NUMBER)

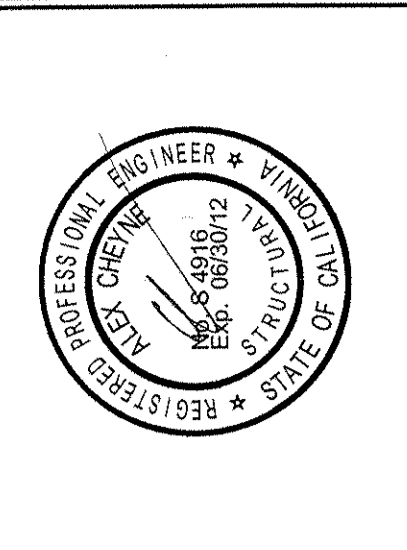

DATE:	10/09/08
REVISION:	1 SET ISSUED PER CSA REVIEW
DATE:	5/05/08
DRAWING STATUS:	<input type="checkbox"/> PRELIMINARY <input checked="" type="checkbox"/> SUBMITTED <input type="checkbox"/> BID SET <input type="checkbox"/> PERMIT SET <input type="checkbox"/> CONST. SET <input checked="" type="checkbox"/> RECORD DRAWING

**devco**  
 engineering inc.  
 245 NE CONIFER, P.O. BOX 1201  
 CORVALLIS, OR 97339  
 WWW.DEVCOENGINEERING.COM  
 © COPYRIGHT 2008  
 DEVCO ENGINEERING, INC.  
 ALL RIGHTS RESERVED.


PROJECT: COLLEGE OF SAN MATEO  
 BUILDING 0N  
 PROJECT LOCATION:  
 SAN MATEO, CA  
 CLIENT:  
 NORTHBAY DRYWALL

SHEET TITLE:  
 WALL SECTIONS

JOB NO. 08-013  
 DRAWN BY: DEVCO  
 DRAWING:  
**SF 4.23**





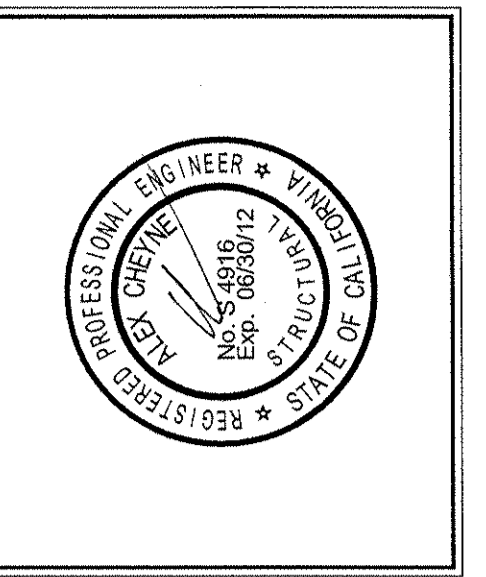


DRAWING STATUS	DATE	NO.	REVISION	DATE
<input type="checkbox"/> PRELIMINARY				
<input checked="" type="checkbox"/> SUBMITTED	6/05/08	1	SET ISSUED PER DSA REVIEW	10/09/08
<input type="checkbox"/> BID SET				
<input type="checkbox"/> PERMIT SET				
<input type="checkbox"/> CONST. SET				
<input checked="" type="checkbox"/> RECORD DRAWING	11/11/10	2		

**devco**  
 engineering inc.  
 246 NE CONNER, BOX 1211  
 CORVALLIS, OR 97339  
 WWW.DEVCOENGINEERING.COM  
 © COPYRIGHT 2010  
 DEVCO ENGINEERING, INC.  
 ALL RIGHTS RESERVED.


PROJECT: COLLEGE OF SAN MATEO  
 BUILDING 5N  
 PROJECT LOCATION: SAN MATEO, CA  
 CLIENT: NORTHBAY DRYWALL

SHEET TITLE:  
**FRAMING DETAILS**


JOB NO. 08-013  
 DRAWN BY: DEVCO  
 DRAWING:  
**SF 4.41**

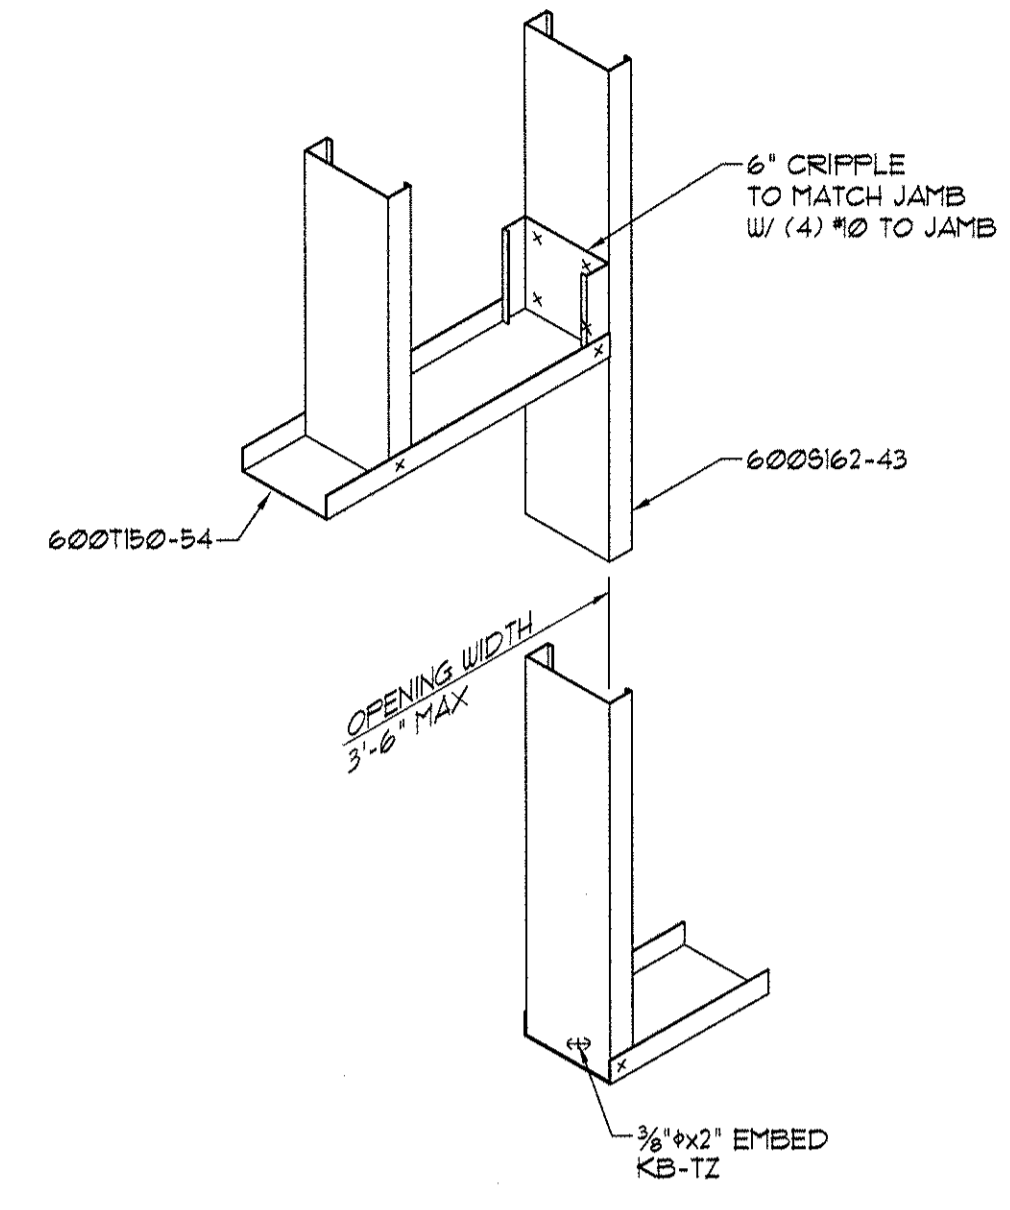


3 FRAMED OPENING  
SCALE: N.T.S.

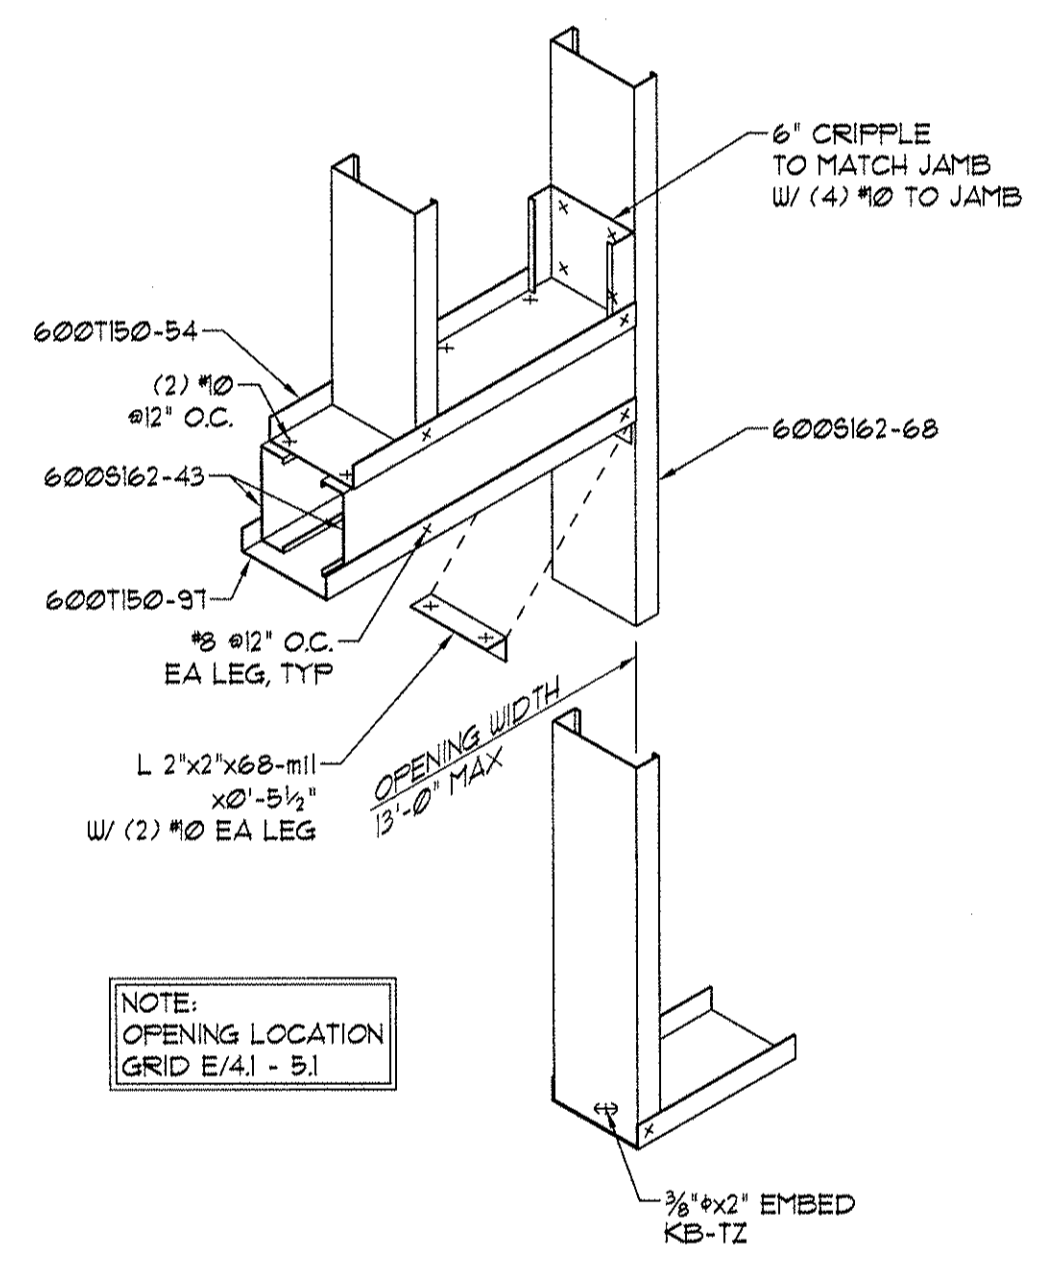


2 FRAMED OPENING  
SCALE: N.T.S.

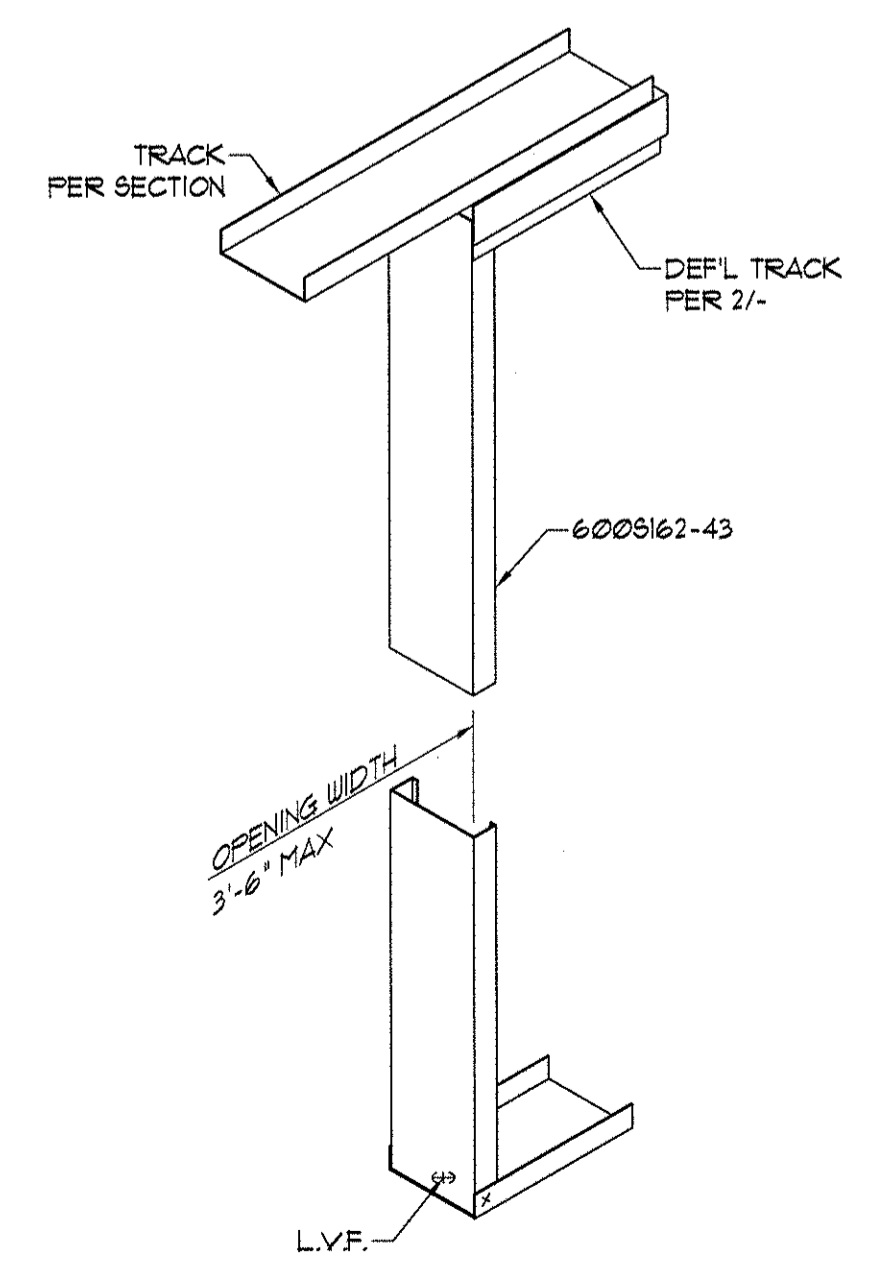

1 FRAMED OPENING  
SCALE: N.T.S.

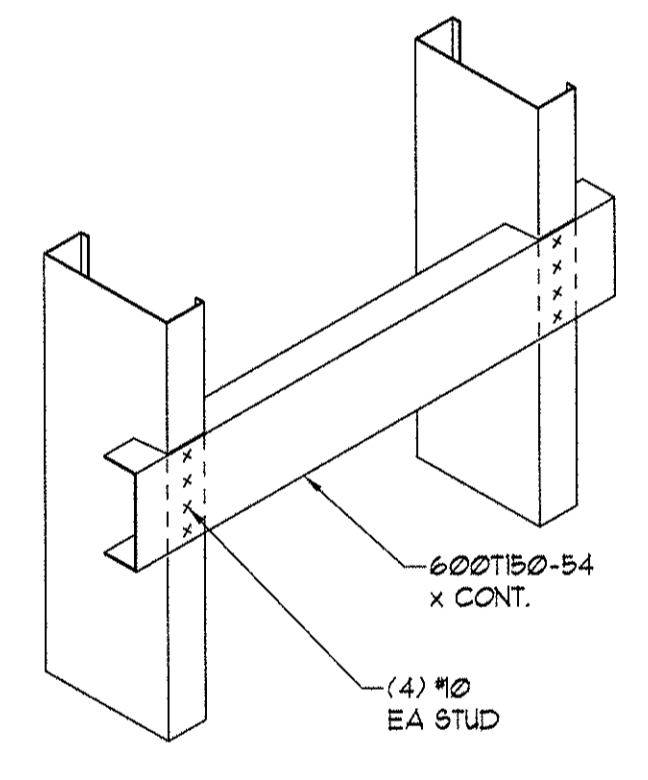

5 BACKING @ HEAVY LOADS  
SCALE: N.T.S.

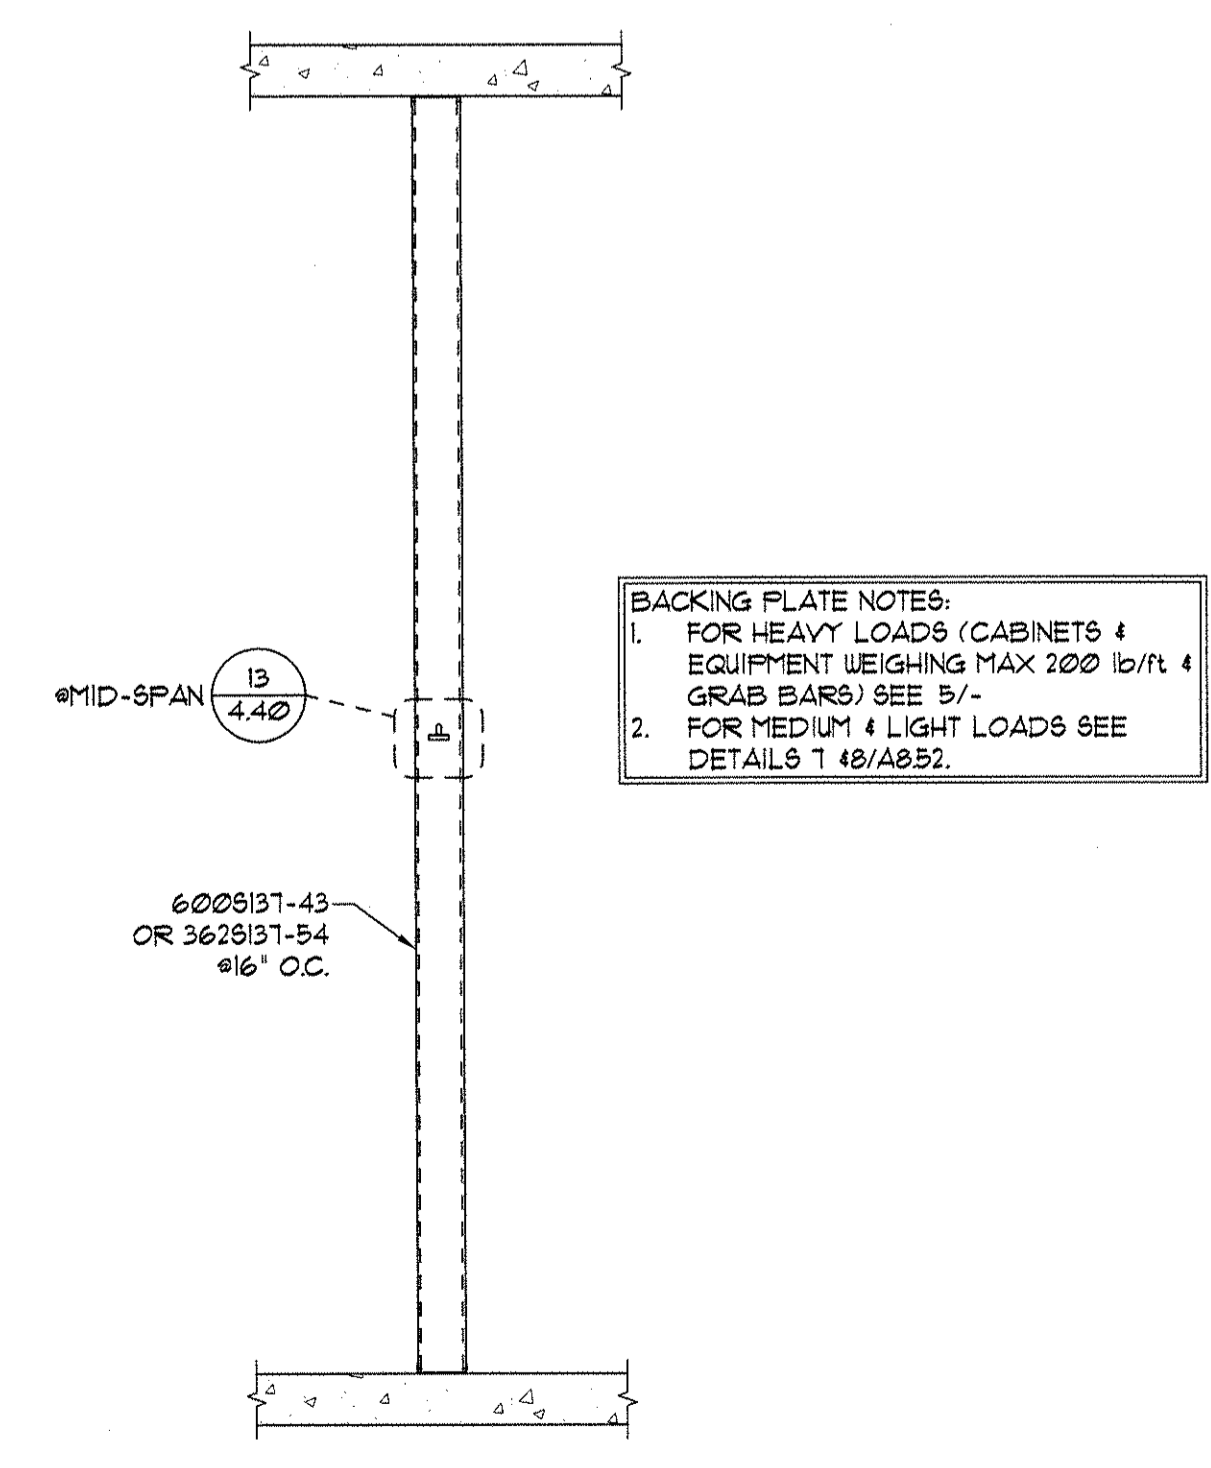


4 INTERIOR WALL STUDS @ HEAVY LOAD BACKING LOCATIONS  
SCALE: 1/4\"/>


**BACKING PLATE NOTES:**  
 1. FOR HEAVY LOADS (CABINETS & EQUIPMENT WEIGHING MAX 200 lb/ft & GRAB BARS) SEE 5/  
 2. FOR MEDIUM & LIGHT LOADS SEE DETAILS T 18/A852.




FILE No. J:\08\08013 College of San Mateo\10-13-10\TEMP\08013442 INTERIOR FRAMING DETAILS.dwg 11/12/10 08:44 - Ben

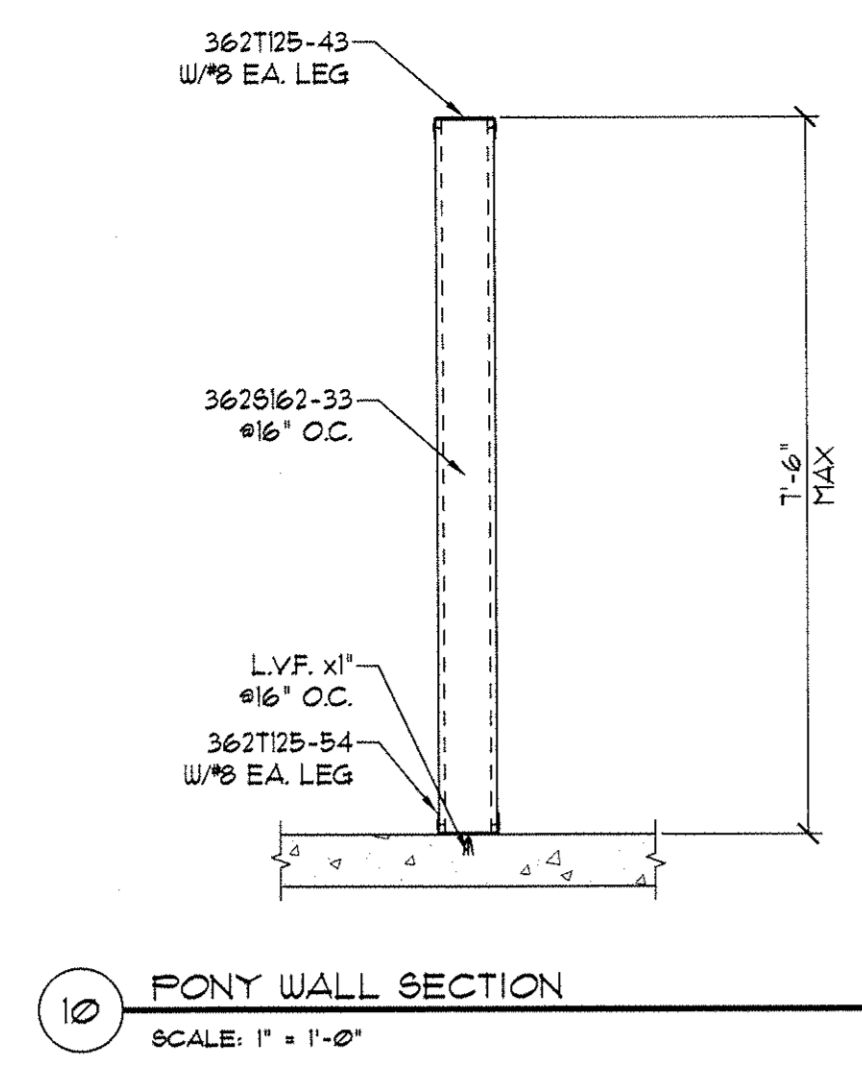


8 PONY WALL SECTION  
SCALE: 1" = 1'-0"

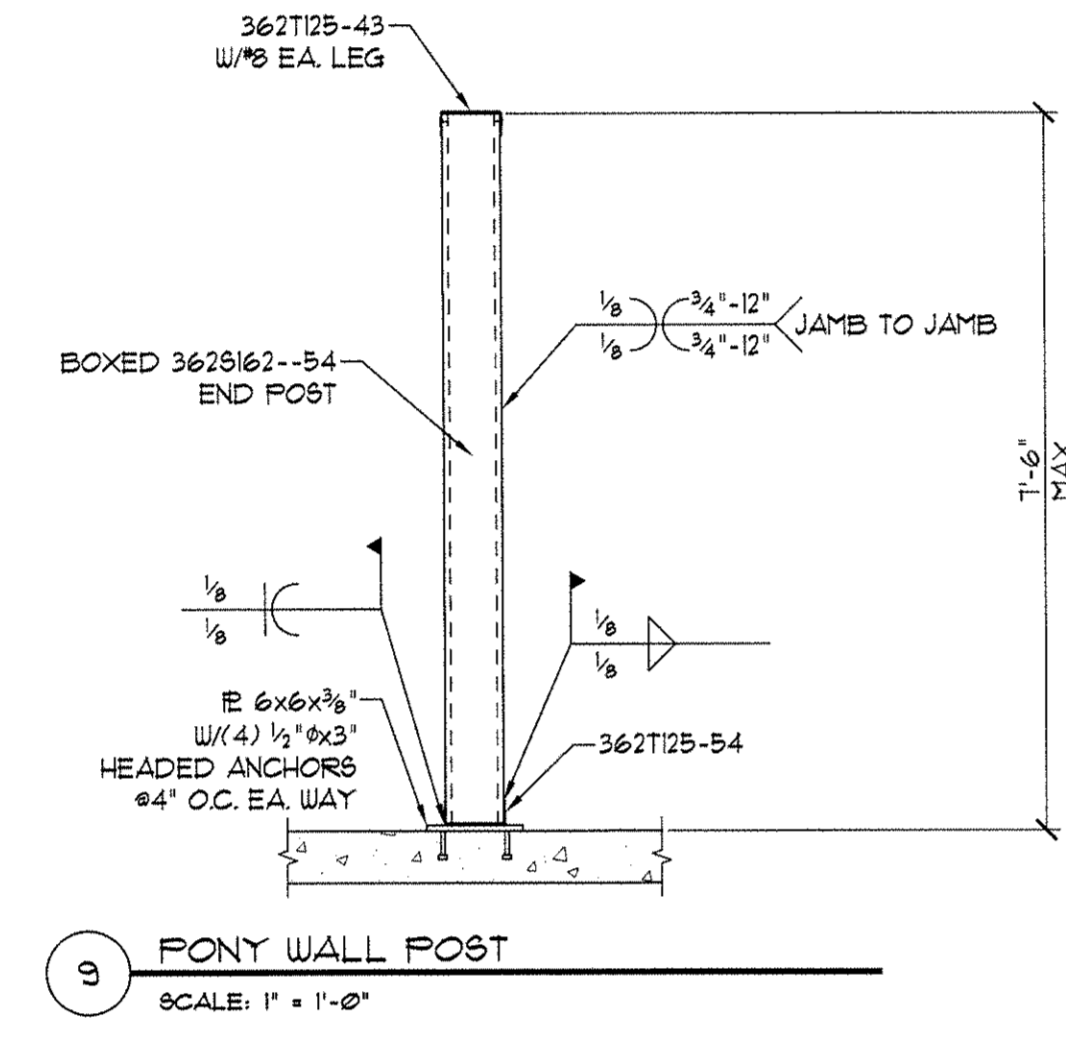


9 PONY WALL POST  
SCALE: 1" = 1'-0"

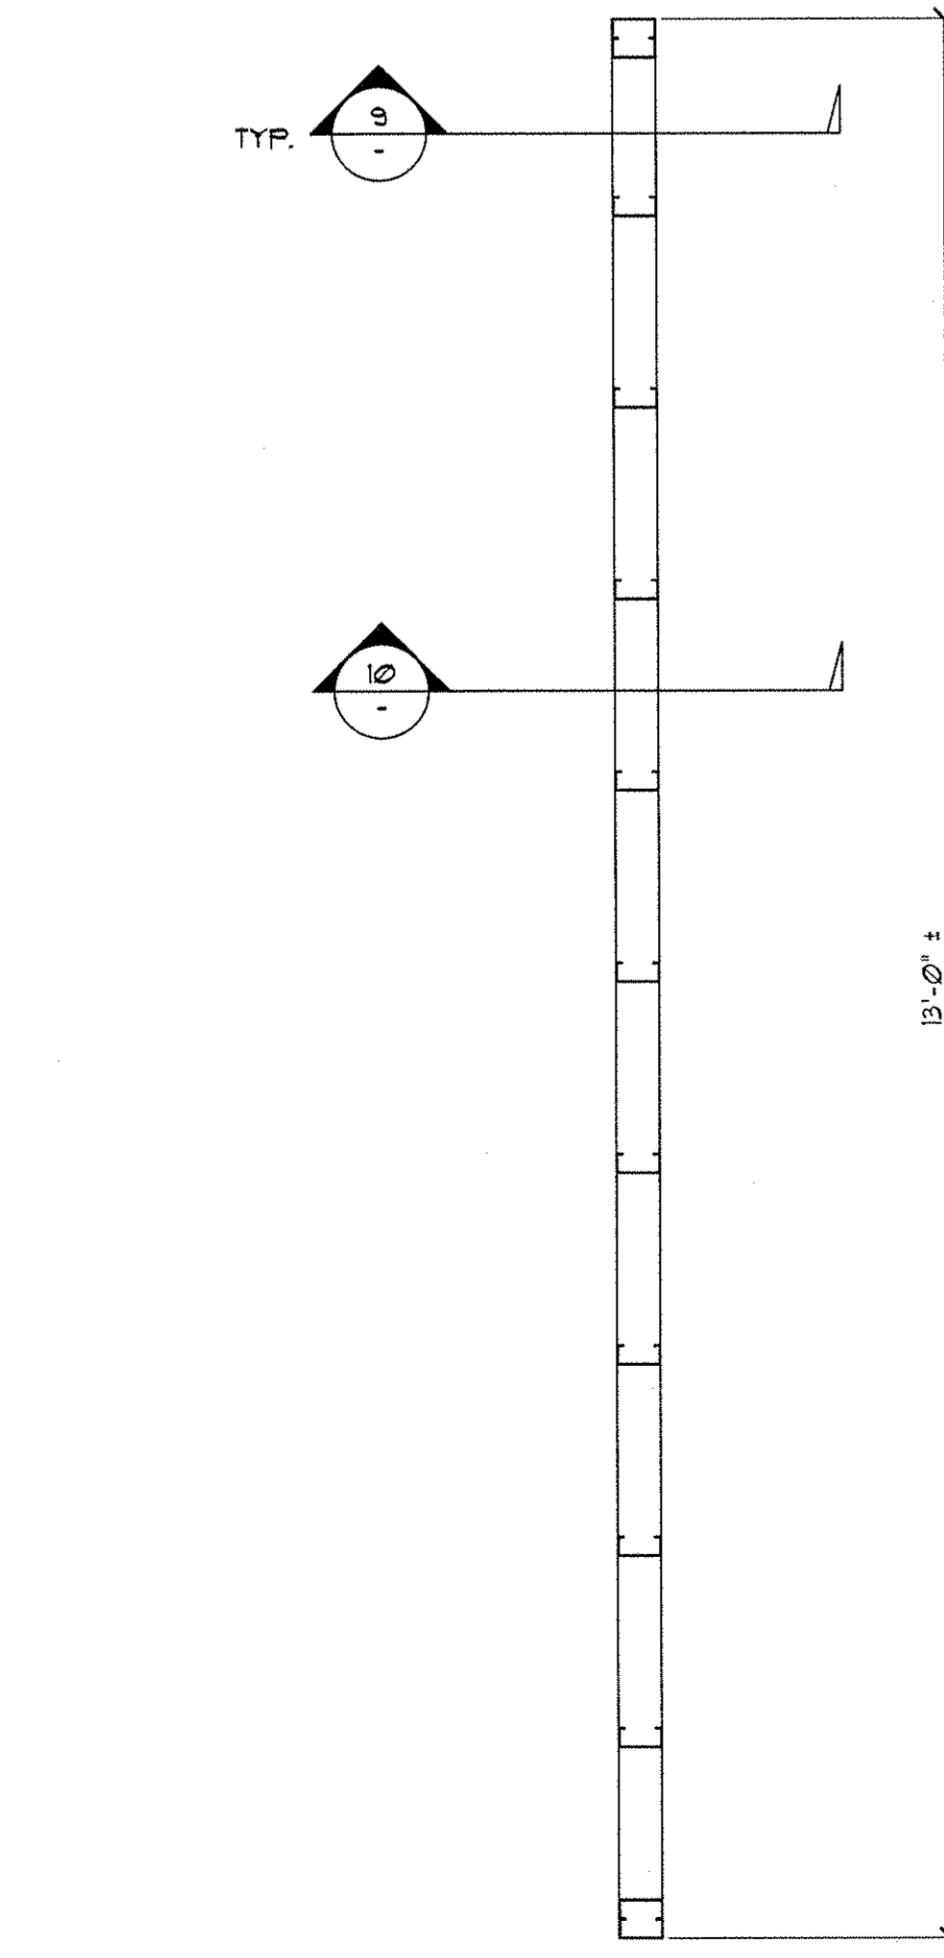


7 TYPICAL PONY WALL FRAMING  
SCALE: 3/4" = 1'-0"

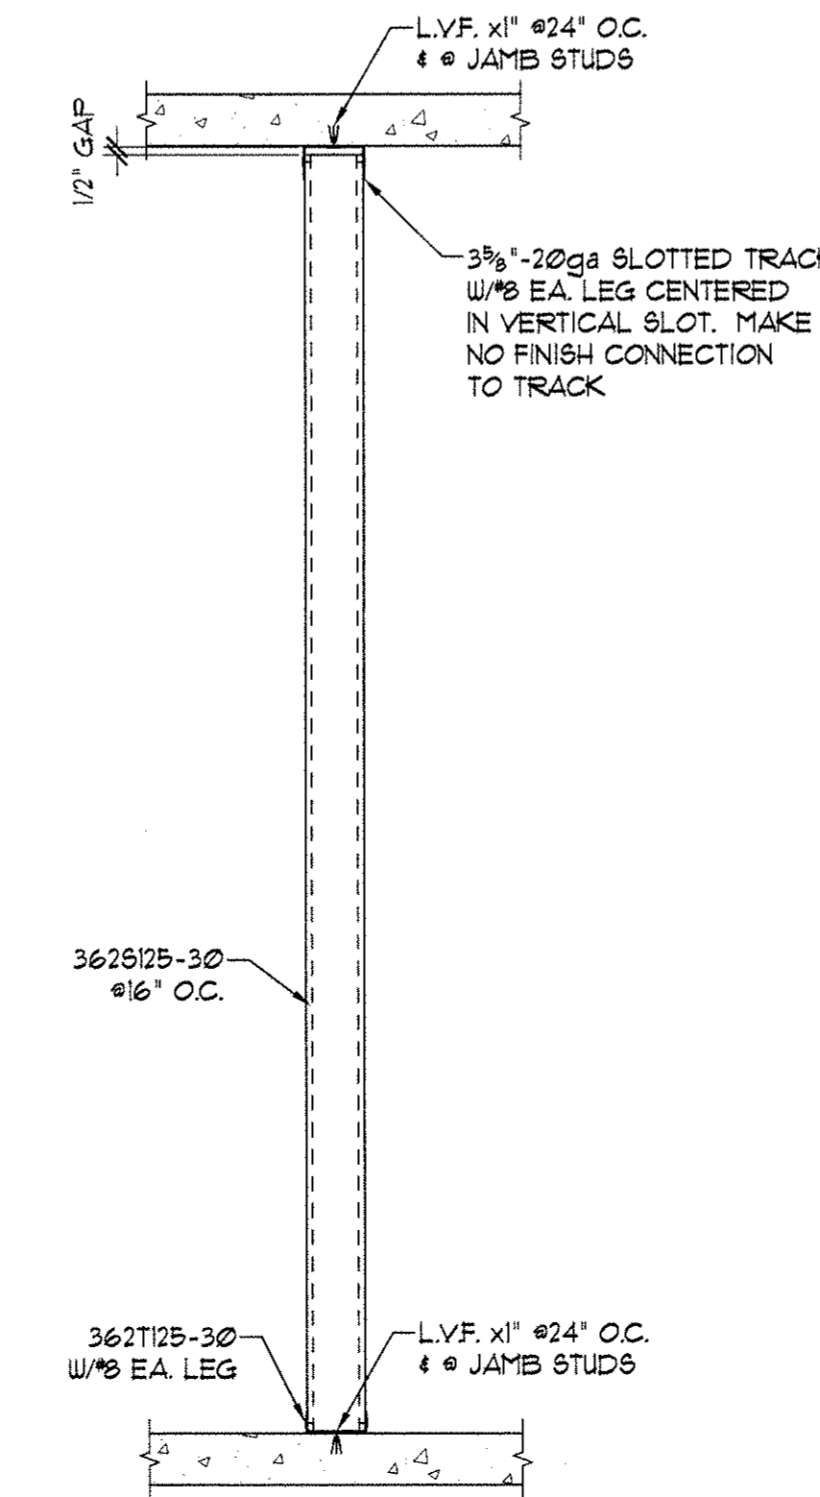


6 TYPICAL INTERIOR WALL FRAMING  
SCALE: 1/2" = 1'-0"

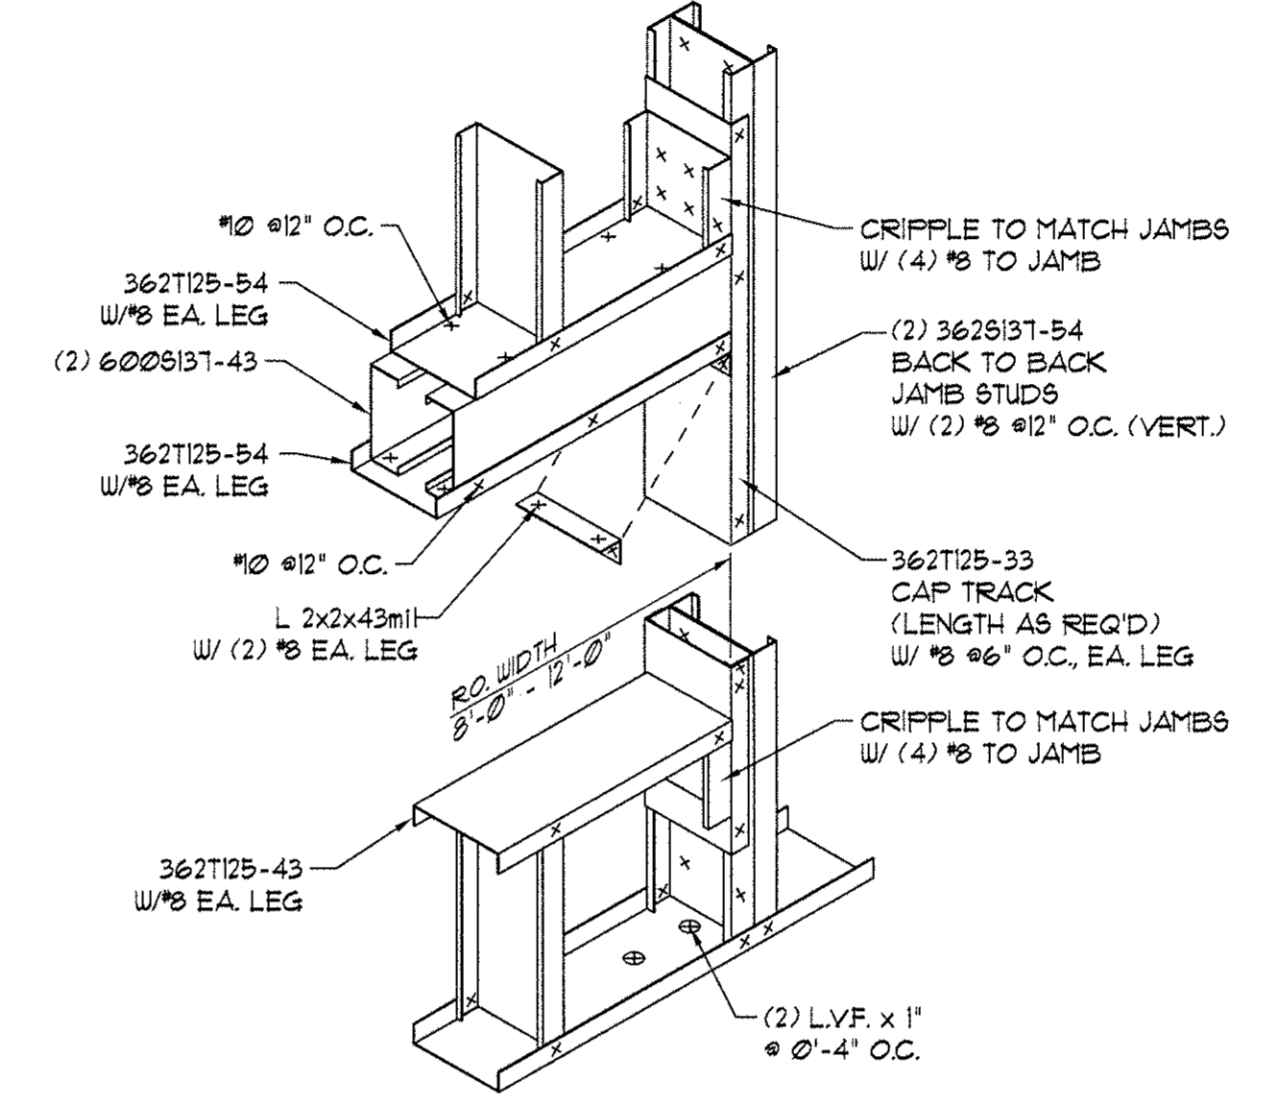


6 INTERIOR WINDOW WALL TYPE 3/A8.04  
SCALE: N.T.S.

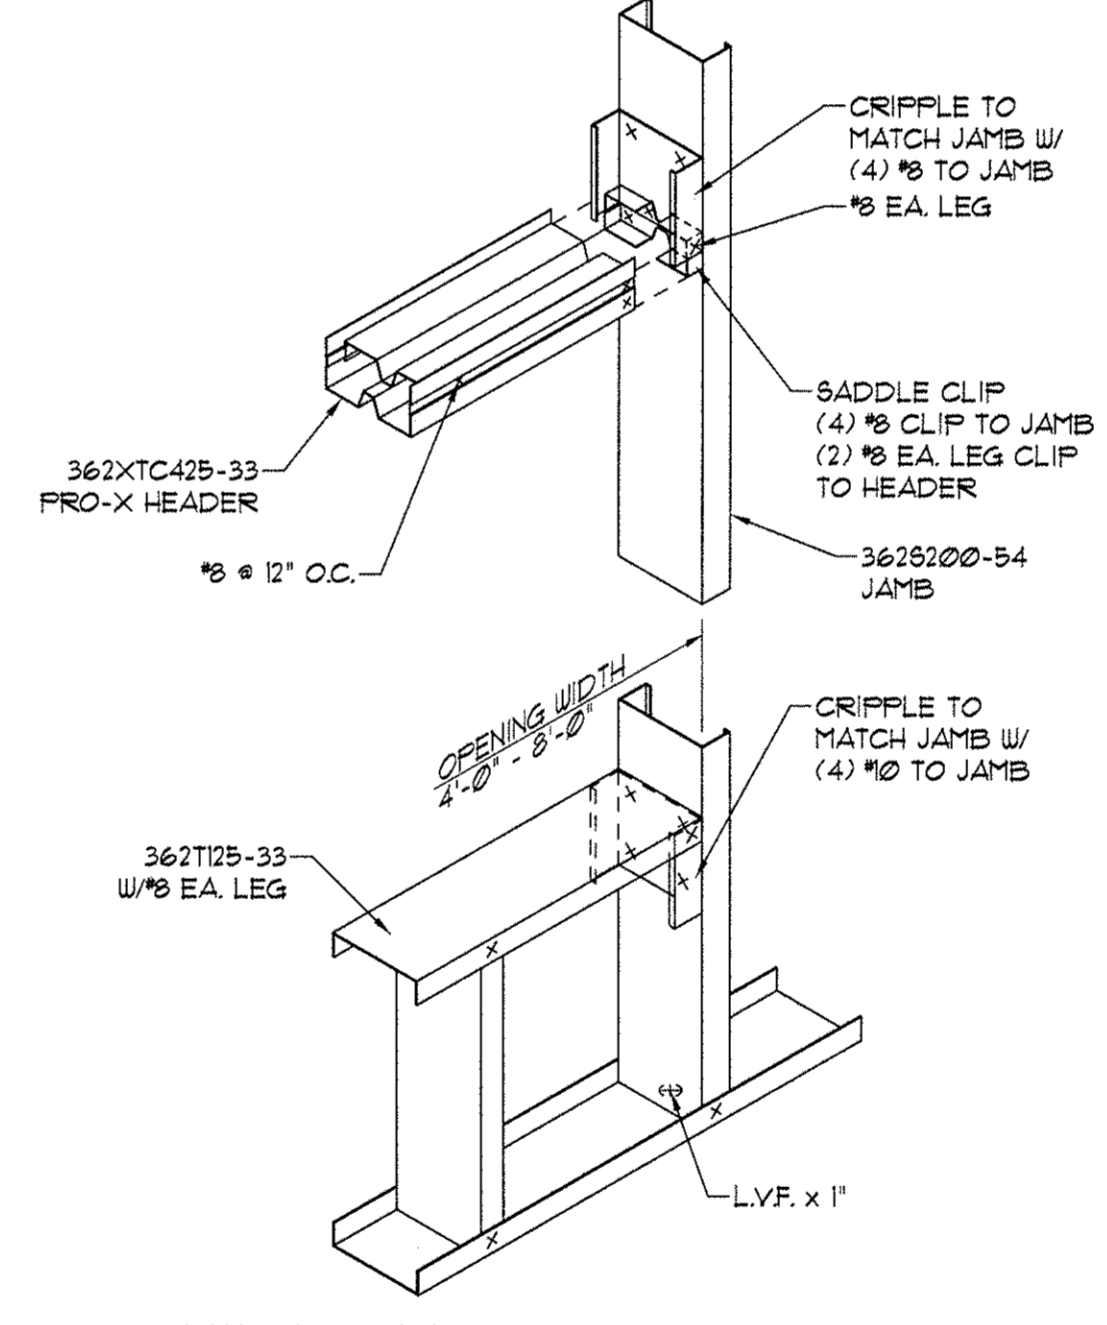


5 INTERIOR WINDOW WALL TYPE 3/A8.04  
SCALE: N.T.S.

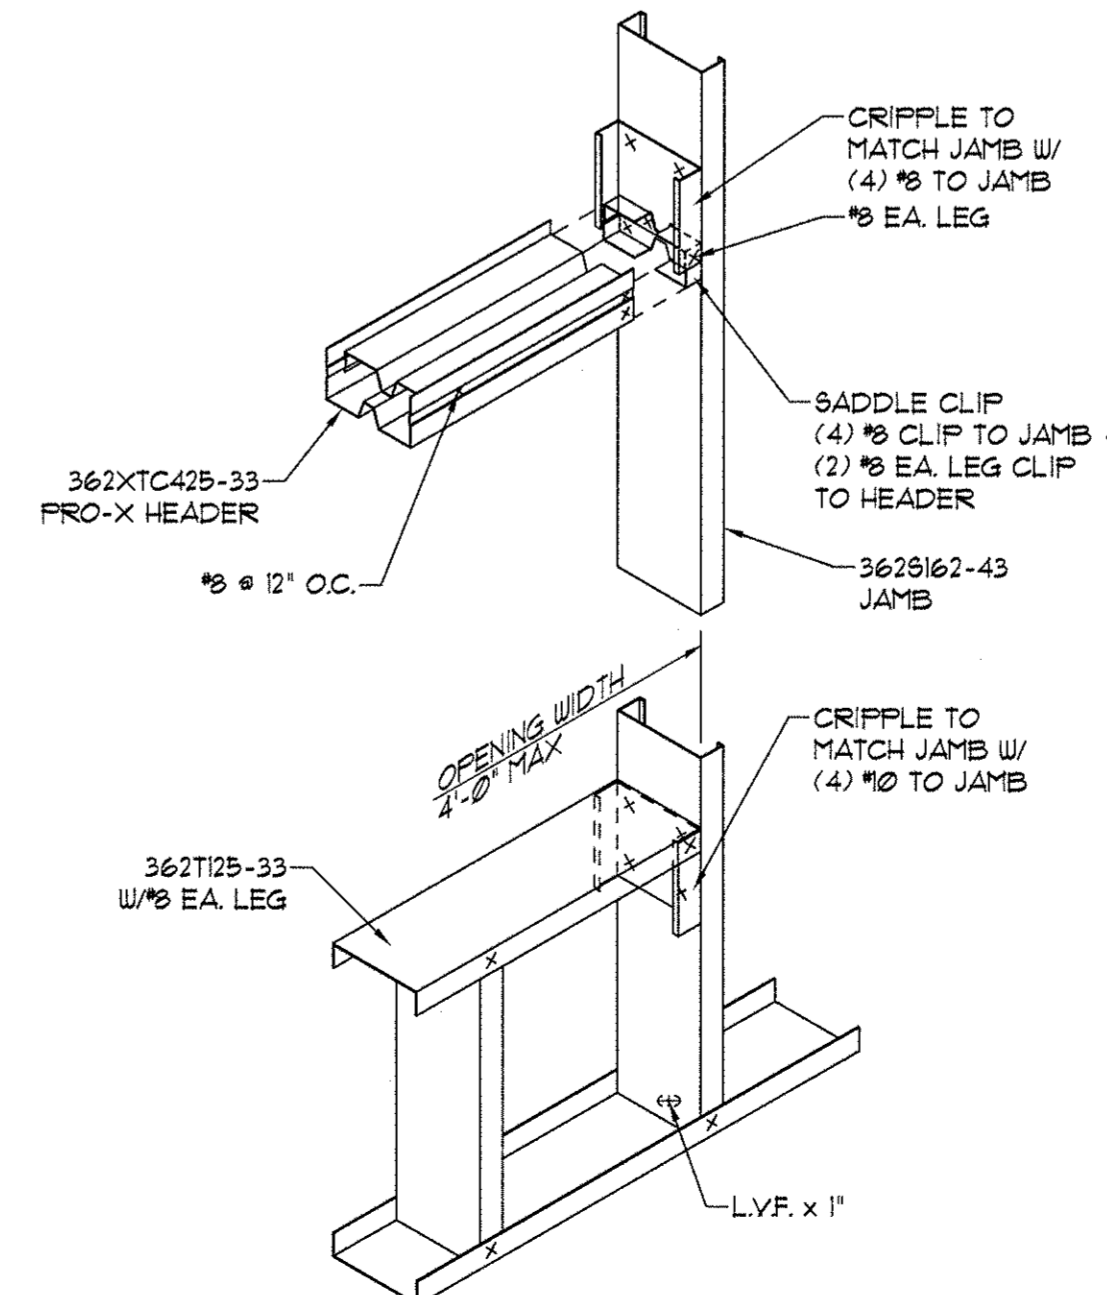


4 INTERIOR WINDOW WALL TYPE 3/A8.04  
SCALE: N.T.S.

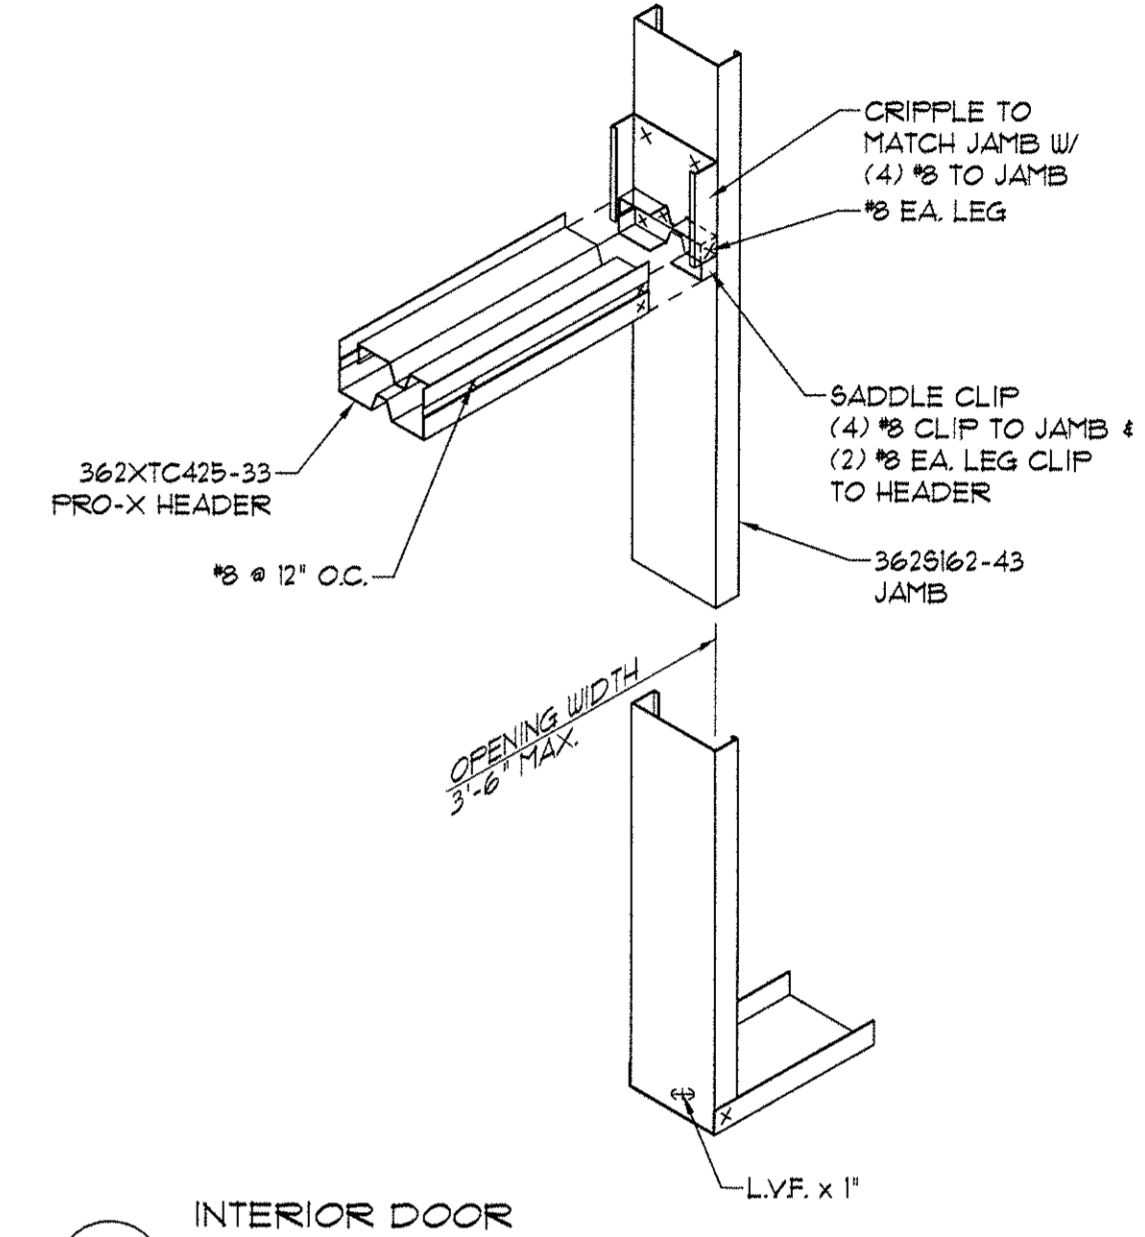

3 INTERIOR DOOR WALL TYPE 3/A8.04  
SCALE: N.T.S.

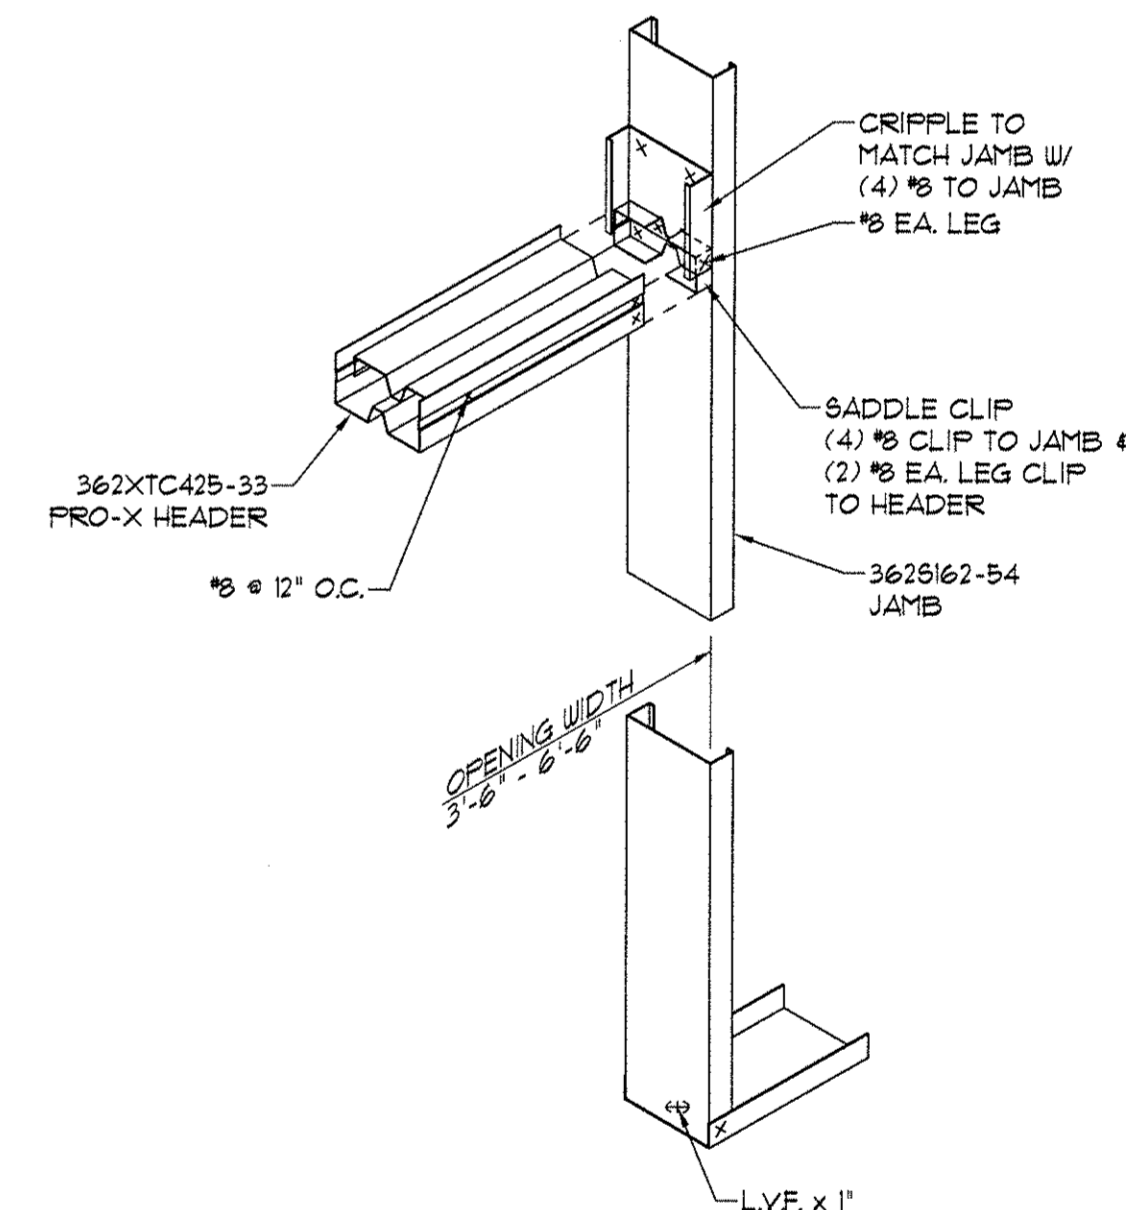


2 INTERIOR DOOR WALL TYPE 3/A8.04  
SCALE: N.T.S.

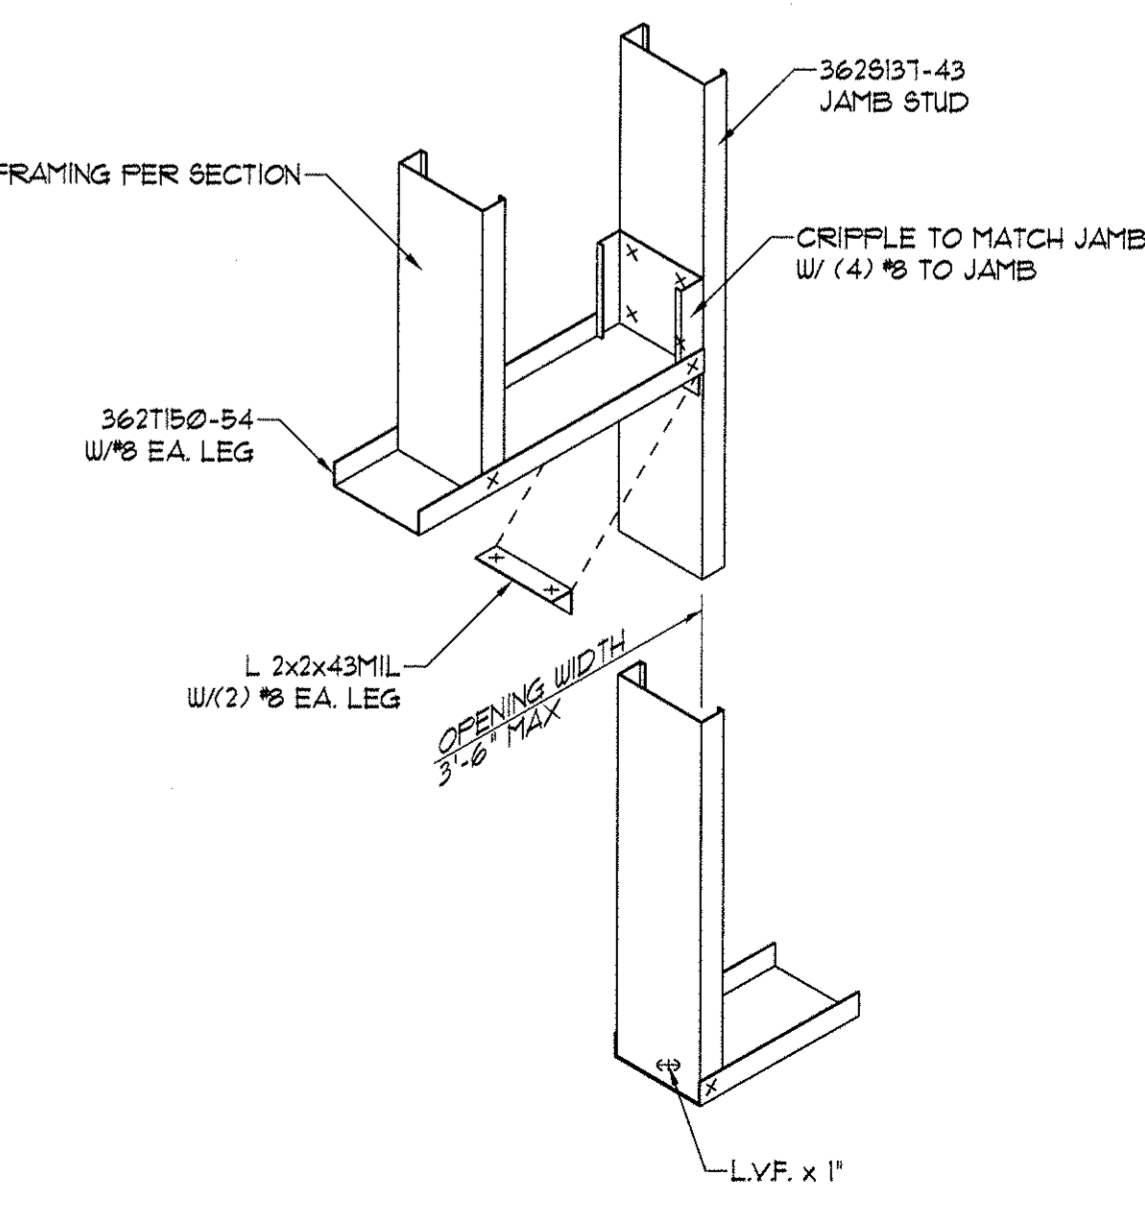

1 INTERIOR DOOR WALL TYPE 1/A8.04  
SCALE: N.T.S.

DETAIL NUMBER	XXX XXXX
PAGE NUMBER (ADD PREFIX SF FOR COMPLETE PAGE NUMBER)	

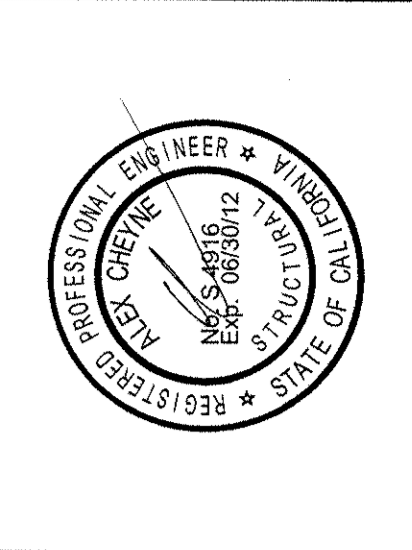

DATE:	10/09/08
REVISION:	SET ISSUED PER DSA REVIEW
DATE:	8/05/08
DRAWING STATUS:	<input type="checkbox"/> PRELIMINARY <input checked="" type="checkbox"/> SUBMITTED <input type="checkbox"/> BID SET <input type="checkbox"/> PERMIT SET <input type="checkbox"/> CONST. SET <input checked="" type="checkbox"/> RECORD DRAWING

**DEVCO**  
Engineering, Inc.  
245 NE CONFER, P.O. BOX 1311  
SAN MATEO, CA 94401  
WWW.DEVCOENGINEERING.COM  
© COPYRIGHT 2008 DEVCO, INC.  
ALL RIGHTS RESERVED.

PROJECT: COLLEGE OF SAN MATEO  
BUILDING 5N  
PROJECT LOCATION: SAN MATEO, CA  
CLIENT: NORTHBAY DRYWALL


SHEET TITLE:  
**INTERIOR FRAMING DETAILS**

JOB NO. 08-013  
DRAWN BY: DEVCO  
DRAWING:  
**SF 4.42**







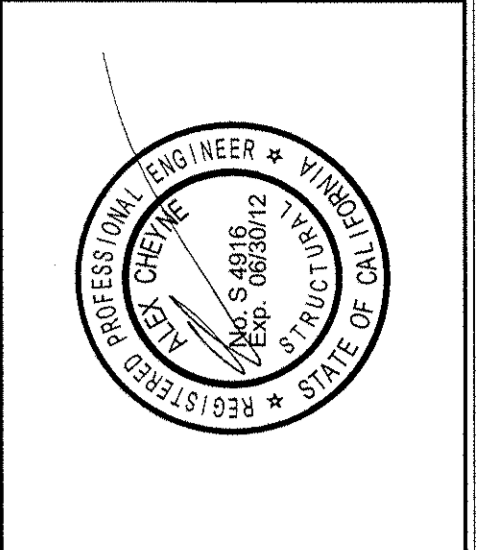

DATE:	REVISION:
6/05/08	1
	2
	3
	4
	5
	6
	7
	8
	9
	10














**devco**  
Engineering, Inc.  
245 NE CONVERSE AVE. BOX 121  
CORVALLIS, OR 97331  
WWW.DEVCOENGINEERING.COM

© COPYRIGHT 2008 DEVCO ENGINEERING, INC.  
ALL RIGHTS RESERVED.

PROJECT: COLLEGE OF SAN MATEO  
BUILDING 5N  
PROJECT LOCATION: SAN MATEO, CA  
CLIENT: NORTHBAY DRYWALL

SHEET TITLE: SKETCHES


JOB NO. 08-013  
DRAWN BY: DEVCO  
DRAWING: SF 5.02

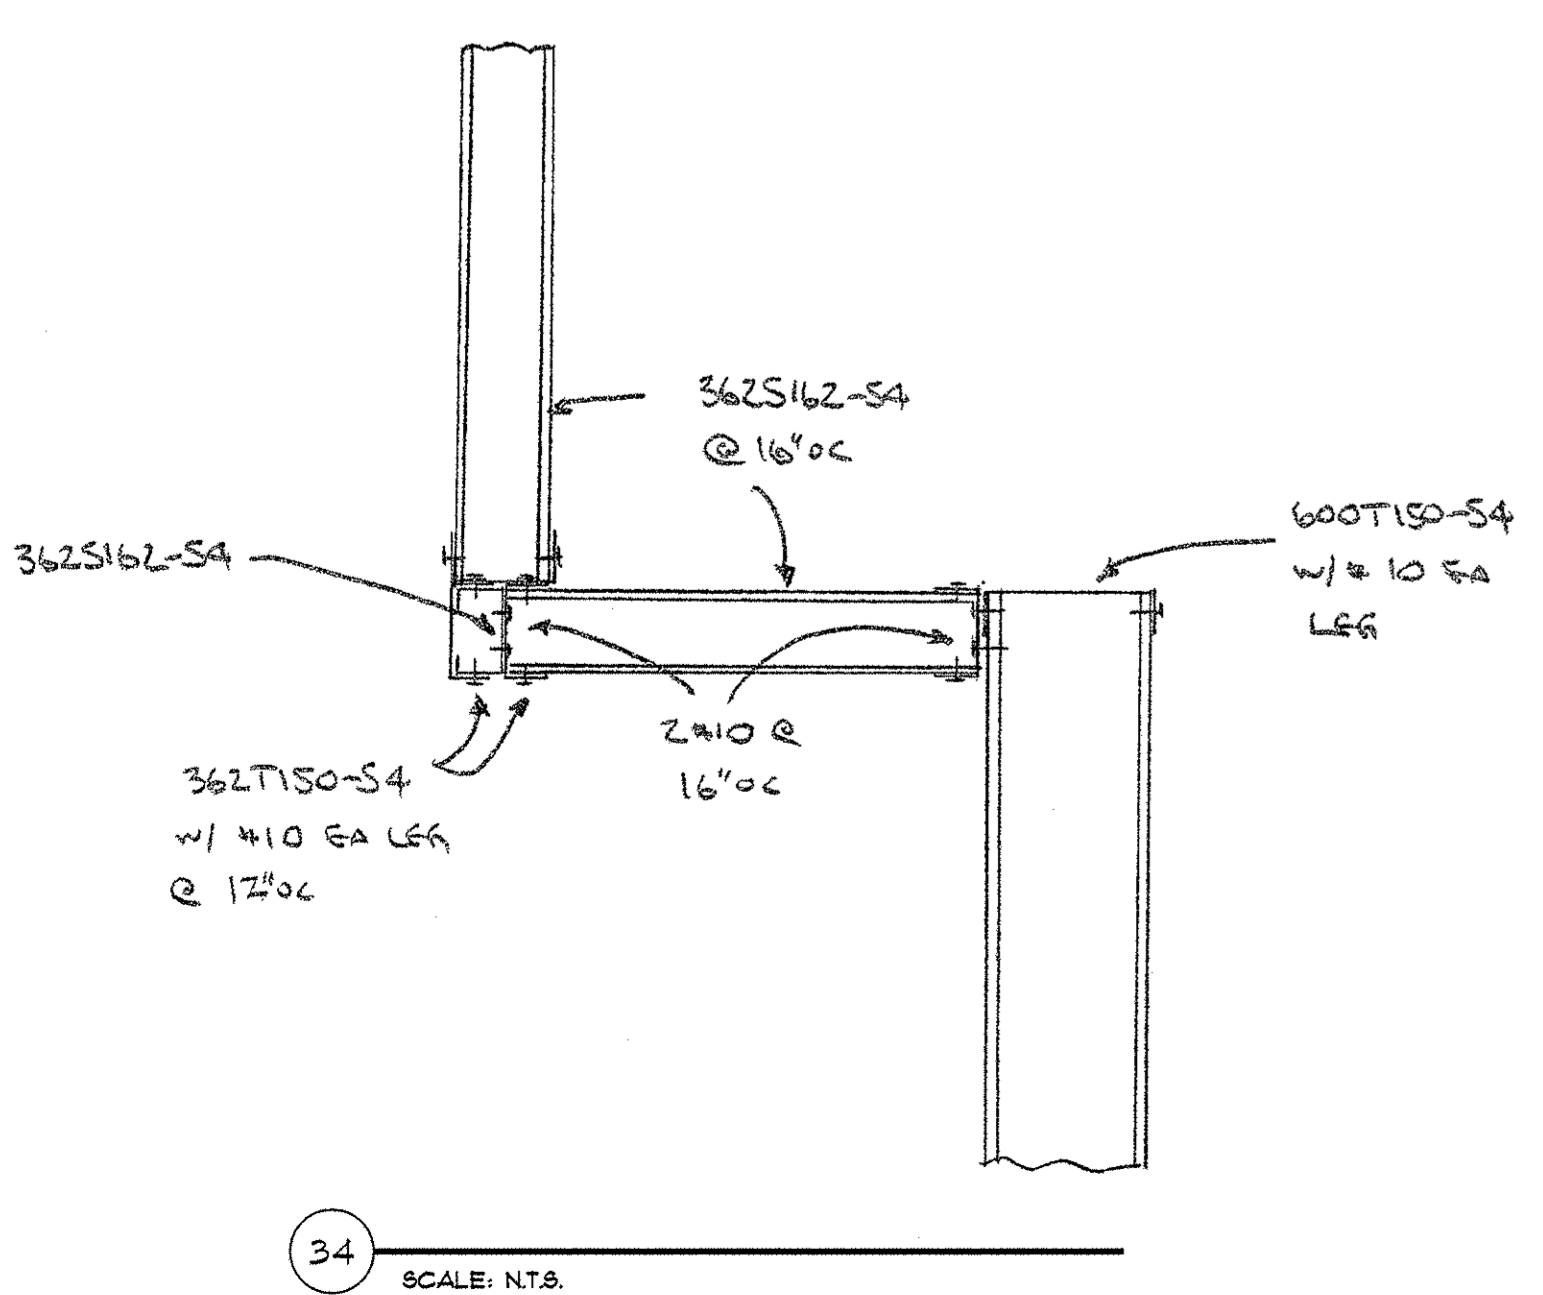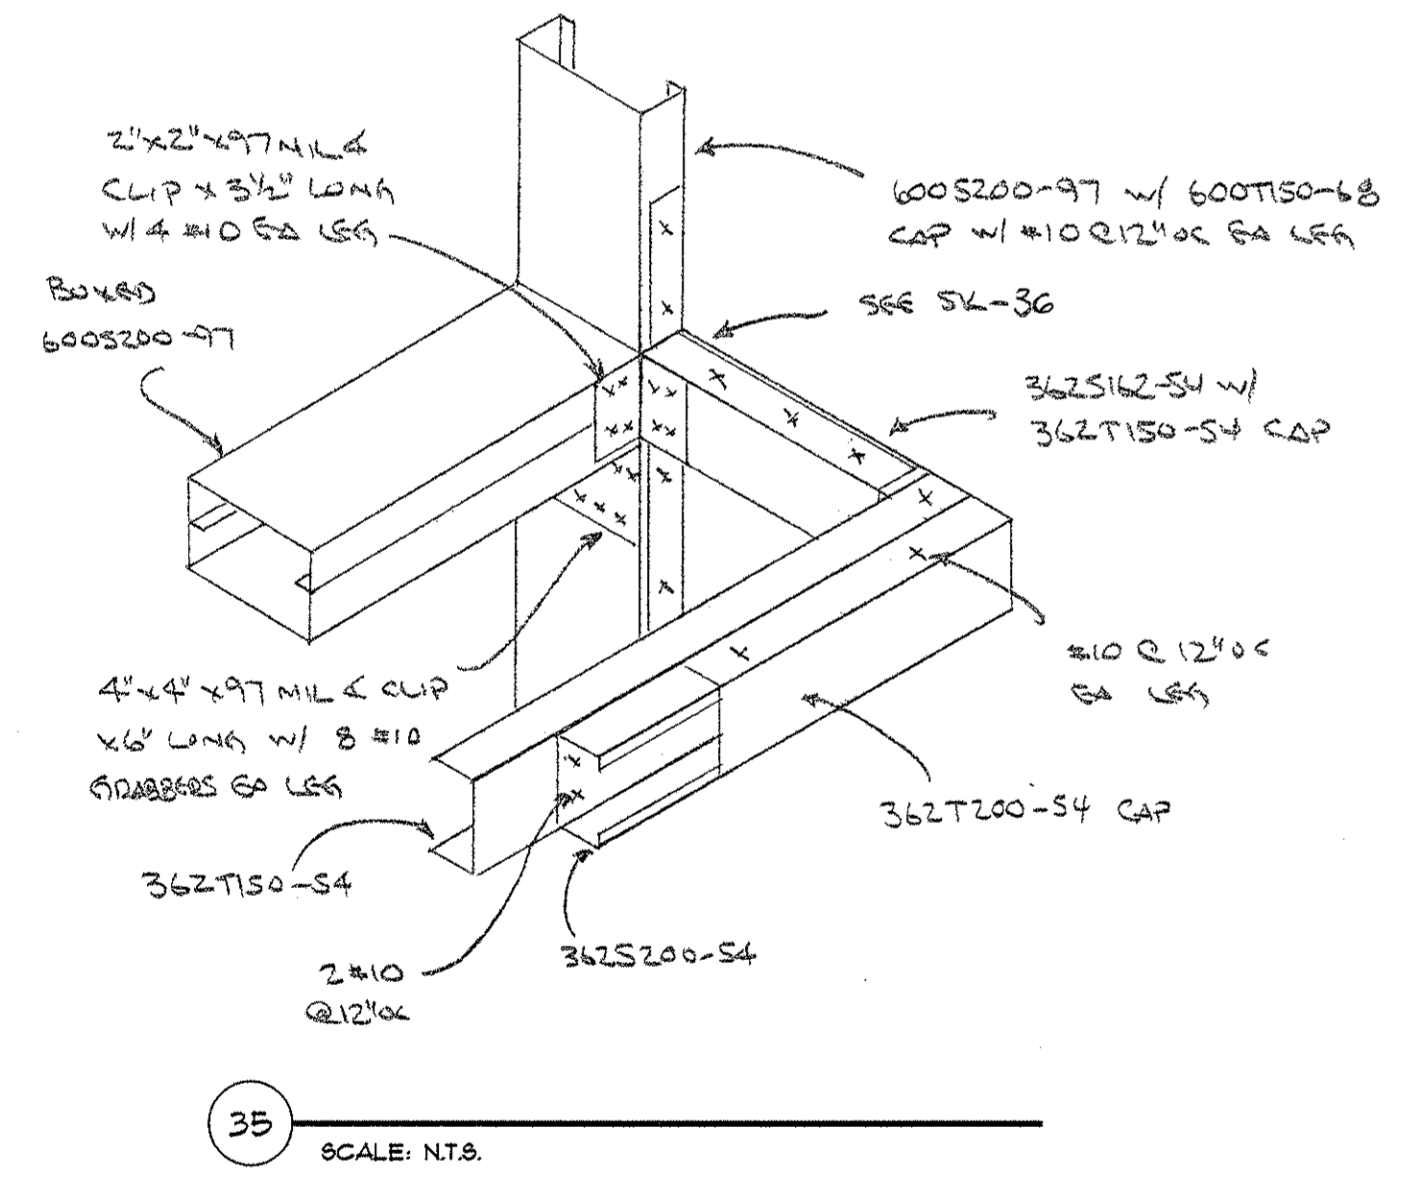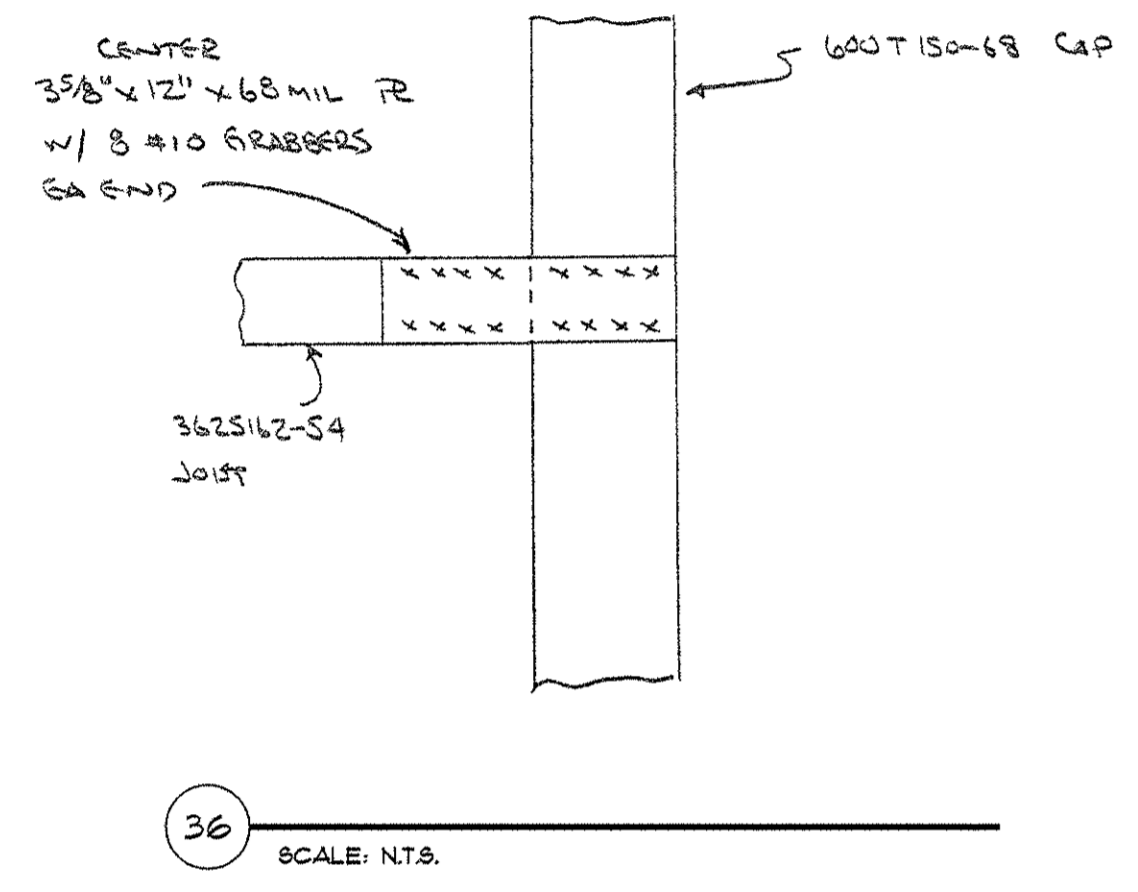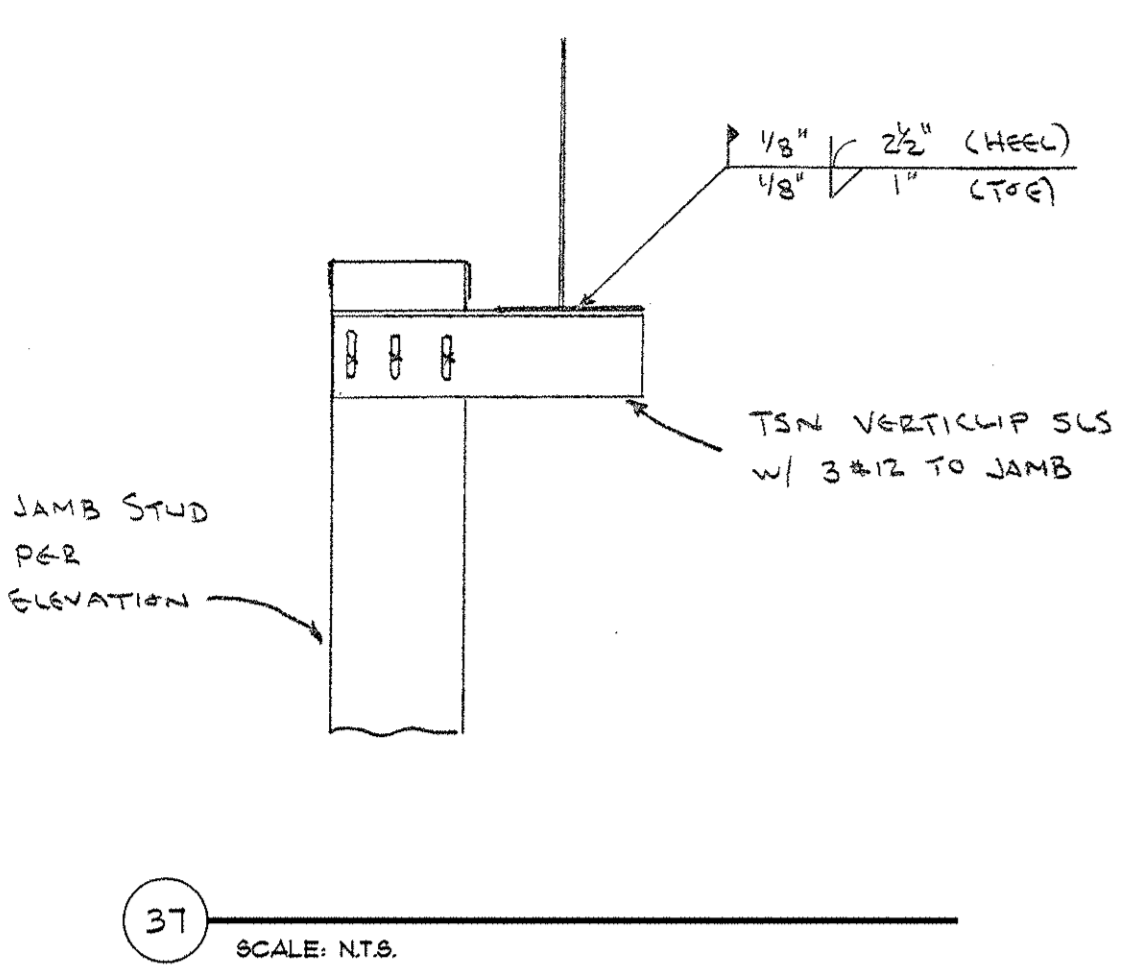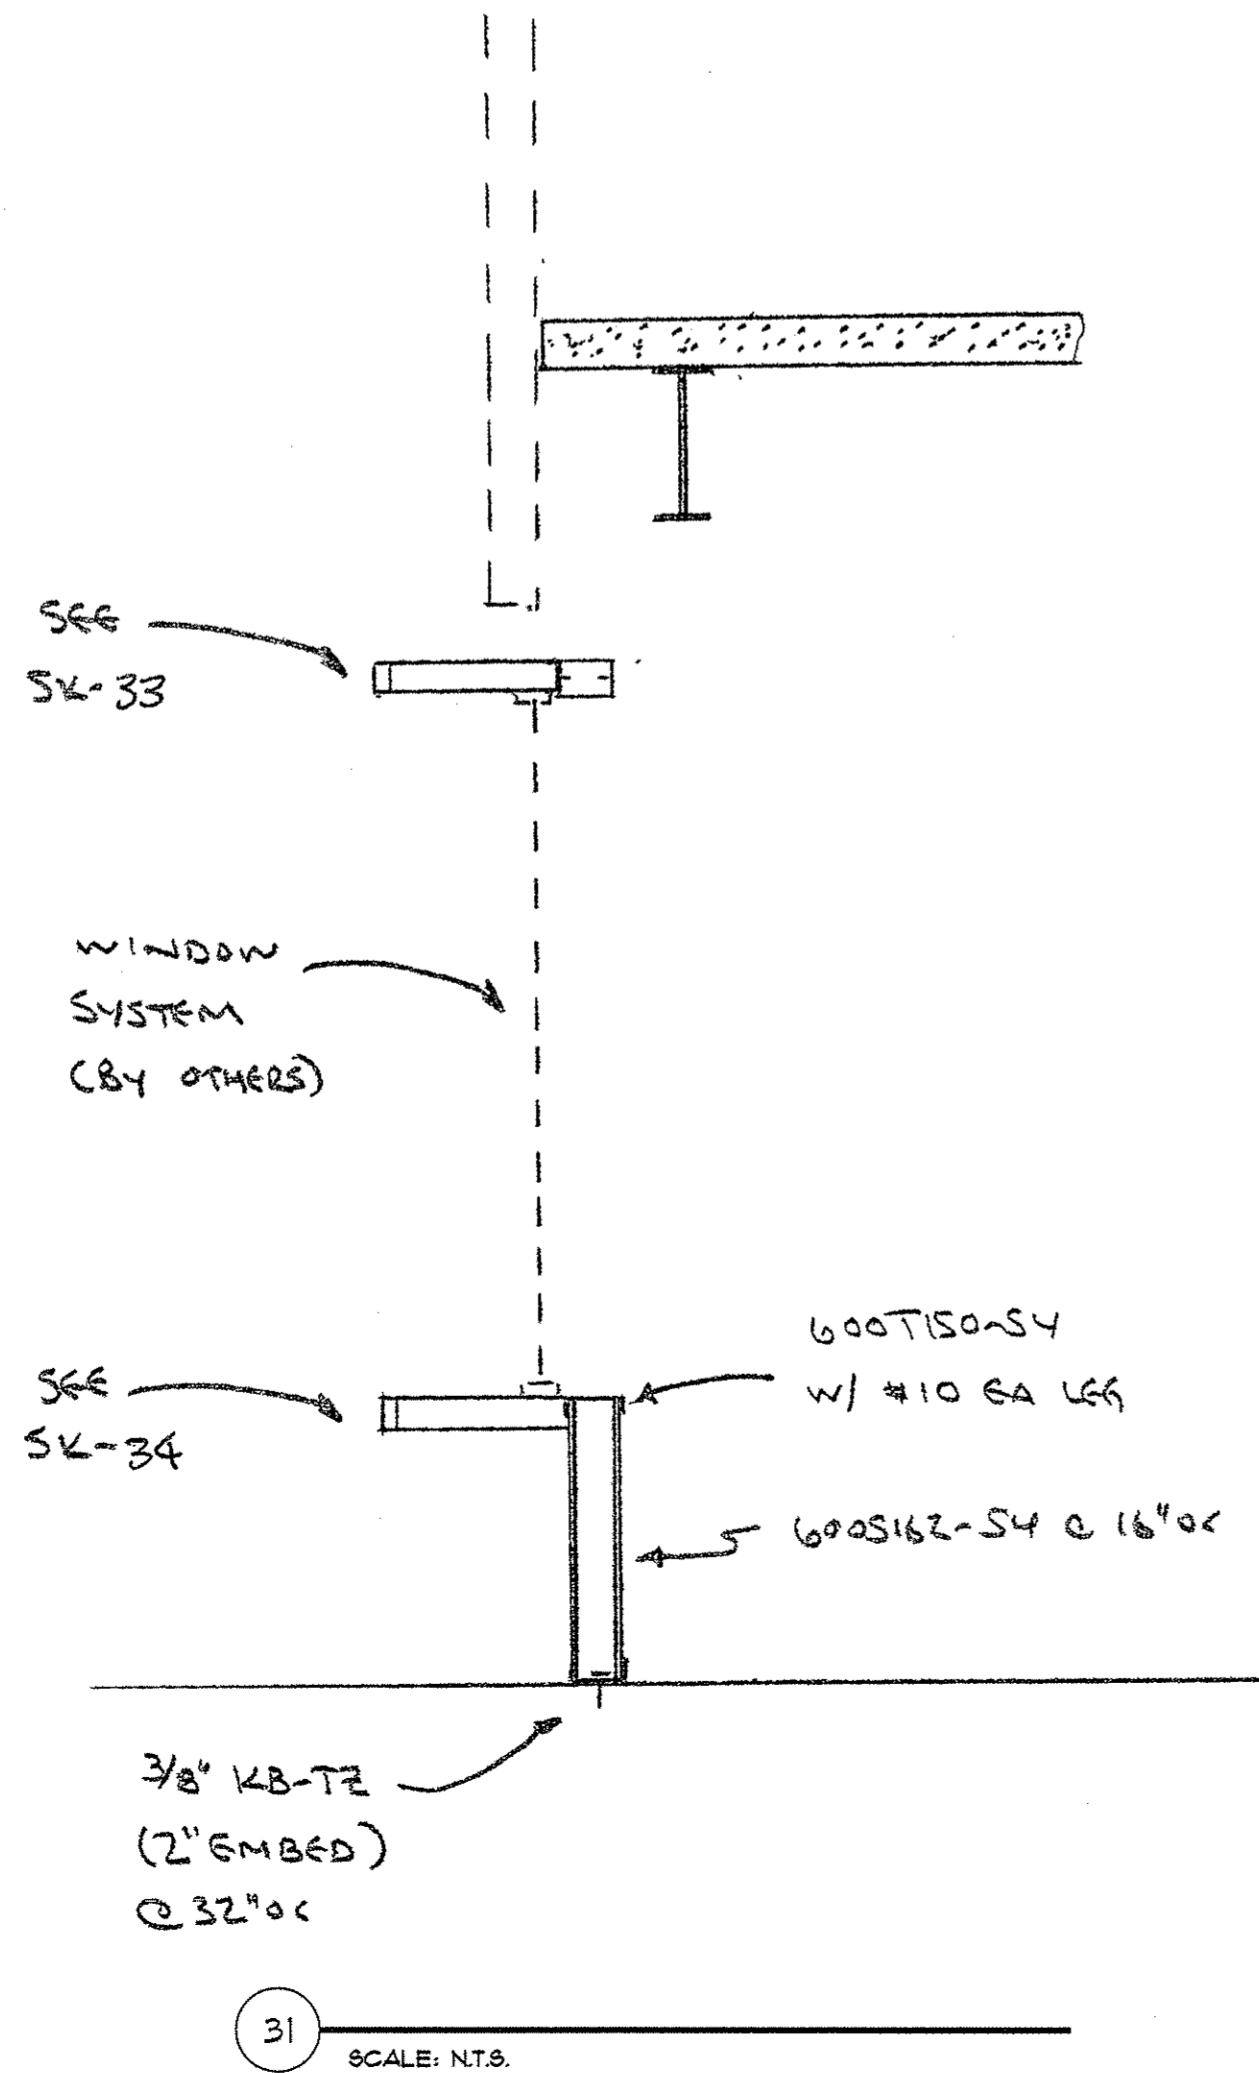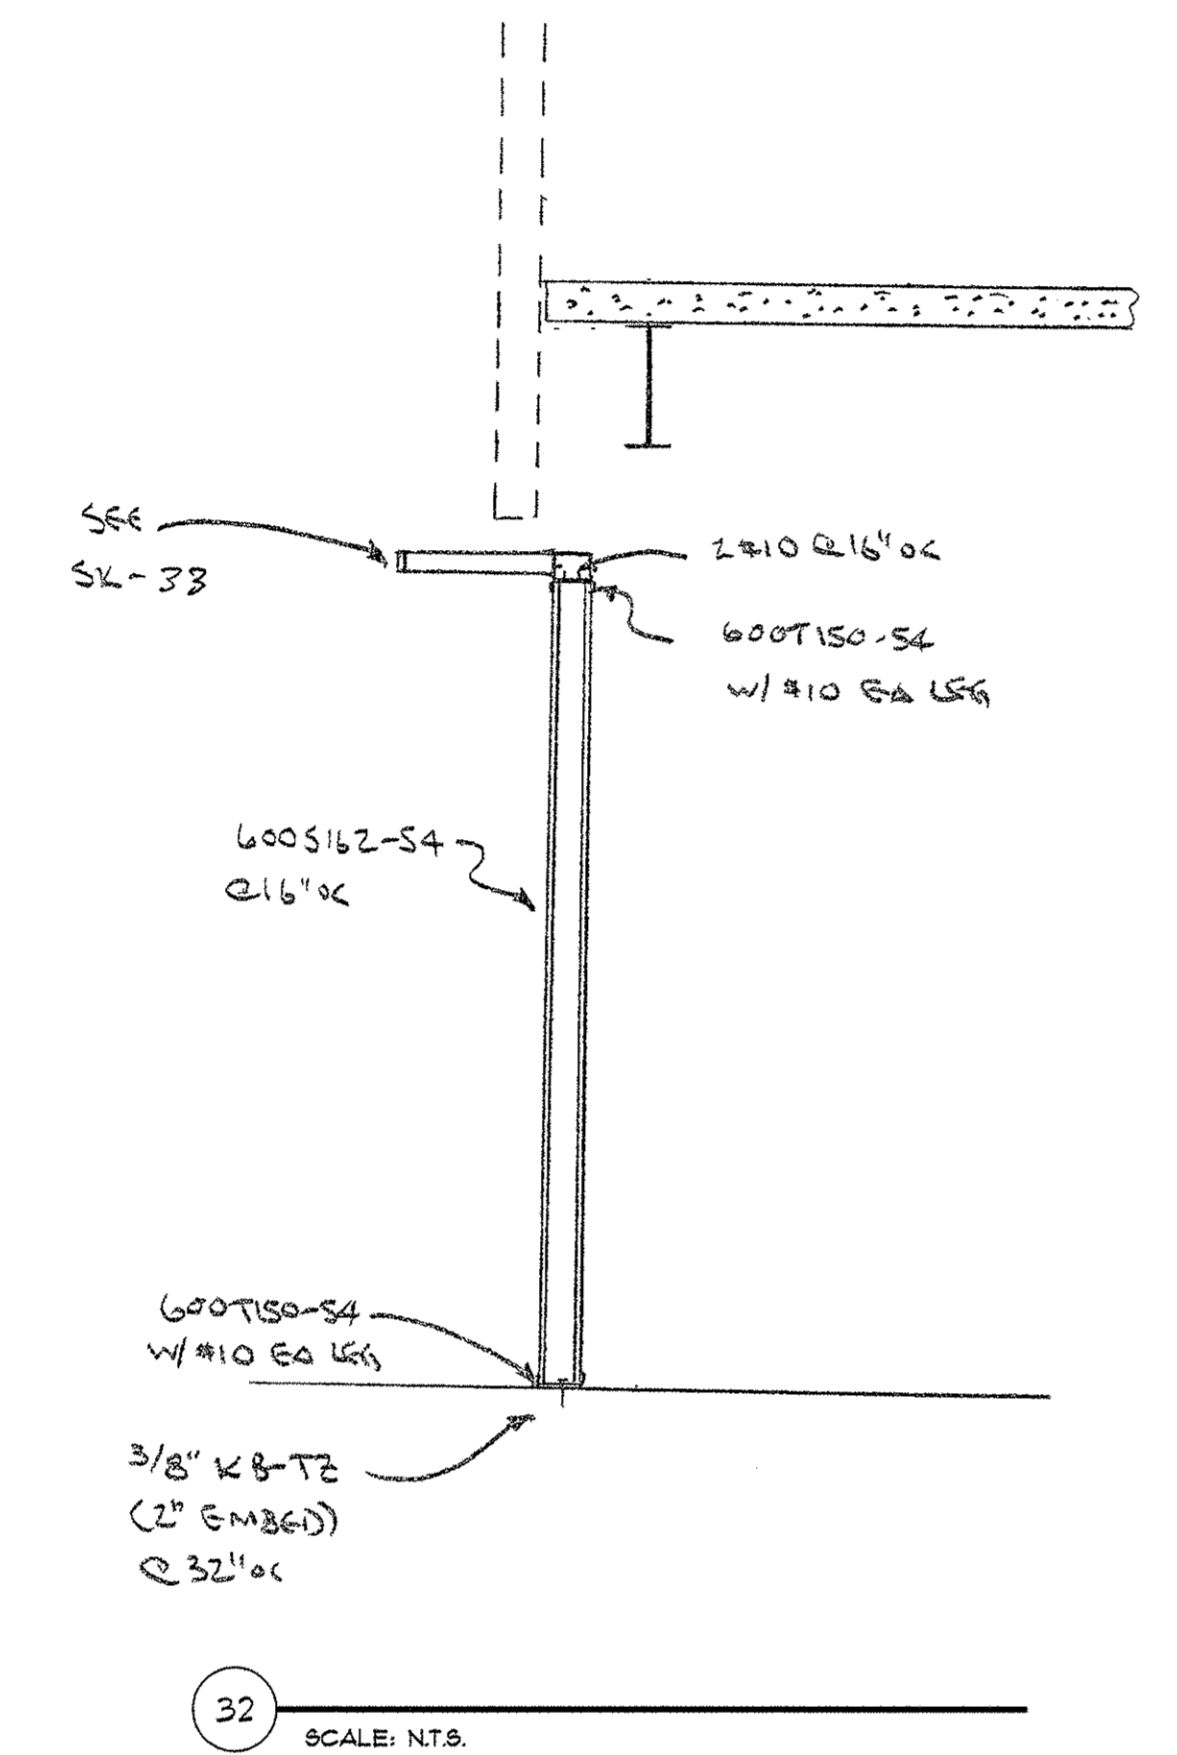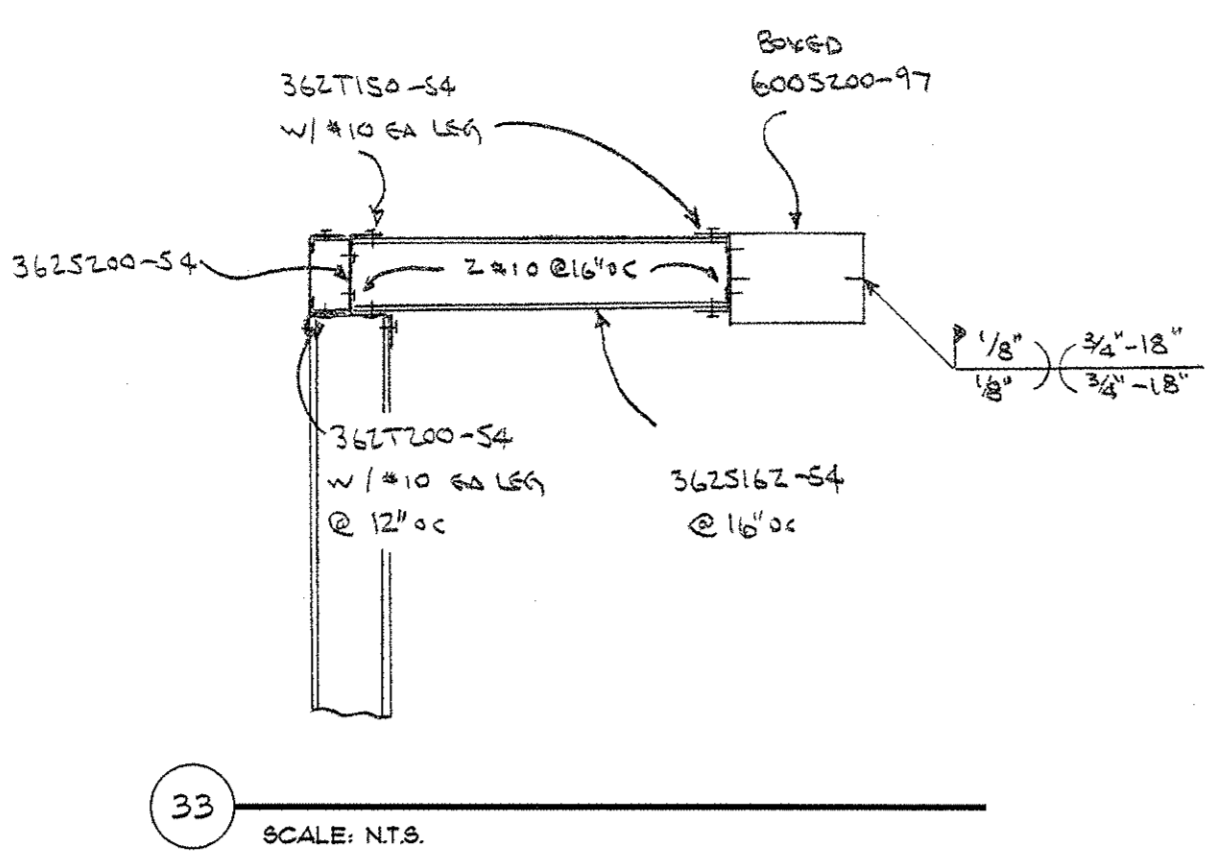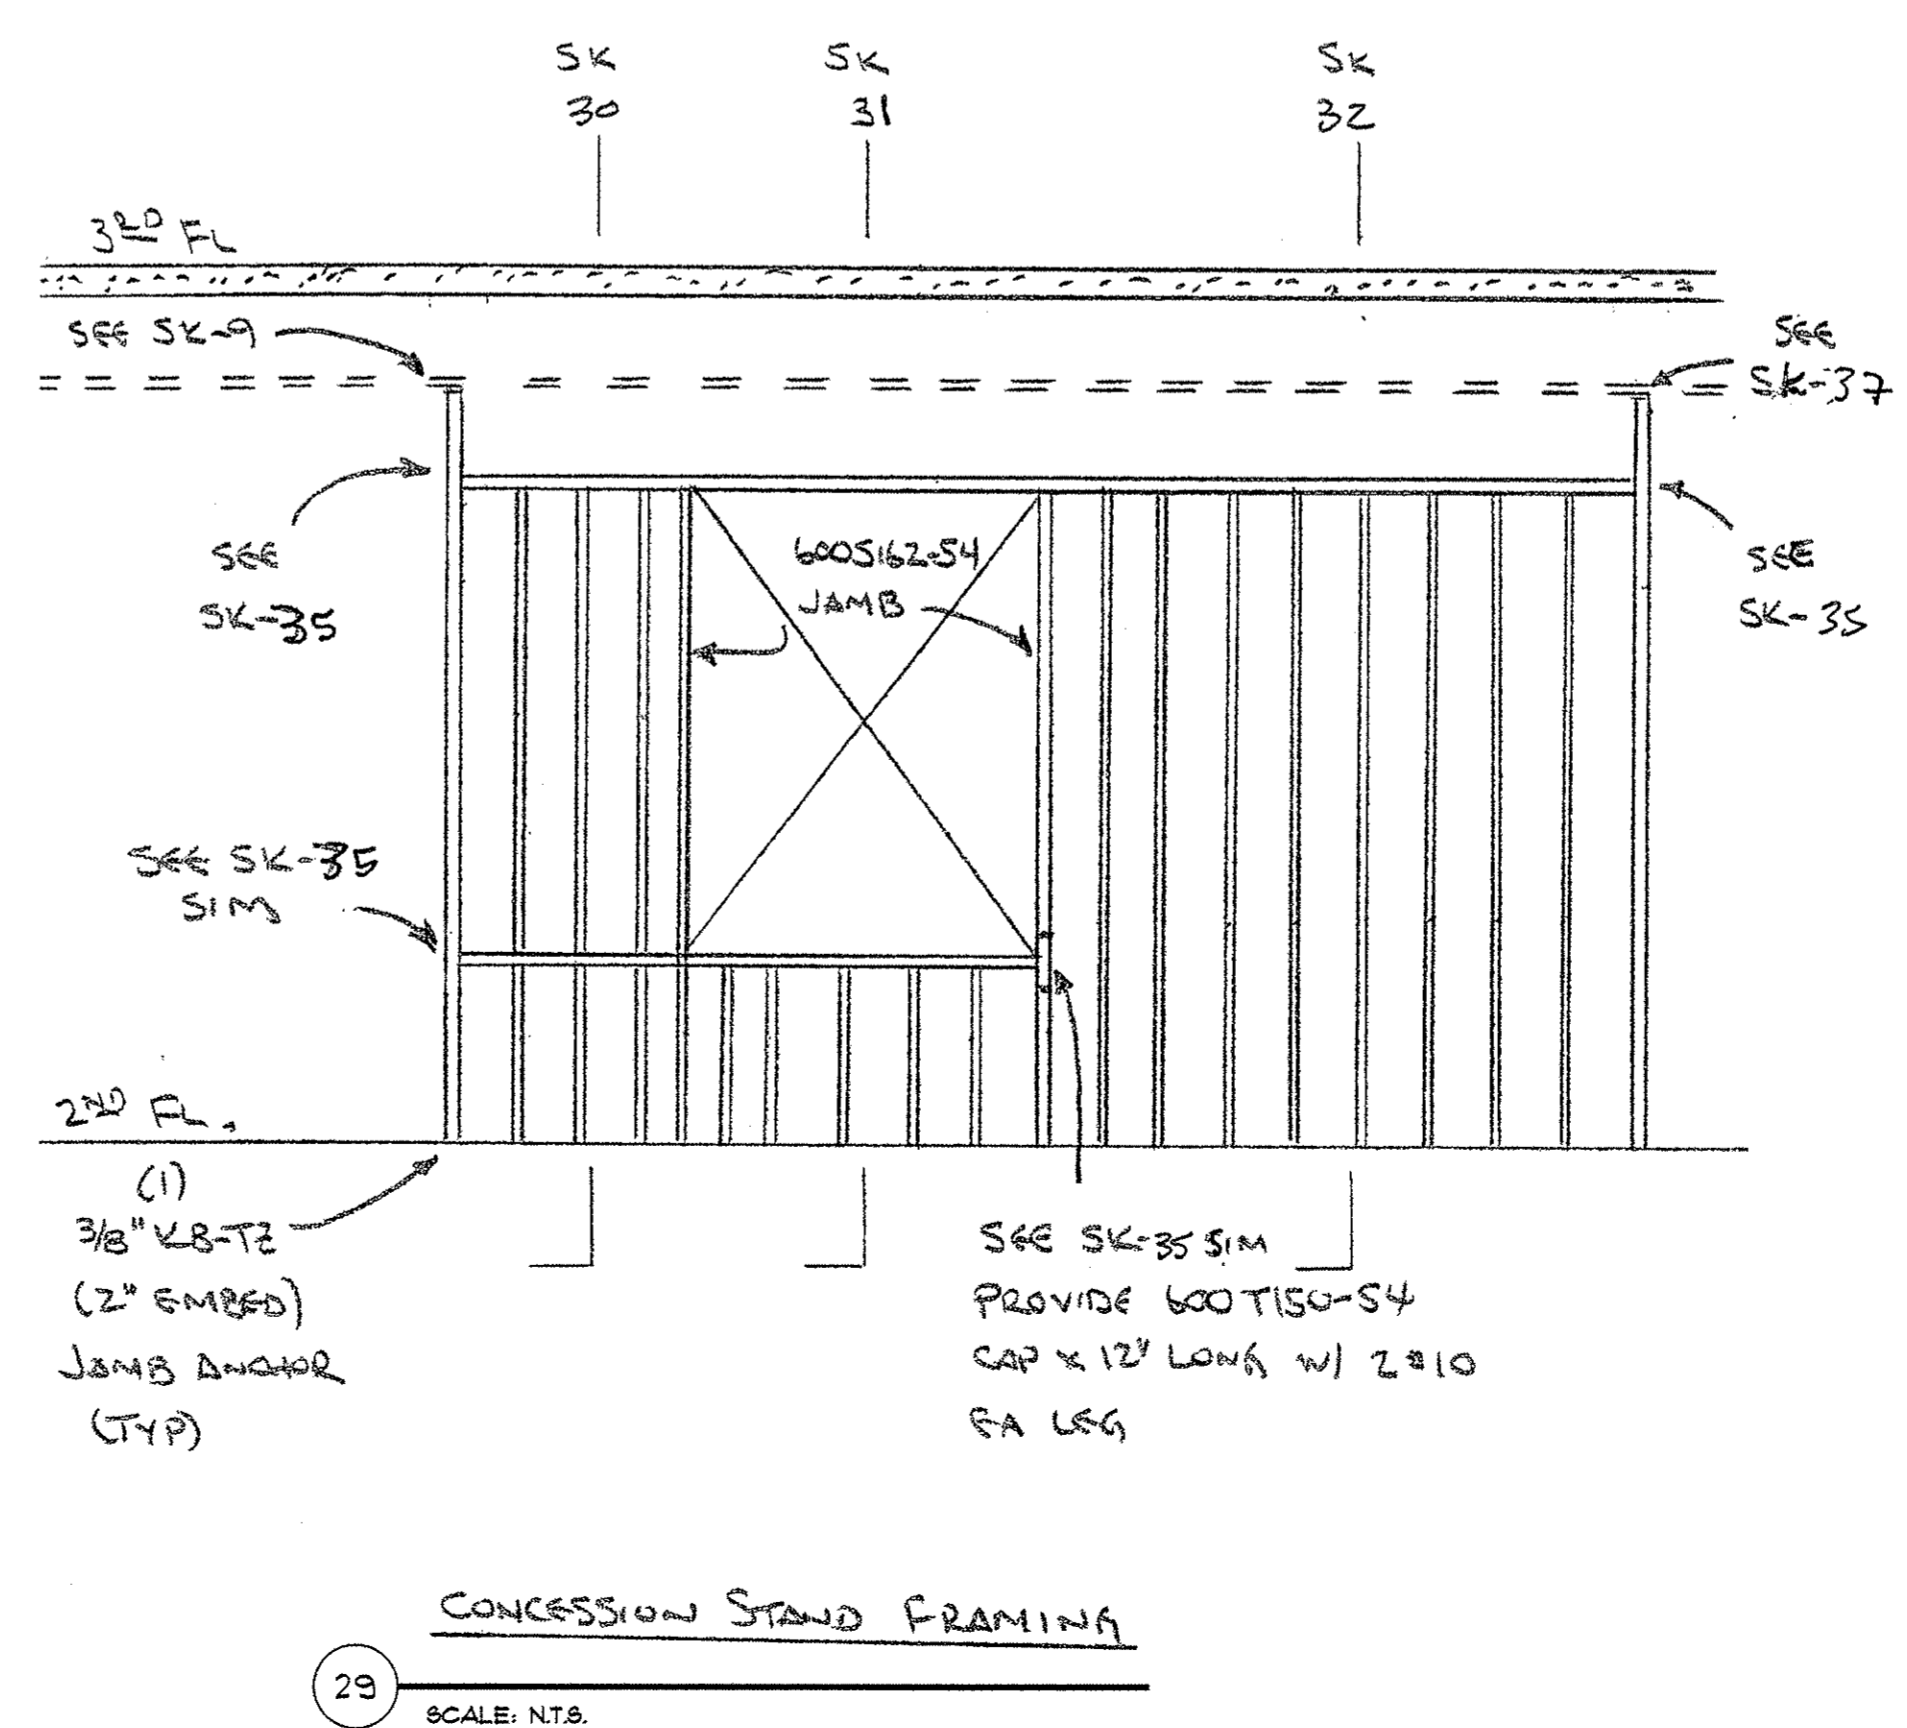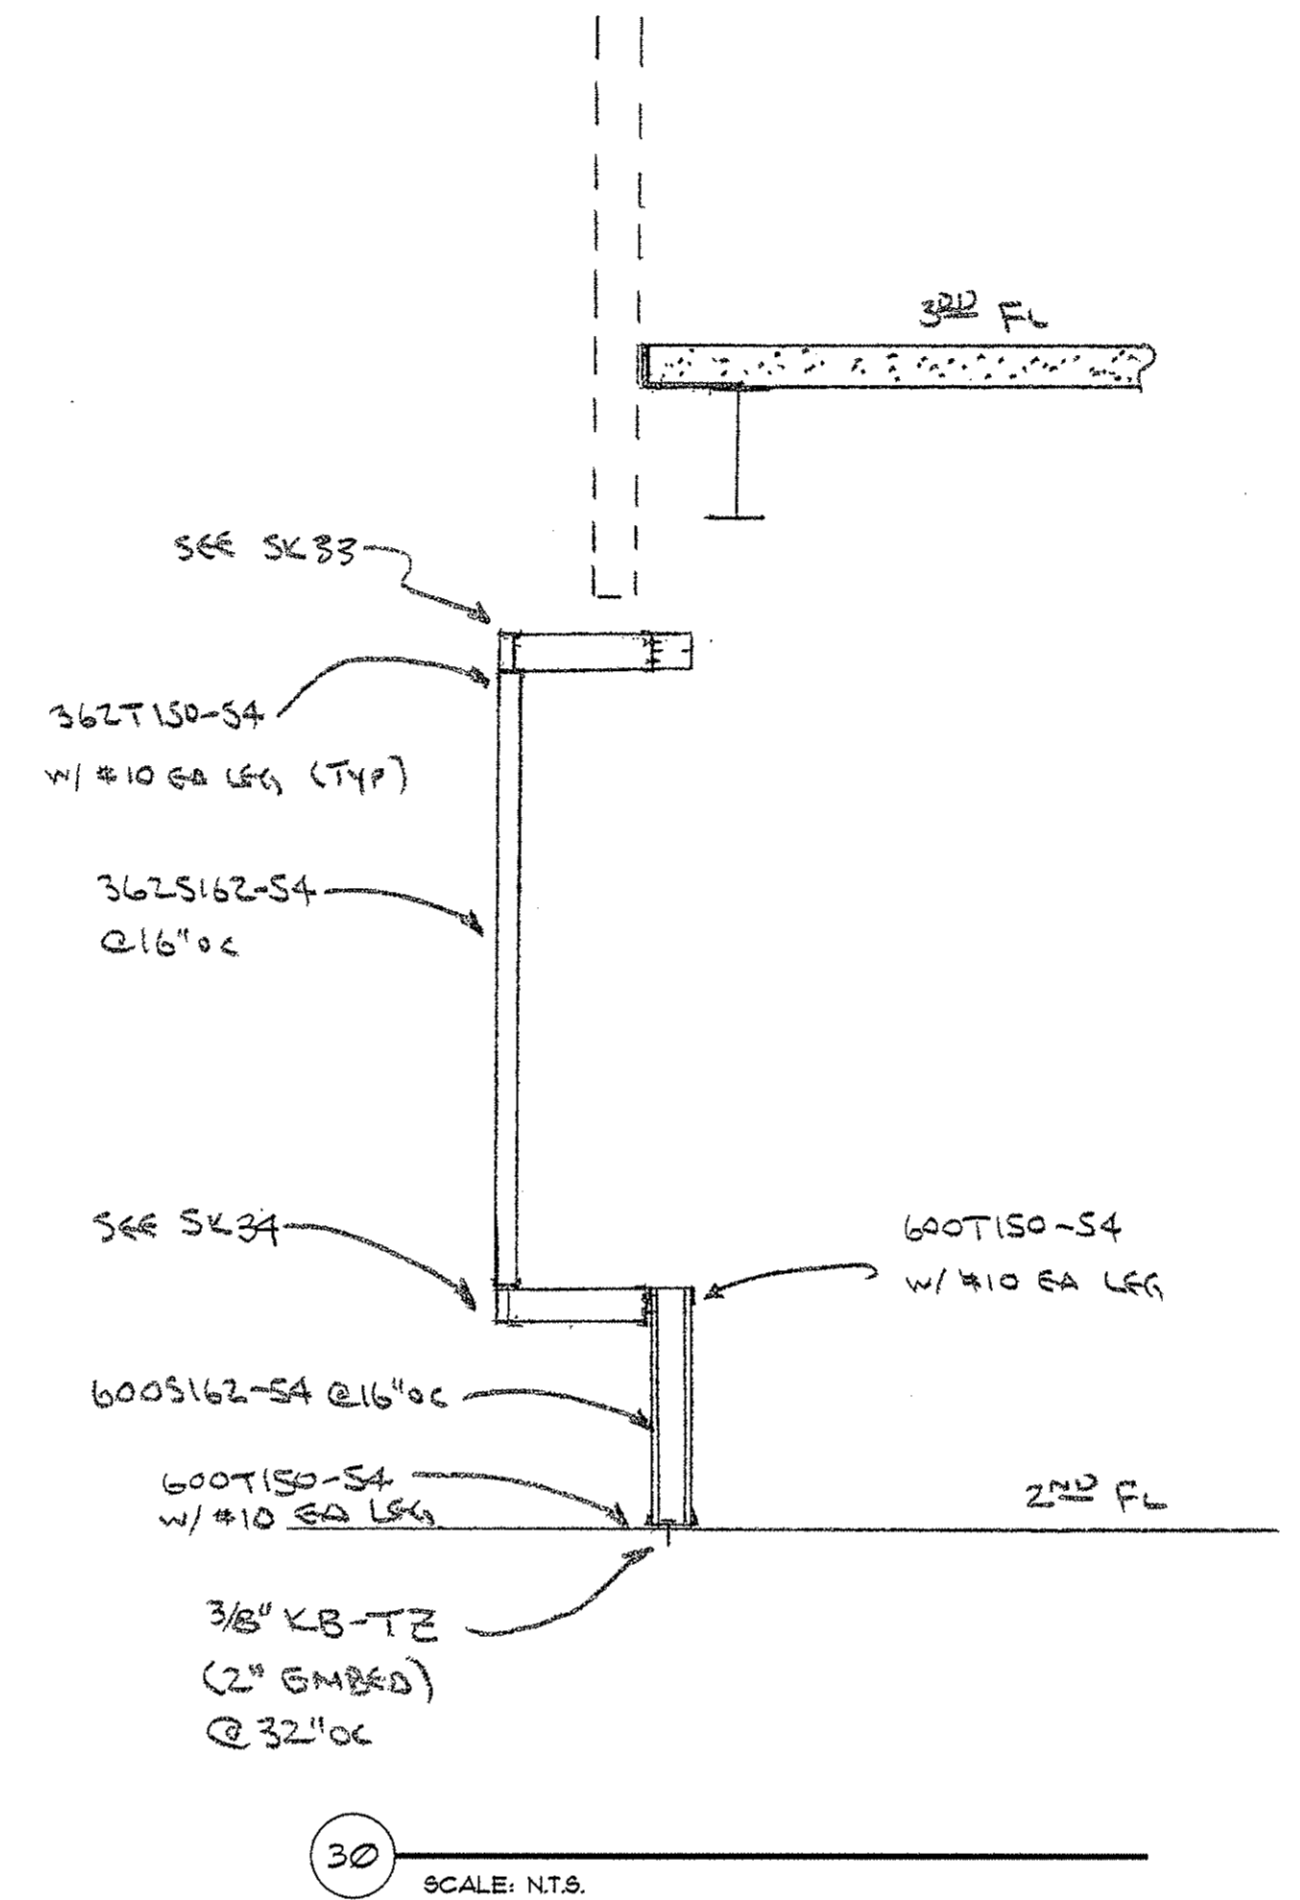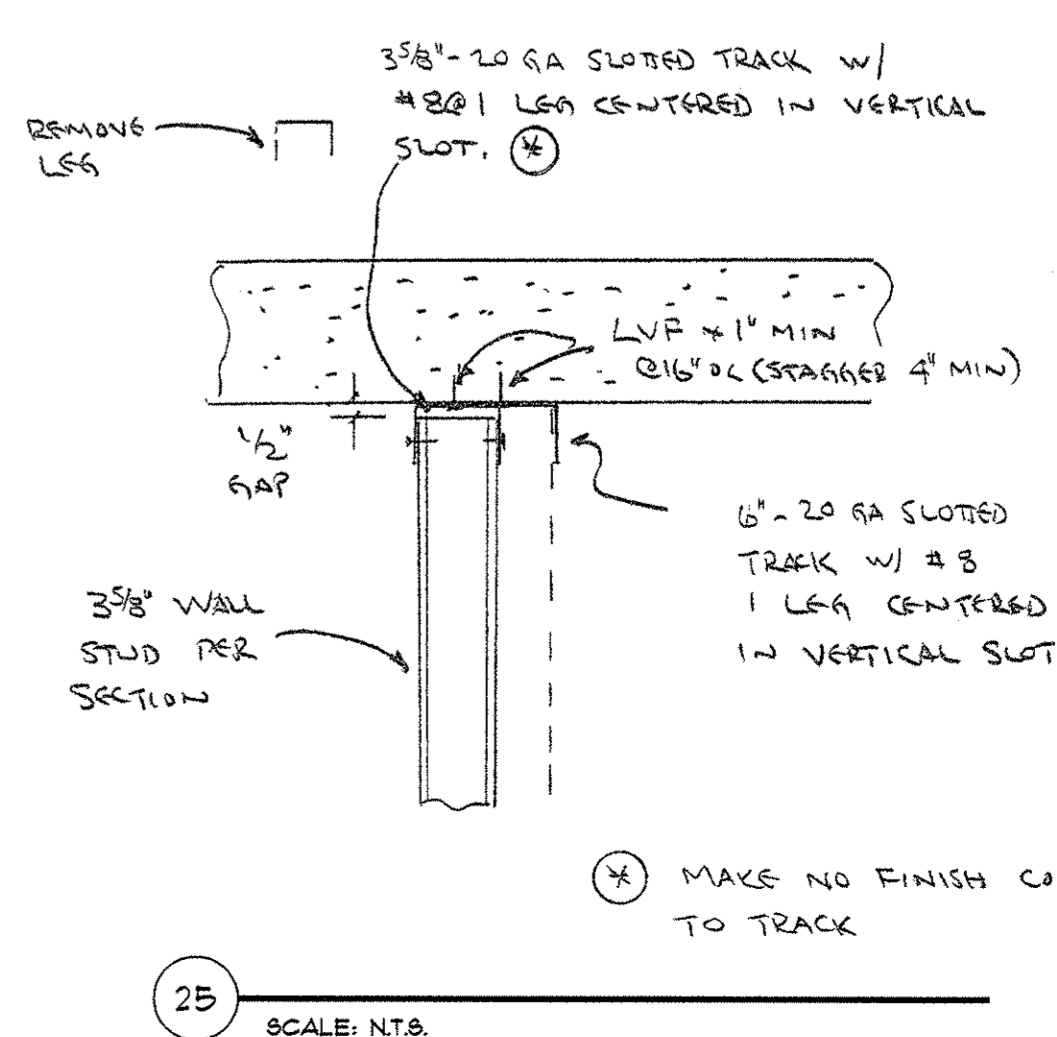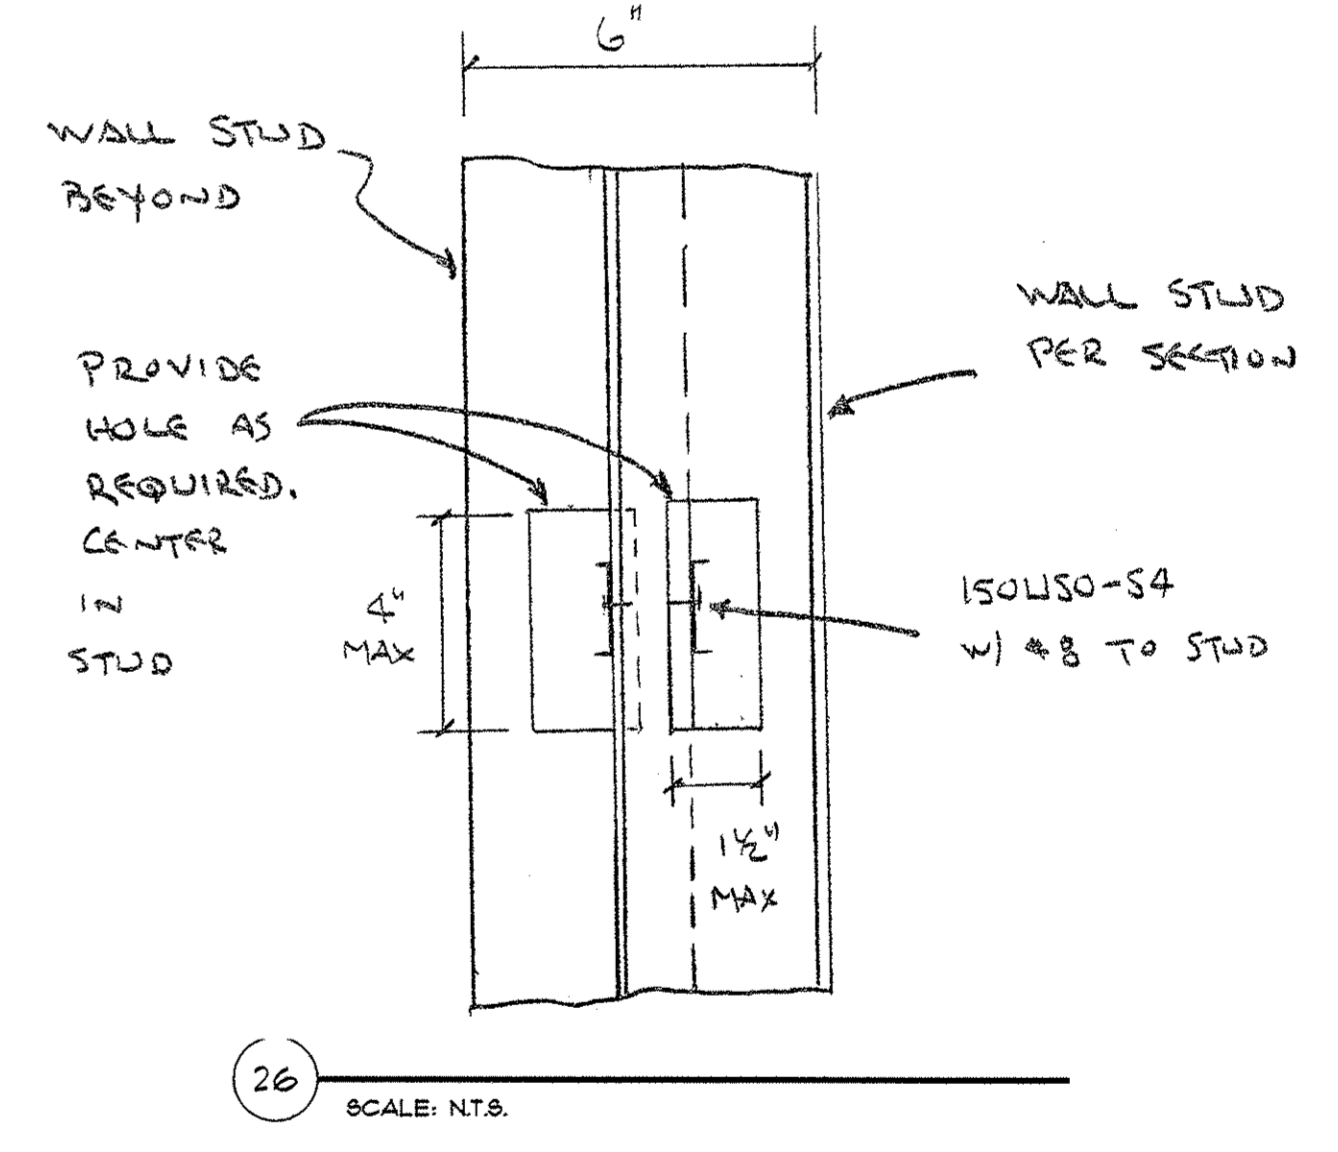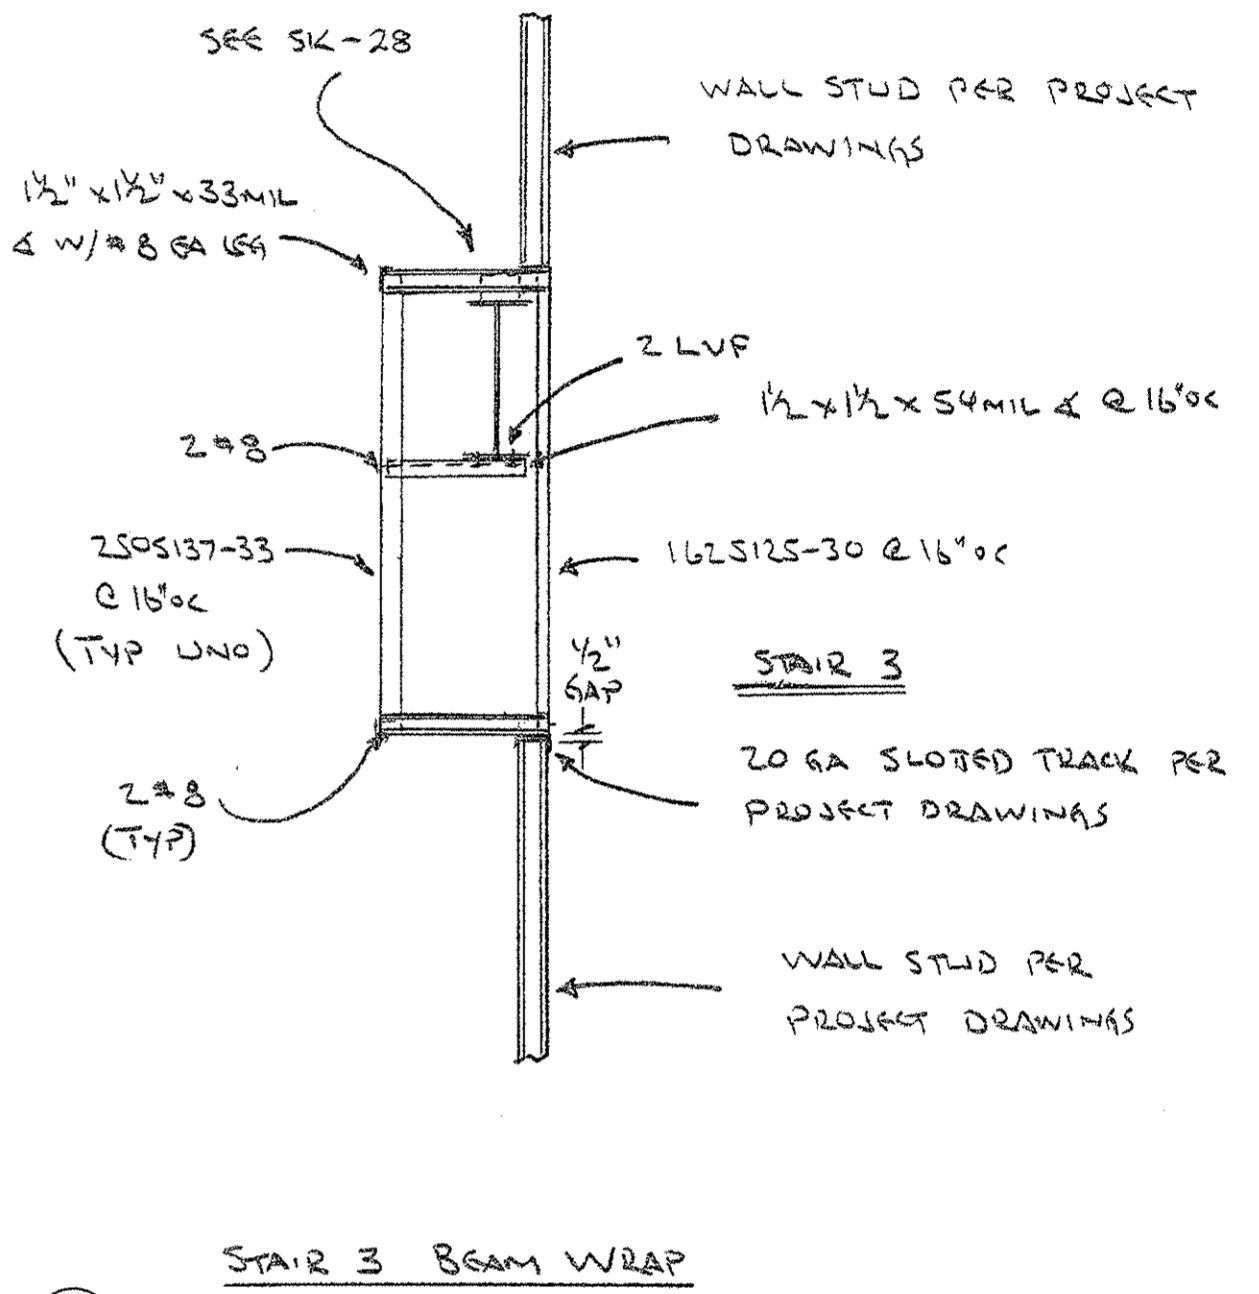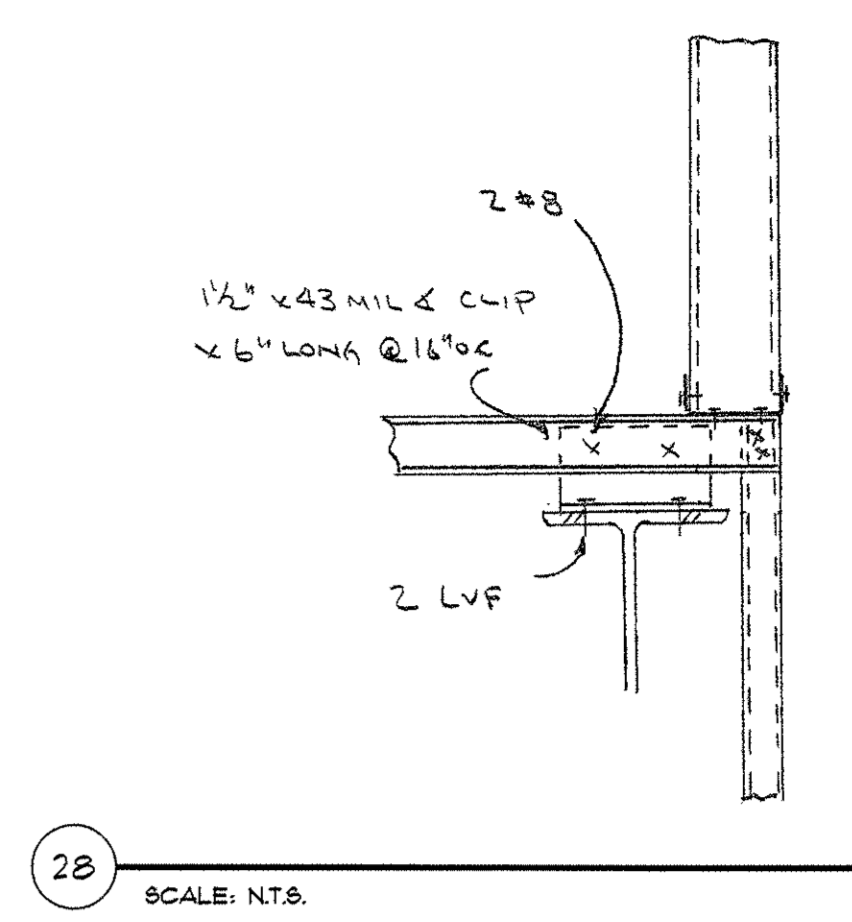

FILE: \\V:\V\0813 College of San Mateo\10-13-10 Sketches\11-11-10\TEMP\081302 SKETCHES.dwg 11/17/2010 4:38 PM - Ben





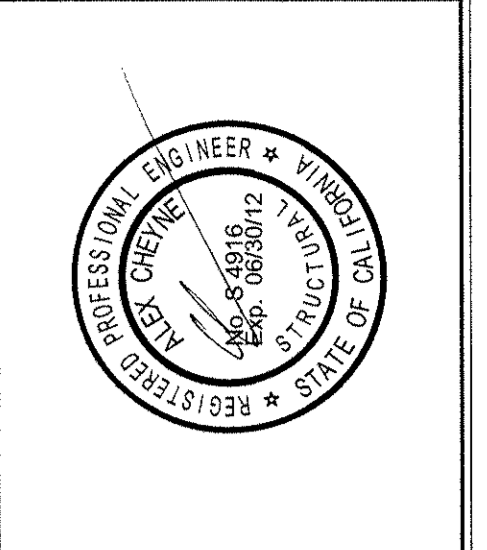


DATE:	REVISION:
8/05/08	1
	2
	3
	4
	5
	6
	7
	8
	9
	10

**DEVCO**  
 CONSULTING ENGINEERING, INC.  
 245 NE CONNER RD. BOX 1231  
 SAN MATEO, CA 94404  
 WWW.DEVCOENGINEERING.COM  
 © COPYRIGHT 2008 DEVCO, INC. ALL RIGHTS RESERVED.


PROJECT: COLLEGE OF SAN MATEO BUILDING 5N  
 PROJECT LOCATION: SAN MATEO, CA  
 CLIENT: NORTHBAY DRYWALL

SHEET TITLE: SKETCHES


JOB NO: 08-013  
 DRAWN BY: DEVCO  
 DRAWING: SF 5.04

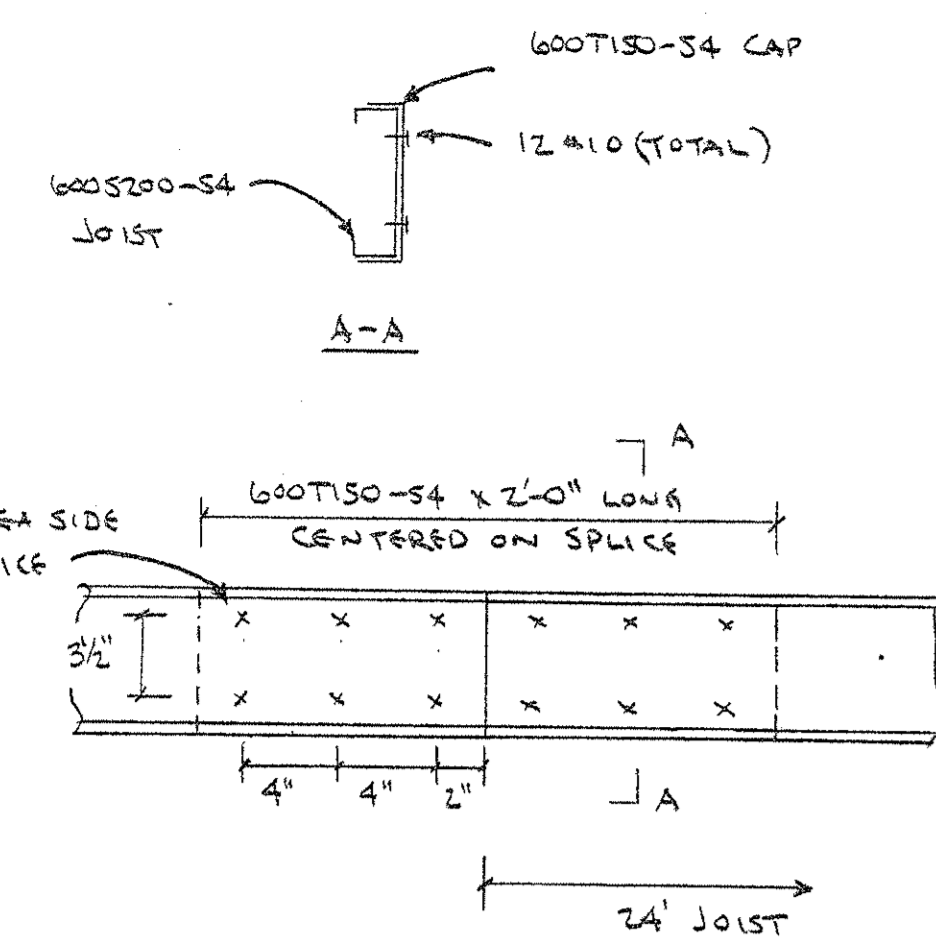


64 JOIST SPLICE DETAIL  
 SCALE: N.T.S.

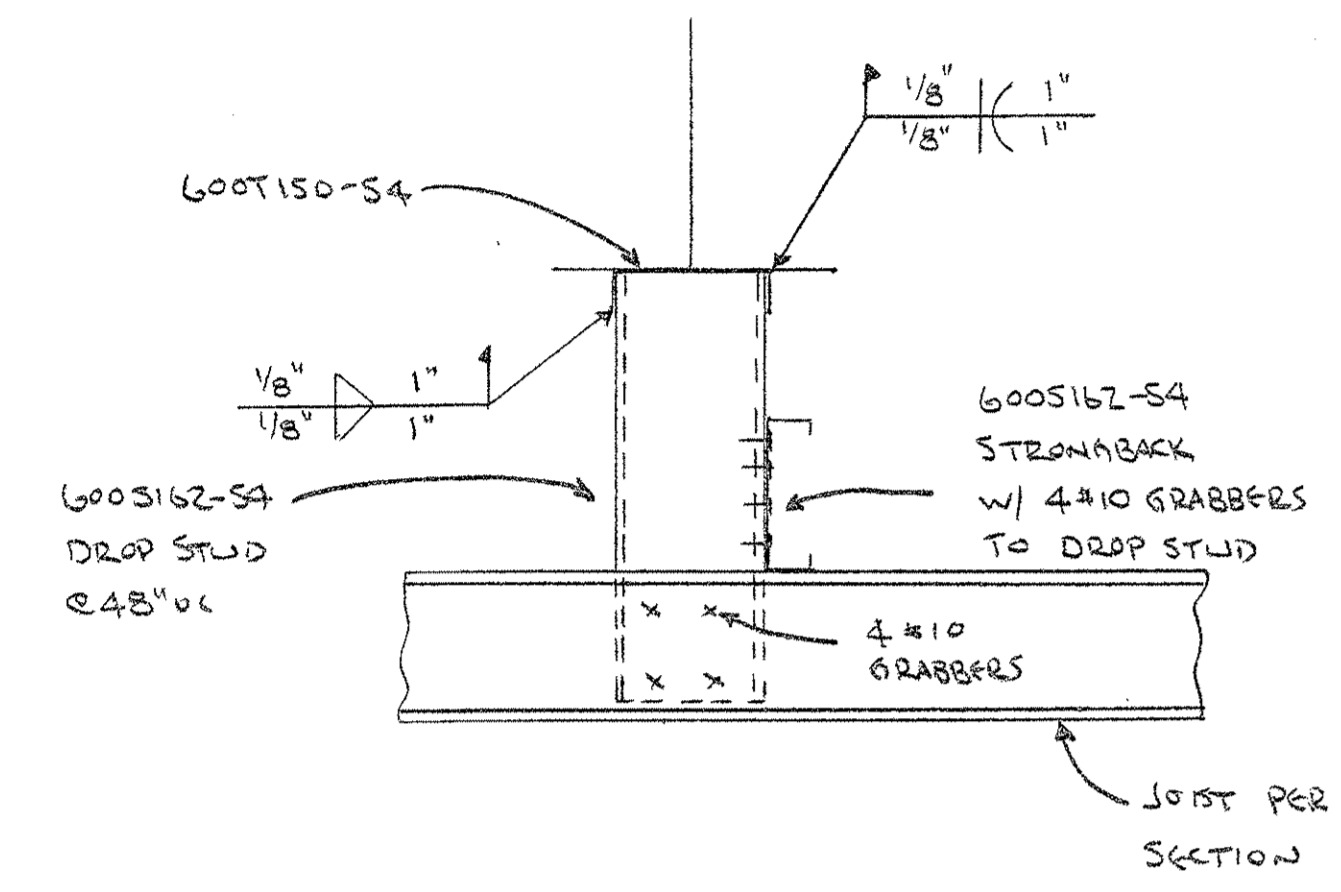


63 STRONGBACK DETAIL @ DROP STUD  
 SCALE: N.T.S.

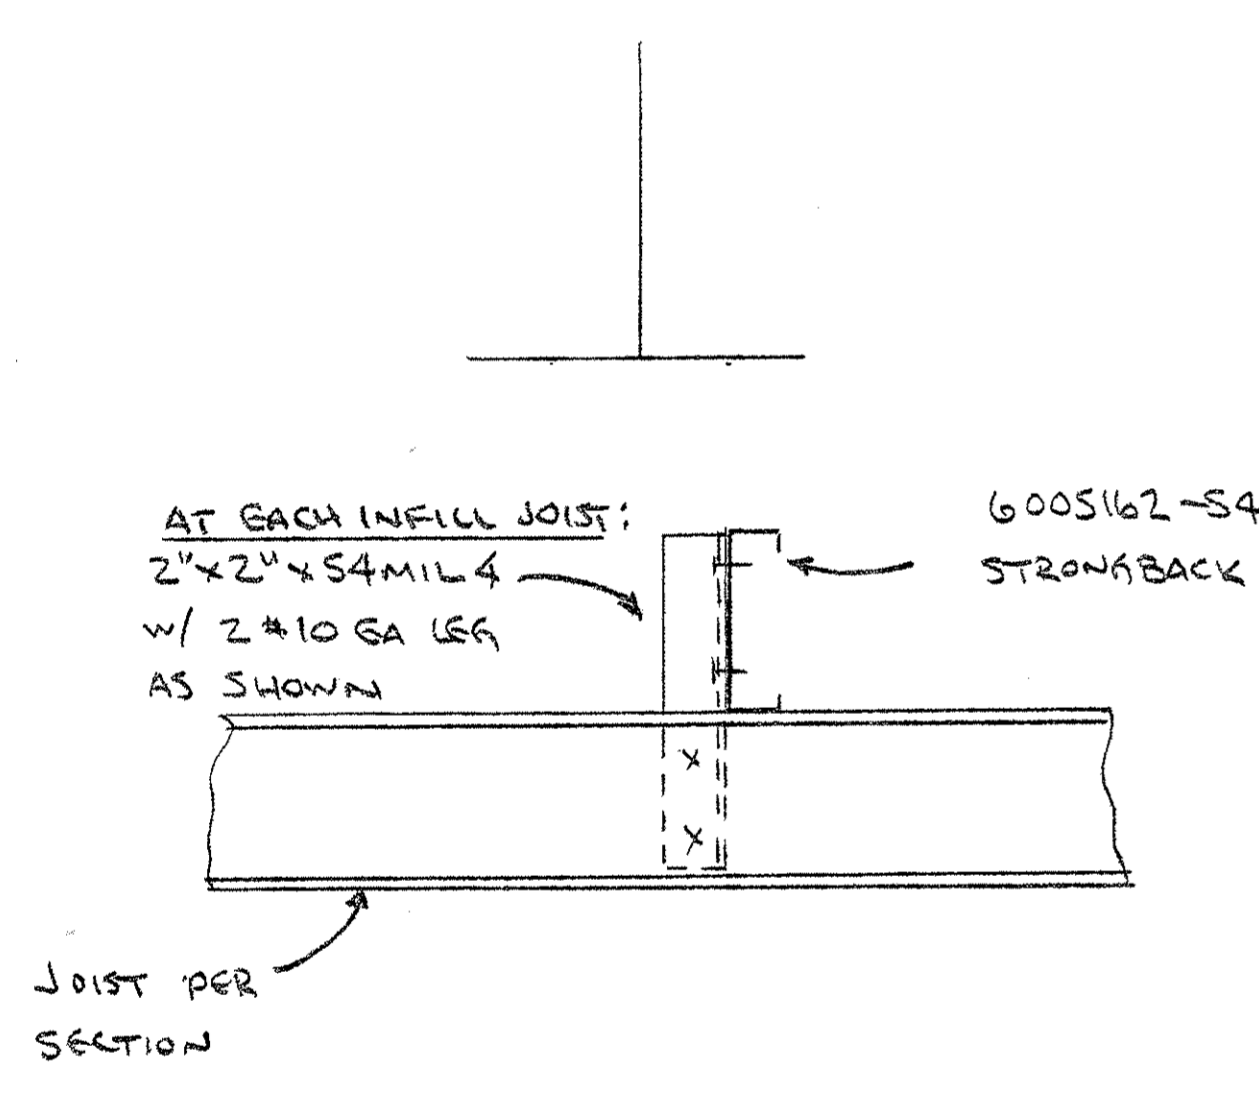


62 STRONGBACK DETAIL @ INFILL JOISTS  
 SCALE: N.T.S.

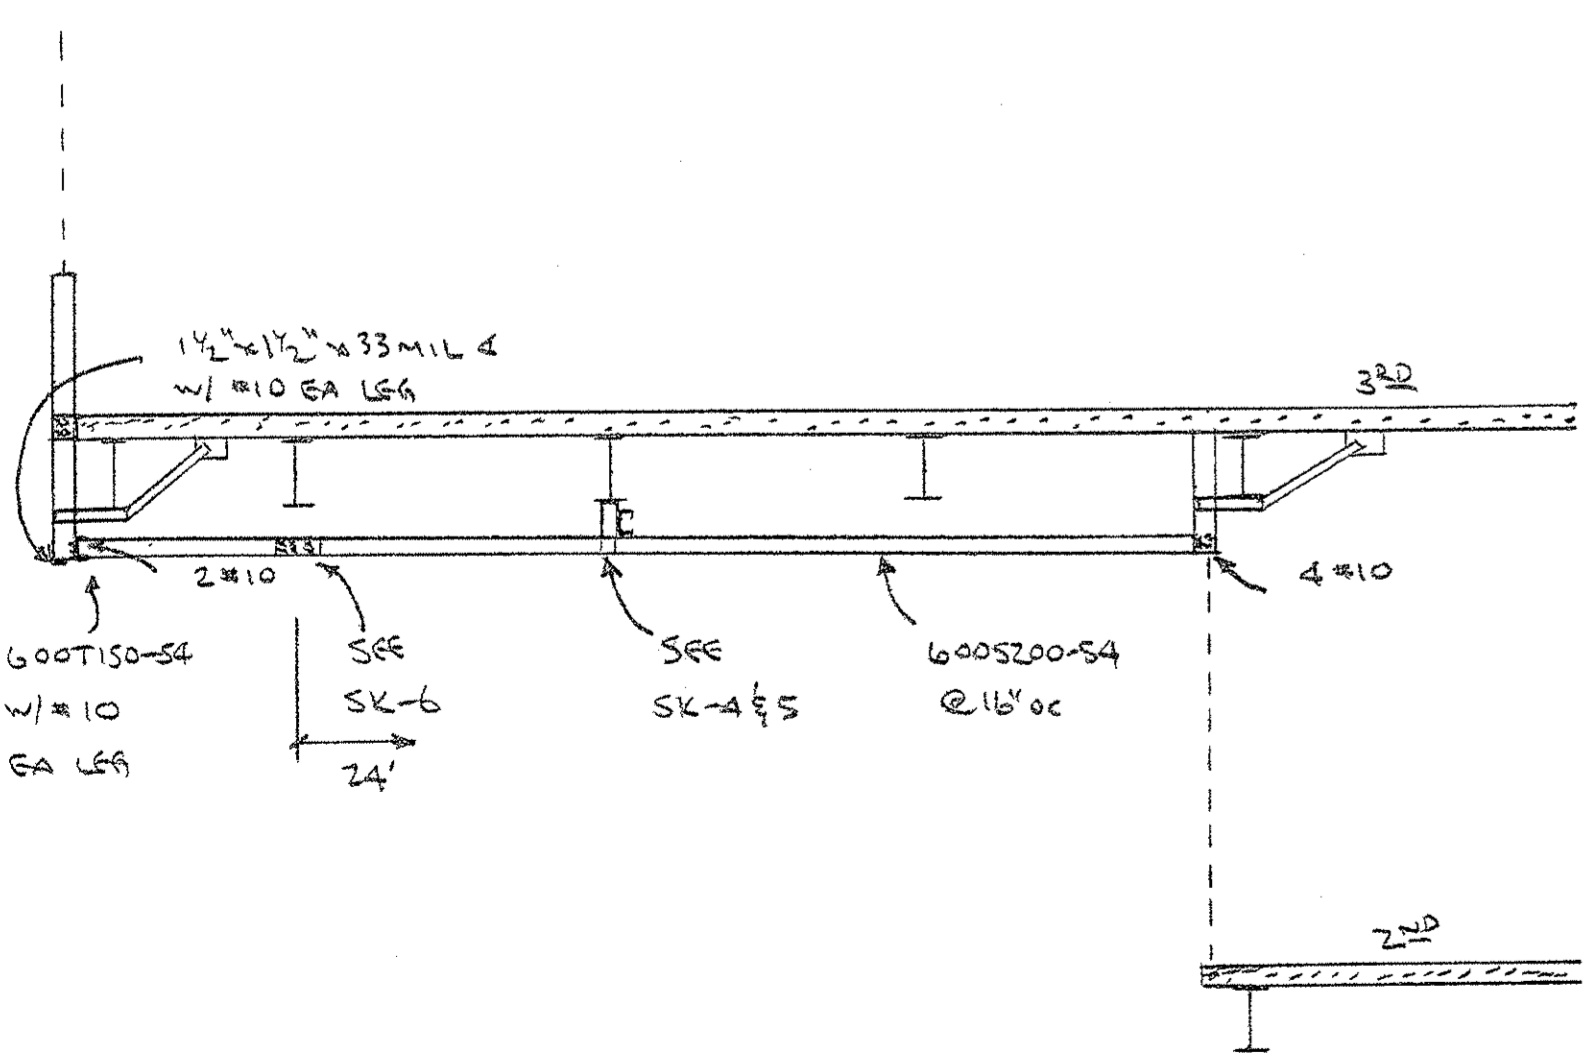

61 SOFFIT FRAMING @ 3RD FLOOR  
 SCALE: N.T.S.

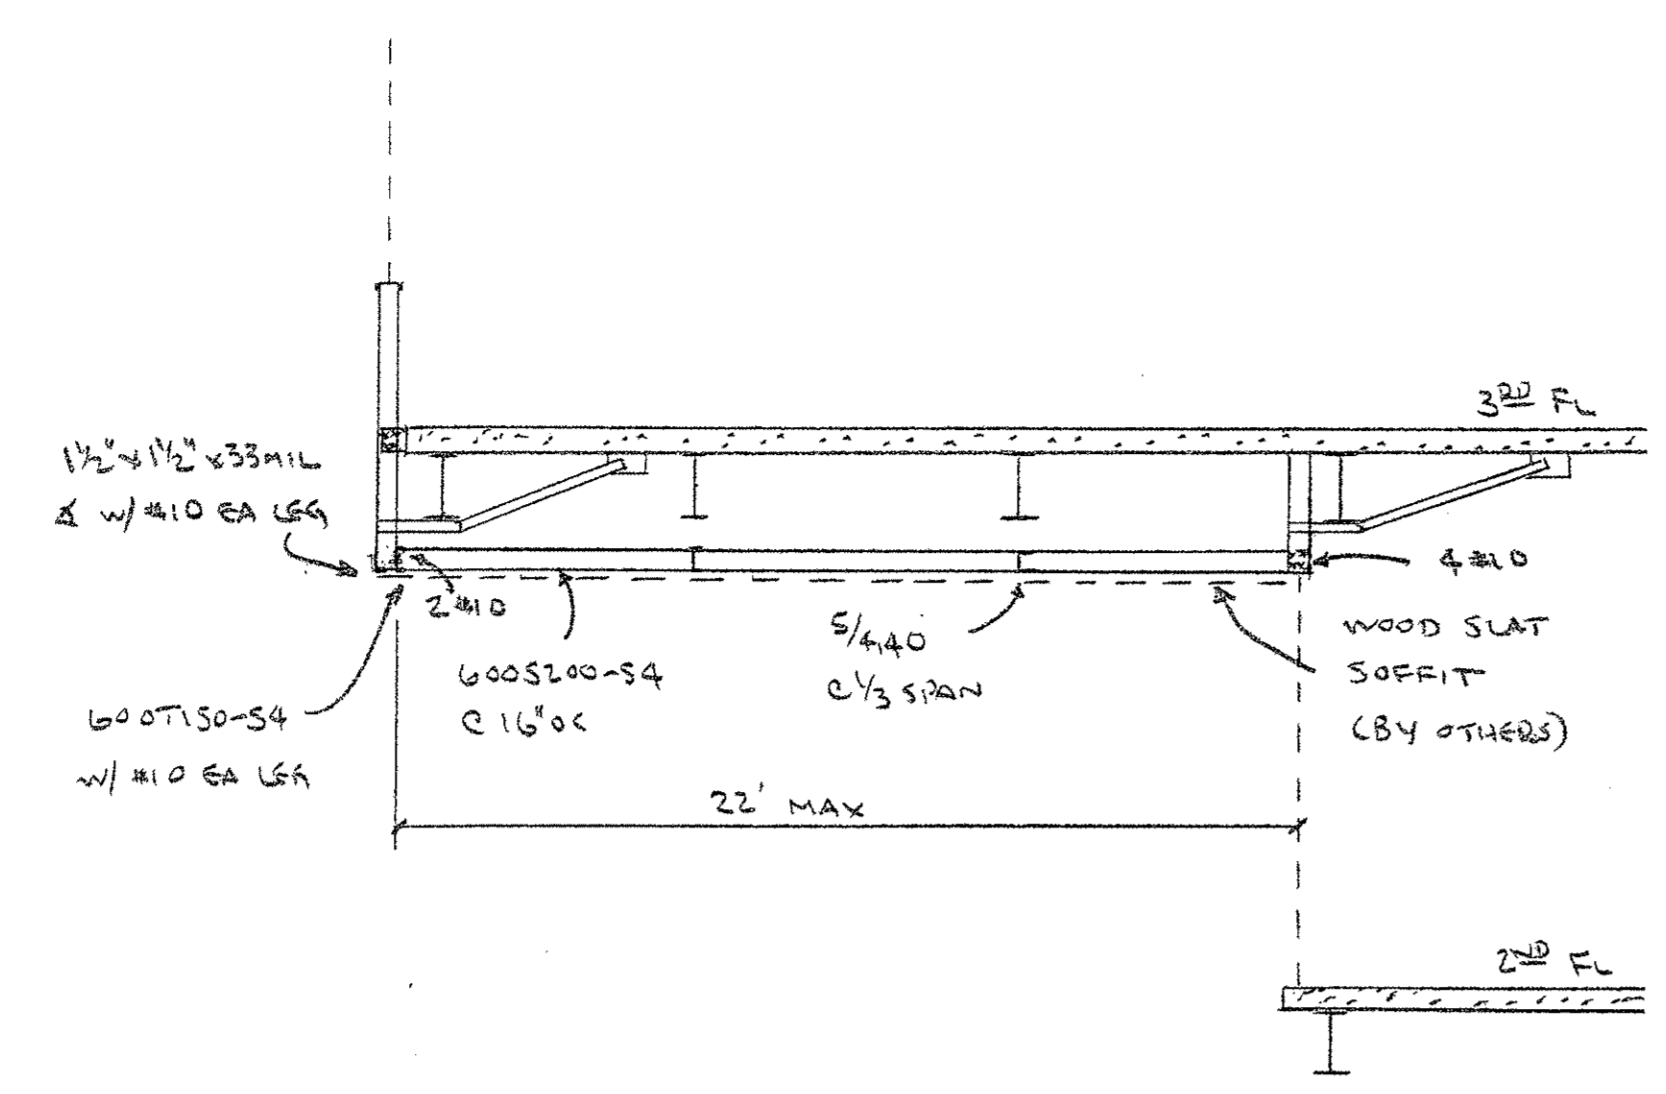


60 SOFFIT FRAMING @ 3RD FLOOR  
 SCALE: N.T.S.

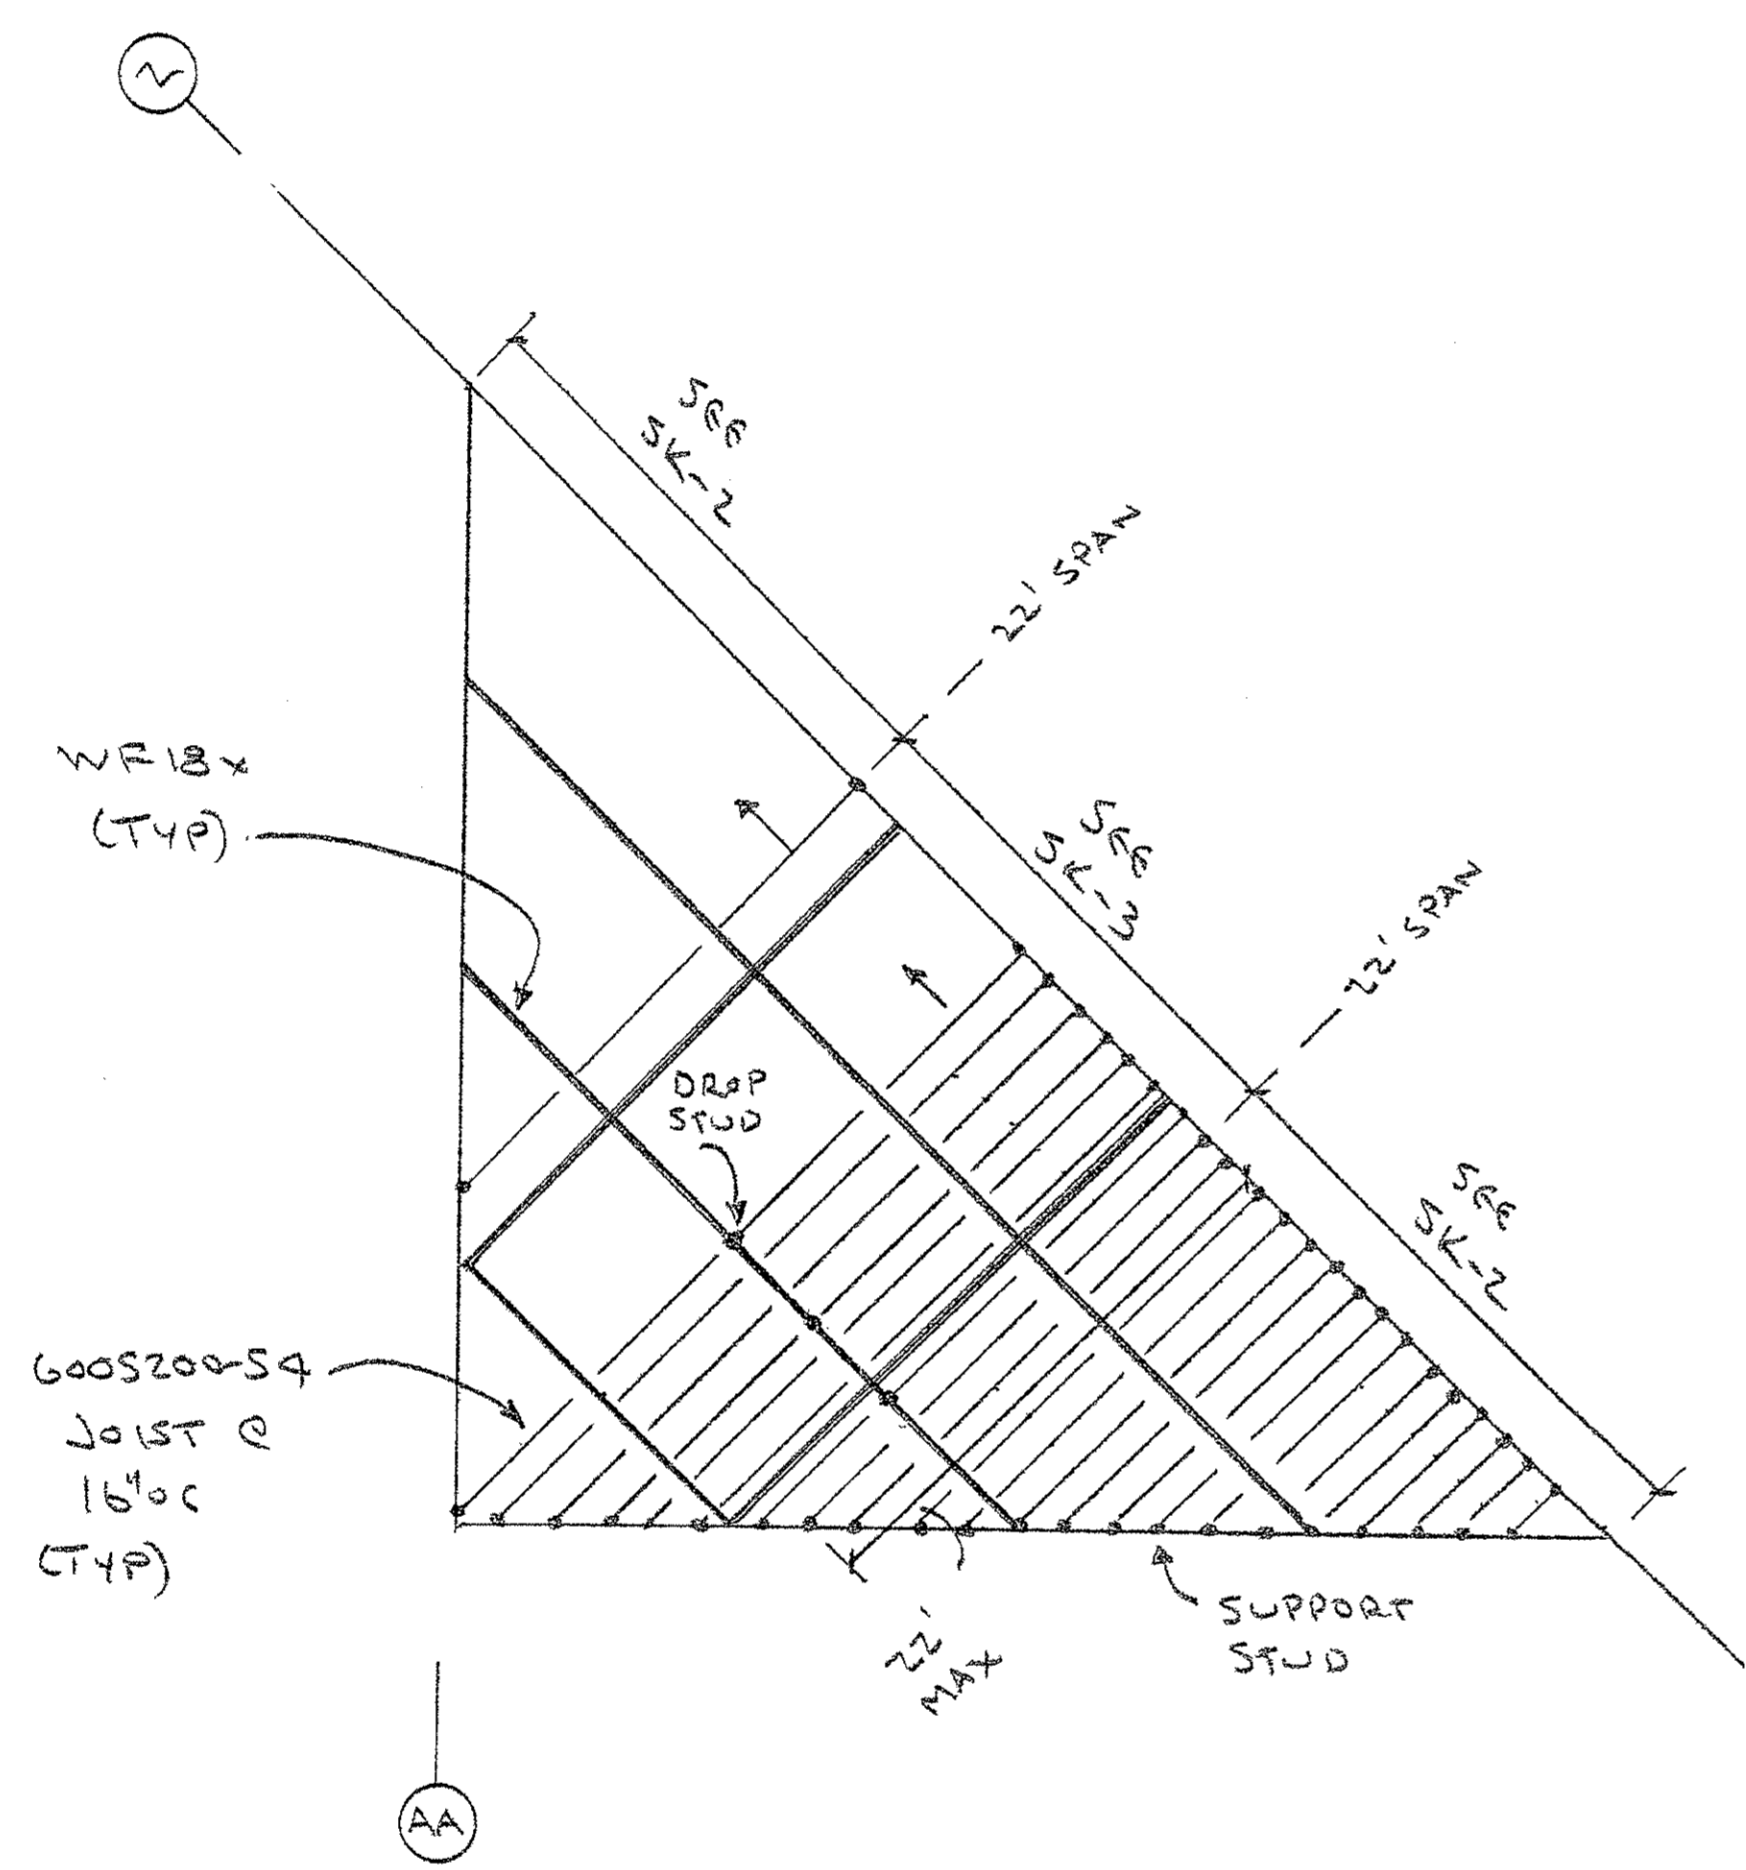


59 SOFFIT FRAMING @ 3RD FLOOR  
 SCALE: N.T.S.


HDR No.	JAMB STUDS	TRACK MATERIALS	HEADER STUDS	CONNECTION	REMARKS
108-1	600S162-43	600T150-43	(2) 362S162-43	(1) LVF	

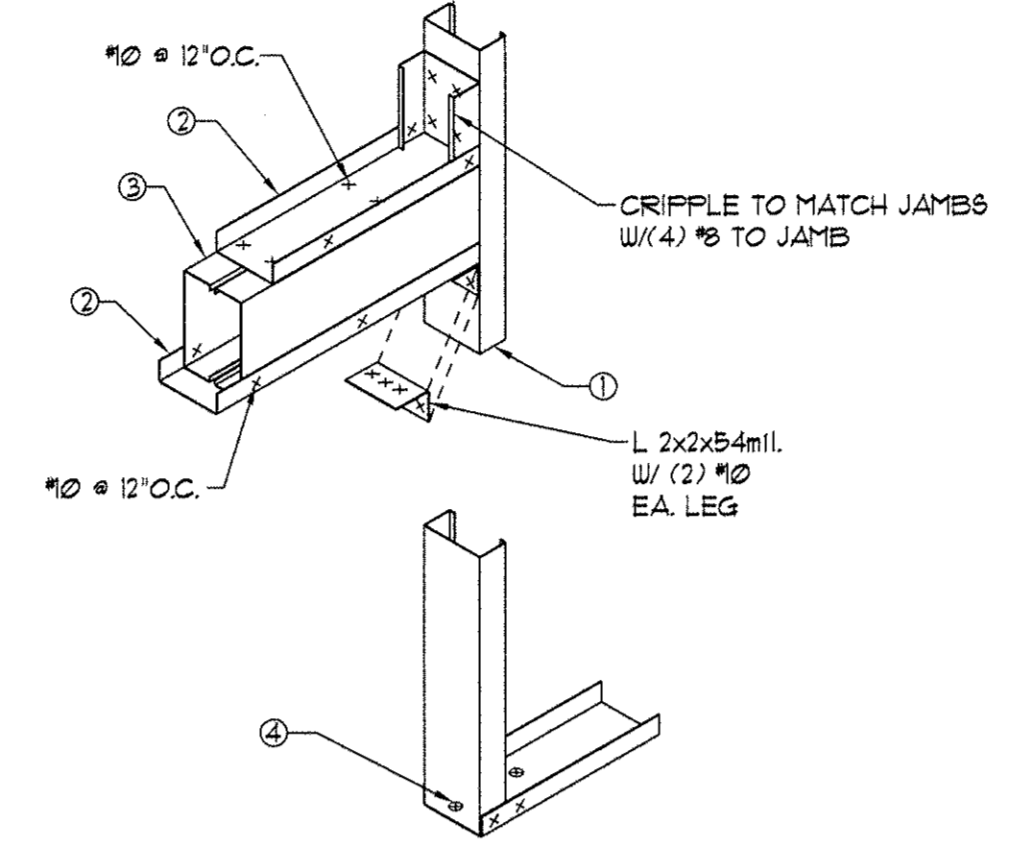


57 JAMB/HEADER DETAIL  
 SCALE: N.T.S.

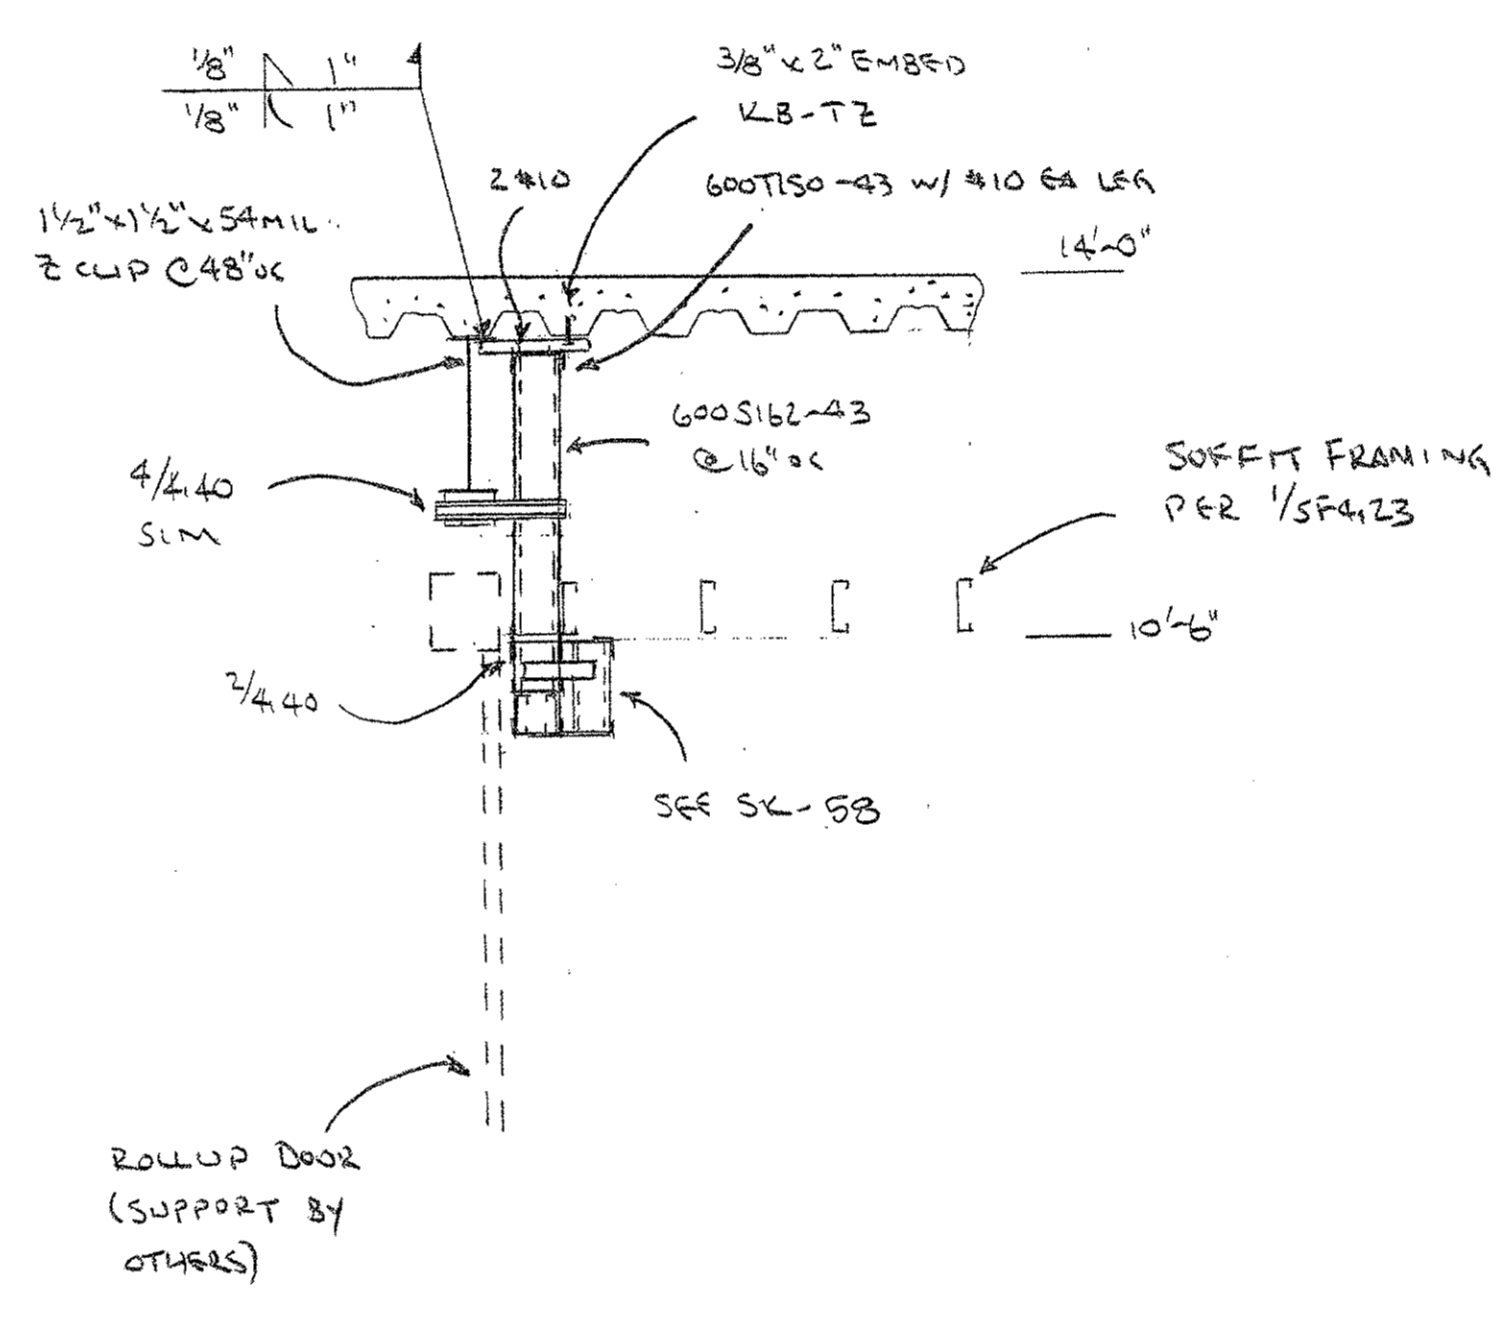


56 SOFFIT FRAMING @ 3RD FLOOR  
 SCALE: N.T.S.

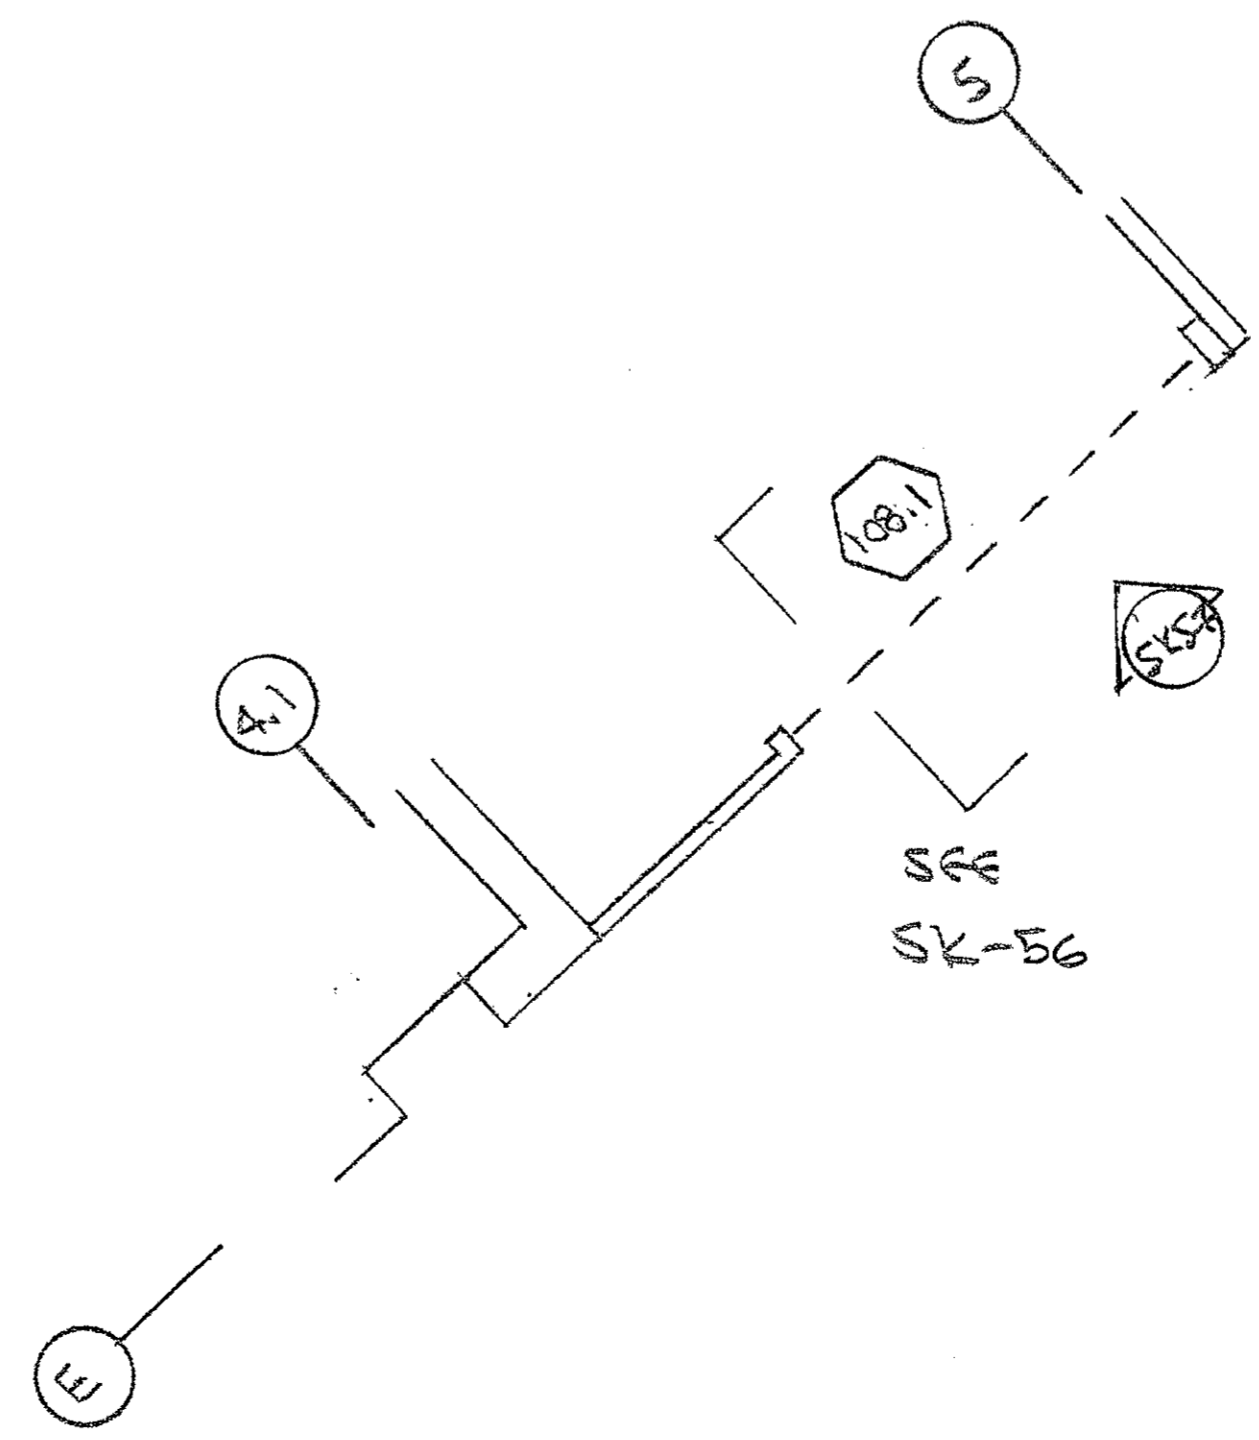


55 SOFFIT FRAMING @ 3RD FLOOR  
 SCALE: N.T.S.

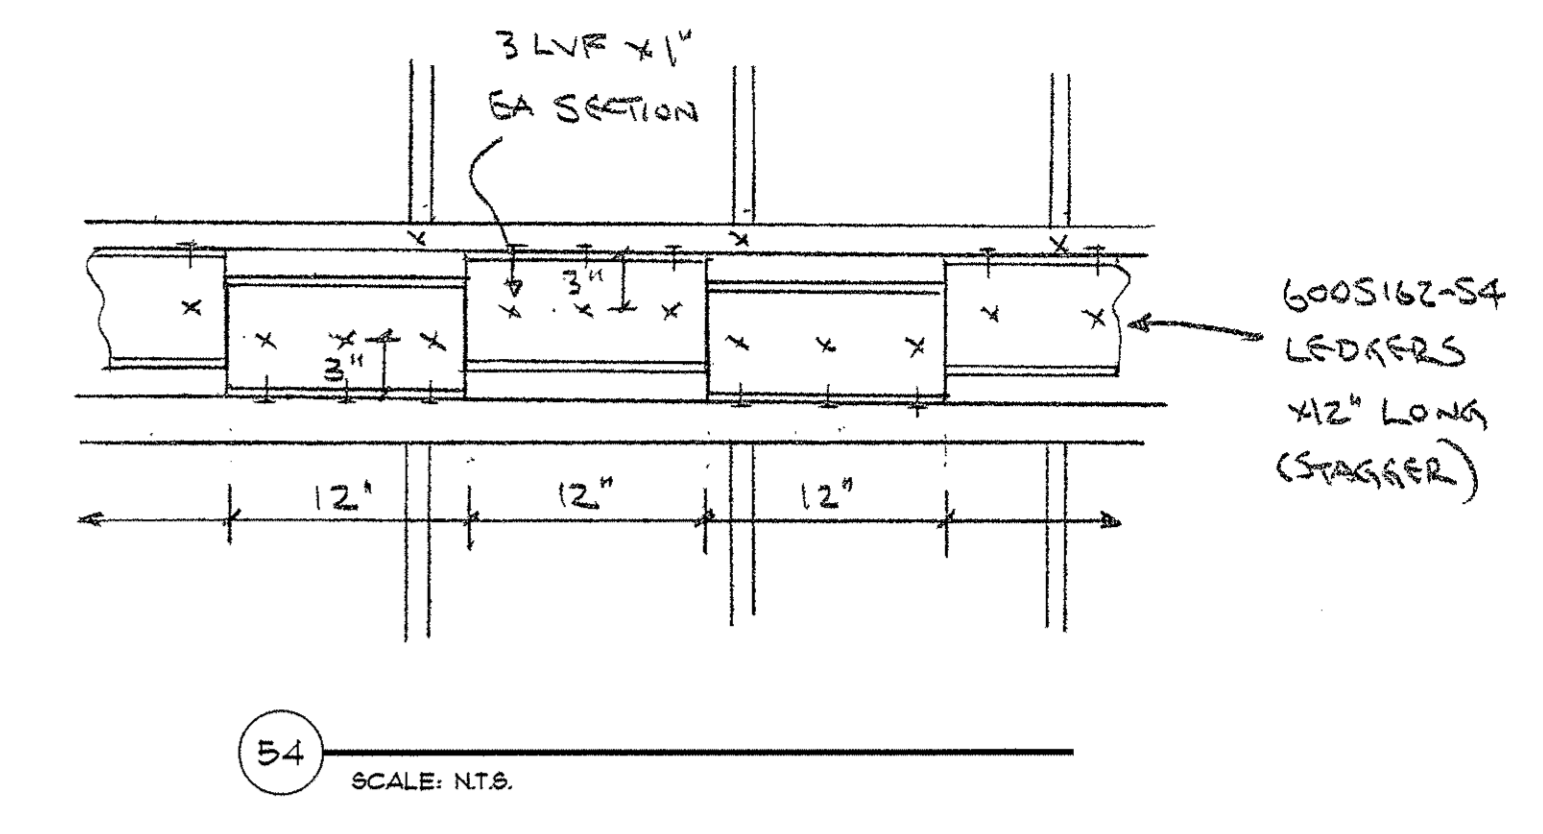


54 INTERIOR SLAB EDGE FRAMING  
 SCALE: N.T.S.

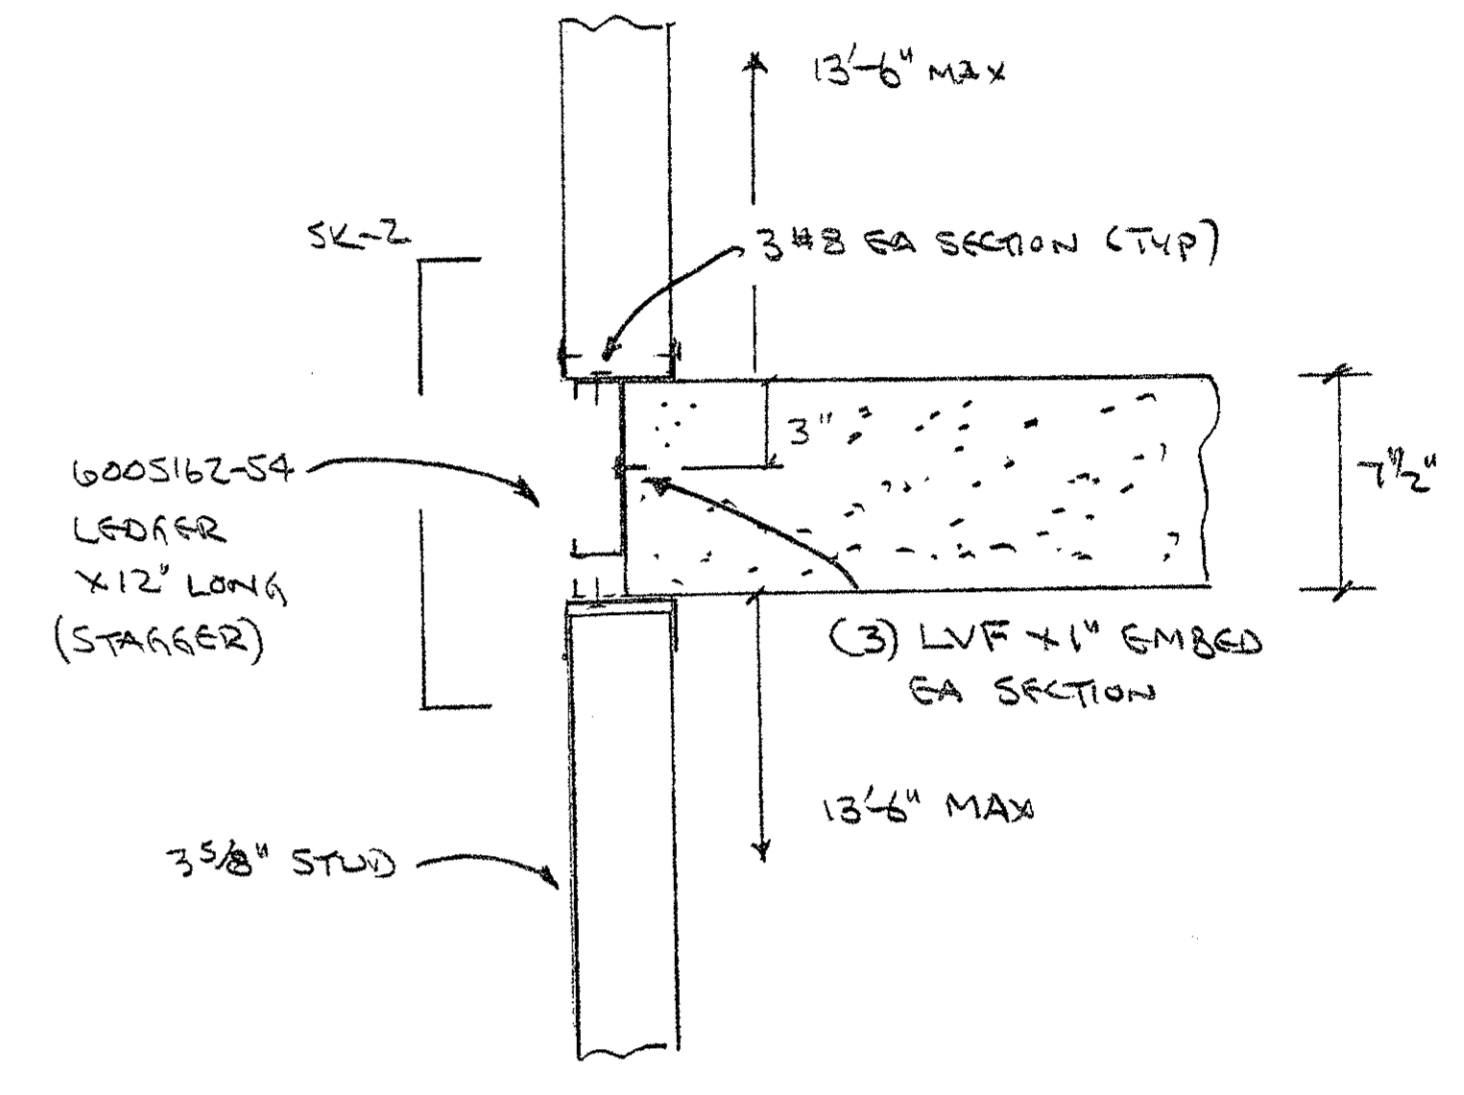

53 INTERIOR SLAB EDGE FRAMING  
 SCALE: N.T.S.

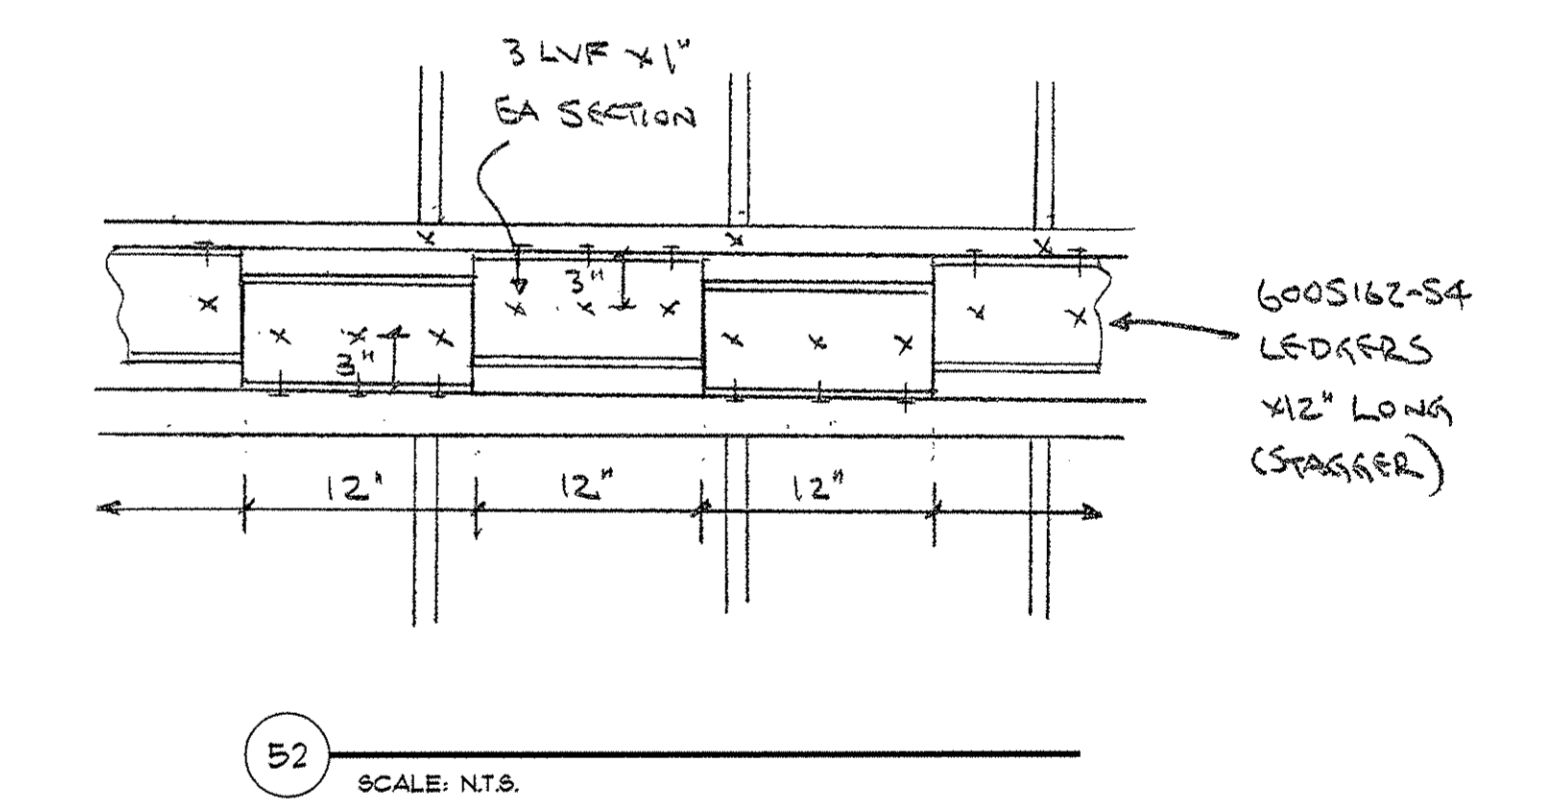


52 INTERIOR SLAB EDGE FRAMING  
 SCALE: N.T.S.

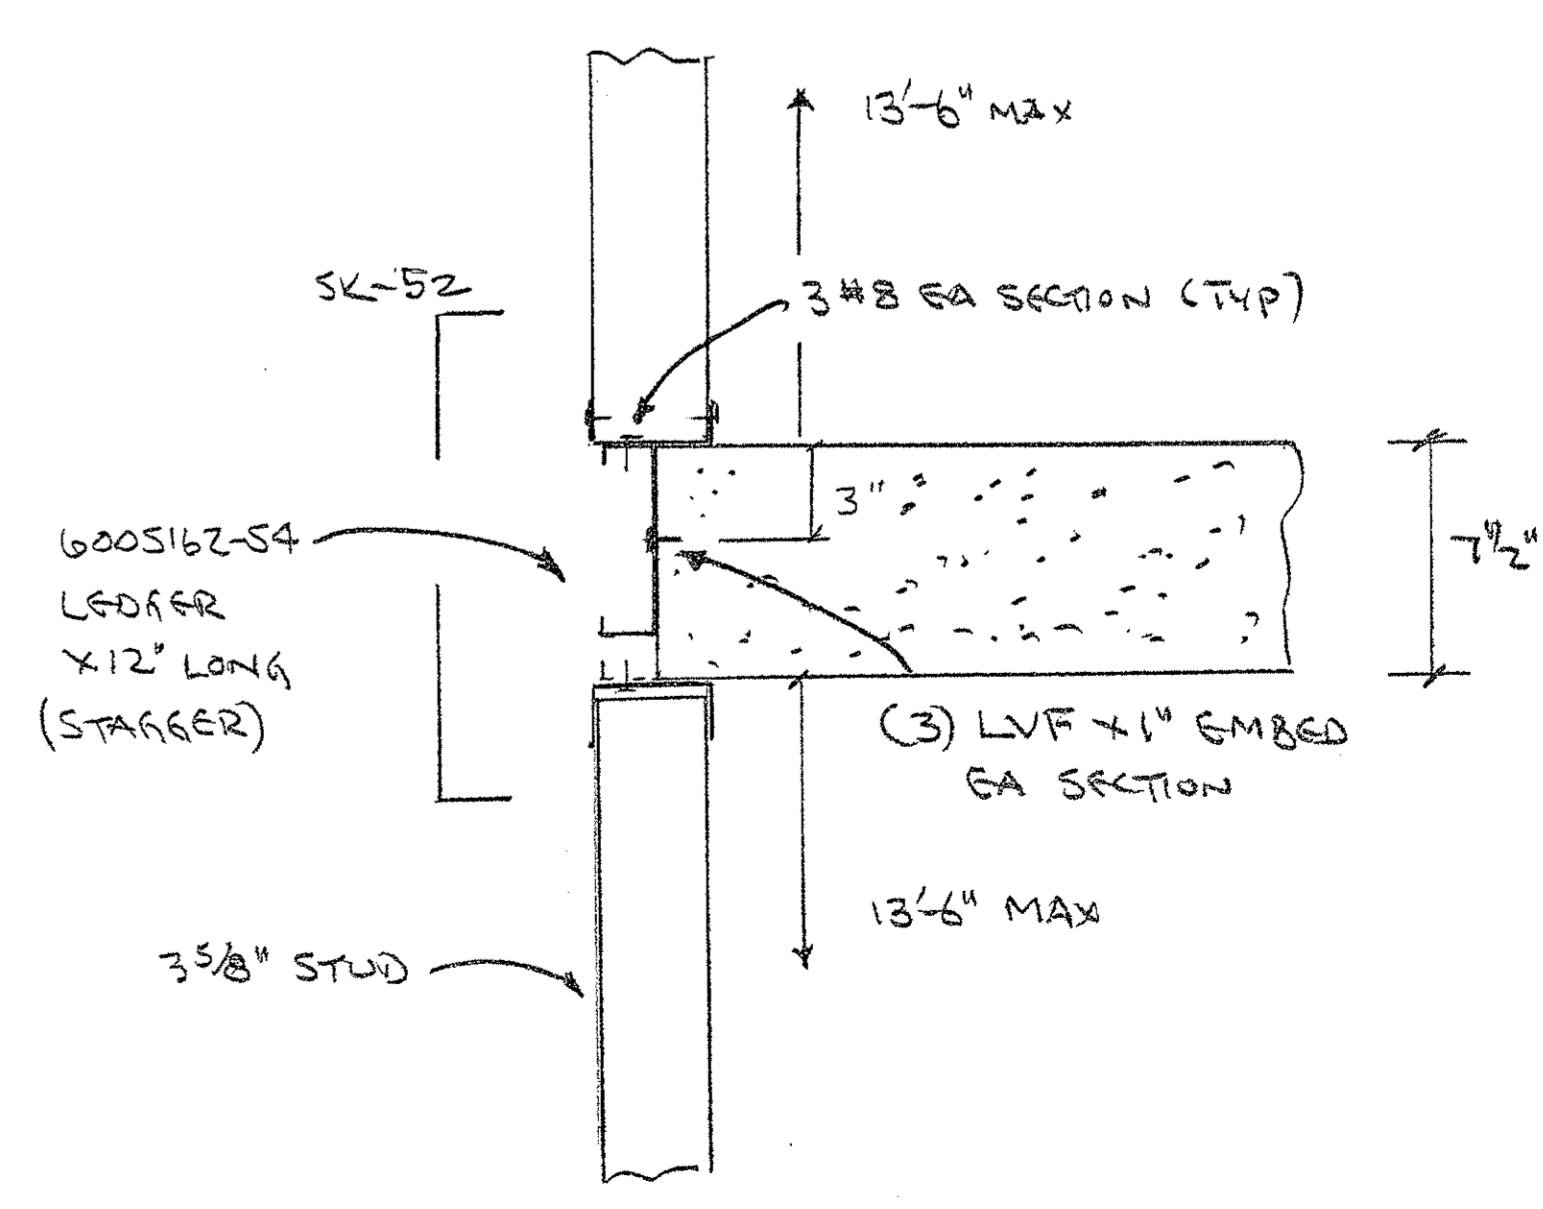

51 INTERIOR SLAB EDGE FRAMING  
 SCALE: N.T.S.

FILE: A:\08\08013 College of San Mateo\10-13-10 5am\REVISED 11-11-10\TEMP\0801304 SKETCHES.dwg 11/12/2010 8:27 AM - Bin



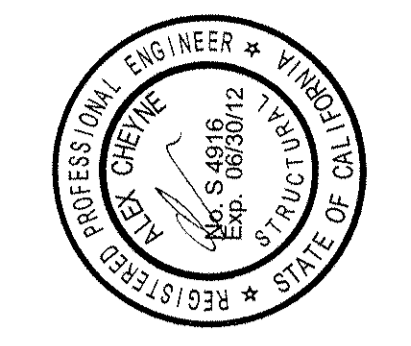














DATE	REVISION
6/05/08	1
	2
	3
	4
	5
	6
	7
	8
	9
	10

**Devco**  
 engineering inc.  
 245 THE CENTER, P.O. BOX 121  
 CORVALLIS, OR 97330  
 WWW.DEVCOENGINEERING.COM  
 © COPYRIGHT 2008  
 DEVCO ENGINEERING, INC.  
 ALL RIGHTS RESERVED.

PROJECT: COLLEGE OF SAN MATEO  
 BUILDING 5N  
 PROJECT LOCATION: SAN MATEO, CA  
 CLIENT: NORTH BAY DRYWALL

SHEET TITLE: SKETCHES

JOB NO. 08-013  
 DRAWN BY: DEVCO  
 DRAWING: SF 5.05

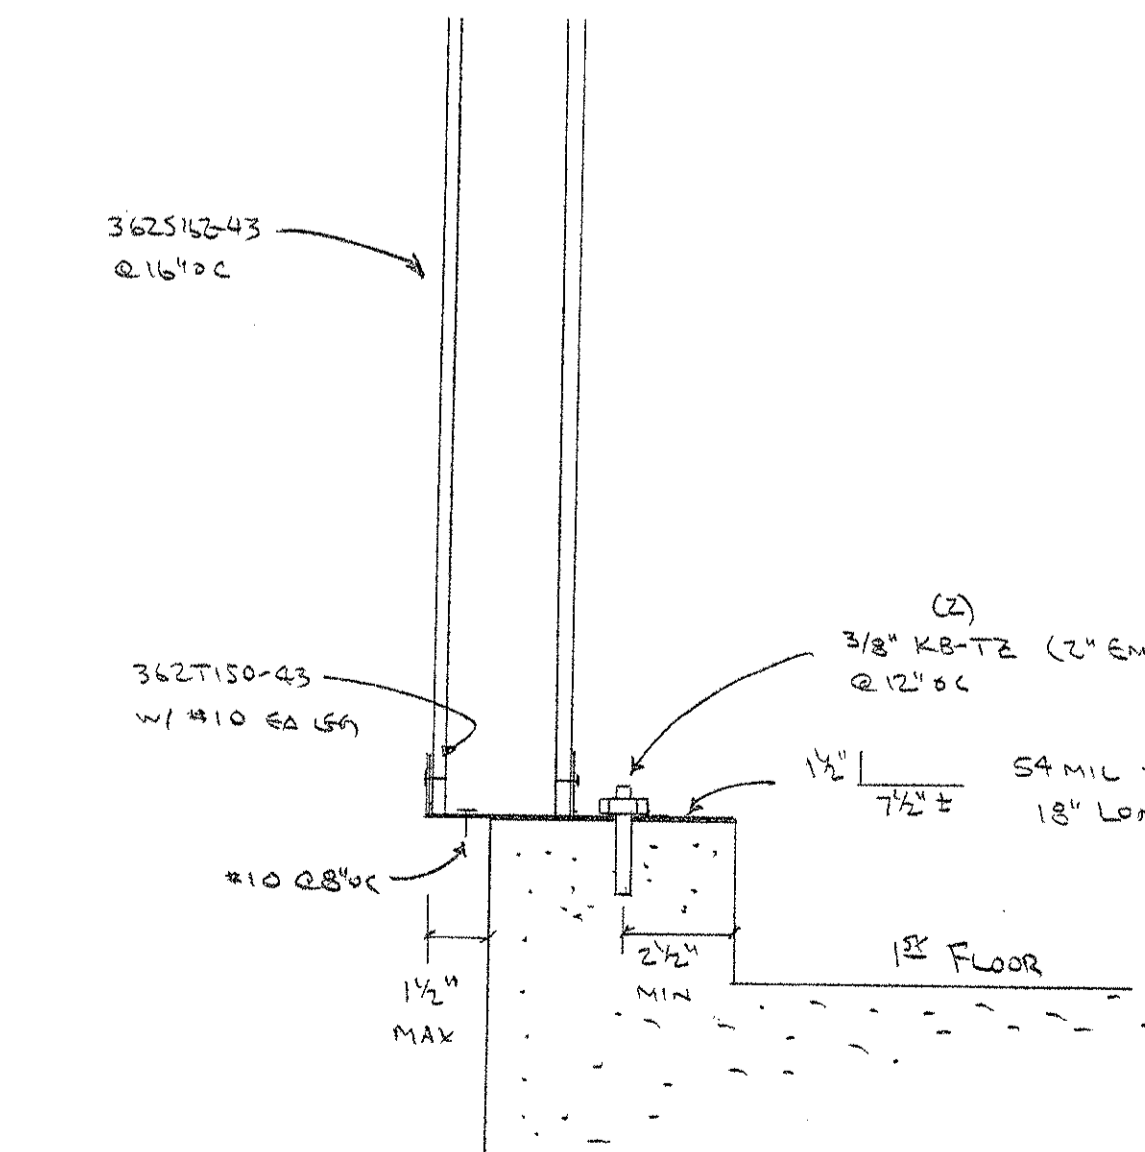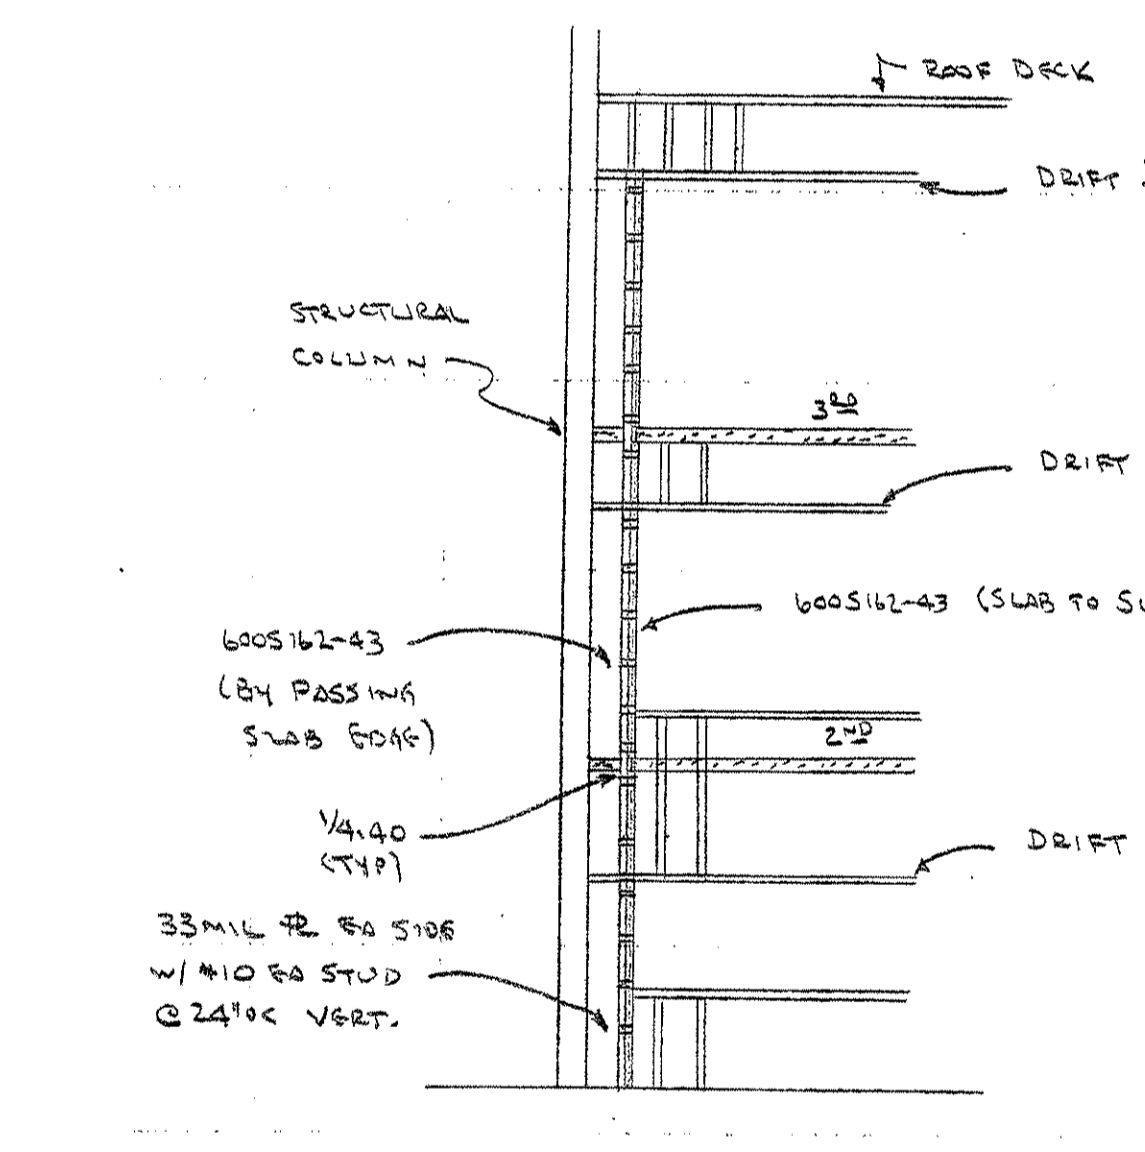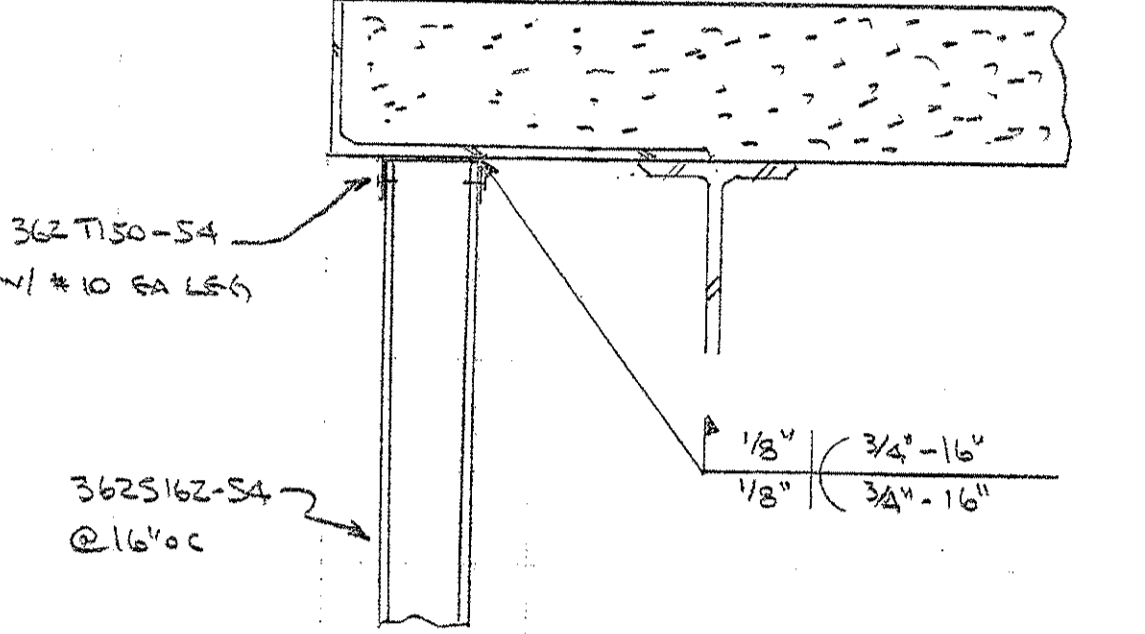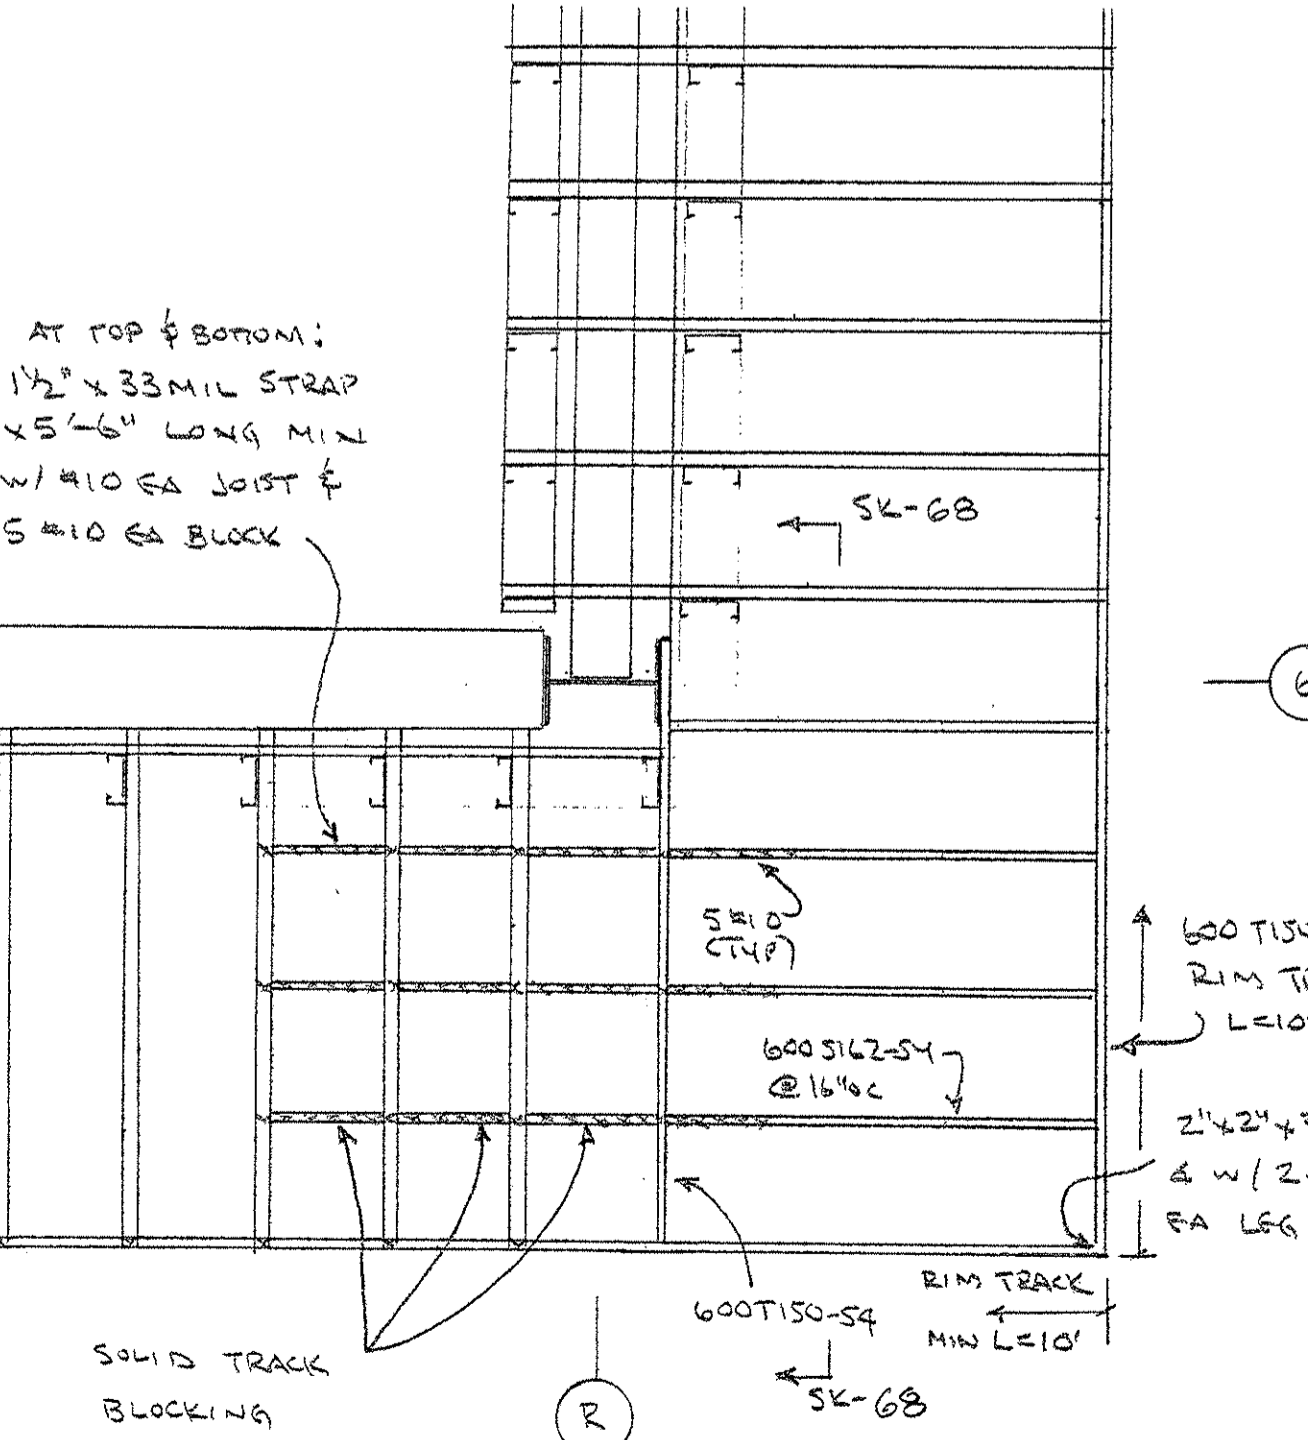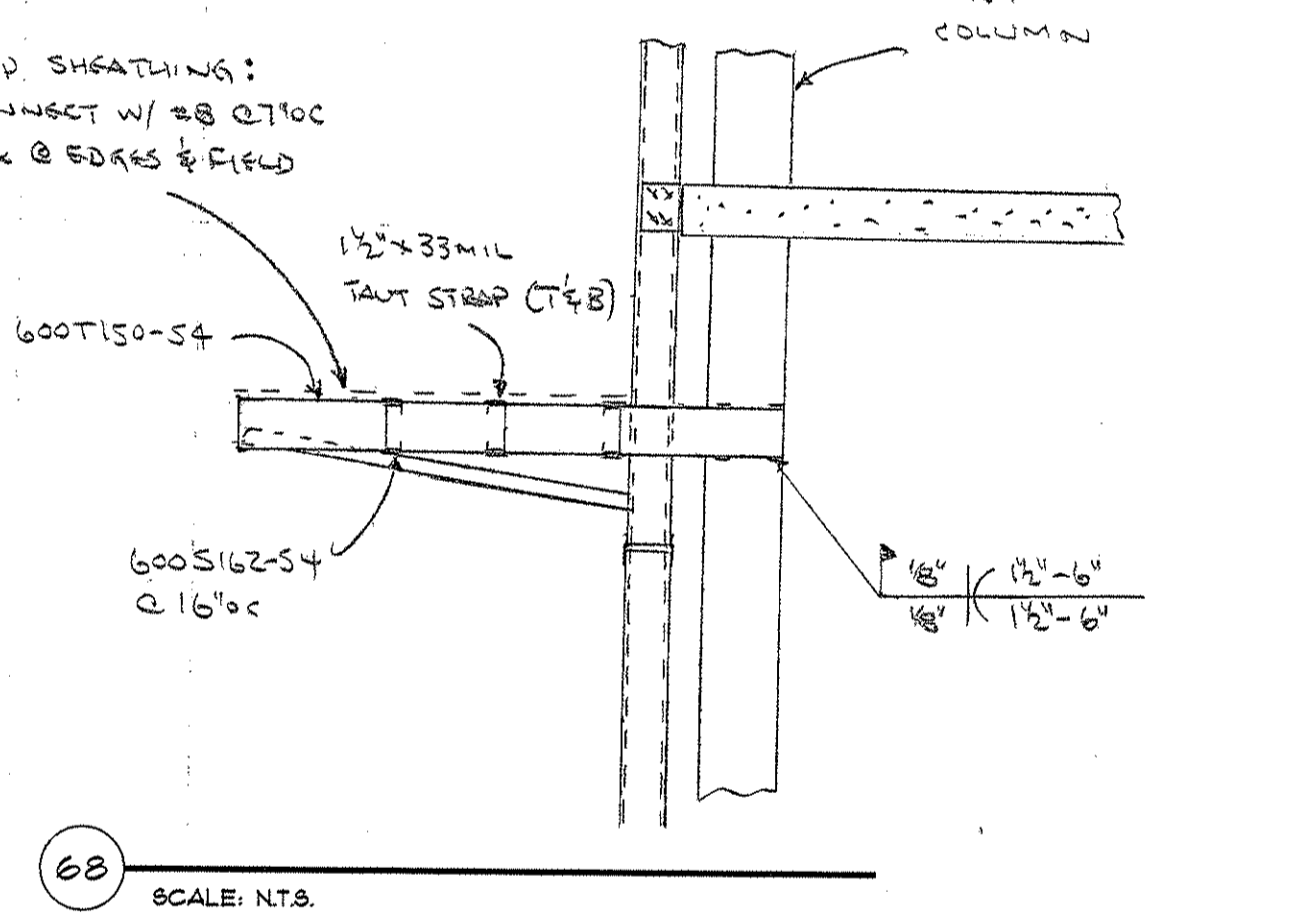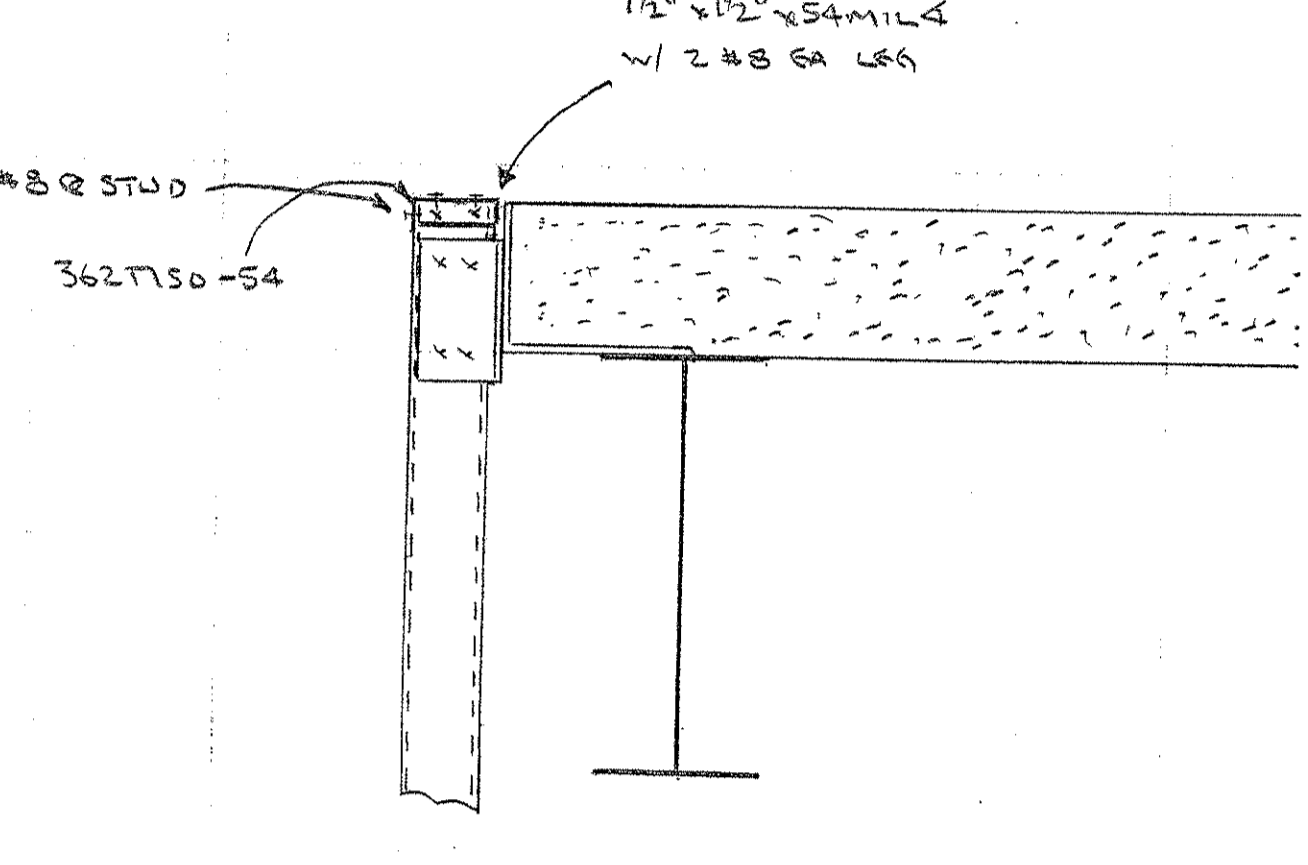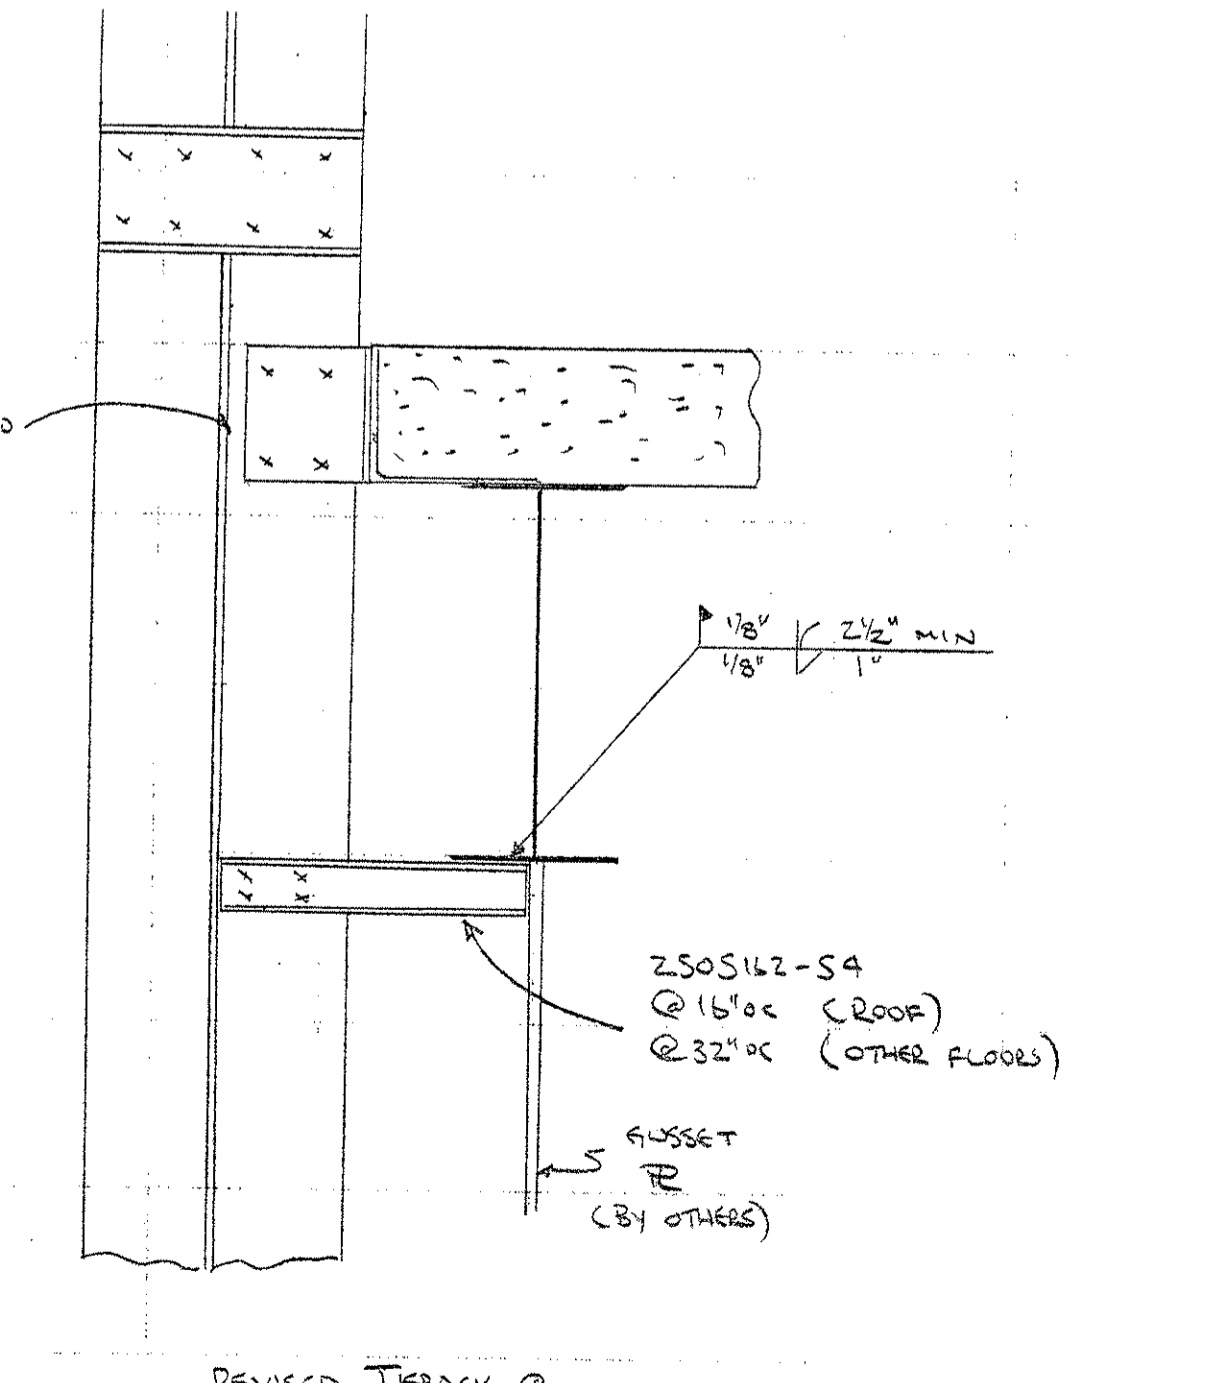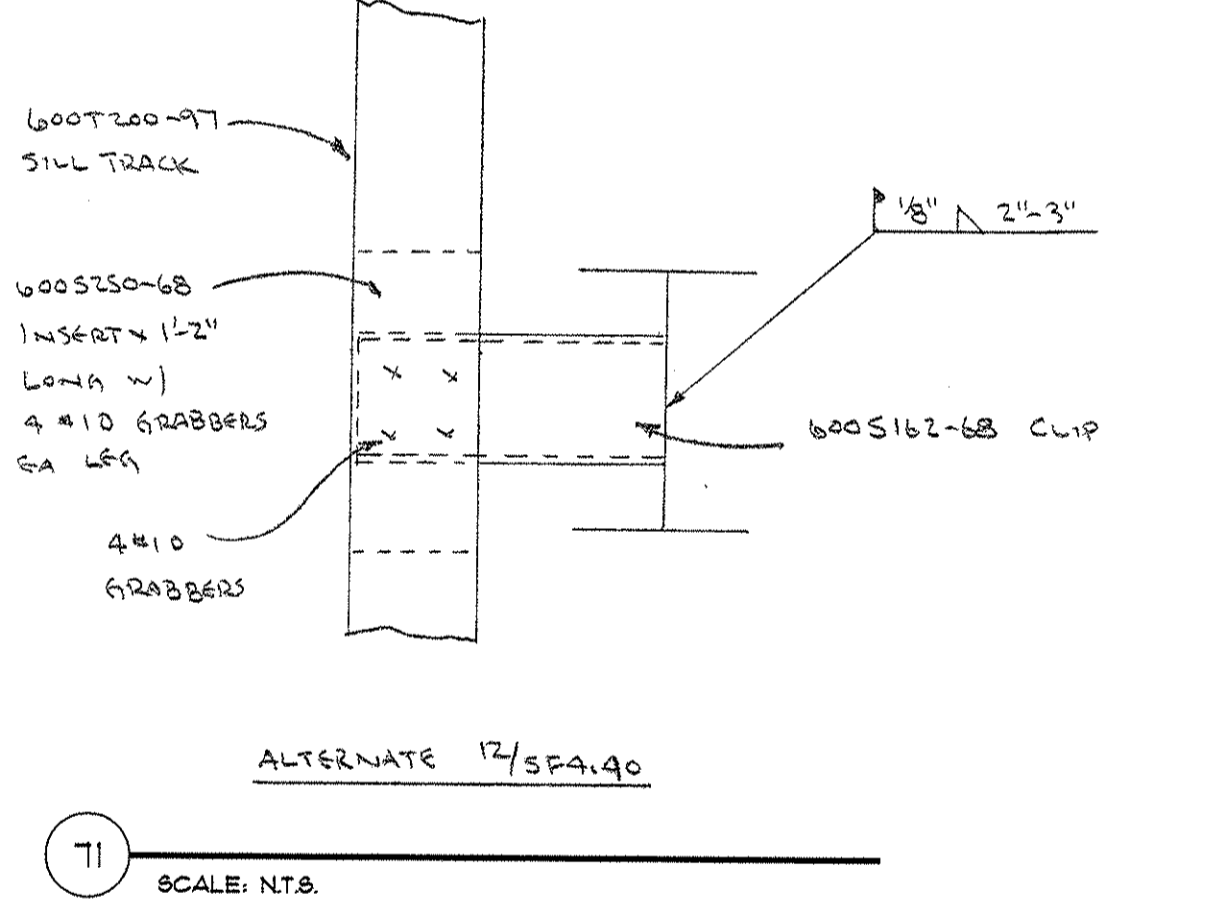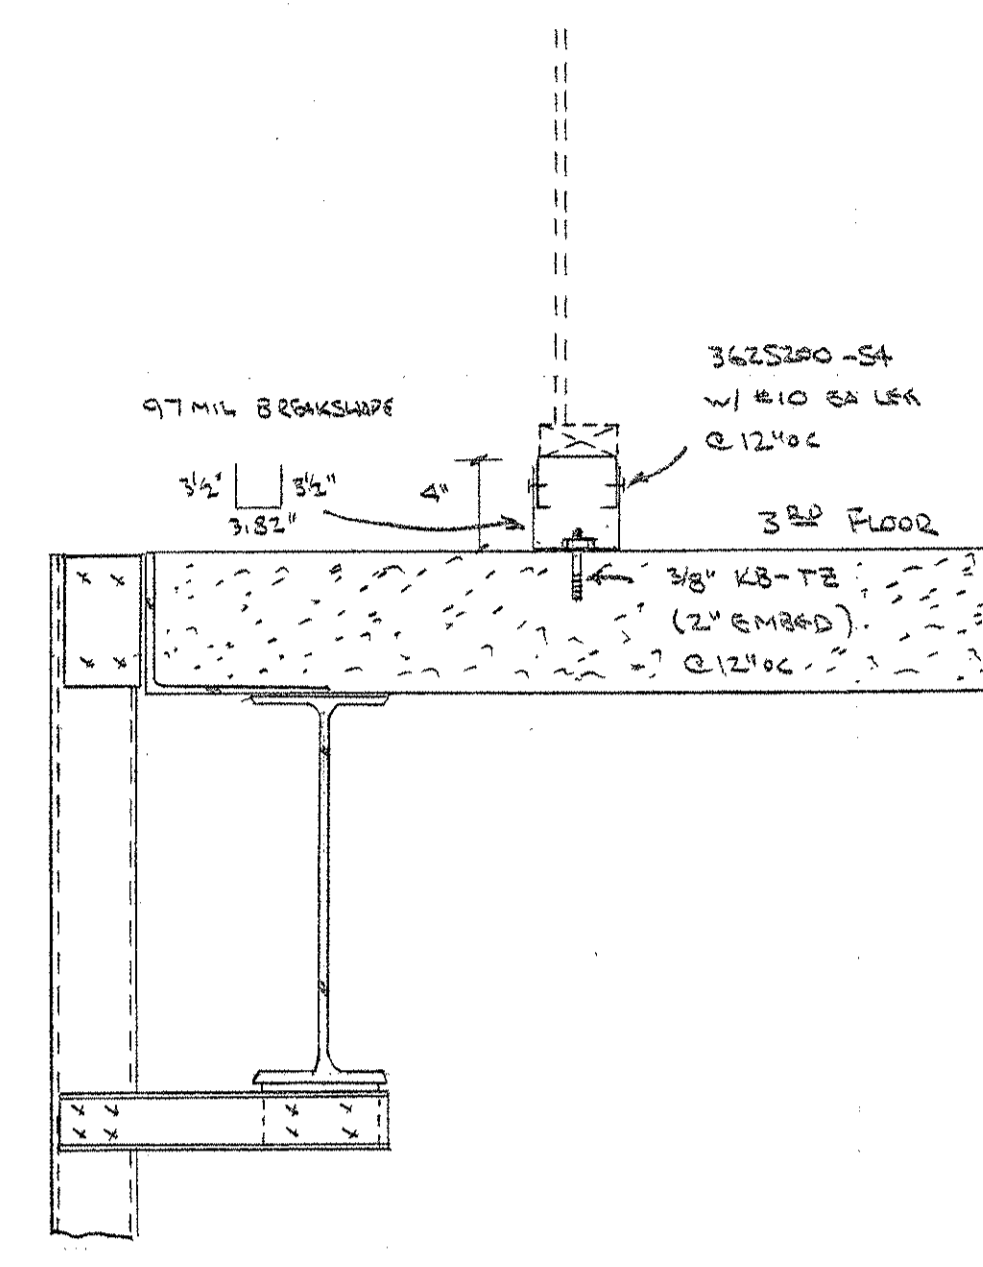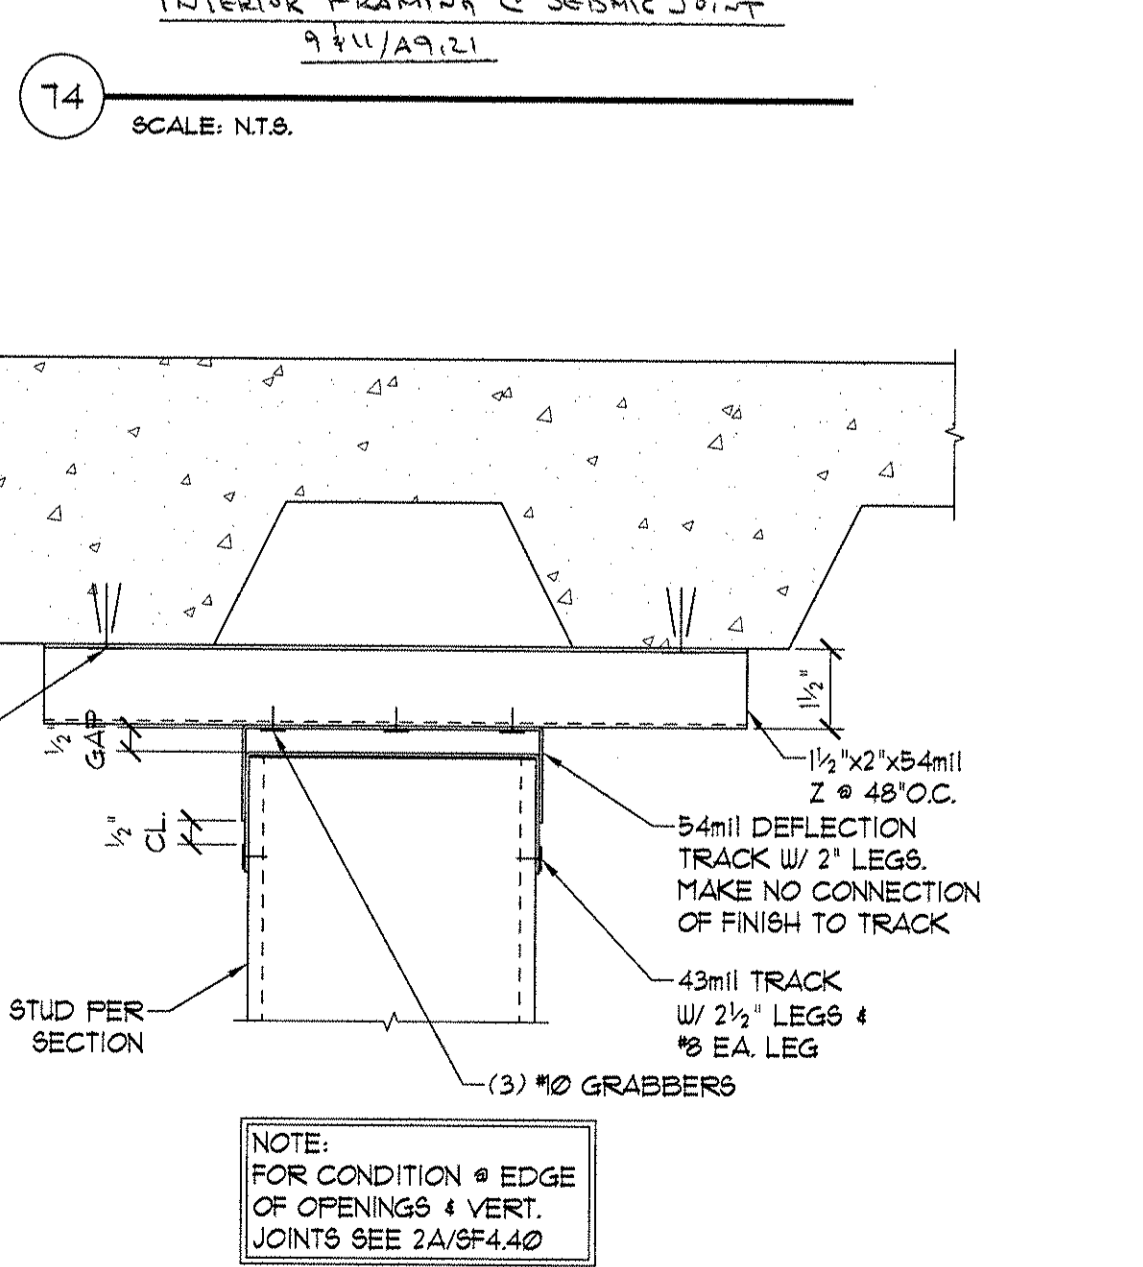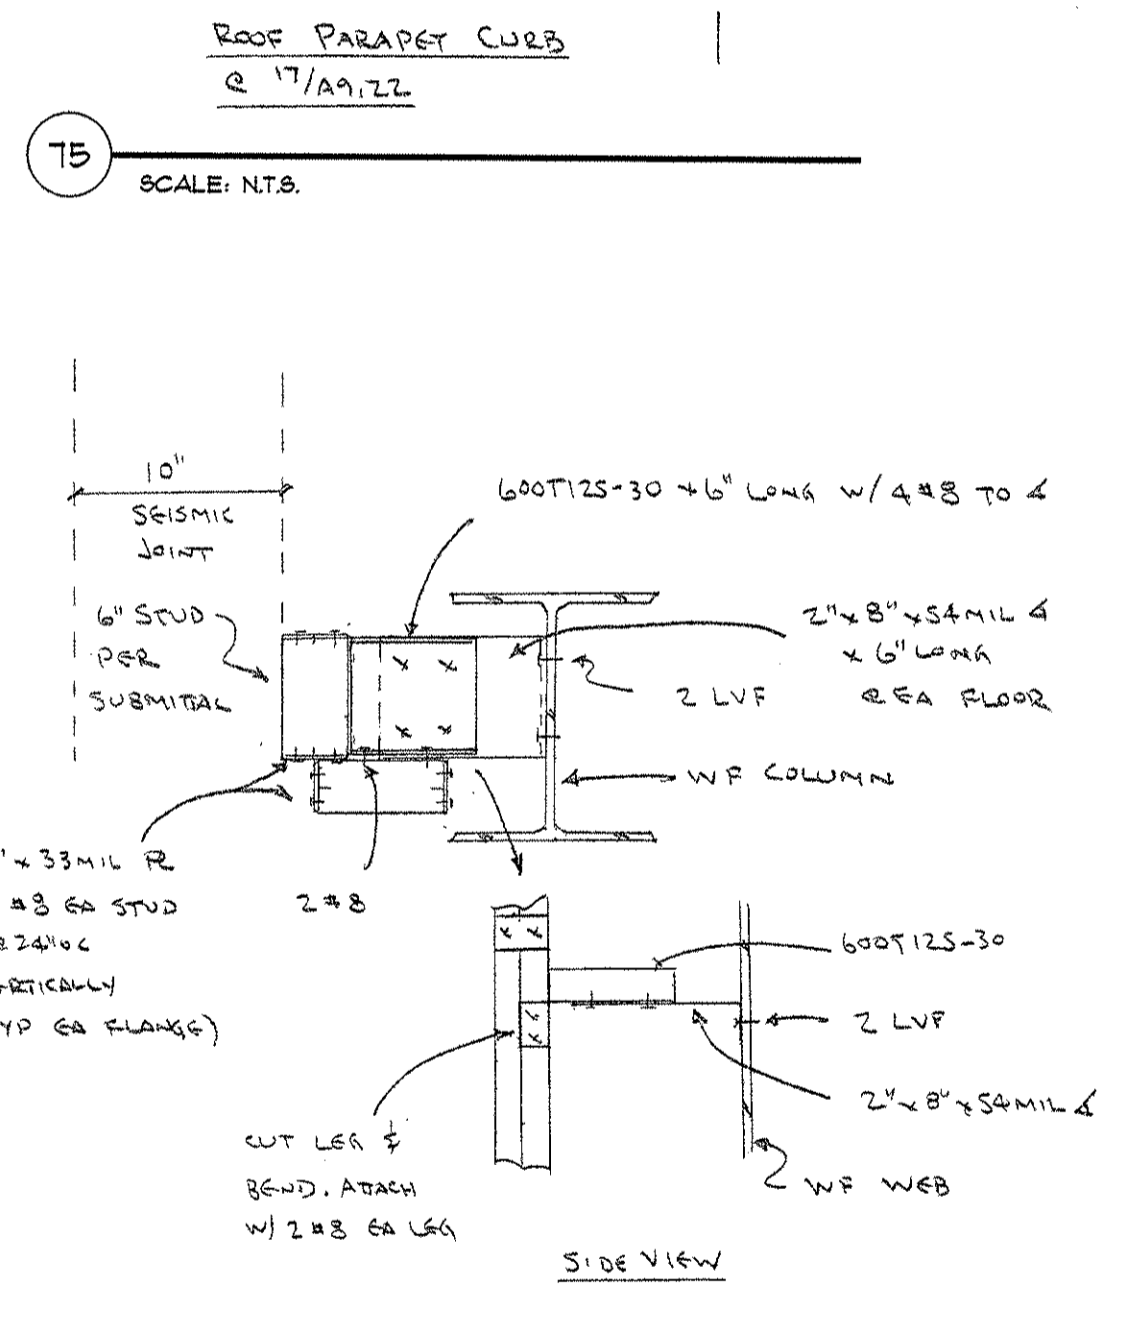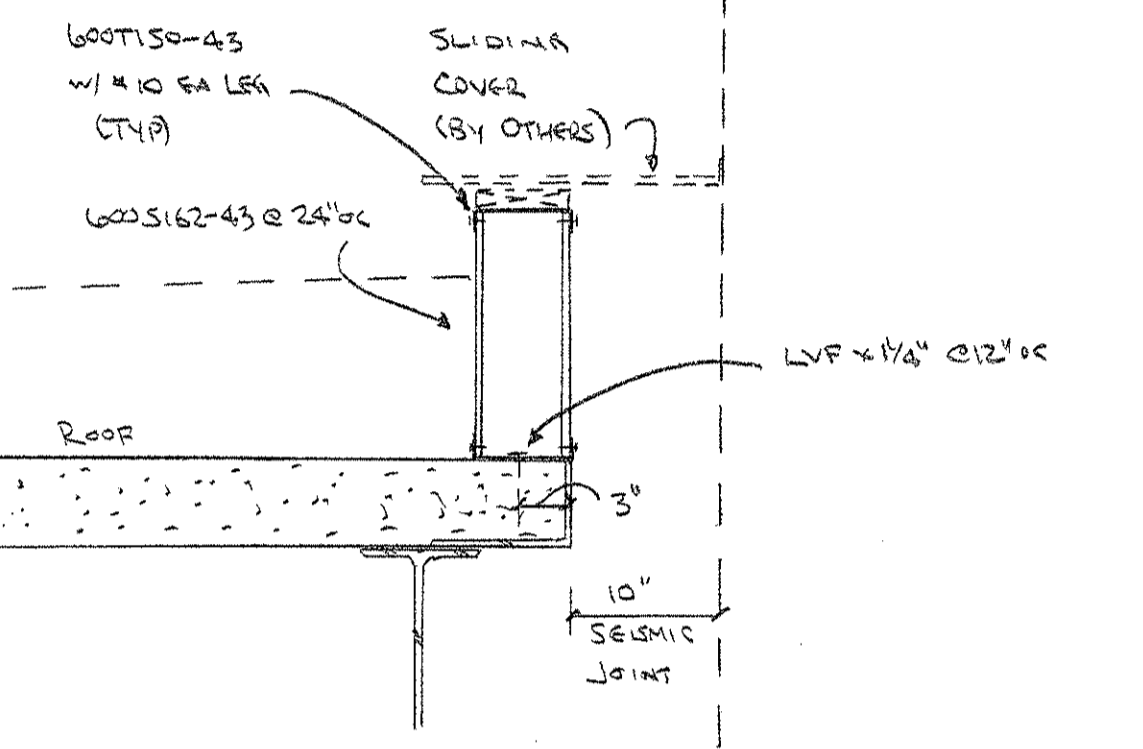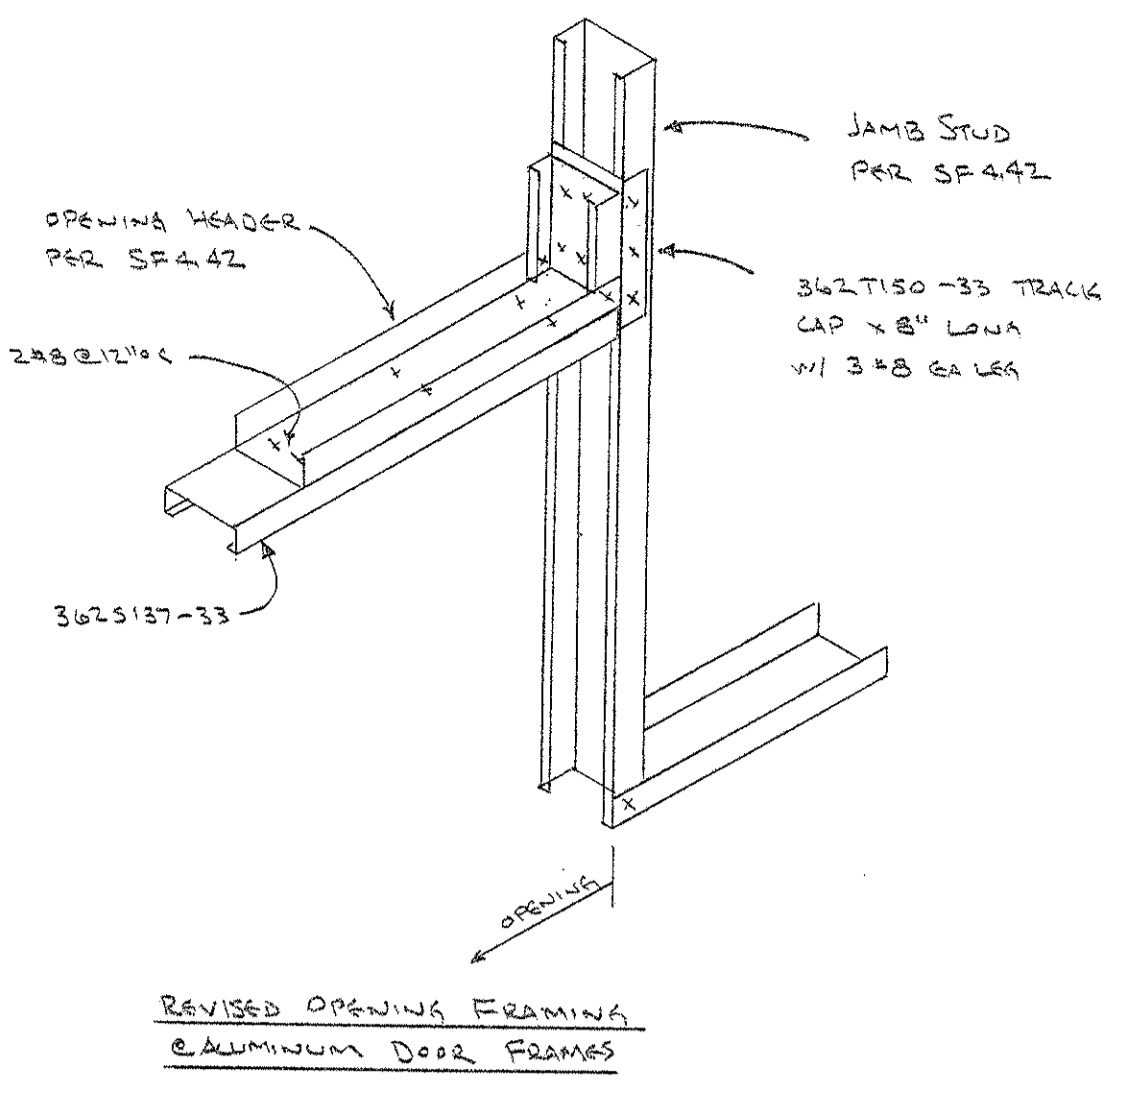

FILE: J:\08\0813 College of San Mateo\10-13-10 Smt\REVISED 11-11-10\TEMP\08013505 SKETCHES.dwg 11/12/2010 8:37 AM - Ben