

20N BUILDING SECTION 1/8"=1'-0"

20G BUILDING SECTION 1/8"=1'-0"


6G BUILDING SECTION 1/8"=1'-0"

20A BUILDING SECTION 1/8"=1'-0"

AS-BUILTS

NO.	DATE	REASON	BY

ISSUE FOR PROGRESS REVIEW	01/15/01
ISSUE FOR PLAN CHECK	01/25/01
ISSUE FOR FINAL REVIEW	05/09/01
ISSUE FOR BID	
ISSUE FOR CONSTRUCTION	

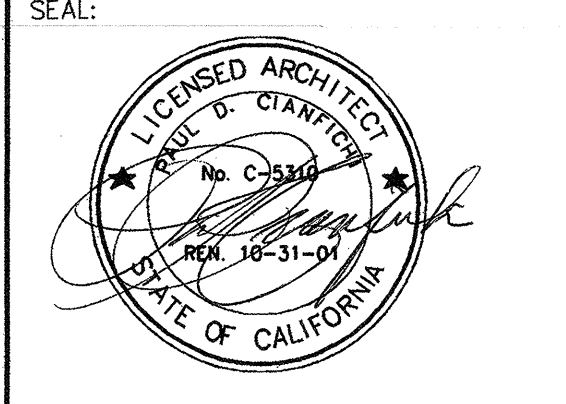

CONSULTANT:
ARCHITECT:
CONSULTANT:

ARCHITECT:
CIANFICHI
ARCHITECTURE • PLANNING
30 ANNE COURT
WALNUT CREEK, CA 94598
TEL: (925) 256-8638
FAX: (925) 256-8652

PROJECT:
CHILD DEVELOPMENT CENTER
CAÑADA COLLEGE
4200 FARM HILL BLVD.
REDWOOD CITY, CA 94061

SAN MATEO COUNTY COMMUNITY COLLEGE DISTRICT
STAMP/REGISTRATION STAMP
DIVISION OF THE STATE ARCHITECT
APPLY: 103529
AC: [Signature]
DATE: 5/27/01

APPL. NUMBER: [Signature]
KEY PLAN:

SHEET TITLE:
BUILDING SECTIONS

DRAWN BY: GL PROJECT NO.: 304.99
CHECKED BY: BA DATE: 01-25-2001
APPL. NO.: SHEET:
DATA NO.: **A21**
NO.: OF:

17