


NO.	DATE	REASON	BY

ISSUE FOR PROGRESS REVIEW 01/15/01  
ISSUE FOR PLAN CHECK 01/25/01  
ISSUE FOR FINAL REVIEW 05/09/01  
ISSUE FOR BID  
ISSUE FOR CONSTRUCTION

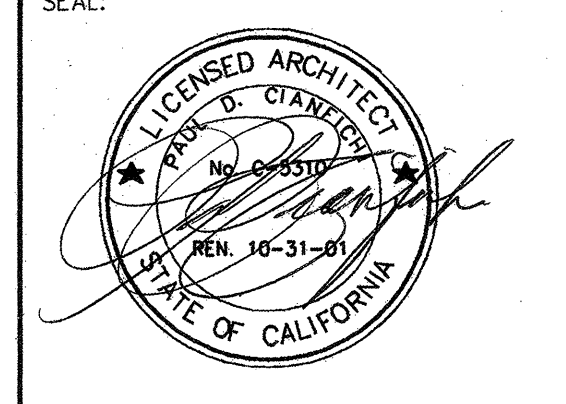

CONSULTANT:  
ARCHITECT:  
CONSULTANT:

**CIANFICHI**  
ARCHITECTURE • PLANNING  
30 ANNE COURT  
WALNUT CREEK, CA 94598  
TEL: (925) 256-8638  
FAX: (925) 256-8652

PROJECT:  
**CHILD DEVELOPMENT CENTER**  
**CANADA COLLEGE**  
4200 FARM HILL BLVD.  
REDWOOD CITY, CA 94061  
SAN MATEO COUNTY COMMUNITY COLLEGE DISTRICT

STAMP/IDENTIFICATION STAMP  
DIVISION OF THE STATE ARCHITECT  
APPL 01 103529  
DATE: 05/16/01  
APPL. NUMBER:  
KEY PLAN:

SHEET TITLE:  
**INTERIOR ELEVATIONS**

DRAWN BY: PROJECT NO.:  
GL 304.99  
CHECKED BY: DATE:  
BA 01-25-2001  
APPL. NO.: SHEET:  
DATA NO.: **A4.5**  
NO. OF:

**AS-BUILTS**