
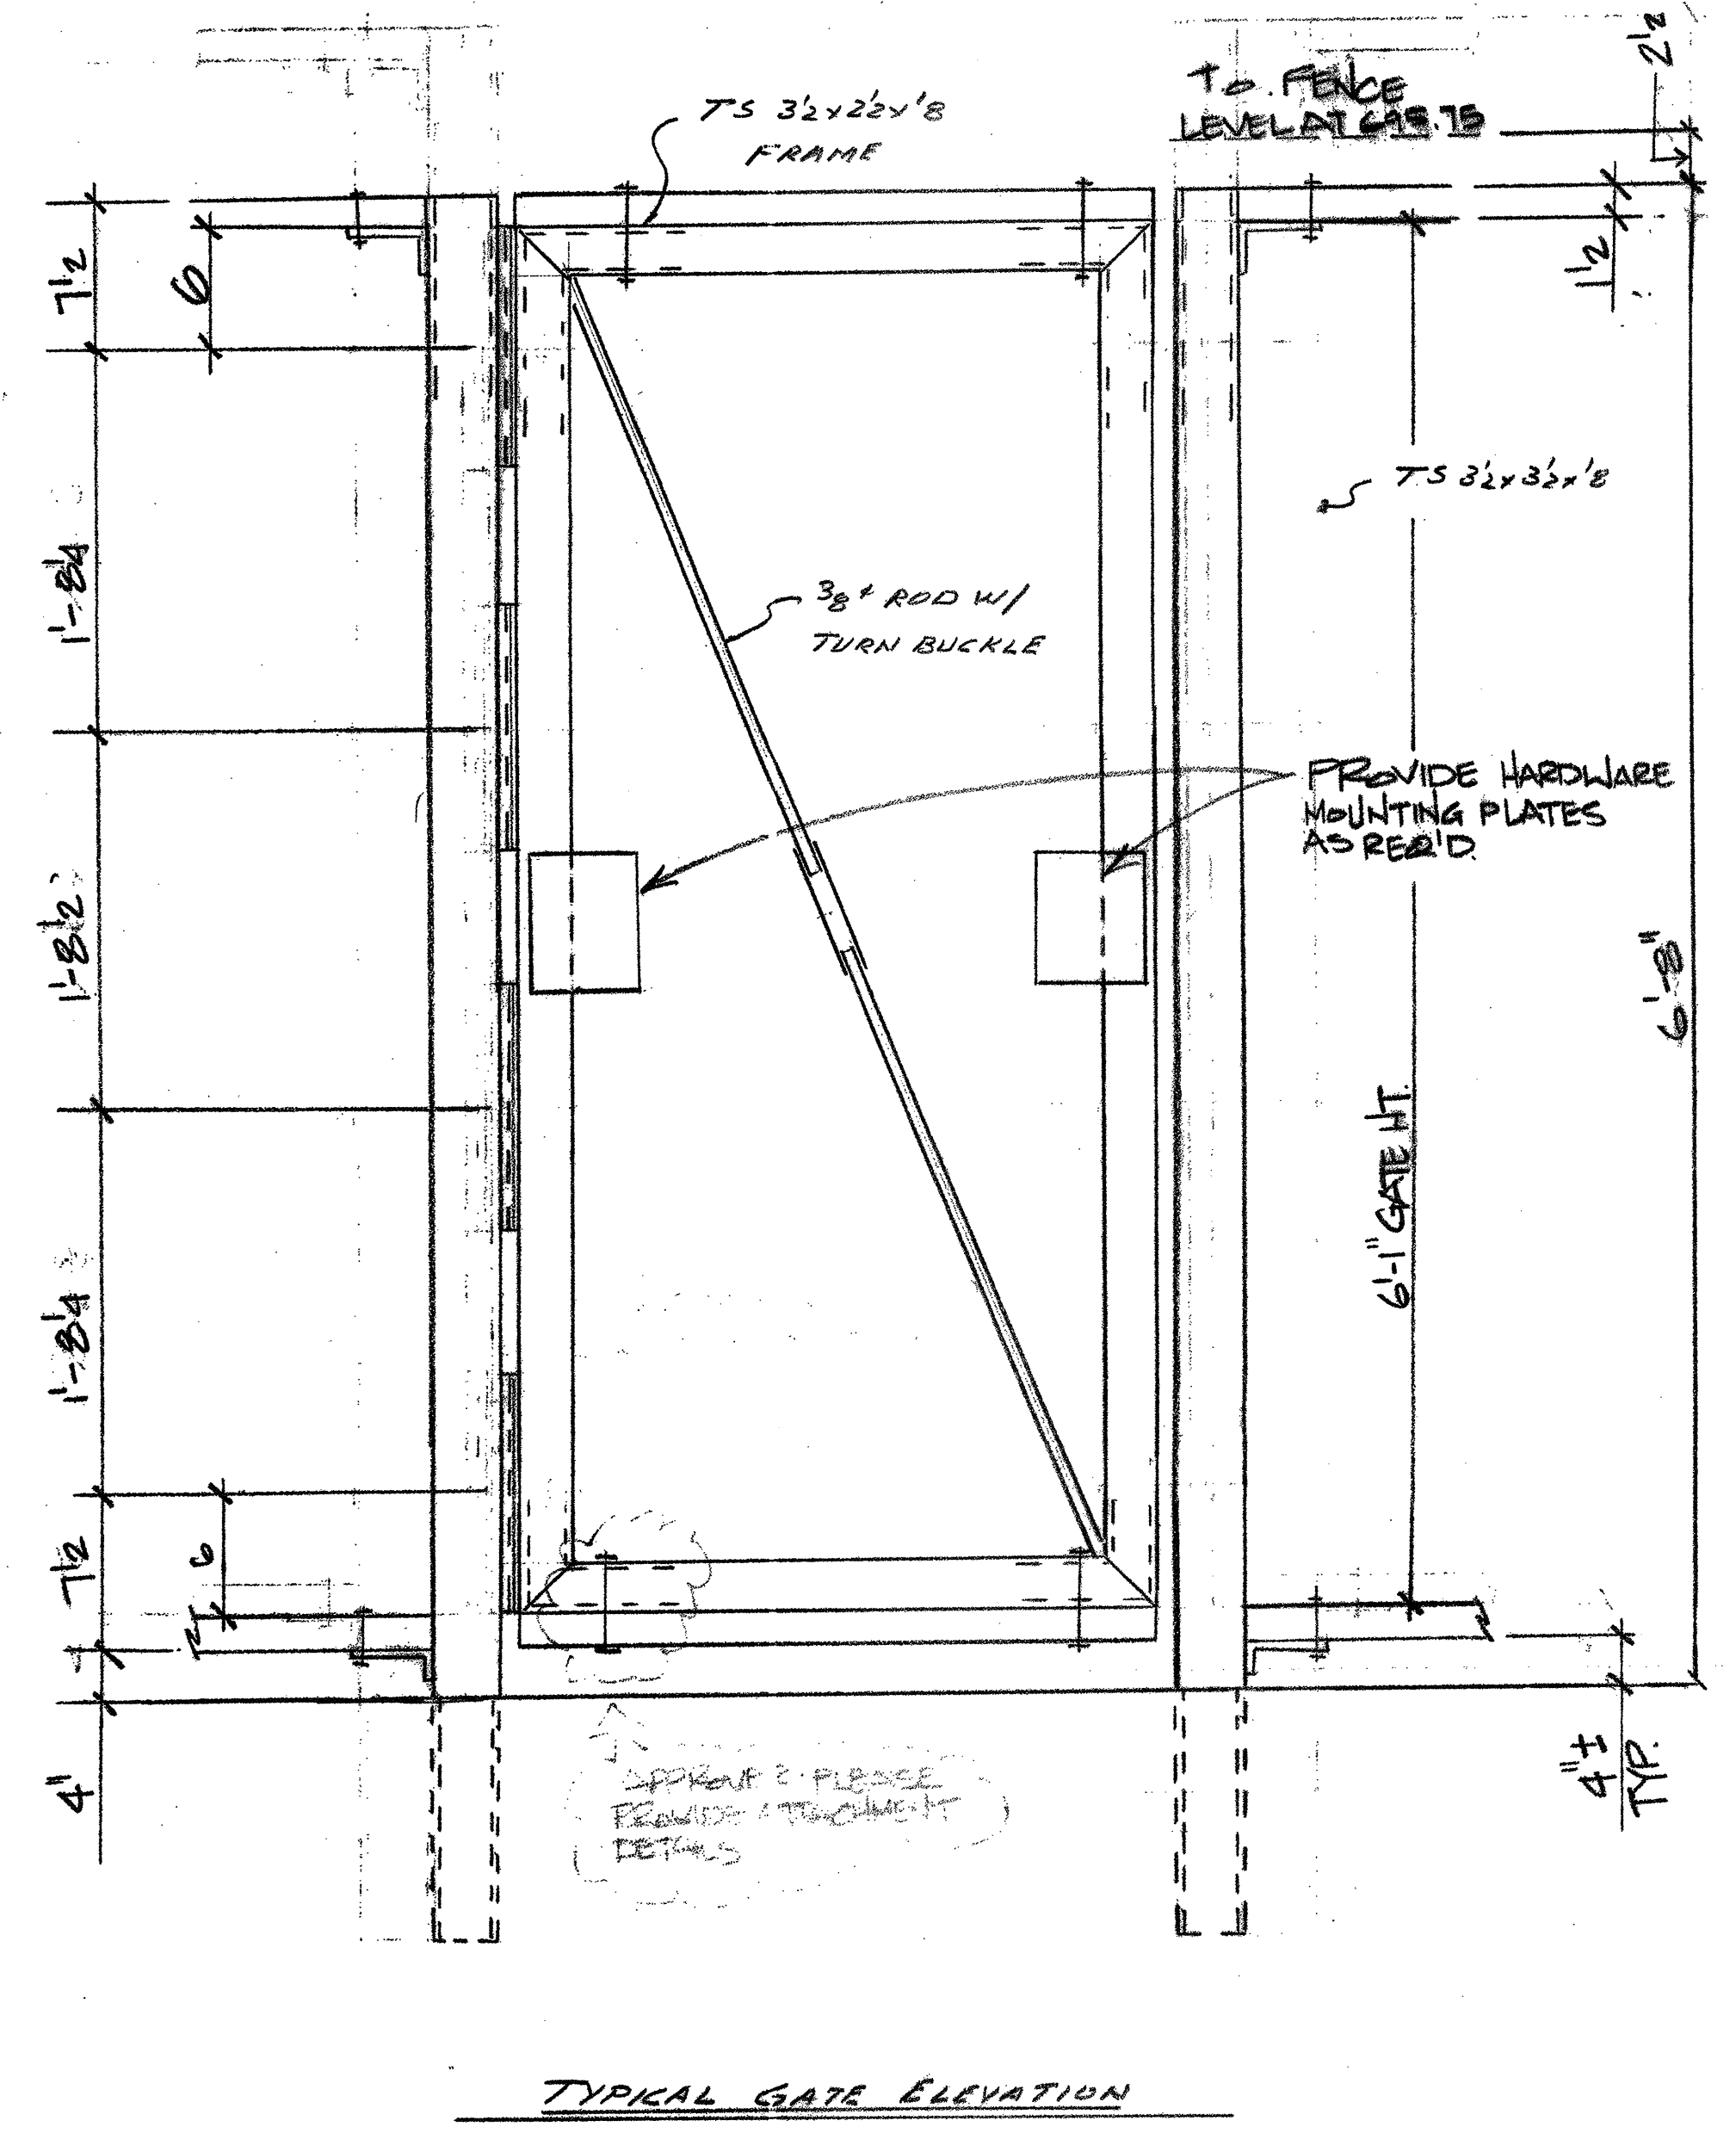
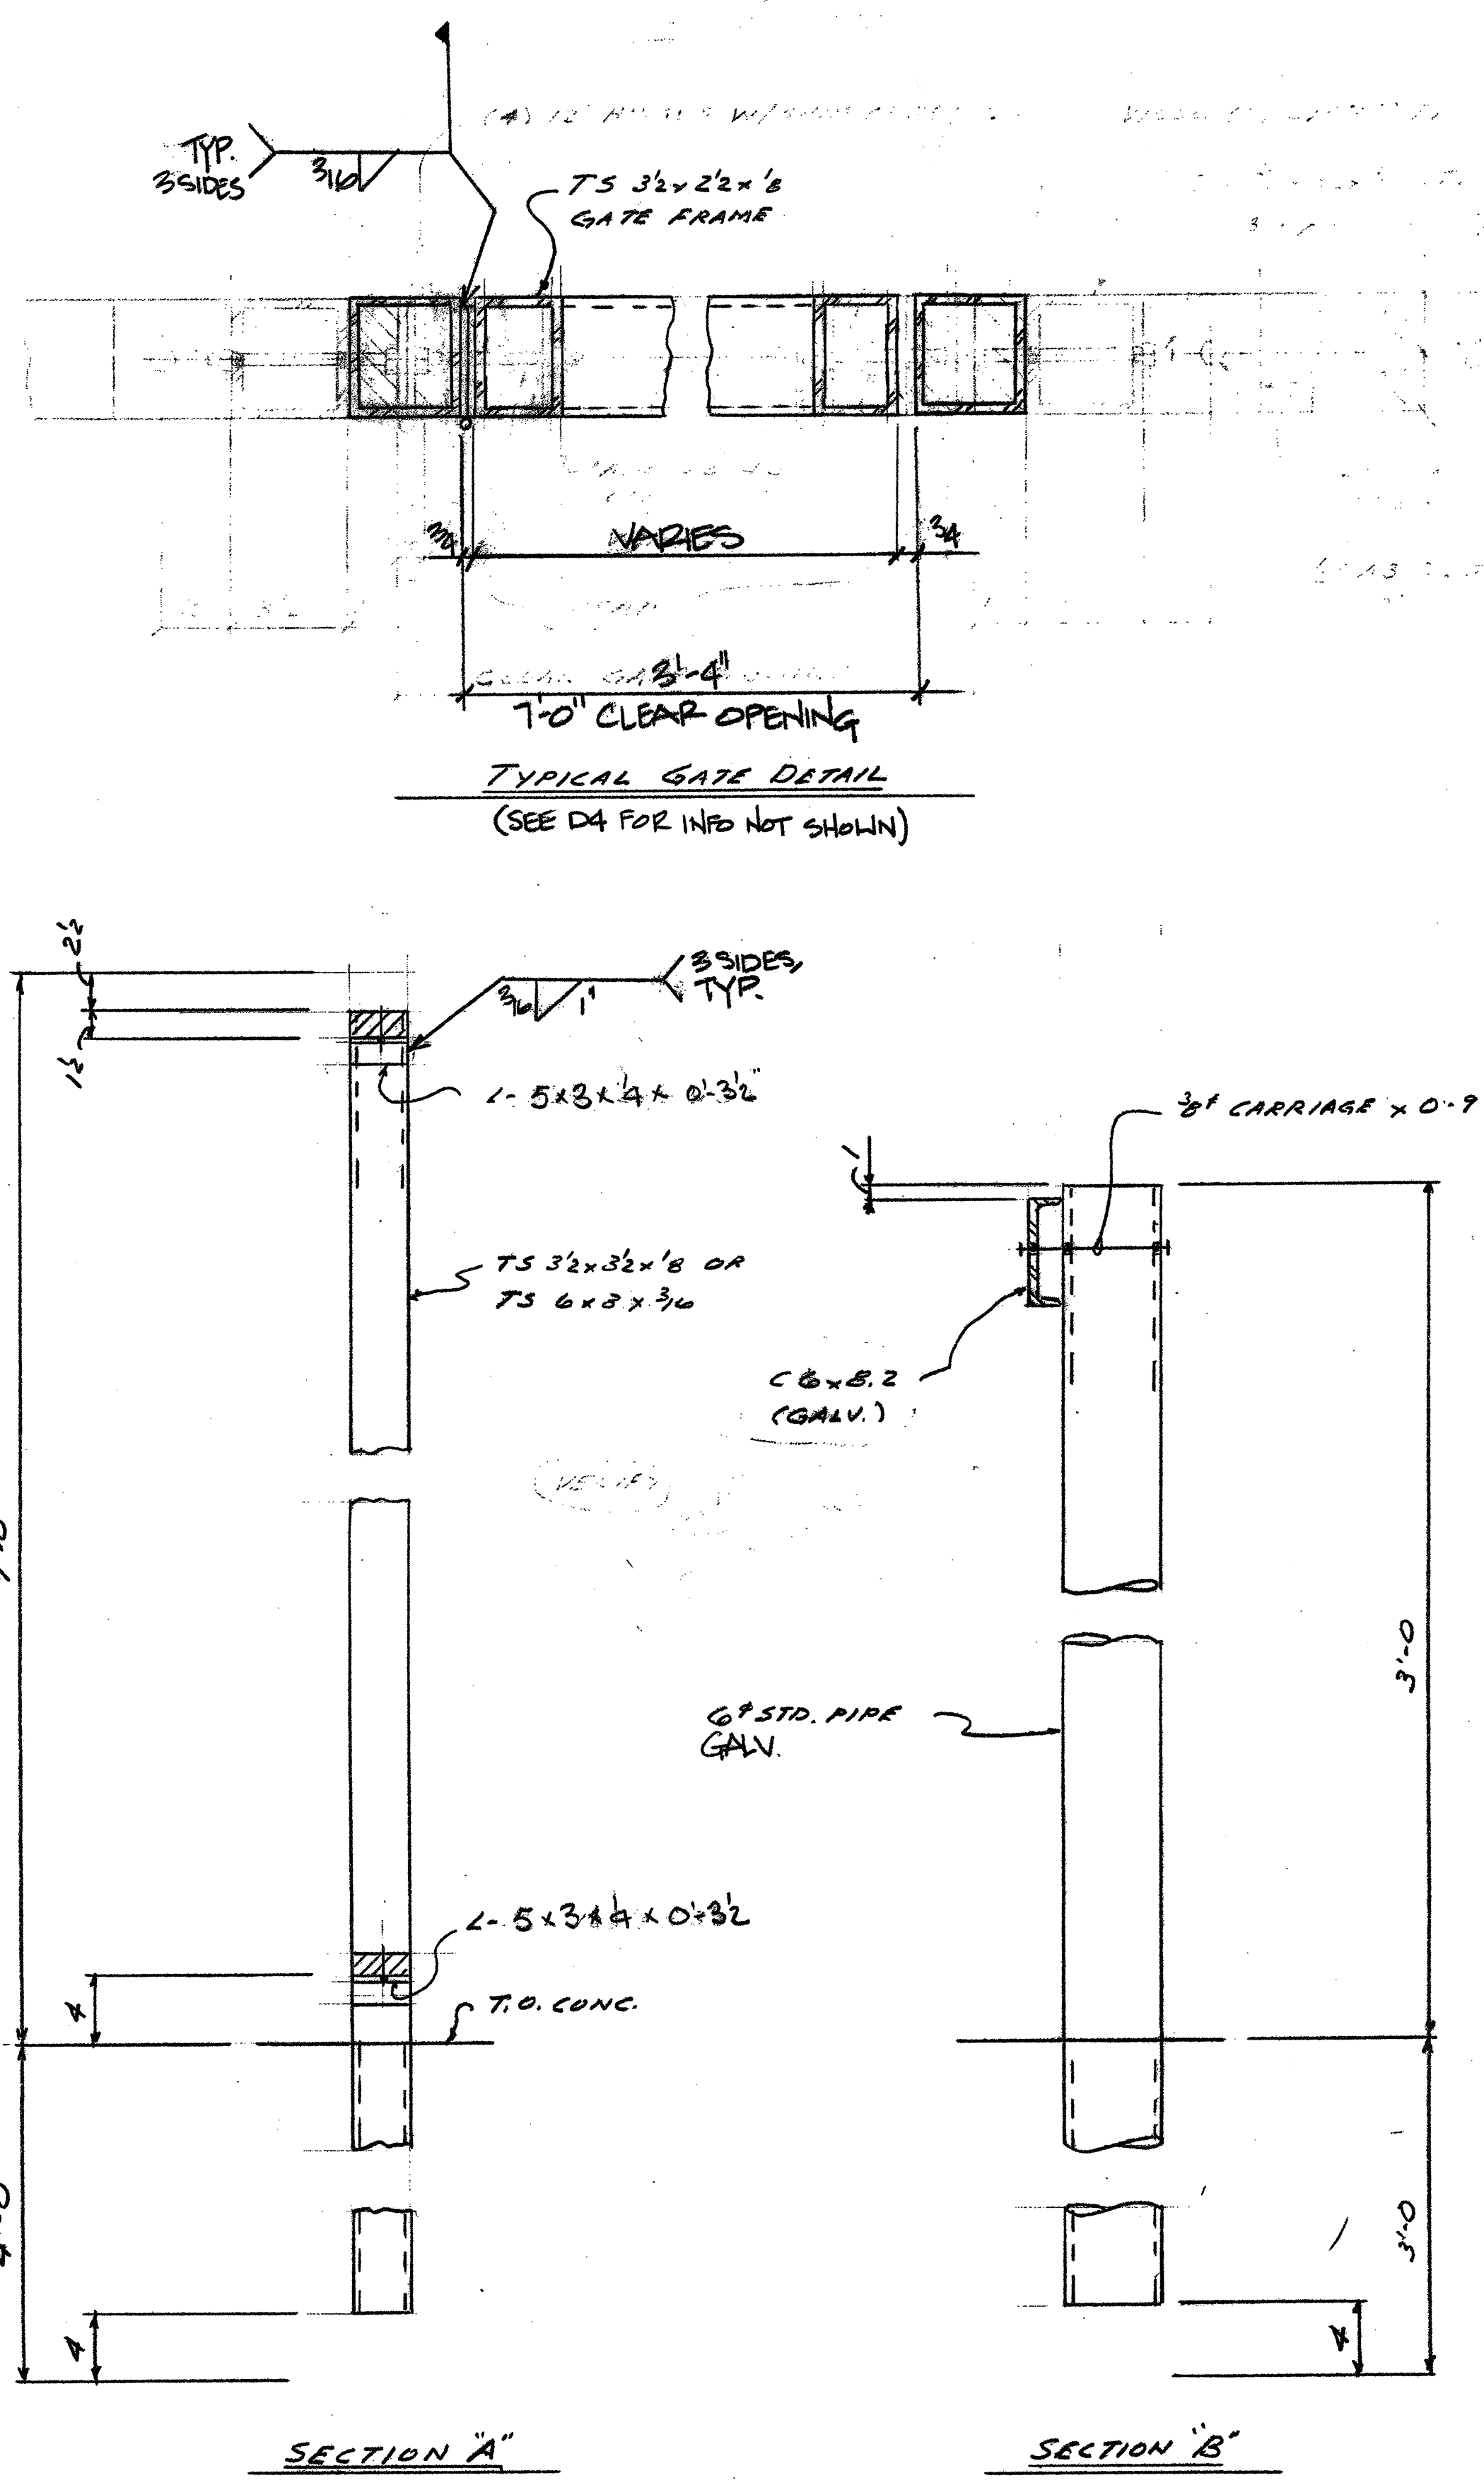


MECHANICAL ENCLOSURE PLAN

NOTE:
POST ARE TS 3/2 x 3/2 x 8 (U.N.O.)

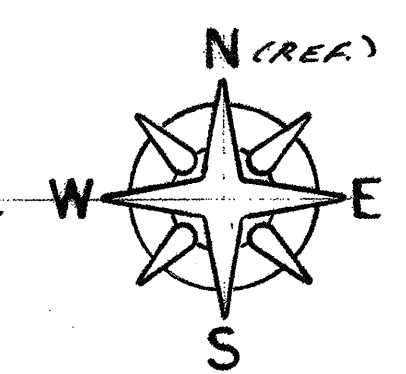

AS-BUILTS

REV. NO.	DESCRIPTION	DATE	BY
A	FOR APPROVAL	3-7-02	
B	REVISE AND RESUBMIT	4-29-03	LK
D	RELEASE FOR FAB	6-20-03	LK

NORTH WIND CONTRACTORS
415 E. 10TH STREET
PITTSBURG, CA 94565

CHILD DEVELOPMENT CENTER
REDWOOD CITY, CA

CONTRACTOR
GONSALVES & STRONCH

REFERENCE:
DESIGN: SWZ/IA & SWZ
ERECTOR:

SCALE:
DRAWN BY: JMS
DATE: 3/13/02
CHECKED BY: JMS
DATE: 3/13/02

REV. NO. 02-15
DRAWING NO. E1