



ROOF FRAMING PLAN NOTES:

- FOR GENERAL NOTES AND TYPICAL DETAILS NOT SHOWN HEREIN, SEE SHEETS S1.1, S1.2, S1.3, S1.4, S1.5, S1.6 AND S1.7
- SEE ARCHITECTURAL, MECHANICAL, PLUMBING AND ELECTRICAL DRAWINGS FOR PERTINENT INFORMATION NOT SHOWN HEREIN. VERIFY ALL ITEMS WITH RESPECTIVE TRADES PRIOR TO FRAMING.
- SEE FOUNDATION AND FLOOR FRAMING PLAN FOR GRID DIMENSIONS AND APPLICABLE NOTES.
- ALL ROOF AREAS SHALL BE SHEATHED WITH 1/2" PLYWOOD, U.O.N. SEE SHEETS S1.1, S1.3, S1.4, S1.7 FOR TYPICAL NAILING, AND PLYWOOD SPLICE PATTERNS.
- SEE ARCHITECTURAL AND MECHANICAL DRAWINGS FOR EXACT LOCATIONS OF ALL MECHANICAL UNITS AND OPENINGS IN ROOF. PROVIDE DOUBLE JOIST AROUND ALL OPENINGS IN ROOF, U.O.N.
- JOISTS SUPPORTING MECHANICAL EQUIPMENT SHALL BE DOUBLE JOISTS (DJ), UNLESS OTHERWISE NOTED.
- S DENOTES ROOF SLOPE, SEE PLANS AND ARCHITECTURAL DRAWINGS.
- DENOTES POST OR COLUMN BELOW. SEE FOUNDATION AND FLOOR FRAMING PLAN FOR ALL POST AND COLUMN SIZE AND LOCATIONS.
- CONNECTION HARDWARE SUCH AS "CC" COLUMN CAPS, "MST" STRAPS, "L" ANGLES ETC., INDICATES SIMPSON STRONG TIE.
- <1/2"> DENOTES GLU-LAM BEAM W/ 1/2" CAMBER, SEE PLANS. GLU-LAM BEAMS WITHOUT THIS DESIGNATION HAVE NO CAMBER.
- PS-2 DENOTES BOLTED TOP PLATE SPLICE, SEE 6/S1.4
- C-1 DENOTES STRAP AT ROOF PW, SEE DETAILS 1, 4 AND 5/S1.7 CENTERLINE OF STRAP AT END OF SHEAR WALL, U.O.N. SIMILAR CONDITION FOR SIMPSON MSTA STRAPS.
- 2X10 BLKG. REG.D @ 4'-0"O.C. @ 2X10 JOISTS @ 1:12 ROOF SLOPE.

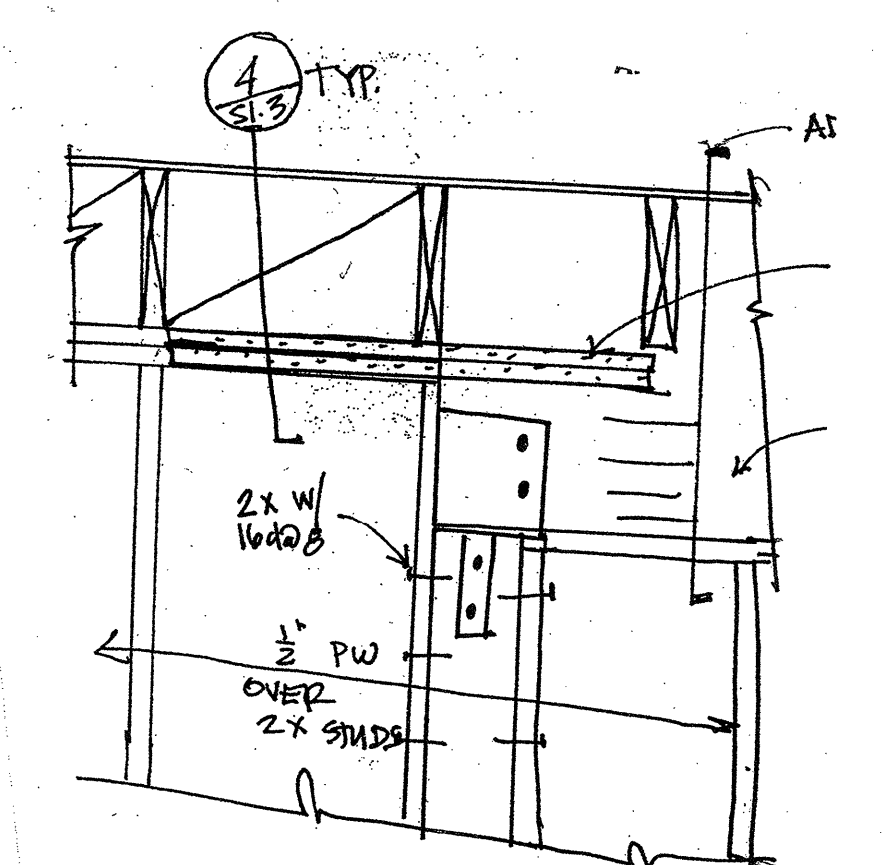


STUD WALL ADJACENT TO GL
@ LINE 4
1"=1'-0"

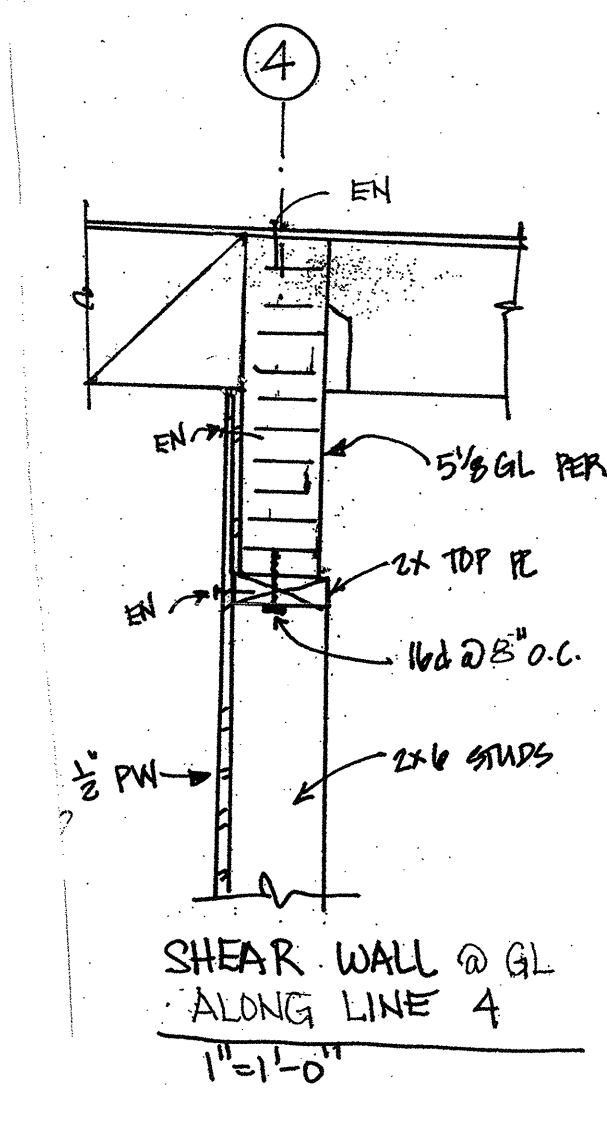

SHEAR WALL @ GL
ALONG LINE 4
1"=1'-0"

ROOF FRAMING PLAN

1/8"=1'-0"

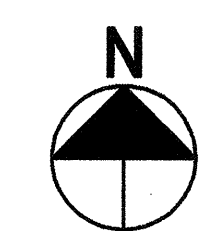

REVISIONS: 12 NO. DATE REASON BY 10/1/16 ASSEMBLY #1	
SEAL:	
CONSULTING ENGINEER:	
ARCHITECT: CIANFICHI ARCHITECTURE • PLANNING 30 ANNE COURT WALNUT CREEK, CA. 94598 TEL: (925) 256-8636 FAX: (925) 256-8632	
PROJECT: CHILD DEVELOPMENT CENTER CANADA COLLEGE	
STAMP: APPROVED DIV OF THE STATE ARCHITECT AC BR FLS 81 OS MZ APPL NO: 112823 DATE 3/1/20	
APPL NUMBER: _____ KEY PLAN: _____	
SHEET TITLE: AS-BUILTS	
SHEET TITLE: ROOF FRAMING PLAN	
DRAWN BY: JS CHECKED BY: MAE/RT APP. NO.: _____ DATA NO.: 202-000	PROJECT NO.: 20024 DATE: 01-13-01 SHEET: _____ NO. OF: _____
S2.2a	