


NO.	DATE	REASON	BY

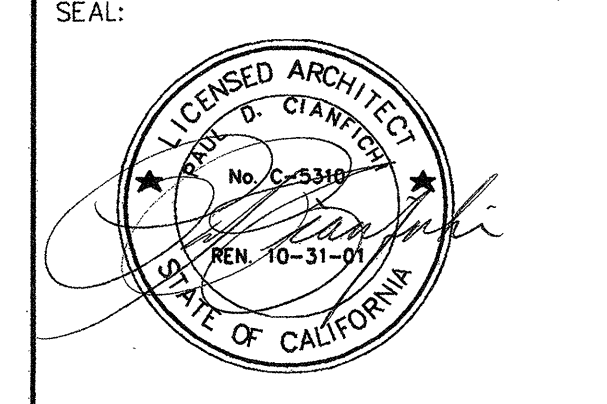

CONSULTANT:

ARCHITECT:

**CIAN FICHI**  
ARCHITECTURE • PLANNING  
30 ANNE COURT  
WALNUT CREEK, CA 94598  
TEL: (925) 256-8838  
FAX: (925) 256-8852

PROJECT:

**CHILD DEVELOPMENT CENTER**  
CAÑADA COLLEGE  
4200 FARM HILL BLVD.  
REDWOOD CITY, CA 94061

SAN MATEO COUNTY COMMUNITY COLLEGE DISTRICT

STAMP: IDENTIFICATION STAMP  
DIVISION OF THE STATE ARCHITECT

APPROVAL: 103529  
AC: UN, FLS, SS, MY, Reddy, B/S, J/S, L/S  
DATE: 1/12/01  
APPL. NUMBER:

KEY PLAN: AS-BUILT

SHEET TITLE:

**SITE DETAILS**

DRAWN BY: CL  
PROJECT NO.: 30499  
CHECKED BY: BA  
DATE: 01-25-2001  
APPL. NO.:  
SHEET: SW2.0  
NO.: OF: