


**2 BLDG 16 - PARTIAL FIRST FLOOR PLAN** DSA APPL # 27796, 107611 1/4" = 1'-0"


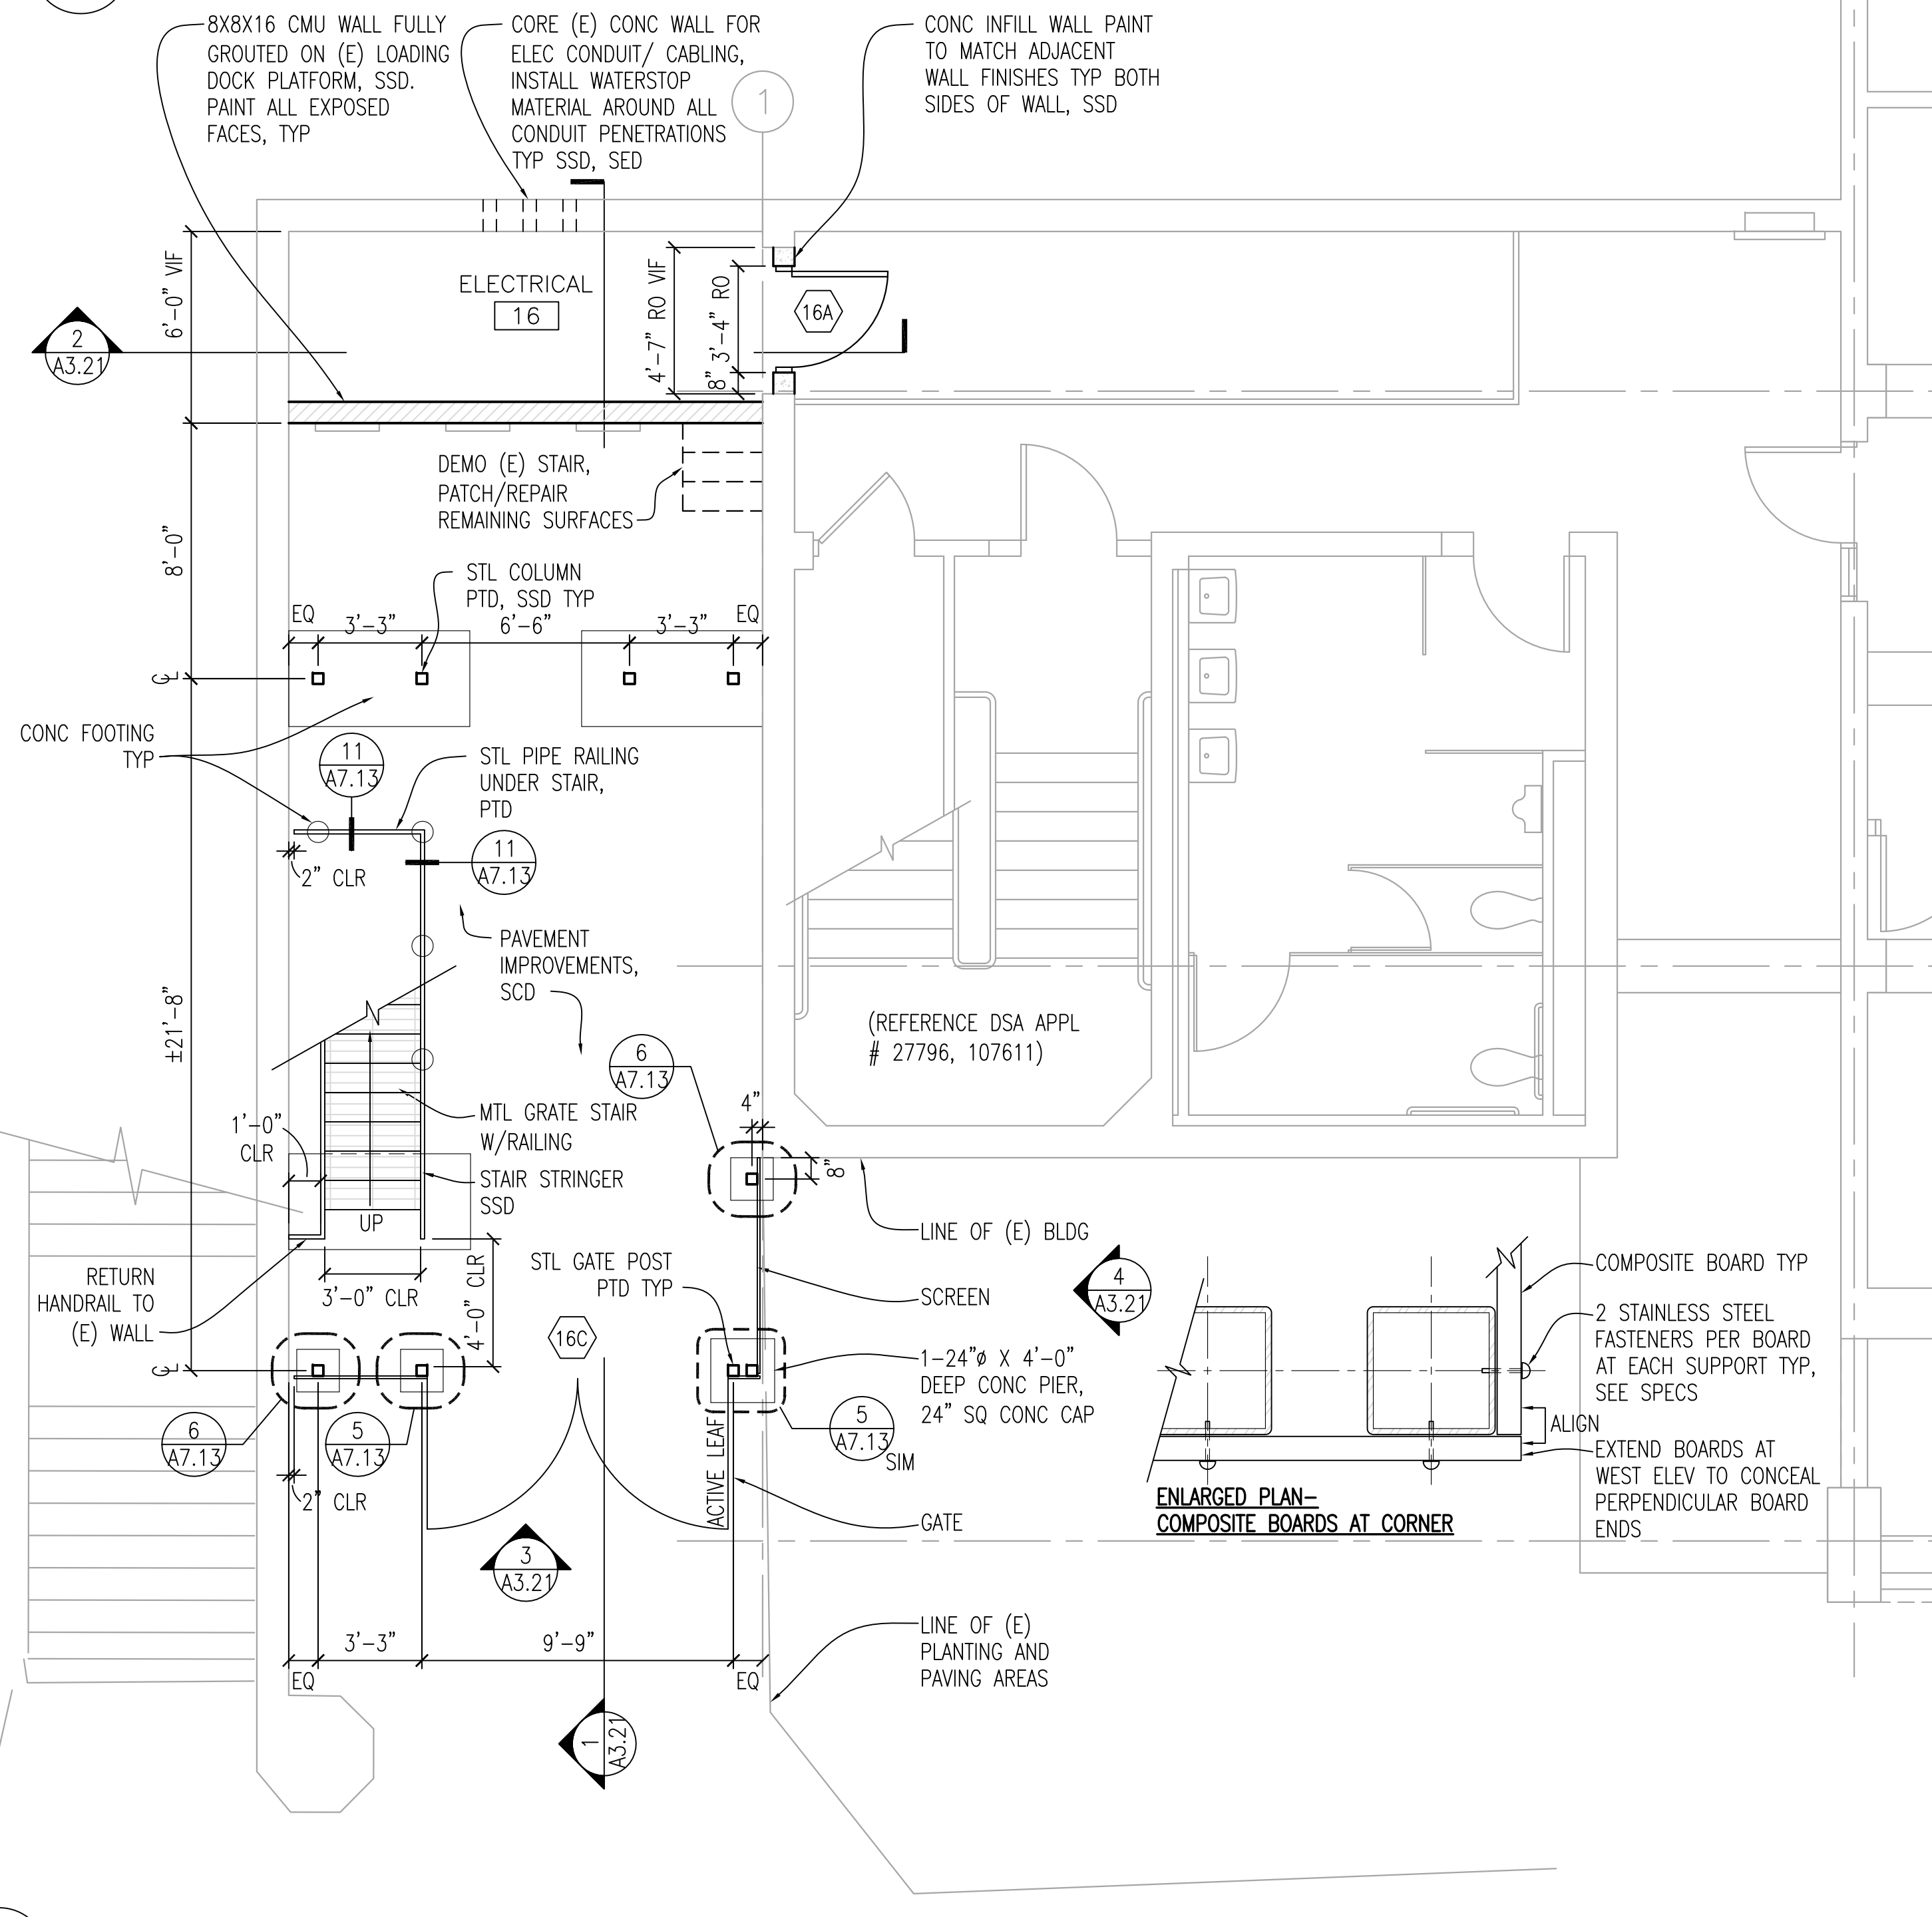


**3 BLDG 16 - PARTIAL GROUND FLOOR PLAN** DSA APPL # 27796, 107611 1/4" = 1'-0"

**DOOR SCHEDULE - BLDG 16**

DOOR	TYPE	SIZE	DR	FR	RATE	DETAILS			HDW	REMARKS
						HEAD	JAMB	SILL		
16A	FRP-1	3'-0" X 7'-0" VIF	FRP	AL	NA	3/A7.12 SIM	3/A7.12	6/A7.11 SIM	03	VERIFY (E) HEAD HEIGHT IN FIELD, LOUVER AT TOP AND BOTTOM
16B	FRP-2	4'-0" X 7'-0" VIF	FRP	AL	NA	3/A7.12 SIM	3/A7.12	6/A7.11 SIM	04	IN (E) OPNG
16C	GATE-1	PR 9'-5" X 7'-10"	STL	STL	NA	5/A3.21	SEE LEGEND	NA	06	NA
16D	GATE-2	±3'-0" X 5'-6"	STL	STL	NA	5/A3.21	SEE LEGEND	NA	07	VERIFY WIDTH AND HEIGHT IN FIELD

**DOOR TYPE LEGEND**

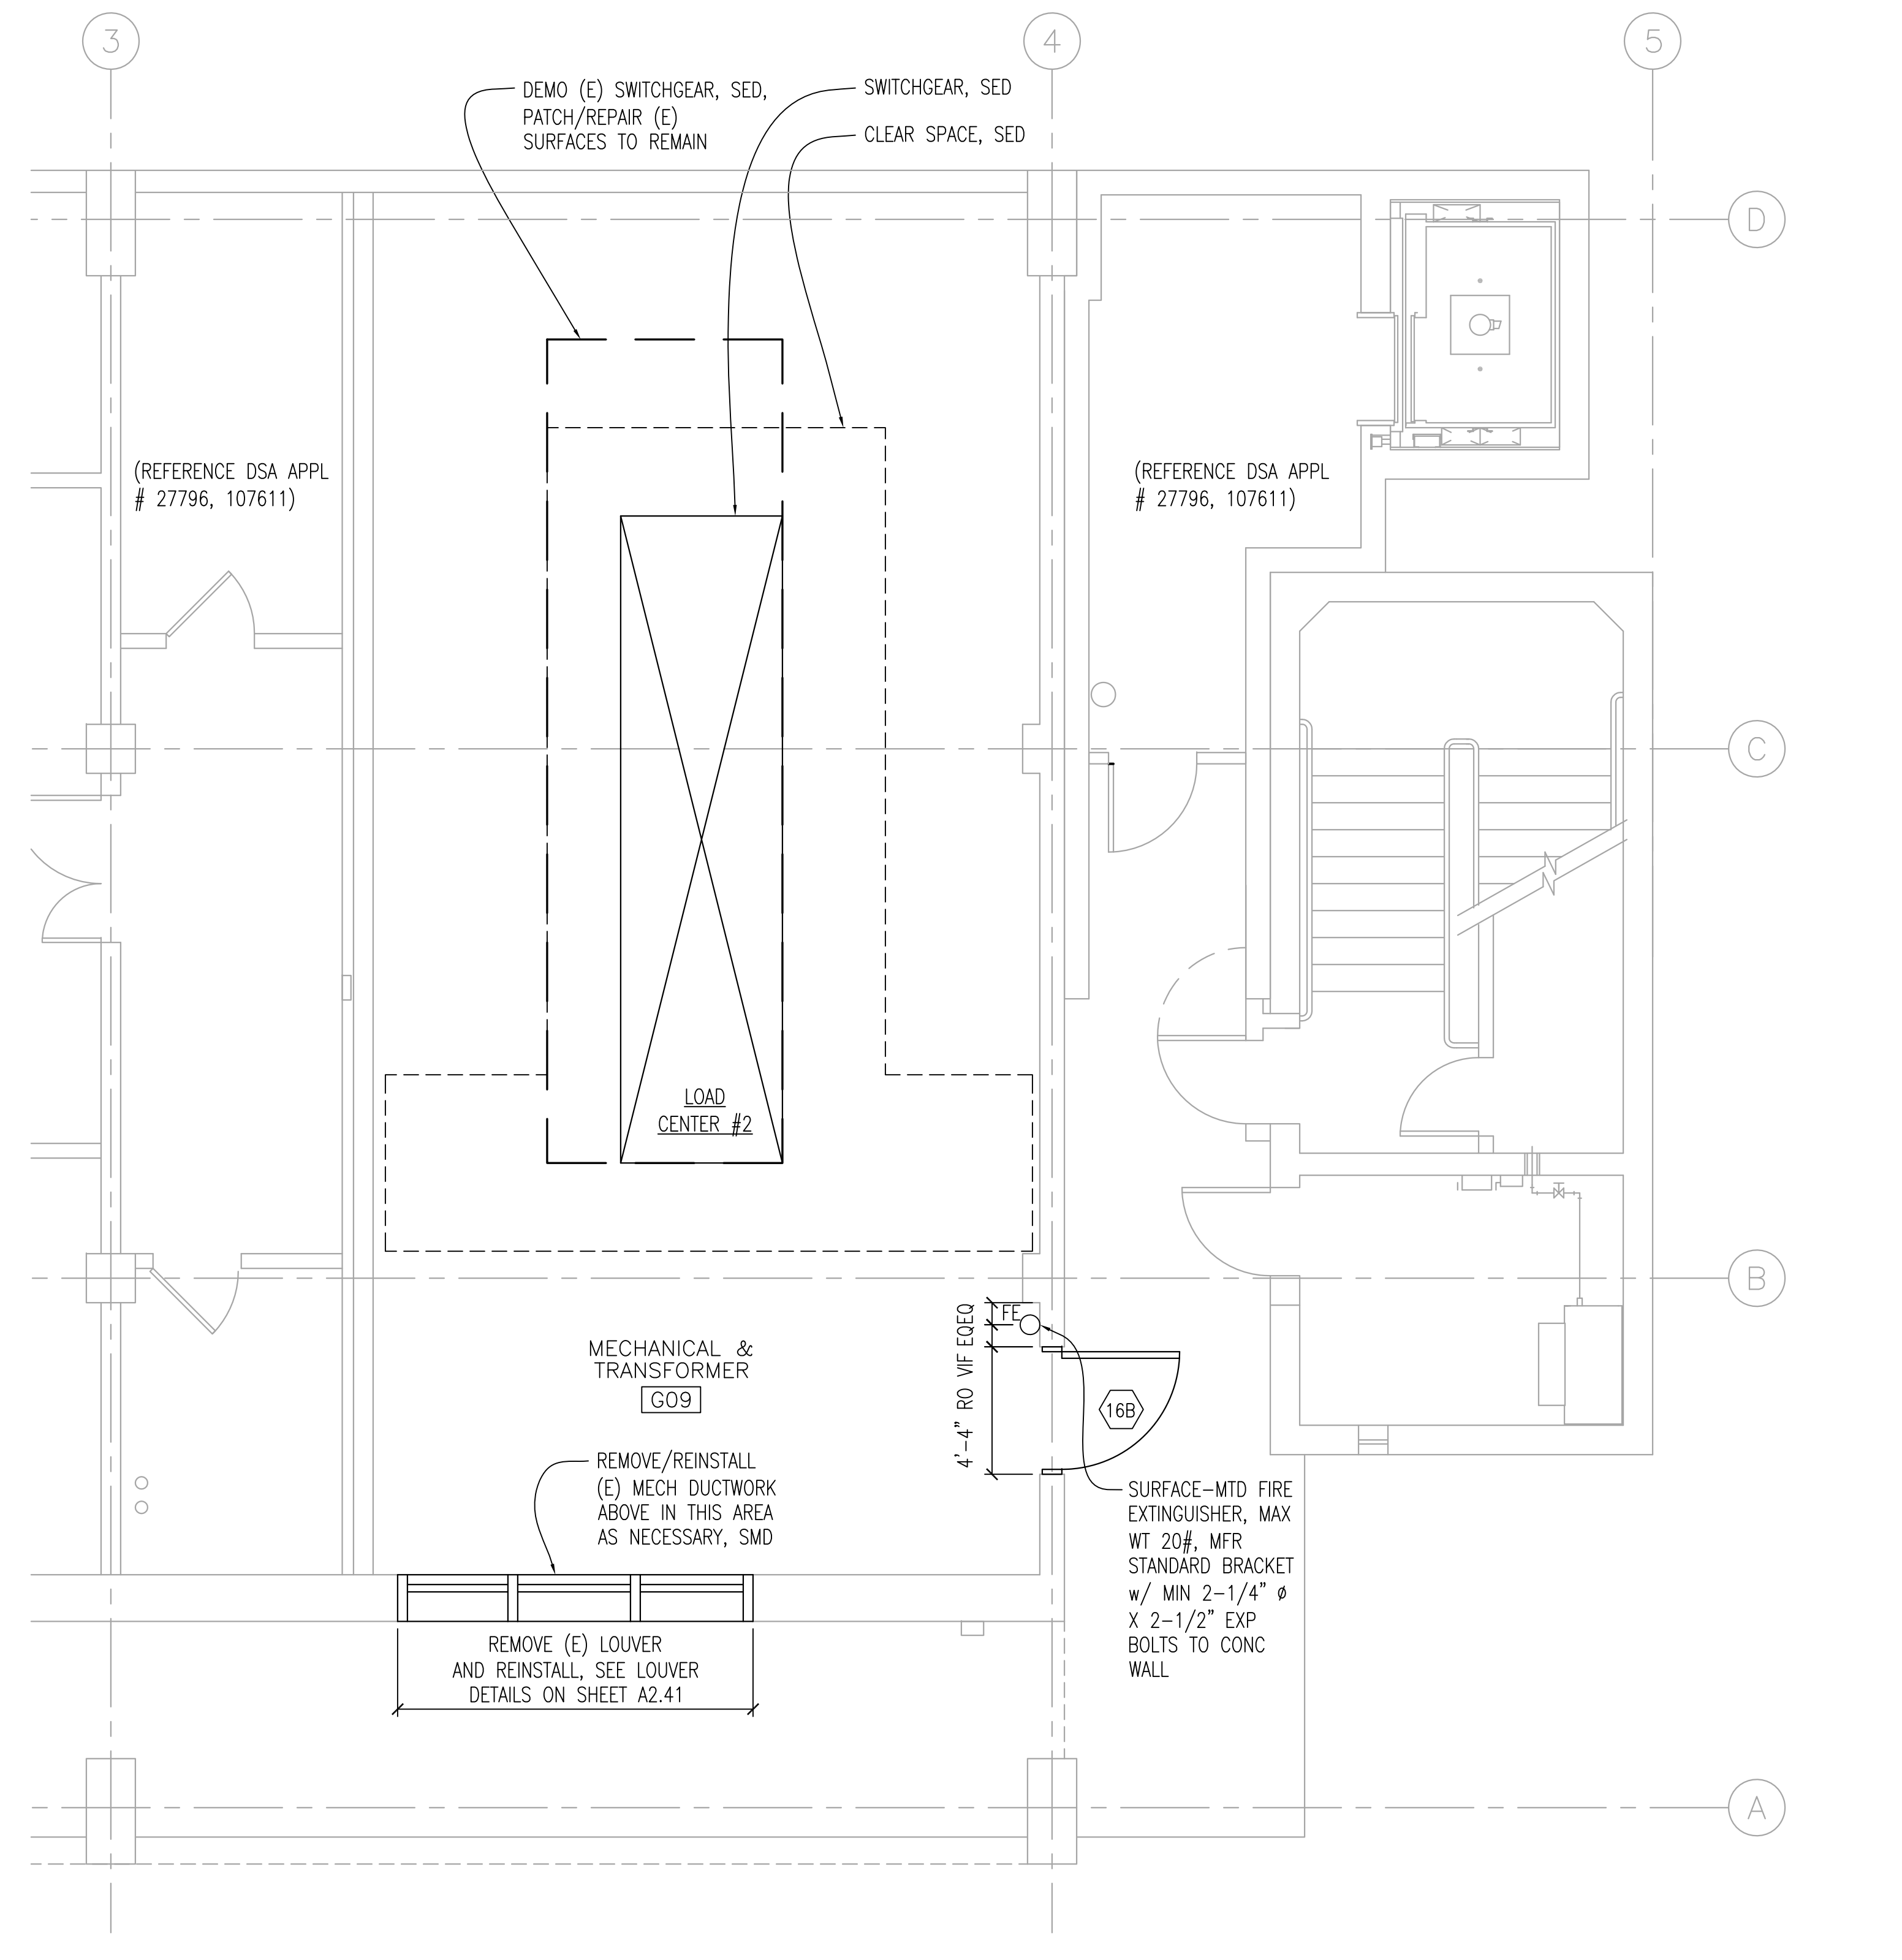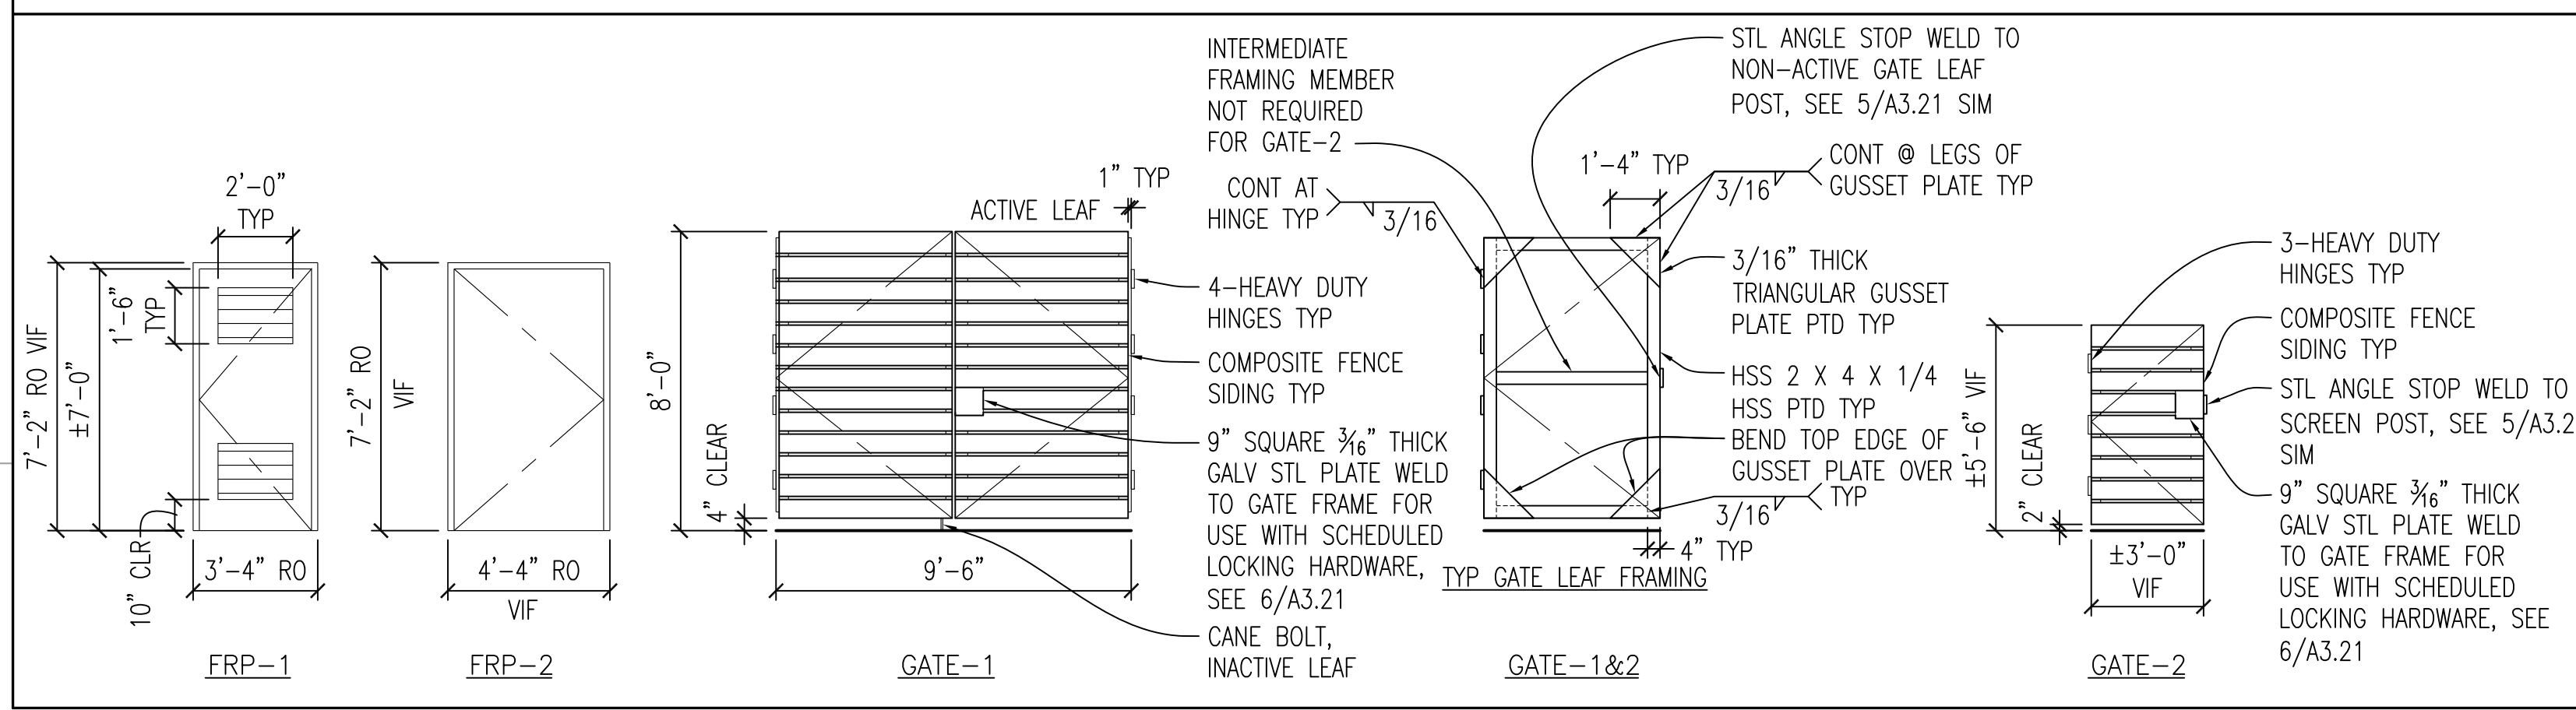

**1 BLDG 16 LOAD CENTER #2 - PARTIAL GROUND FLOOR PLAN** DSA APPL # 27796, 107611 1/4" = 1'-0"


nolltam  
architects and planners

729 Heinz Avenue  
Berkeley, CA 94710  
516.649.8295  
fax 510.649.3008

IDENTIFICATION STAMP  
DIVISION OF THE STATE ARCHITECT  
APPLICATION NUMBER 01-111618  
AC \_\_\_\_\_  
DATE \_\_\_\_\_

CALIFORNIA STATE FIRE MARSHAL  
APPROVED  
APPROVAL OF THIS PLAN DOES NOT AUTHORIZE OR APPROVE ANY  
CONSTRUCTION OR DEVIATION FROM APPLICABLE REGULATIONS. FINAL  
APPROVAL IS SUBJECT TO REGISTRATION. ONE SET OF APPROVED  
PLANS SHALL BE AVAILABLE ON THE PROJECT SITE AT ALL TIMES.  
REVIEWED BY: \_\_\_\_\_ DATE: \_\_\_\_\_

**CAÑADA COLLEGE**  
Electrical  
Infrastructure  
Replacement  
Project  
4200 Farm Hill Blvd  
Redwood City, CA 94061

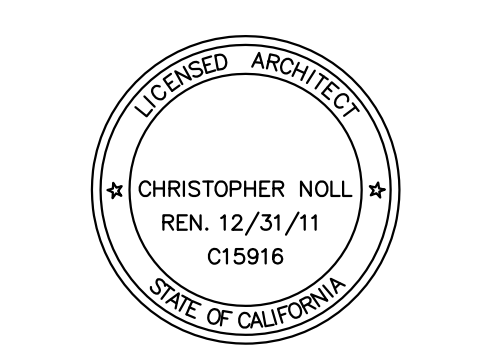

RECORD DRAWING

SHEET TITLE

**BLDG 16 Load Center #2- Plans, Schedule**

NO.	DATE	DESCRIPTION

DATE July 9, 2012  
DRAWN TC/AL  
CHECKED MM  
SCALE 1/4" = 1'-0"  
JOB NO. 2921.01  
SHEET NUMBER

**A2.31**

