
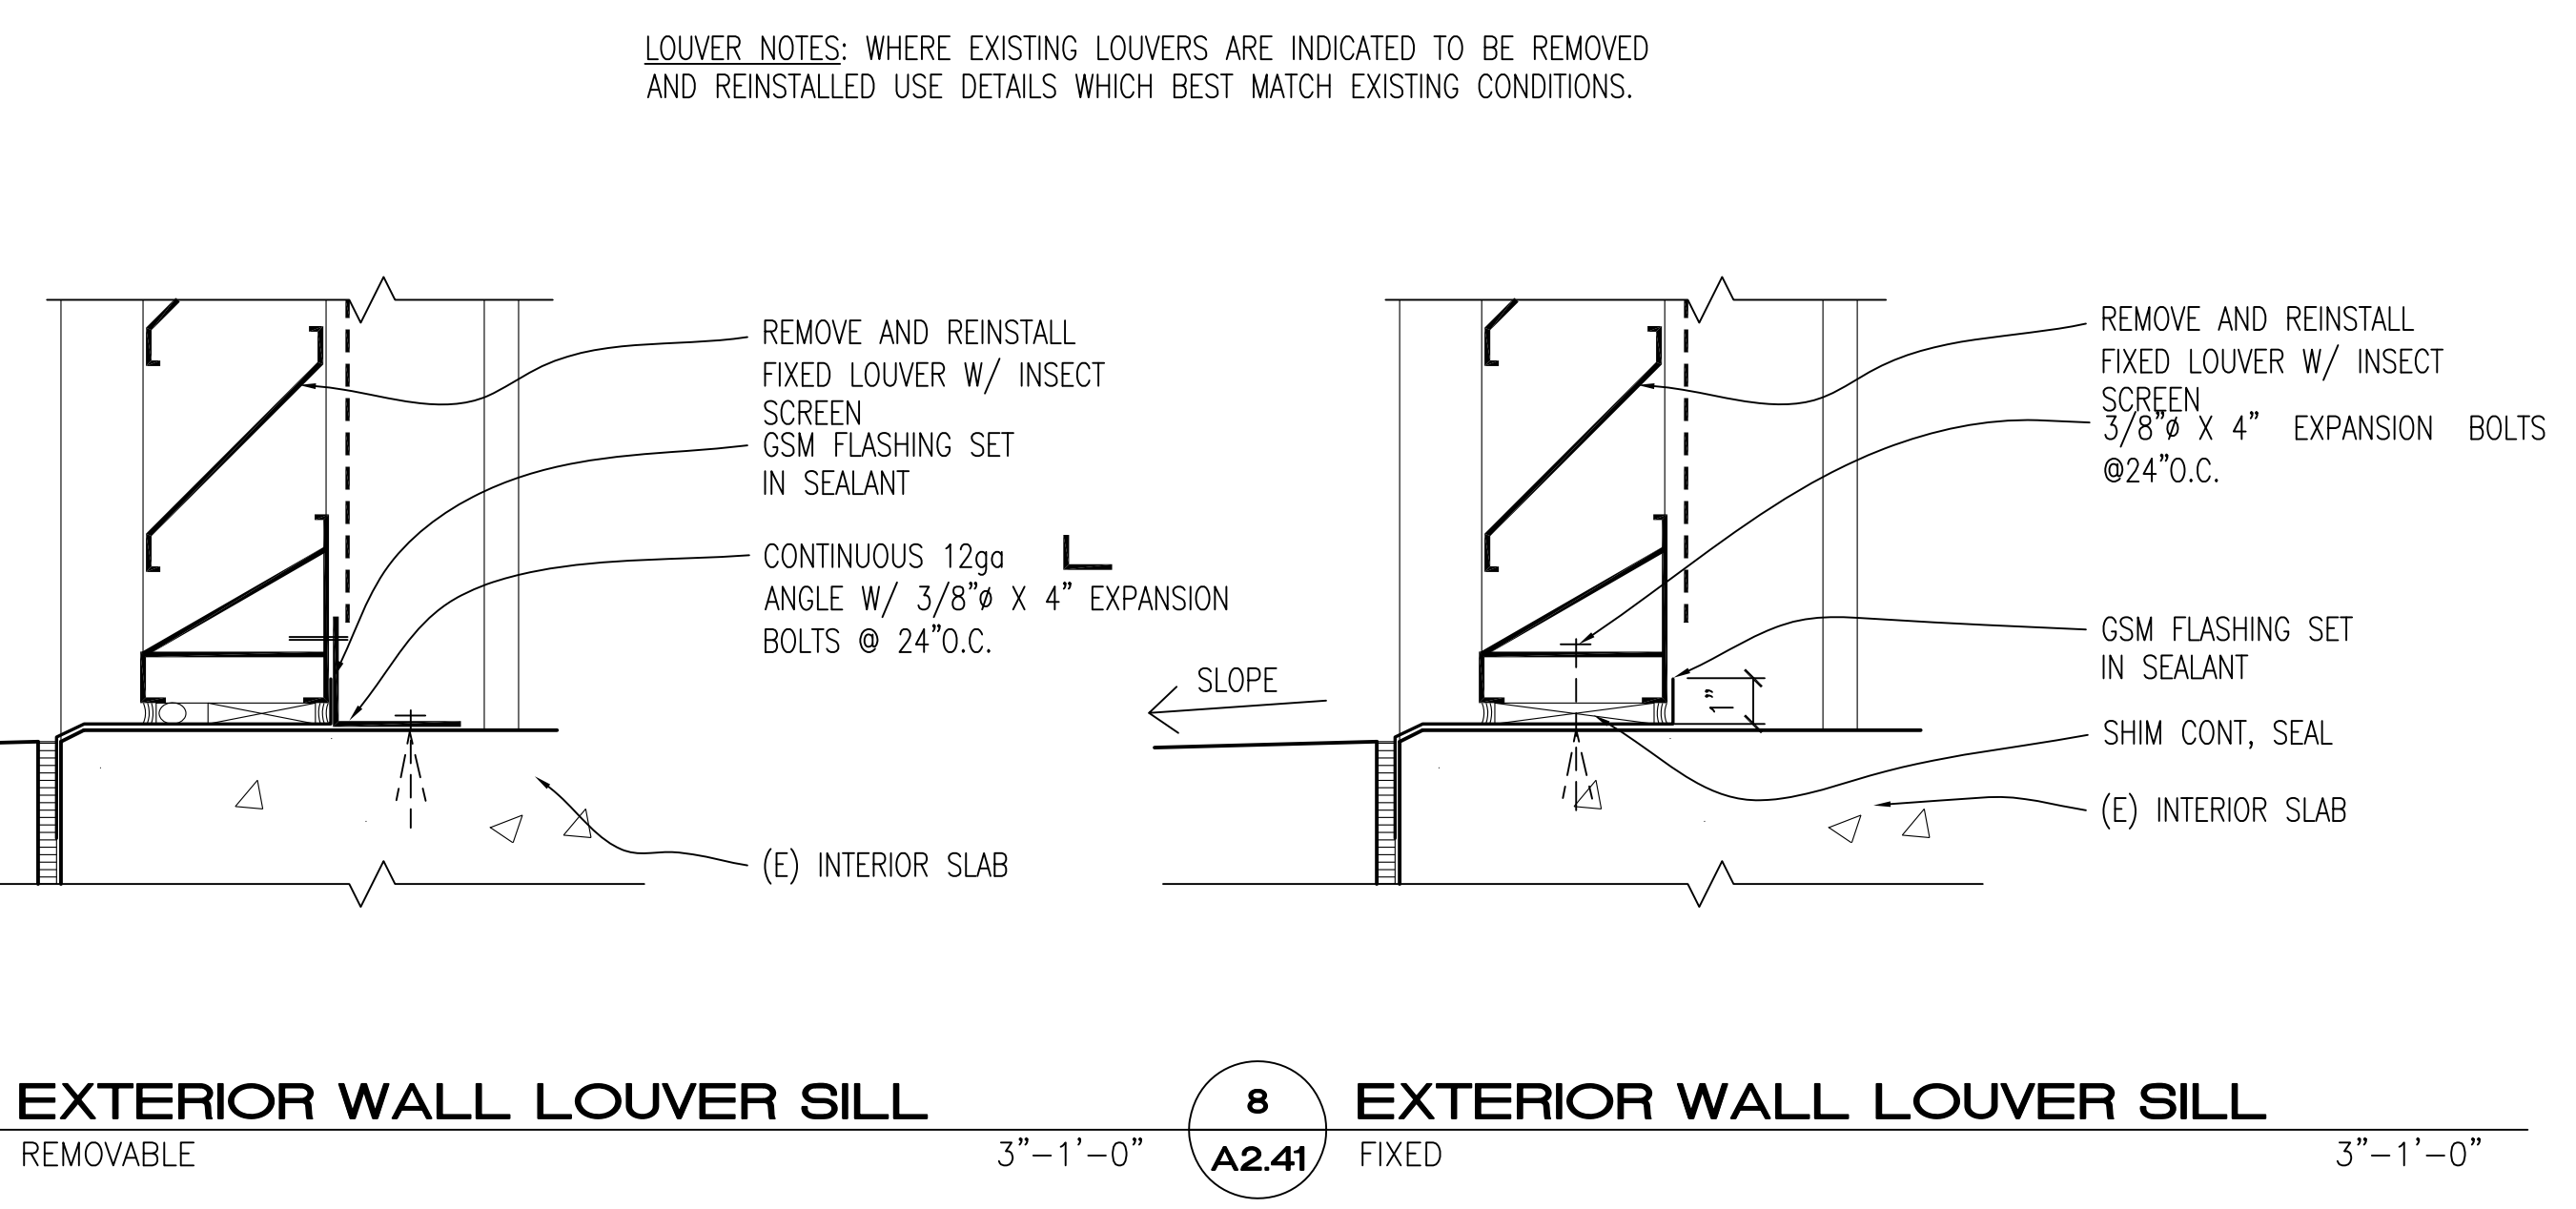


1 BLDG 13 - PARTIAL FIRST FLOOR PLAN DSA APPL # 27796 1/4" = 1'-0"


LOUVER NOTES: WHERE EXISTING LOUVERS ARE INDICATED TO BE REMOVED AND REINSTALLED USE DETAILS WHICH BEST MATCH EXISTING CONDITIONS.

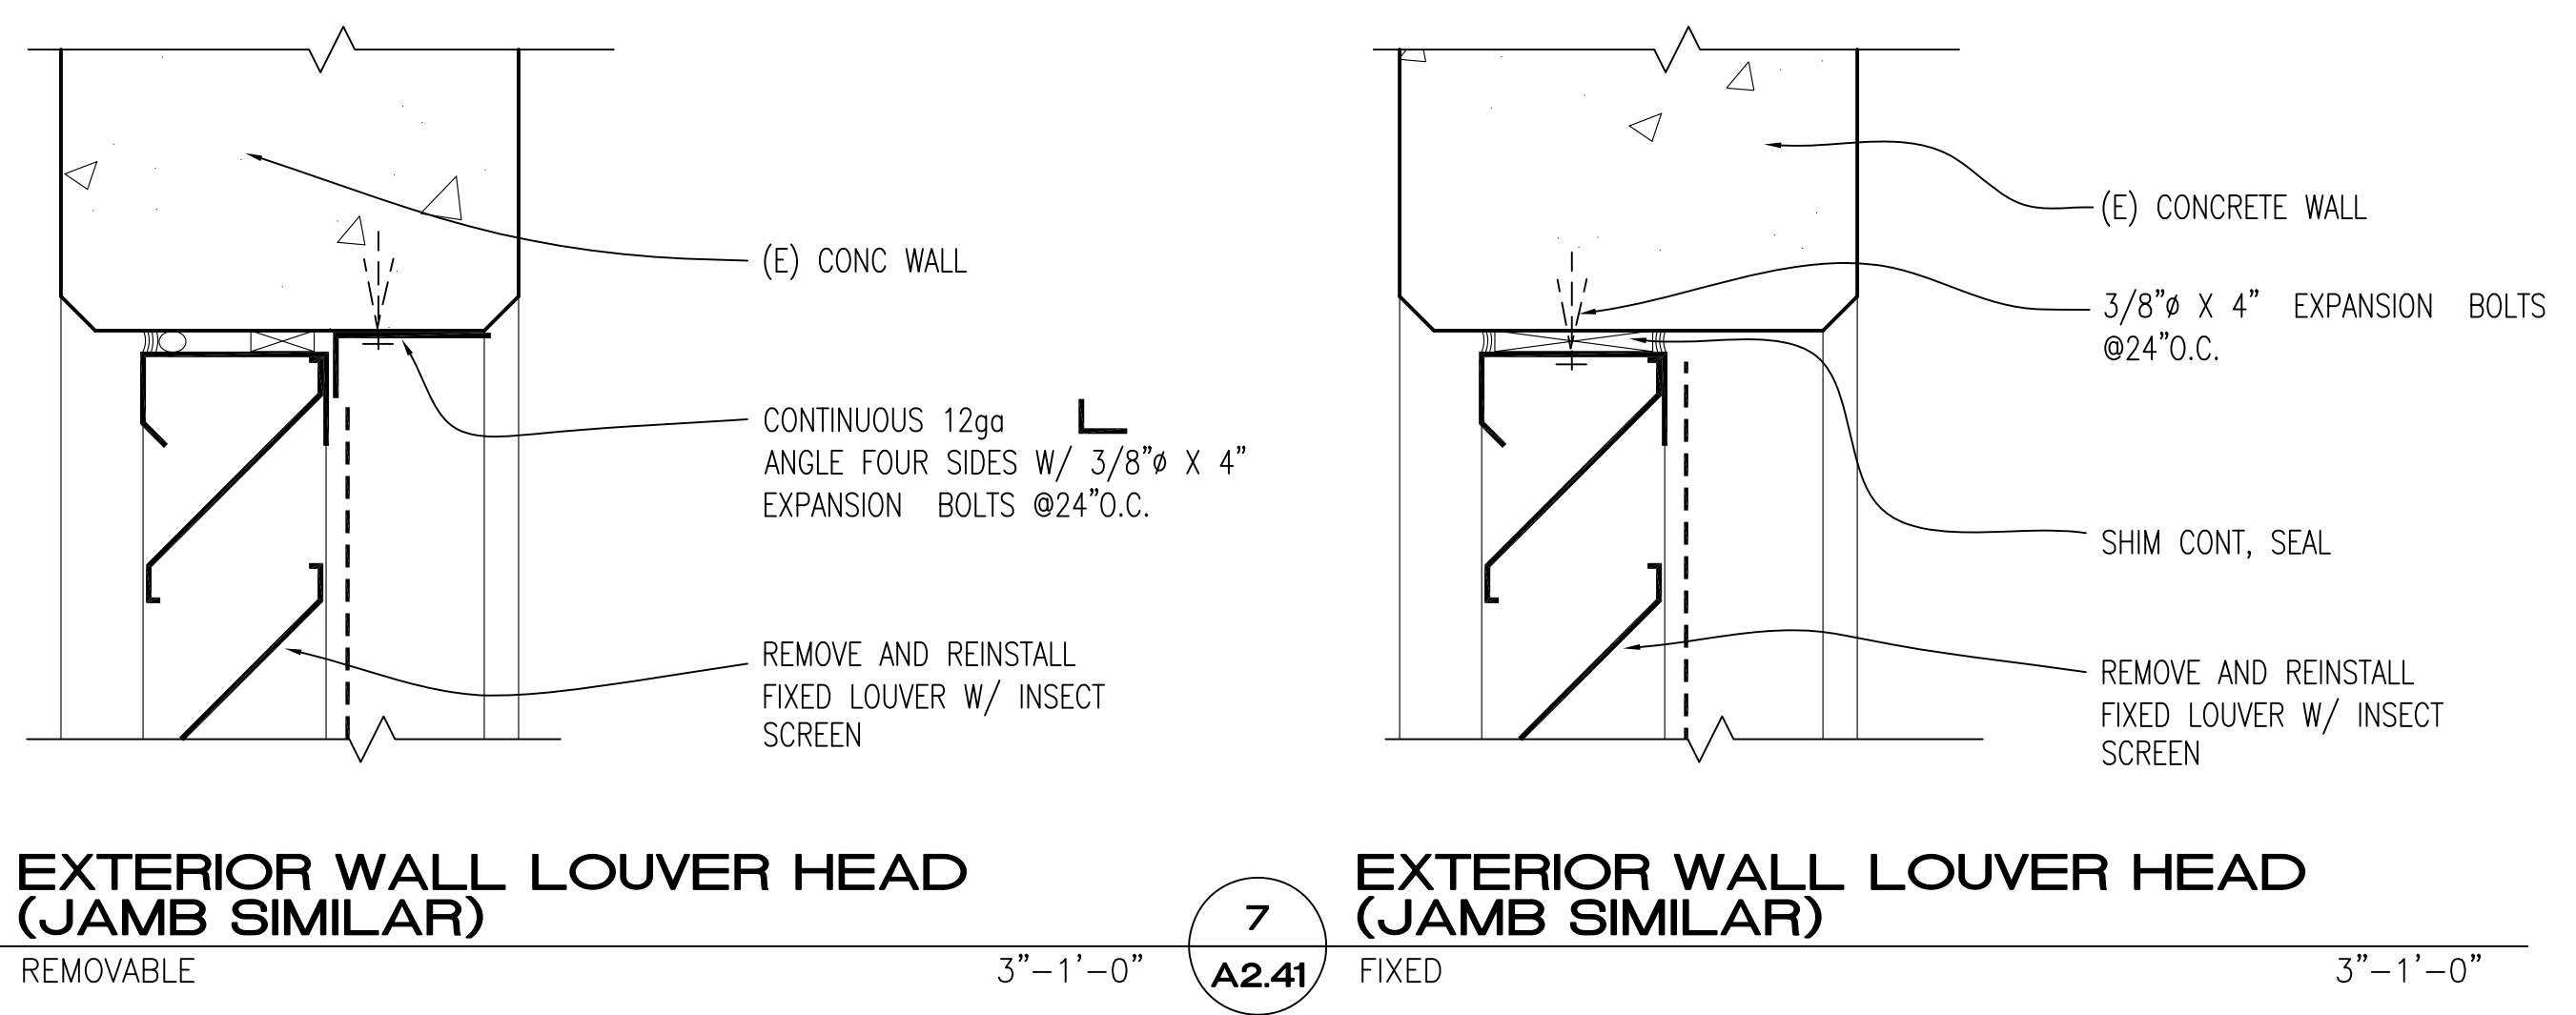

LOUVER NOTES: WHERE EXISTING LOUVERS ARE INDICATED TO BE REMOVED AND REINSTALLED USE DETAILS WHICH BEST MATCH EXISTING CONDITIONS.

IDENTIFICATION STAMP
 DIVISION OF THE STATE ARCHITECT
 APPLICATION NUMBER 01-111618
 AC _____ RLS _____ 05 _____
 DATE _____
 CALIFORNIA STATE FIRE MARSHAL APPROVED
 APPROVAL OF THIS PLAN DOES NOT AUTHORIZE OR APPROVE ANY CHANGE OR DEVIATION FROM APPLICABLE REGULATIONS. FINAL APPROVAL IS SUBJECT TO REG. NOTICES. ONE SET OF APPROVED PLANS SHALL BE AVAILABLE ON THE PROJECT SITE AT ALL TIMES.
 REVIEWED BY: _____ DATE: _____

CAÑADA COLLEGE
 Electrical Infrastructure Replacement Project
 4200 Farm Hill Blvd
 Redwood City, CA 94061

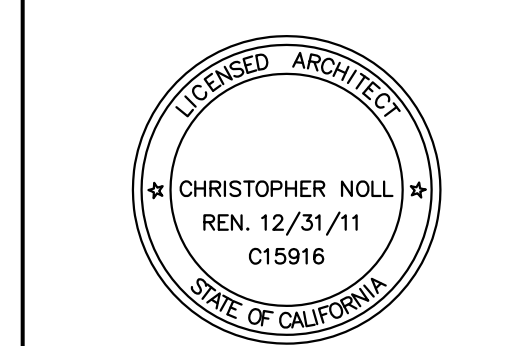

RECORD DRAWING

SHEET TITLE
Bldg 13-Plan

REVISIONS		
NO.	DATE	DESCRIPTION

DATE July 9, 2012
 DRAWN TC/AL
 CHECKED MM
 SCALE 1/4" = 1'-0"
 JOB NO. 2921.01

SHEET NUMBER
A2.41

