EXISTING CONDITION NOTES

- 1. THIS CONTRACTOR SHALL VERIFY ALL EXISTING CONDITIONS AND DIMENSIONS AT THE JOB SITE. CONTRACTOR SHALL COMPARE THE MECHANICAL DRAWINGS WITH ARCHITECTURAL, STRUCTURAL, CIVIL, PLUMBING, AND ELECTRICAL DRAWINGS AND THE DRAWINGS OF OTHER TRADES BEFORE COMMENCING WITH THE WORK AND SHALL NOTIFY THE ARCHITECT OF ANY DISCREPANCIES REQUIRING CLARIFICATION OR REVISION. DO NOT SCALE DRAWINGS.
- 2. MECHANICAL SYSTEMS SHOWN ARE BASED ON FIELD SITE VISITS AND ON THE AVAILABLE ORIGINAL MECHANICAL DRAWINGS. ACTUAL LOCATIONS OF EXISTING MECHANICAL EQUIPMENT, DUCT AND PIPING MAY VARY FROM THOSE SHOWN ON THESE DRAWINGS.
- 3. ALL EXISTING CONDITIONS HAVE BEEN SHOWN AS ACCURATELY AS POSSIBLE. ALL EXISTING CONDITIONS ARE TO BE FIELD VERIFIED. CONTRACTOR IS TO INCLUDE IN HIS BID, ADJUSTMENTS TO THE WORK AS REQUIRED TO ACCOMMODATE THE ACTUAL FIELD CONDITIONS.

SITE VISIT PRIOR TO BID SUBMISSION

- 1. VISIT THE SITE OF THE WORK. COMPARE THE EXISTING CONDITIONS WITH THE DRAWINGS AND SPECIFICATIONS AS TO THE CONDITIONS TO WHICH WORK IS TO BE PERFORMED. ASCERTAIN AND CHECK ALL CONDITIONS AND ELEVATIONS AND TAKE ALL MEASUREMENTS THAT MAY AFFECT THE WORK. NO ALLOWANCE SHALL SUBSEQUENTLY BE MADE FOR ANY ADDITIONAL EXPENSES OR CLAIMS DUE TO THE FAILURE OR NEGLECT UNDER THIS SECTION TO MAKE SUCH EXAMINATION, INCLUDING EXAMINATION OF RESTRICTED WORKING CONDITIONS OR SUCH OTHER DIFFICULTIES VISUALLY OBSERVED DURING THE SITE VISIT.
- 2. ALL EXISTING CONDITIONS HAVE BEEN SHOWN AS ACCURATELY AS POSSIBLE. ALL EXISTING CONDITIONS ARE TO BE FIELD VERIFIED. CONTRACTOR IS TO INCLUDE IN HIS BID ADJUSTMENTS TO THE WORK AS REQUIRED TO ACCOMMODATE THE ACTUAL FIELD CONDITIONS.

DUCT/PIPING BRACING GUIDELINES

- 1. PIPING AND DUCTWORK SYSTEMS SHALL BE BRACED TO RESIST THE FORCES PRESCRIBED IN ASCE 7-05 13.3 AS DEFINED IN ASCE 7-05 SECTIONS 13.6.8, 13.6.7 AND 13.6.5.5 ITEM 6 RESPECTIVELY.
- 2. THE BRACING AND ATTACHMENTS TO THE STRUCTURE SHALL COMPLY WITH ONE OF THE OSHPD PRE-APPROVALS WITH OPA # SUCH AS MASON INDUSTRIES (OPA 349), OR ISAT (OPA 485) AS MODIFIED TO SATISFY ANCHORAGE REQUIREMENTS OF ACI 318, APPENDIX D.
- 3. COPIES OF THE PRE-APPROVAL MANUAL SHALL BE AVAILABLE ON THE JOBSITE PRIOR TO THE START OF HANGING AND BRACING OF THE PIPE AND DUCTWORK SYSTEMS. THE STRUCTURAL ENGINEER OF RECORD SHALL VERIFY THE ADEQUACY OF THE STRUCTURE TO SUPPORT THE HANGER AND BRACE LOADS.


SEISMIC BRACING NOTES

- ALL BRACING OF DUCTS AND PIPING SHALL BE INSTALLED IN ACCORDANCE WITH SMACNA GUIDELINES AS APPROVED BY DSA.
- 2. WHERE BRACING DETAILS ARE NOT SHOWN ON THE DRAWINGS OR IN THE GUIDELINE, THE FIELD INSTALLATION SHALL BE SUBJECT TO THE APPROVAL OF THE MECHANICAL ENGINEER AND THE DSA FIELD ENGINEER.
- 3. A COPY OF THE GUIDELINES PUBLISHED BY SMACNA AND APPROVED BY DSA SHALL BE PROVIDED BY THE CONTRACTOR AND KEPT ON THE JOB AT ALL TIMES.

| SYMBOL | ABBREVIATION | DESCRIPTION | <u>ABBREVIATION</u> | DESCRIPTION | ABBREVIATION | DESCRIPTION |
|---|--------------|---|---------------------|---------------------------------|-------------------------|---|
| S | | SWITCH OR SENSOR - MOUNT AT +48" AFF | ø | DIAMETER | H & V, HV | HEATING AND VENTILATING |
| _ | | | ø | PHASE | HT. | HEIGHT |
| T | | THERMOSTAT - MOUNT AT +48" AFF | AC, A/C | AIR CONDITIONING | HVAC | HEATING, VENTILATING AND AIR CONDITIONING |
| 4 | | SHEET NOTE DESIGNATION | AFF | ABOVE FINISHED FLOOR | IFC | IN FURRED CEILING |
| _ | | ITEM FURNISHED AND INSTALLED | ALT. | ALTERNATE | IN. | INCH, INCHES |
| M | | BY MECHANICAL CONTRACTOR | AP | ACCESS PANEL | (2"L), (1"L), OR (L) | LINED DUCT — ALL DIMENSIONS SHOWN ARE NET |
| E | | ITEM FURNISHED AND INSTALLED BY ELECTRICAL CONTRACTOR | APPROX. | APPROXIMATE | OK (L) | LINED DUCT — ALL DIMENSIONS SHOWN ARE NET CLEAR INSIDE DIMENSIONS. DUCTS ARE TO BE INCREASED IN SIZE TO ACCOMMODATE LINING, WITHOLOSS OF AREA. (2"L) INDICATES 2" THICK, 3 PCF LINING; (1"L) OR (L) INDICATES 1" THICK, 1.5 PCF |
| P | | ITEM FURNISHED AND INSTALLED | ARCH. | ARCHITECT, ARCHITECTURAL | | LINING; (1"L) OR (L) INDICATES 1" THICK, 1.5 PCF LINING. |
| | | BY PLUMBING CONTRACTOR | BD | BOTTOM OF DUCT | LBS., # | POUNDS |
| $\begin{pmatrix} 1 \\ M2.1 \end{pmatrix}$ | | DETAIL REFERENCE — UPPER NUMBER=DETAIL NUMBER, | BF | BELOW FLOOR | LVG. | LEAVING |
| | | LOWER NUMBER=SHEET NUMBER | BG | BELOW GRADE | MAT'L, MATL. | MATERIAL |
| $\frac{\overline{AC}}{1}$ | | EQUIPMENT TAG | BLDG. | BUILDING | MAX. | MAXIMUM |
| 1 | | | CFH | CUBIC FEET PER HOUR | МВН | 1,000 BTU/HR. |
| | | EXISTING DUCT, PIPING OR EQUIPMENT | CFM | CUBIC FEET PER MINUTE | MECH. | MECHANICAL |
| | | TO REMAIN | CKT. | CIRCUIT | MED. | MEDIUM |
| | | EXISTING DUCT, PIPING OR EQUIPMENT TO BE REMOVED | ę a | CENTERLINE | MFG. | MANUFACTURER |
| | | IO DE REMOVED | CLG | CONCRETE | MIN. | MINIMUM |
| | | | CONC. | CONCRETE | MIN. | MINUTE |
| | | | CONT. | CONNECTION CONTINUATION | MTD. | MOUNTED |
| | | | CONT. CONTR. | CONTRACTOR | (N) | NEW |
| | | | CTE | CONNECT TO EXISTING | NIC, N.I.C. | NOT IN CONTRACT |
| | | | DF | DOUGLAS FIR | NO | NORMALLY OPEN |
| | | | DI | DIGITAL INPUT | OC | ON CENTER |
| | | | DIA. | DIAMETER | O.D. | OUTSIDE DIAMETER |
| | | | DIM. | DIMENSION | OPNG. | OPENING |
| | | | DIV. | DIVISION | OSA | OUTSIDE AIR |
| | | | DN | DOWN | PC | PLUMBING CONTRACTOR |
| | | | DSA | DIVISION OF THE STATE ARCHITECT | PCF | POUNDS PER CUBIC FOOT |
| | | | DWG | DRAWING | PLMB. | PLUMBING |
| | | | DWGS. | DRAWINGS | POC | POINT OF CONNECTION |
| | | | (E) | EXISTING | PRESS. | PRESSURE |
| | | | EAT | ENTERING AIR TEMPERATURE | PSI | POUNDS PER SQUARE INCH |
| | | | EFF. | EFFICIENT, EFFICIENCY | R | RADIUS |
| | | | ELEC. | ELECTRICAL | REF. | REFERENCE |
| | | | ELEC. CHAR. | ELECTRICAL CHARACTERISTICS | REQD. | REQUIRED |
| | | | ELEV. | ELEVATION | REV. | REVISION ROUND HEAD WOOD CODEWS |
| | | | EMBED. | EMBEDMENT | RHWS | ROUND HEAD WOOD SCREWS |
| | | | ENT. | ENTERING | SAD SED | SEE ARCHITECTURAL DRAWINGS SEE ELECTRICAL DRAWINGS |
| | | | EQ. | EQUAL | SF, S.F. | SQUARE FEET |
| | | | EXH | EXHAUST | SIM | SIMILAR |
| | | | EXIST. | EXISTING | SM | SHEET METAL |
| | | | FF, F.F. | FINISHED FLOOR | SPD | SEE PLUMBING DRAWINGS |
| | | | FT. | FEET | SS | STAINLESS STEEL - TYPE 316 UNO |
| | | | FPS | FEET PER SECOND | SSD | SEE STRUCTURAL DRAWINGS |
| | | | GA. | GAUGE | STL. | STEEL |
| | | | GAL. | GALLON | TD | TOP OF DUCT |
| | | | GC | GENERAL CONTRACTOR | TS, T.S. | TOP OF STEEL |
| | | | GPM | GALLONS PER MINUTE | TS, T.S. | TUBE STEEL |
| | | | GSM | GALVANIZED SHEET METAL | TYP. | TYPICAL |
| | | | GYP. BD. | GYPSUM BOARD | UL, U.L. | UNDERWRITERS' LABORATORY |
| | | | | | UNO | UNLESS NOTED OTHERWISE |
| | | | | | VIF | VERIFY IN FIELD |
| | | | | | WG | WATER GAGE |
| | | | | | W.O.G. | WATER OIL GAS |
| | | | | | W.P. | WATERPROOF |
| | | | | | | 14# - 714 |

MECHANICAL LIST OF DRAWINGS
M0.1 MECHANICAL LEGEND AND NOTES

M1.1 MECHANICAL PARTIAL FLOOR PLANS - BUILDING 16

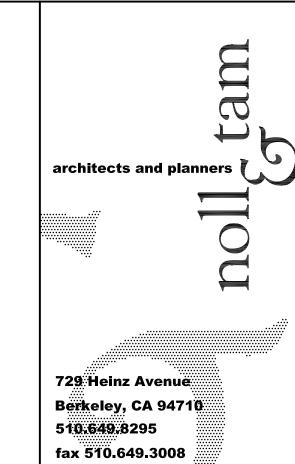

CALIFORNIA STATE FIRE MARSHAL APPROVED

APPROVAL OF THIS PLAN DOES NOT AUTHORIZE OR APPROVE ANY OMISSION OR DEVIATION FROM APPLICABLE REGULATIONS. FINAL APPROVAL IS SUBJECT TO FIELD INSPECTION. ONE SET OF APPROVED PLANS SHALL BE AVAILABLE ON THE PROJECT SITE AT ALL TIMES.

REVIEWED BY: _______ DATE:

CAÑADA COLLEGE

Electrical
Infrastructure
Replacement
Project

4200 Farm Hill Blvd Redwood City, CA 94061

RECORD SET

SHEET TITLE

MECHANICAL LEGEND AND NOTES

REVISIONS

NO. DATE DESCRIPTION

DATE June 15, 2012

DRAWN VT/AL

CHECKED MW

SCALE NO SCALE

JOB NO. 2921.01

SHEET NUMBER

MO.1