

**GENERAL NOTES**

1. PIPING FLOOR PLAN IS DIAGRAMMATIC. ALL ABOVE GRADE PIPING SHOWN NEAR A PLUMBING CHASE IS TO BE LOCATED WITHIN THE PLUMBING CHASE, UNLESS OTHERWISE NOTED. OFFSET PIPING AROUND BEAMS, COLUMNS, WALLS, ETC. AS REQUIRED.
2. ALL EXISTING CONDITIONS HAVE BEEN SHOWN AS ACCURATELY AS POSSIBLE. ALL EXISTING CONDITIONS ARE TO BE FIELD VERIFIED. CONTRACTOR IS TO INCLUDE IN HIS BID ADJUSTMENTS TO THE WORK AS REQUIRED TO ACCOMMODATE THE ACTUAL FIELD CONDITIONS.
3. FIELD VERIFY LOCATIONS OF MECHANICAL SYSTEM UNIT OUTSIDE AIR INTAKES. VENT PIPING TERMINATIONS IN ALL CASES ARE TO BE A MINIMUM OF TEN (10) FEET FROM A/C UNIT OUTSIDE AIR INTAKES AND ARE TO BE OFFSET AS REQUIRED. ALL VENT PIPING SUPPORTS, ETC. NECESSARY TO MEET THIS REQUIREMENT ARE TO BE INCLUDED.
4. ALL HORIZONTAL STORM DRAIN PIPING SHALL MAINTAIN A MINIMUM 2% SLOPE TO POINT OF DISPOSAL.
5. ALL CORING AND PENETRATIONS OF ROOFS, WALLS, FOOTINGS, AND/OR FLOORS FOR PIPING ARE TO BE AS SMALL AS POSSIBLE. OVERSIZING OF OPENINGS IS TO BE AVOIDED.
6. WALL PENETRATIONS ARE TO BE COORDINATED WITH ALL OTHER TRADES AND THE DRAWINGS. WALL PENETRATIONS ARE TO BE KEPT AS HIGH AS POSSIBLE AND ARE TO BE MADE IN AREAS WHERE PIPING WILL BE CONCEALED.
7. IF PENETRATIONS IN EXPOSED LOCATIONS ARE UNAVOIDABLE, INSTALL ESCUTCHEON RINGS AT THESE LOCATIONS.
8. COORDINATE WITH ALL TRADES TO AVOID CONFLICTS.

**SITE VISIT PRIOR TO BID SUBMISSION**

1. VISIT THE SITE OF THE WORK. COMPARE THE EXISTING CONDITIONS WITH THE DRAWINGS AND SPECIFICATIONS AS TO THE CONDITIONS TO WHICH WORK IS TO BE PERFORMED. ASCERTAIN AND CHECK ALL CONDITIONS AND ELEVATIONS AND TAKE ALL MEASUREMENTS THAT MAY AFFECT THE WORK. NO ALLOWANCE SHALL SUBSEQUENTLY BE MADE FOR ANY ADDITIONAL EXPENSES OR CLAIMS DUE TO THE FAILURE OR NEGLECT UNDER THIS SECTION TO MAKE SUCH EXAMINATION, INCLUDING EXAMINATION OF RESTRICTED WORKING CONDITIONS OR SUCH OTHER DIFFICULTIES VISUALLY OBSERVED DURING THE SITE VISIT.
2. ALL EXISTING CONDITIONS HAVE BEEN SHOWN AS ACCURATELY AS POSSIBLE. ALL EXISTING CONDITIONS ARE TO BE FIELD VERIFIED. CONTRACTOR IS TO INCLUDE IN HIS BID ADJUSTMENTS TO THE WORK AS REQUIRED TO ACCOMMODATE THE ACTUAL FIELD CONDITIONS.

**EXISTING UTILITY CONNECTION NOTES**

1. PORTIONS OF THE PLUMBING WORK INCLUDE CONNECTING INTO THE EXISTING BUILDING UTILITY PIPING INCLUDING, BUT NOT LIMITED TO, COLD WATER, WASTE AND VENT PIPING.
2. PRIOR TO ANY SHUTDOWN OF THE BUILDING SYSTEMS NOTIFY DISTRICT A MINIMUM OF TWO (2) WEEKS IN ADVANCE TO COORDINATE REQUIRED SYSTEM DOWN TIME AND APPROPRIATE DATE(S). CONTRACTOR IS RESPONSIBLE FOR BRINGING SYSTEMS BACK ON LINE.
3. AFTER ALL NEW WORK IS COMPLETE, THE CAMPUS SYSTEMS ARE TO BE PURGED OF ALL AIR, FLUSHED OF ALL DEBRIS.

**EXISTING CONDITION NOTES**

1. THIS CONTRACTOR SHALL VERIFY ALL EXISTING CONDITIONS AND DIMENSIONS AT THE JOB SITE. CONTRACTOR SHALL COMPARE THE PLUMBING DRAWINGS WITH ARCHITECTURAL, STRUCTURAL, CIVIL, MECHANICAL, AND ELECTRICAL DRAWINGS AND THE DRAWINGS OF OTHER TRADES BEFORE COMMENCING WITH THE WORK AND SHALL NOTIFY THE ARCHITECT OF ANY DISCREPANCIES REQUIRING CLARIFICATION OR REVISION. DO NOT SCALE DRAWINGS.
2. ALL EXISTING UTILITIES SHOWN ARE BASED ON FIELD SITE VISITS AND ON THE AVAILABLE ORIGINAL PLUMBING DRAWINGS. ACTUAL LOCATIONS OF UTILITIES MAY VARY FROM THOSE SHOWN ON THESE DRAWINGS.
3. ALL EXISTING CONDITIONS HAVE BEEN SHOWN AS ACCURATELY AS POSSIBLE. ALL EXISTING CONDITIONS ARE TO BE FIELD VERIFIED. CONTRACTOR IS TO INCLUDE IN HIS BID, ADJUSTMENTS TO THE WORK AS REQUIRED TO ACCOMMODATE THE ACTUAL FIELD CONDITIONS.

**PIPING BRACING GUIDELINES**

1. PIPING DISTRIBUTION SYSTEMS SHALL BE BRACED TO RESIST THE FORCES PRESCRIBED IN ASCE 7-05 13.3 AS DEFINED IN ASCE 7-05 SECTIONS 13.6.8, 13.6.7 AND 13.6.5.5 ITEM 6, RESPECTIVELY.
2. THE BRACING AND ATTACHMENTS TO THE STRUCTURE SHALL COMPLY WITH ONE OF THE OSHPD PRE-APPROVALS WITH OPA # SUCH AS MASON INDUSTRIES (OPA 349), OR ISAT (OPA 485) AS MODIFIED TO SATISFY ANCHORAGE REQUIREMENTS OF ACI 318, APPENDIX D.
3. COPIES OF THE PRE-APPROVAL MANUAL SHALL BE AVAILABLE ON THE JOBSITE PRIOR TO THE START OF HANGING AND BRACING OF THE PIPING SYSTEMS. THE STRUCTURAL ENGINEER OF RECORD SHALL VERIFY THE ADEQUACY OF THE STRUCTURE TO SUPPORT THE HANGER AND BRACE LOADS.

**SEISMIC BRACING NOTES**

1. ALL BRACING OF PIPING SHALL BE INSTALLED IN ACCORDANCE WITH SMAQNA GUIDELINES AS APPROVED BY DSA.
2. WHERE BRACING DETAILS ARE NOT SHOWN ON THE DRAWINGS OR IN THE GUIDELINE, THE FIELD INSTALLATION SHALL BE SUBJECT TO THE APPROVAL OF THE MECHANICAL ENGINEER AND THE DSA FIELD ENGINEER.
3. A COPY OF THE GUIDELINES PUBLISHED BY SMAQNA AND APPROVED BY DSA SHALL BE PROVIDED BY THE CONTRACTOR AND KEPT ON THE JOB AT ALL TIMES.

**PLUMBING LEGEND AND ABBREVIATIONS**

| SYMBOL      | ABBREVIATION | DESCRIPTION  | ABBREVIATION | DESCRIPTION                                 | ABBREVIATION | DESCRIPTION                |
|-------------|--------------|--|--------------|---|--------------|----------------------------|
| (4)         |              | SHEET NOTE DESIGNATION   | Ø            | DIAMETER                                    | GCO          | GRADE CLEANOUT             |
| (M)         |              | ITEM FURNISHED AND INSTALLED BY MECHANICAL CONTRACTOR                    | Ø            | PHASE                                       | GPH          | GALLONS PER HOUR           |
| (E)         |              | ITEM FURNISHED AND INSTALLED BY ELECTRICAL CONTRACTOR                    | AFF          | ABOVE FINISHED FLOOR                        | GPM          | GALLONS PER MINUTE         |
| (P)         |              | ITEM FURNISHED AND INSTALLED BY PLUMBING CONTRACTOR                      | ALT.         | ALTERNATE                                   | GSM          | GALVANIZED SHEET METAL     |
| (1)<br>P2.1 |              | DETAIL REFERENCE - UPPER NUMBER=DETAIL NUMBER, LOWER NUMBER=SHEET NUMBER | AP           | ACCESS PANEL                                | HB           | HOSE BIBB                  |
| SD          | SD           | STORM DRAIN PIPING   | APPROX.      | APPROXIMATE                                 | HT.          | HEIGHT                     |
| ○ EQO       | FCO          | FLOOR CLEANOUT   | ARCH.        | ARCHITECT, ARCHITECTURAL                    | IE, I.E.     | INVERT ELEVATION           |
| ○ WCO       | WCO          | WALL CLEANOUT  | BF           | BELOW FLOOR                                 | IFC          | IN FURRED CEILING          |
| — — —       |              | WALL CLEANOUT  | BFF          | BELOW FINISHED FLOOR                        | IND.         | INDIRECT                   |
| — — —       |              | WALL CLEANOUT  | BG           | BELOW GRADE                                 | INV          | INVERT                     |
| — — —       |              | WALL CLEANOUT  | BLDG.        | BUILDING                                    | LBS., #      | POUNDS                     |
| — — —       |              | WALL CLEANOUT  | BV           | BALL VALVE                                  | MAX.         | MAXIMUM                    |
| — — —       |              | WALL CLEANOUT  | CFCI         | CONTRACTOR FURNISHED / CONTRACTOR INSTALLED | MECH.        | MECHANICAL                 |
| — — —       |              | WALL CLEANOUT  | CL           | CENTERLINE                                  | MGF.         | MANUFACTURER               |
| — — —       |              | WALL CLEANOUT  | CI           | CAST IRON                                   | MH           | MANHOLE                    |
| — — —       |              | WALL CLEANOUT  | CKV          | CHECK VALVE                                 | MIN.         | MINIMUM                    |
| — — —       |              | WALL CLEANOUT  | CLG          | CEILING                                     | (N)          | NEW                        |
| — — —       |              | WALL CLEANOUT  | CO           | CLEANOUT                                    | OC           | ON CENTER                  |
| — — —       |              | WALL CLEANOUT  | COMP.        | COMPARTMENT                                 | OPER.        | OPERABLE                   |
| — — —       |              | WALL CLEANOUT  | CONC.        | CONCRETE                                    | PC, P.C.     | PLUMBING CONTRACTOR        |
| — — —       |              | WALL CLEANOUT  | CONN.        | CONNECT, CONNECTION                         | PLMB.        | PLUMBING                   |
| — — —       |              | WALL CLEANOUT  | CONTR.       | CONTRACTOR                                  | P.O.C.       | POINT OF CONNECTION        |
| — — —       |              | WALL CLEANOUT  | CONTR.       | CONTRACTOR                                  | PRESS.       | PRESSURE                   |
| — — —       |              | WALL CLEANOUT  | CONTR.       | CONTRACTOR                                  | PSI, PSI.    | POUNDS PER SQUARE INCH     |
| — — —       |              | WALL CLEANOUT  | CTE          | CONNECT TO EXISTING                         | P/T          | PRESSURE/TEMPERATURE       |
| — — —       |              | WALL CLEANOUT  | DEMO         | DEMOLITION                                  | REF.         | REFERENCE                  |
| — — —       |              | WALL CLEANOUT  | DIA.         | DIAMETER                                    | REQD.        | REQUIRED                   |
| — — —       |              | WALL CLEANOUT  | DIM.         | DIMENSION                                   | REV.         | REVISION                   |
| — — —       |              | WALL CLEANOUT  | DIR.         | DIRECT                                      | RHWS         | ROUND HEAD WOOD SCREWS     |
| — — —       |              | WALL CLEANOUT  | DN           | DOWN  | SAD          | SEE ARCHITECTURAL DRAWINGS |
| — — —       |              | WALL CLEANOUT  | DSA          | DIVISION OF THE STATE ARCHITECT             | SCD          | SEE CIVIL DRAWINGS         |
| — — —       |              | WALL CLEANOUT  | DWG          | DRAWING                                     | SCH 40, 80   | SCHEDULE 40 OR 80 PIPE     |
| — — —       |              | WALL CLEANOUT  | DWGS.        | DRAWINGS                                    | SD           | STORM DRAIN                |
| — — —       |              | WALL CLEANOUT  | (E)          | EXISTING                                    | SED          | SEE ELECTRICAL DRAWINGS    |
| — — —       |              | WALL CLEANOUT  | ELEC.        | ELECTRICAL                                  | S.F., SF     | SQUARE FEET                |
| — — —       |              | WALL CLEANOUT  | ELEV.        | ELEVATION                                   | SM           | SHEET METAL                |
| — — —       |              | WALL CLEANOUT  | EMBED.       | EMBEDMENT                                   | SMD          | SEE MECHANICAL DRAWINGS    |
| — — —       |              | WALL CLEANOUT  | EQ.          | EQUAL                                       | SOV          | SHUT-OFF VALVE             |
| — — —       |              | WALL CLEANOUT  | EST.         | ESTIMATED                                   | SS           | STAINLESS STEEL            |
| — — —       |              | WALL CLEANOUT  | EXIST.       | EXISTING                                    | SS           | SANITARY SEWER             |
| — — —       |              | WALL CLEANOUT  | FBPC         | FURNISHED BY PLUMBING CONTRACTOR            | SSD          | SEE STRUCTURAL DRAWINGS    |
| — — —       |              | WALL CLEANOUT  | FCO          | FLOOR CLEANOUT                              | SSMH         | SANITARY SEWER MANHOLE     |
| — — —       |              | WALL CLEANOUT  | FD           | FLOOR DRAIN                                 | TP           | TRAP PRIMER                |
| — — —       |              | WALL CLEANOUT  | FF, F.F.     | FINISHED FLOOR                              | T&P          | TEMPERATURE AND PRESSURE   |
| — — —       |              | WALL CLEANOUT  | F.H.         | FLAT HEAD                                   | TPC          | TRAP PRIMER CONNECTION     |
| — — —       |              | WALL CLEANOUT  | FIN.         | FINISHED                                    | TYF, TYP.    | TYPICAL                    |
| — — —       |              | WALL CLEANOUT  | F & I        | FURNISHED AND INSTALLED                     | UNO          | UNLESS OTHERWISE NOTED     |
| — — —       |              | WALL CLEANOUT  | FU           | FIXTURE UNITS                               | VF           | VERIFY IN FIELD            |
| — — —       |              | WALL CLEANOUT  | GA.          | GAUGE                                       | VTR          | VENT THROUGH ROOF          |
| — — —       |              | WALL CLEANOUT  | GC, G.C.     | GENERAL CONTRACTOR                          | WC           | WATER CLOSET               |
| — — —       |              | WALL CLEANOUT  |              |   | WC           | WATER COLUMN (PRESS.)      |
| — — —       |              | WALL CLEANOUT  |              |   | WCO          | WALL CLEANOUT              |
| — — —       |              | WALL CLEANOUT  |              |   | WH           | WATER HEATER               |
| — — —       |              | WALL CLEANOUT  |              |   | WOG          | WATER OIL GAS              |
| — — —       |              | WALL CLEANOUT  |              |   | WT.          | WEIGHT                     |



IDENTIFICATION STAMP  
DIVISION OF THE STATE ARCHITECT  
APPLICATION NUMBER 01-111618  
AC \_\_\_\_\_ FILE \_\_\_\_\_ BS \_\_\_\_\_  
DATE \_\_\_\_\_

CALIFORNIA STATE FIRE MARSHAL  
APPROVED  
APPROVAL OF THIS PLAN DOES NOT AUTHORIZE OR APPROVE ANY CHANGE OR DEVIATION FROM APPLICABLE REGULATIONS. FINAL APPROVAL IS SUBJECT TO BUILDING OFFICIALS. ONE SET OF APPROVED PLANS SHALL BE AVAILABLE ON THE PROJECT SITE AT ALL TIMES.  
REVISIONS BY: \_\_\_\_\_ DATE: \_\_\_\_\_

**CAÑADA COLLEGE**  
Electrical Infrastructure Replacement Project  
4200 Farm Hill Blvd  
Redwood City, CA 94061

RECORD SET

SHEET TITLE  
**PLUMBING LEGEND AND NOTES**


| NO. | DATE | DESCRIPTION |
|-----|------|-------------|
|     |      |             |
|     |      |             |
|     |      |             |
|     |      |             |

DATE June 15, 2012  
DRAWN VT/AL  
CHECKED MW  
SCALE NO SCALE  
JOB NO. 2921.01

SHEET NUMBER  
**PO.1**


**PLUMBING LIST OF DRAWINGS**

|      |  |
|------|--|
| P0.1 | PLUMBING LEGEND, SCHEDULE, DETAILS AND NOTES |
| P1.1 | PLUMBING PARTIAL FLOOR PLANS - BUILDING 3    |

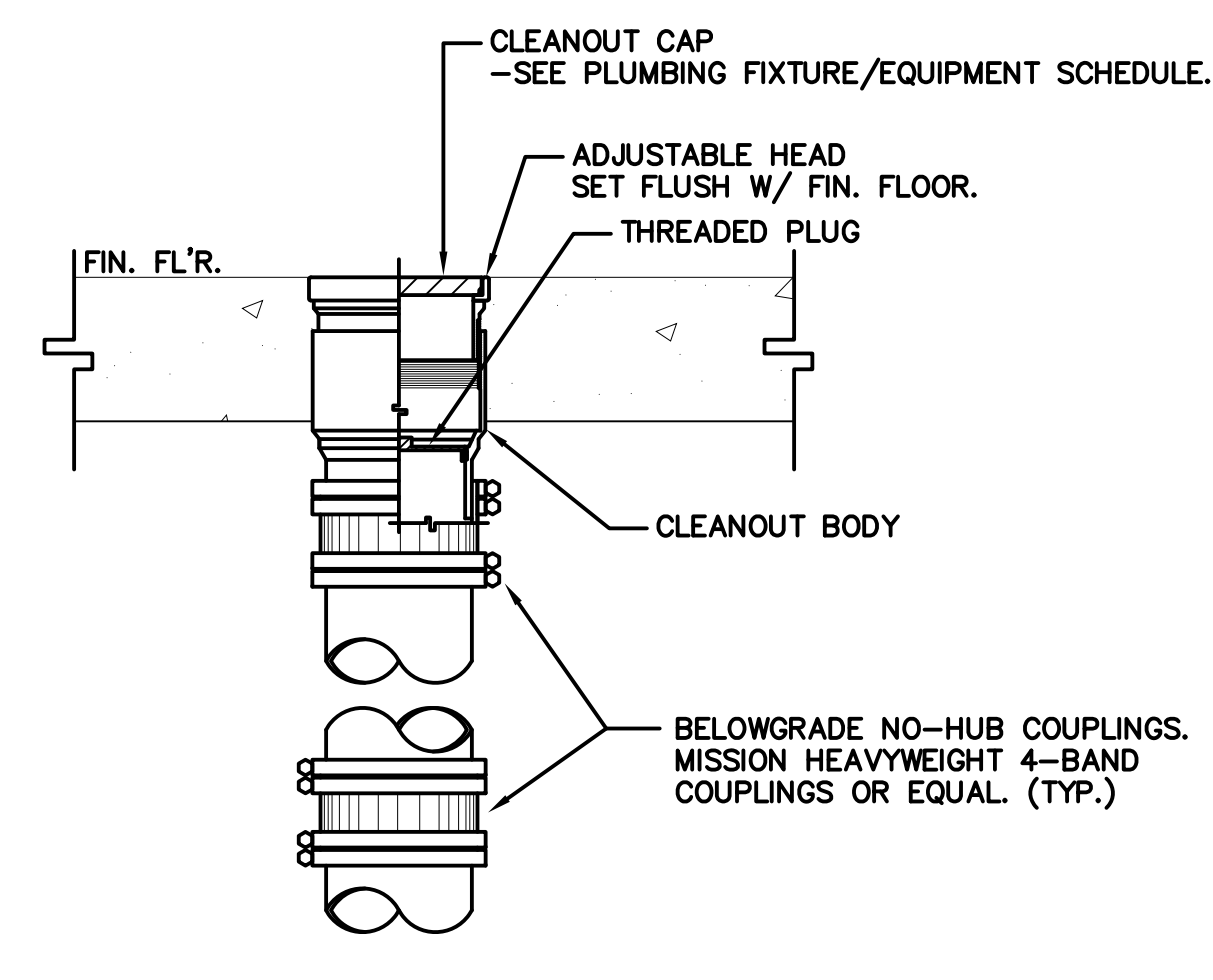

**FLUSH FLOOR CLEANOUT DETAIL**  
NO SCALE

- NOTES:
1. AT LOCATIONS WHERE CLEANOUT OCCURS MIDWAY IN PIPING RUN, INSTALL TWO-WAY CLEANOUT FITTING IN PIPING RUN BELOW.
  2. PROVIDE UNDERDECK CLAMP AND ROOF SUMP RECEIVER AT DECK LOCATIONS.

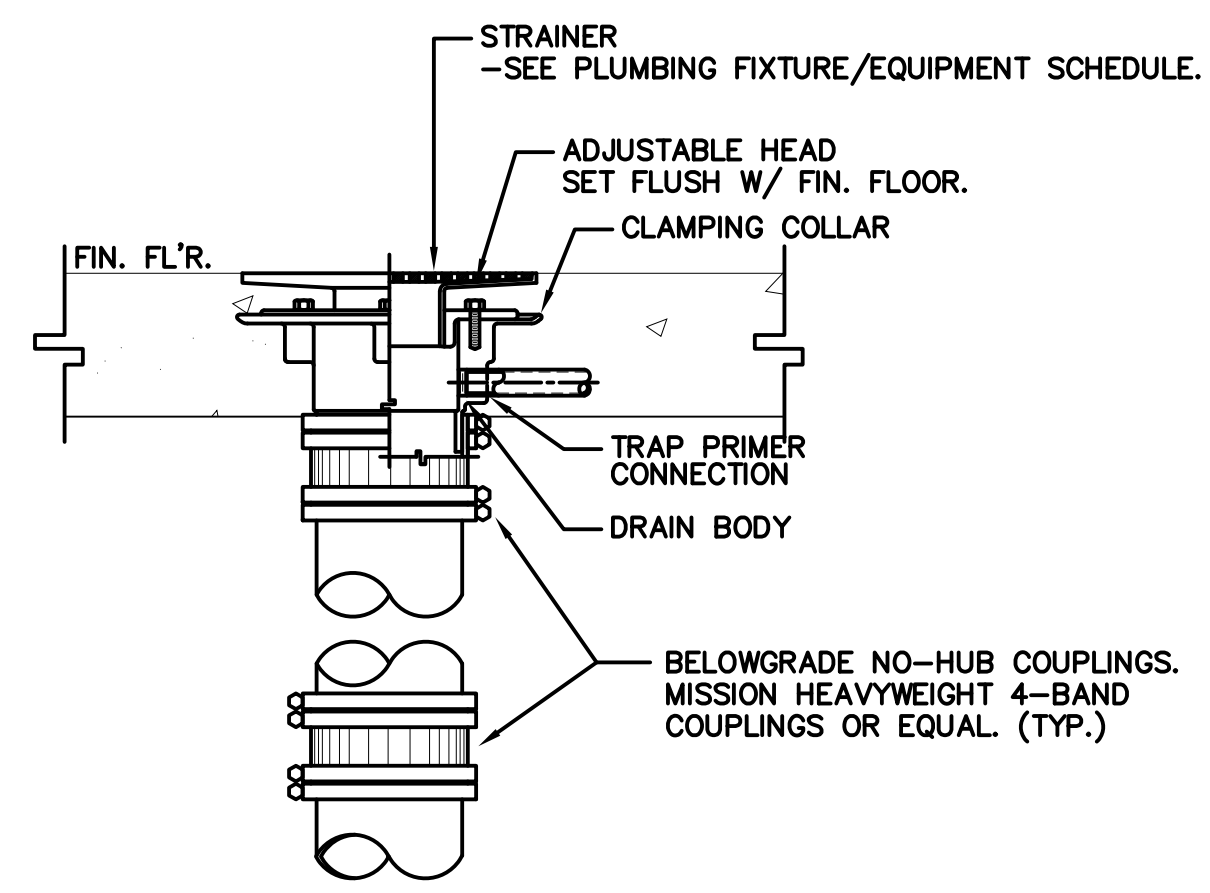

**FLOOR DRAIN DETAIL**  
NO SCALE

- NOTES:
1. AT LOCATIONS WHERE CLEANOUT OCCURS MIDWAY IN PIPING RUN, INSTALL TWO-WAY CLEANOUT FITTING IN PIPING RUN BELOW.
  2. PROVIDE UNDERDECK CLAMP AND ROOF SUMP RECEIVER AT DECK LOCATIONS.

**PLUMBING FIXTURE/EQUIPMENT SCHEDULE**

| ITEM | DESCRIPTION    | SD                | V | CW | SPECIFICATIONS AND REMARKS  |
|------|----------------|-------------------|---|----|---|
| FD   | FLOOR DRAIN    | 3"                | - | -  | ZURN ZN-415-P-VP NICKEL BRONZE FLOOR DRAIN WITH INTEGRAL MEMBRANE CLAMP AND ADJUSTABLE COLLAR. PROVIDE VANDALPROOF SECURED TOP. 6" DIA., "TYPE B" STRAINER. VERIFY THAT MOUNTING ARRANGEMENT MEETS THE REQUIREMENTS OF THE FLOOR IN WHICH IT IS TO BE INSTALLED. SEE PLUMBING DETAILS FOR REQUIREMENTS. |
| FCO  | FLOOR CLEANOUT | LINE SIZE 4" MAX. | - | -  | ZURN ZN-1400-BP-KC NICKEL BRONZE CLEANOUT WITH BRONZE PLUG, ANCHOR FLANGE AND CLAMPING COLLAR TO SECURE BUILDING WATERPROOF MEMBRANE. SEE PLUMBING DETAILS FOR REQUIREMENTS.  |