
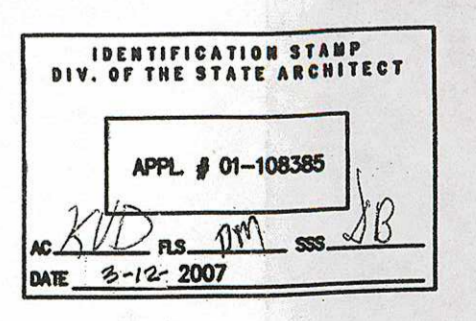


1 FIRST FLOOR POWER AND SIGNAL PLAN
1/8" = 1'-0"

SHEET NOTES

- ◆ RECEPTACLE FOR PROJECTOR. MOUNT ON CEILING 15'-0" FROM SCREEN. PROVIDE SINGLE GANG, 4" SQUARE JUNCTION BOX FOR TELECOM INTERFACE.
- ◆ SINGLE GANG, 4" SQUARE BOX FOR WIRELESS ACCESS POINT WIRING. REFER TO TELECOM DRAWINGS FOR EXACT LOCATION AND SIZE.
- ◆ TWO-GANG JUNCTION BOX MOUNTED +18" AFF FOR INSTRUCTIONAL PATHWAY. PROVIDE 2" C UP TO 6" ABOVE ACCESSIBLE CEILING SPACE. REFER TO TELECOM DWGS. FOR EXACT LOCATION AND SIZE.
- ◆ (2) 4" SLEEVES. REFER TO TELECOM DRAWINGS FOR EXACT LOCATION AND SIZE.
- ◆ (1) 2" SLEEVE. REFER TO TELECOM DRAWINGS FOR EXACT LOCATION AND SIZE.
- ◆ (2) 4" C UP TO THIRD FLOOR IT ROOM, 7316. REFER TO TELECOM DRAWINGS FOR EXACT LOCATION AND SIZE.
- ◆ (2) 4" C UP TO SECOND FLOOR CEILING SPACE. REFER TO TELECOM DRAWINGS FOR EXACT LOCATION AND SIZE.
- ◆ CIRCUIT SHOWN IS FOR POWER TO LOCK POWER SUPPLY. REFER TO SECURITY DRAWING, SY4.01 FOR EXACT CIRCUIT CONFIGURATION.
- ◆ TELECOM GROUND BUSBAR.
- ◆ ALL 120V. CIRCUITS FOR MISC. RECEPTACLES, EQUIPMENT, ETC. SHALL BE CONNECTED FROM PANEL "7R1C" U.O.N.
- ◆ ALL 120V. CIRCUITS FOR MISC. RECEPTACLES, EQUIPMENT, ETC. SHALL BE CONNECTED FROM PANEL "7R1B" U.O.N.
- ◆ ALL 120V. CIRCUITS FOR MISC. RECEPTACLES, EQUIPMENT, ETC. SHALL BE CONNECTED FROM PANEL "7R1A" U.O.N.
- ◆ ALL 480V/3Ø CIRCUITS FOR MECHANICAL EQUIPMENTS ETC. SHALL BE CONNECTED FROM "MOCA".
- ◆ JUNCTION BOX FOR CONNECTION OF DISPLAY LIGHTS.
- ◆ IN ADDITION TO REQUIRED BRANCH CIRCUIT CONDUITS, PROVIDE 4-3/4" C.O W/PULL STRING TO ACCESSIBLE CEILING. ALSO SEE 1/ES.02.
- ◆ QUAD RECEPTACLE FOR POWER TO PORTABLE ASSISTIVE LISTENING DEVICES.
- ◆ CIRCUIT SHOWN IS FOR POWER TO QUAD RECEPTACLE, LOW VOLTAGE TRANSFORMER AND DEVICE POWER SUPPLY. REFER TO SECURITY DRAWING, SY4.01 FOR CIRCUIT CONFIGURATION.

AS-BUILT

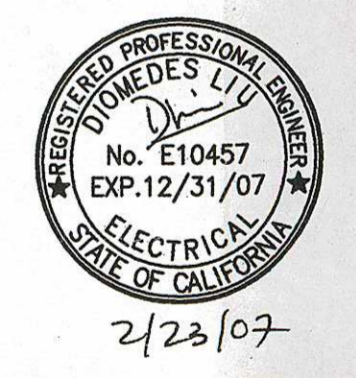

02.27.07	DSA BACK CHECK
11.02.06	DSA SUBMITTAL
10.13.06	75% CD
09.12.06	40% PROGRESS
REV.	DATE

key plan

1st Floor
STEINBERG ARCHITECTS

project no: 06015 date: 02.27.07
drawn by: MAMP checked by: VB
scale: 1/8" = 1'-0"

FIRST FLOOR POWER AND SIGNAL PLAN