


NOTES  
 1. FOR LEGEND, DETAILS, ETC. SEE SHEET P-1  
 2. FOR NOTES RELATING TO PLUMBING, SEE SHEET P-1

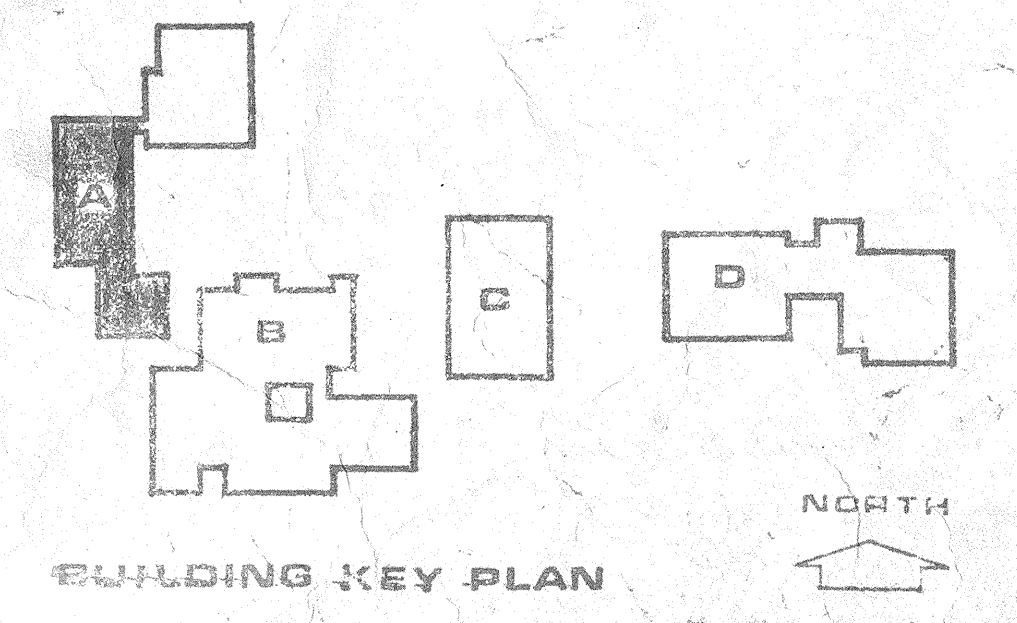

AS BUILT DRAWING  
 HARRY LEE HIGGINS  
 DATE 12-7-67

AS BUILT