


PROJECT  
RECORD SET

BUILDING 4  
SKYLINE COLLEGE


SAN MATEO COUNTY  
COMMUNITY COLLEGE  
DISTRICT

CIP2 DESIGN-BUILD  
PROJECT  
BUILDING 4

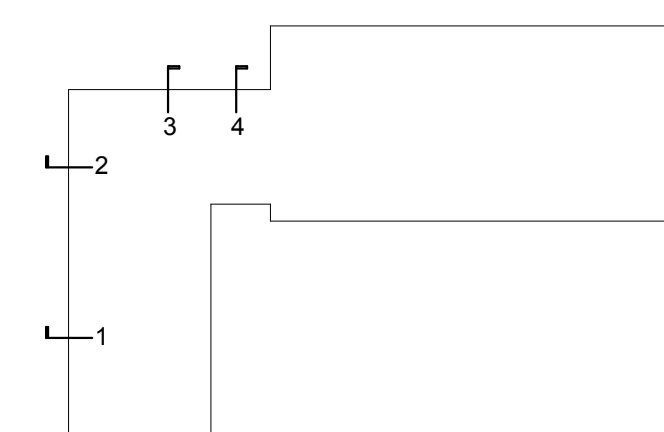


PROJECT NO.: 07012.00 DRAWN BY: MC  
DATE: 06/30/08 CHECKED BY: LG  
SCALE: As indicated


SHEET TITLE:  
WALL SECTIONS

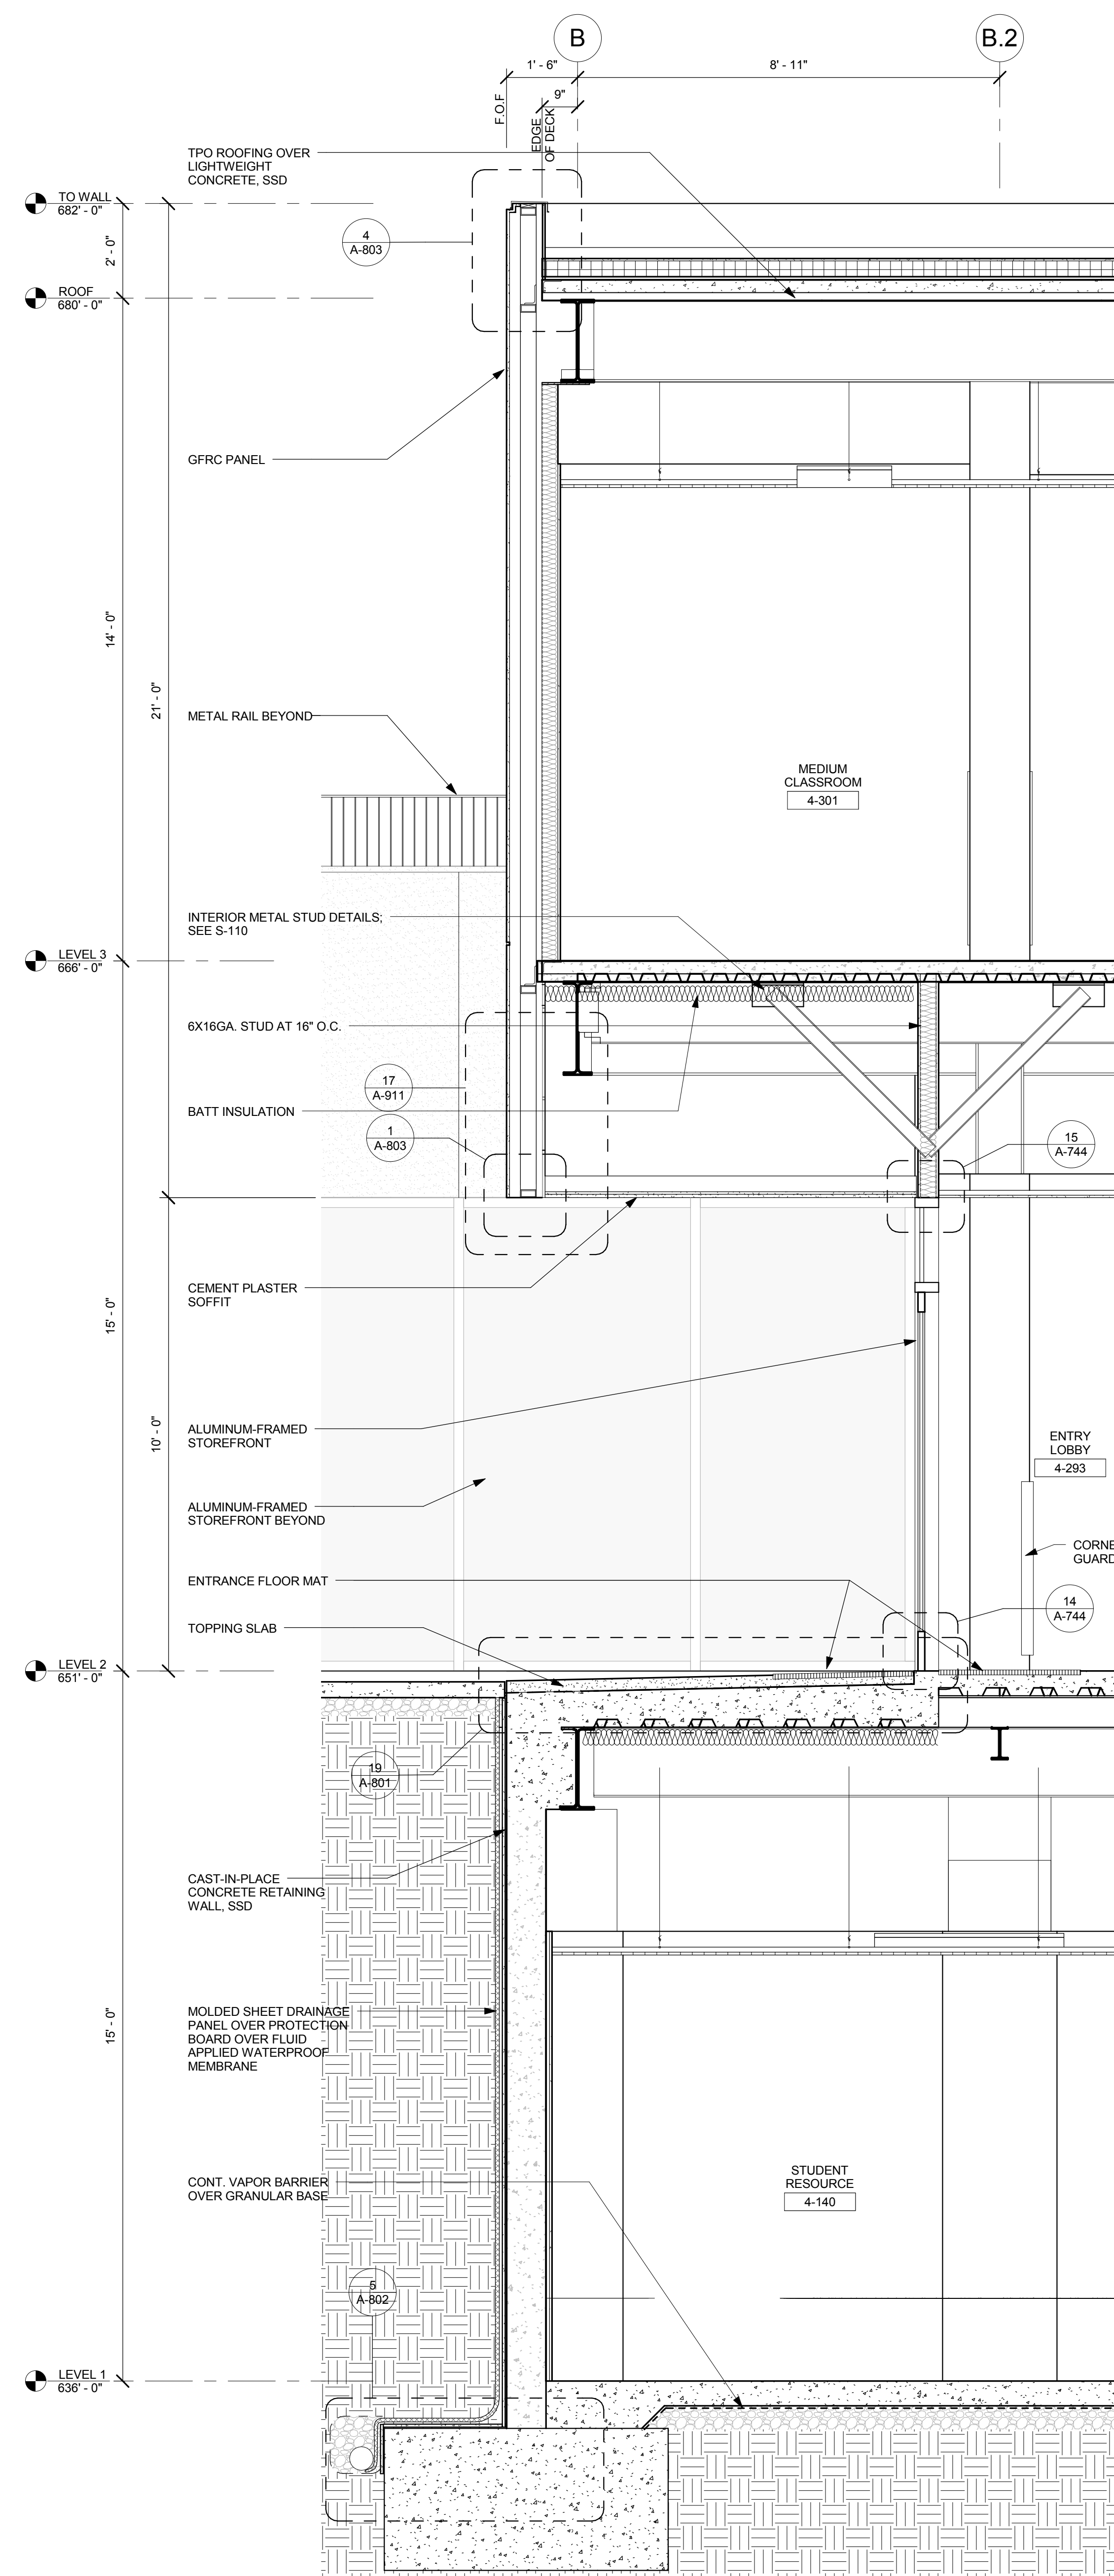


**4** SECTION BETWEEN 4/5  
1/2" = 1'-0"

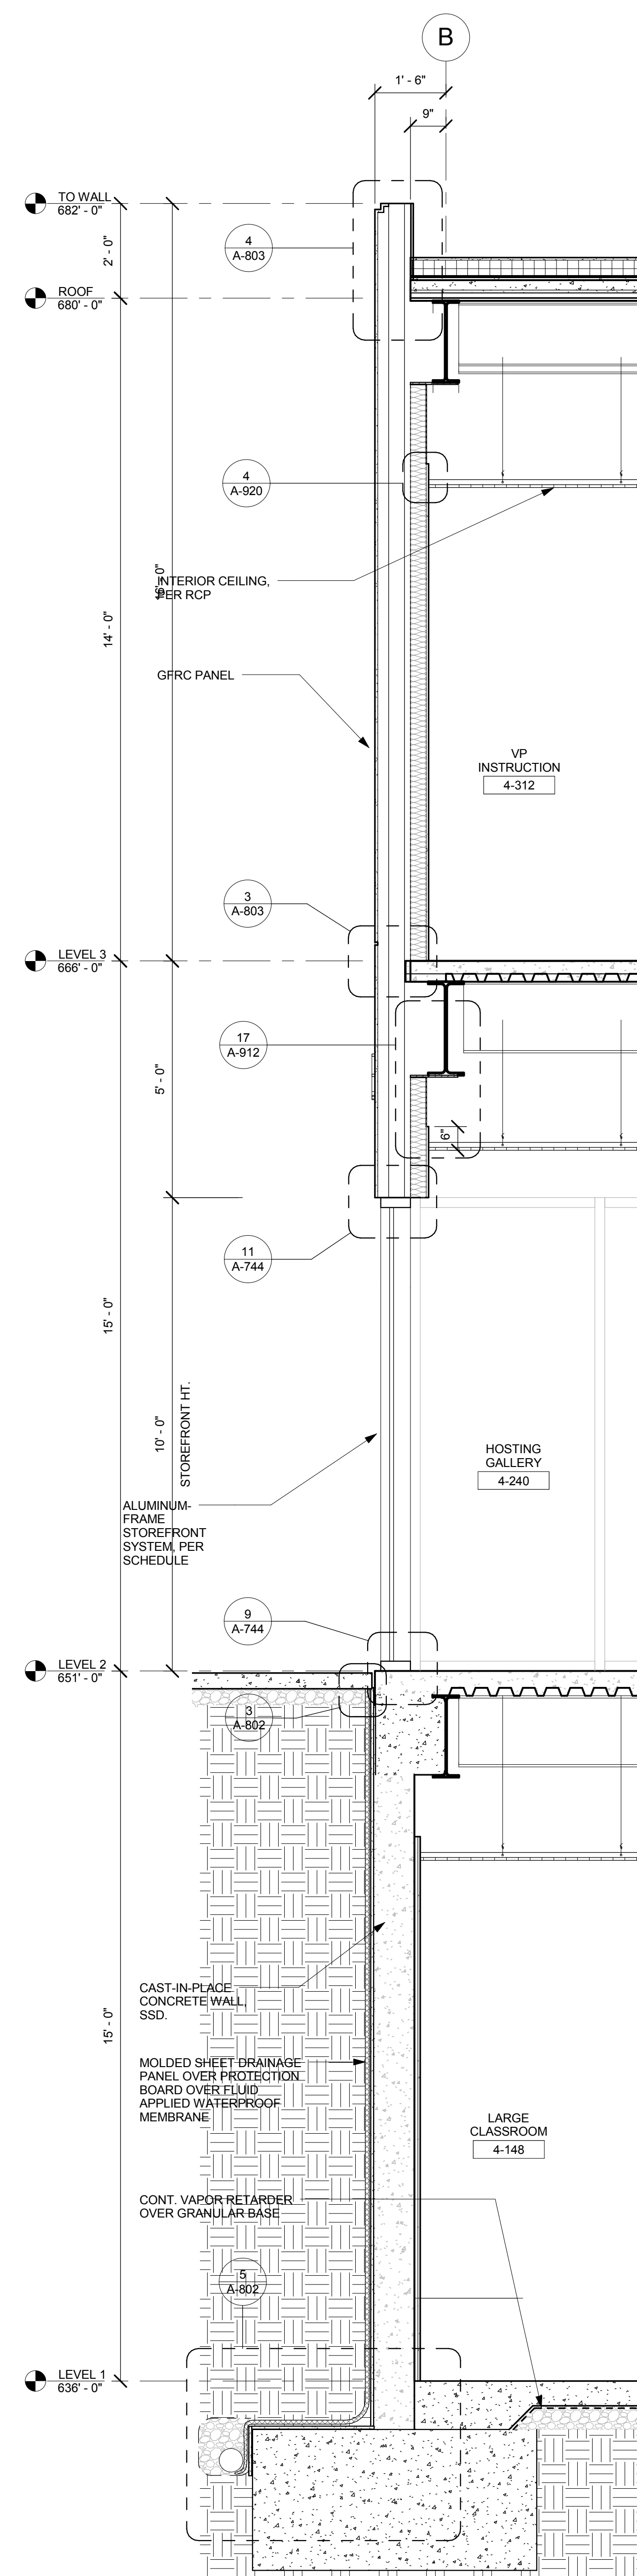

**3** WALL SECTION AT LINE B - BTWN 3 & 4  
1/2" = 1'-0"

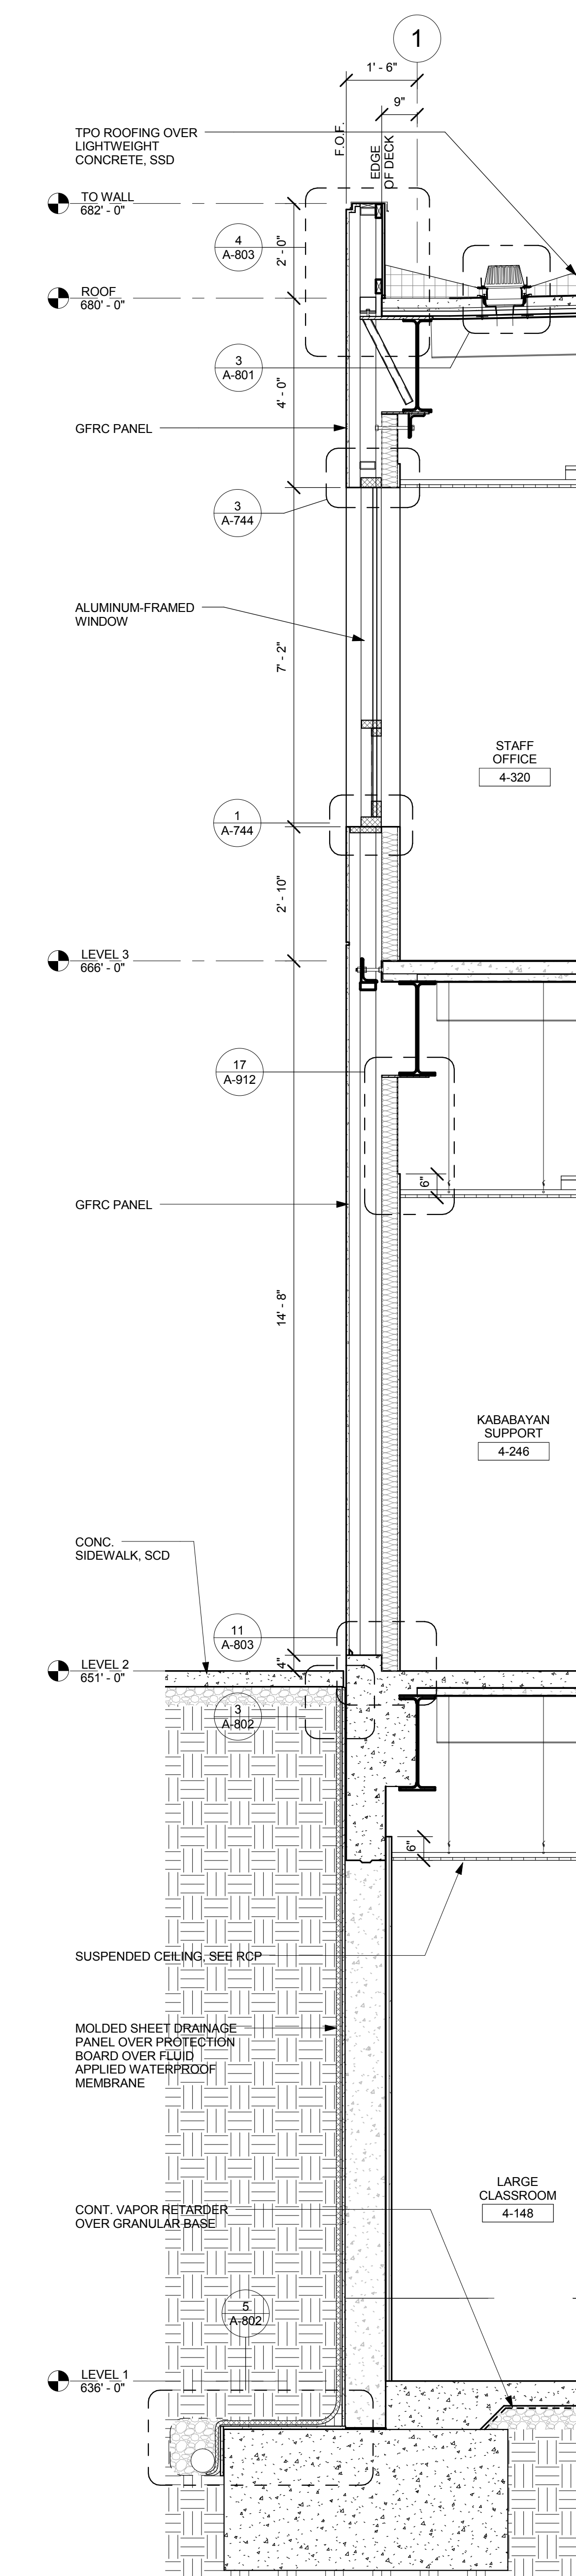

**2** SECTION BETWEEN B/C.5  
1/2" = 1'-0"

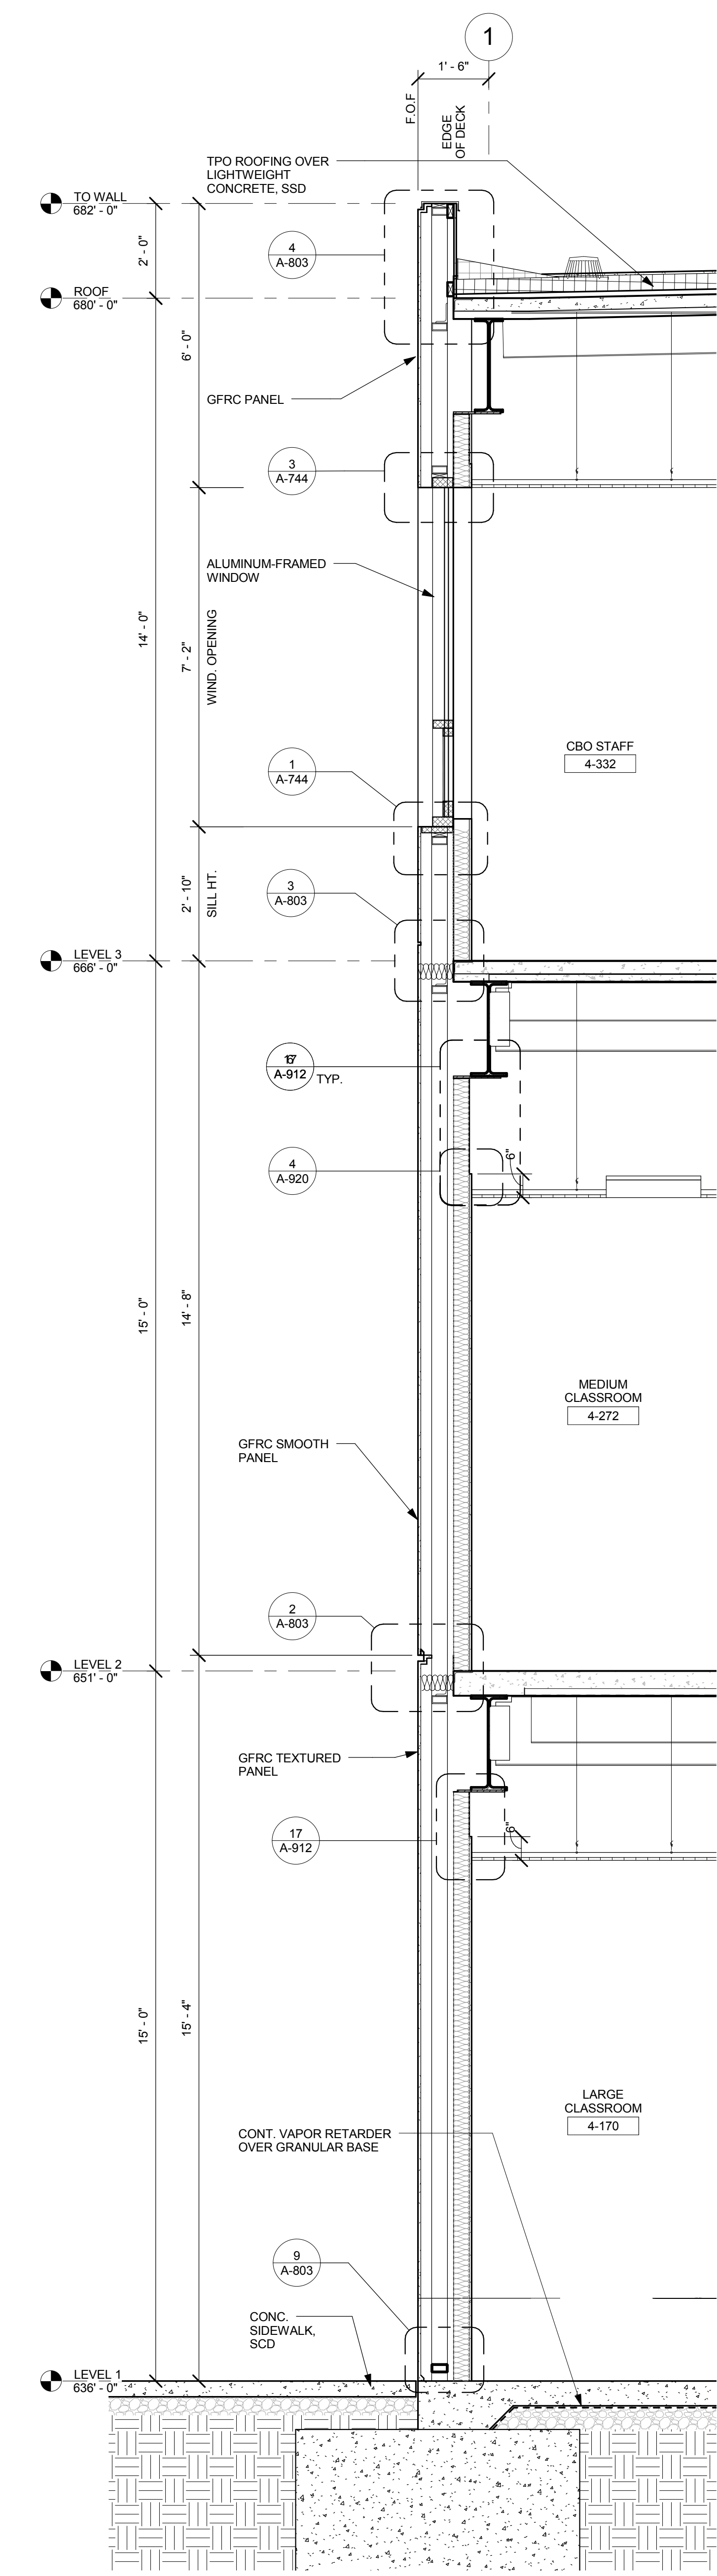

**1** SECTION BETWEEN E/F  
1/2" = 1'-0"