

PROJECT  
RECORD SET

BUILDING 4  
SKYLINE COLLEGE

SAN MATEO COUNTY  
COMMUNITY COLLEGE  
DISTRICT


CIP2 DESIGN-BUILD  
PROJECT  
BUILDING 4

PROJECT NO.: 07012.00 DRAWN BY: BC  
DATE: 01/26/09 CHECKED BY: LG  
SCALE: 1/2" = 1'-0"


SHEET TITLE:  
SEISMIC JOINT SECTIONS

SHEET NO.


A-852

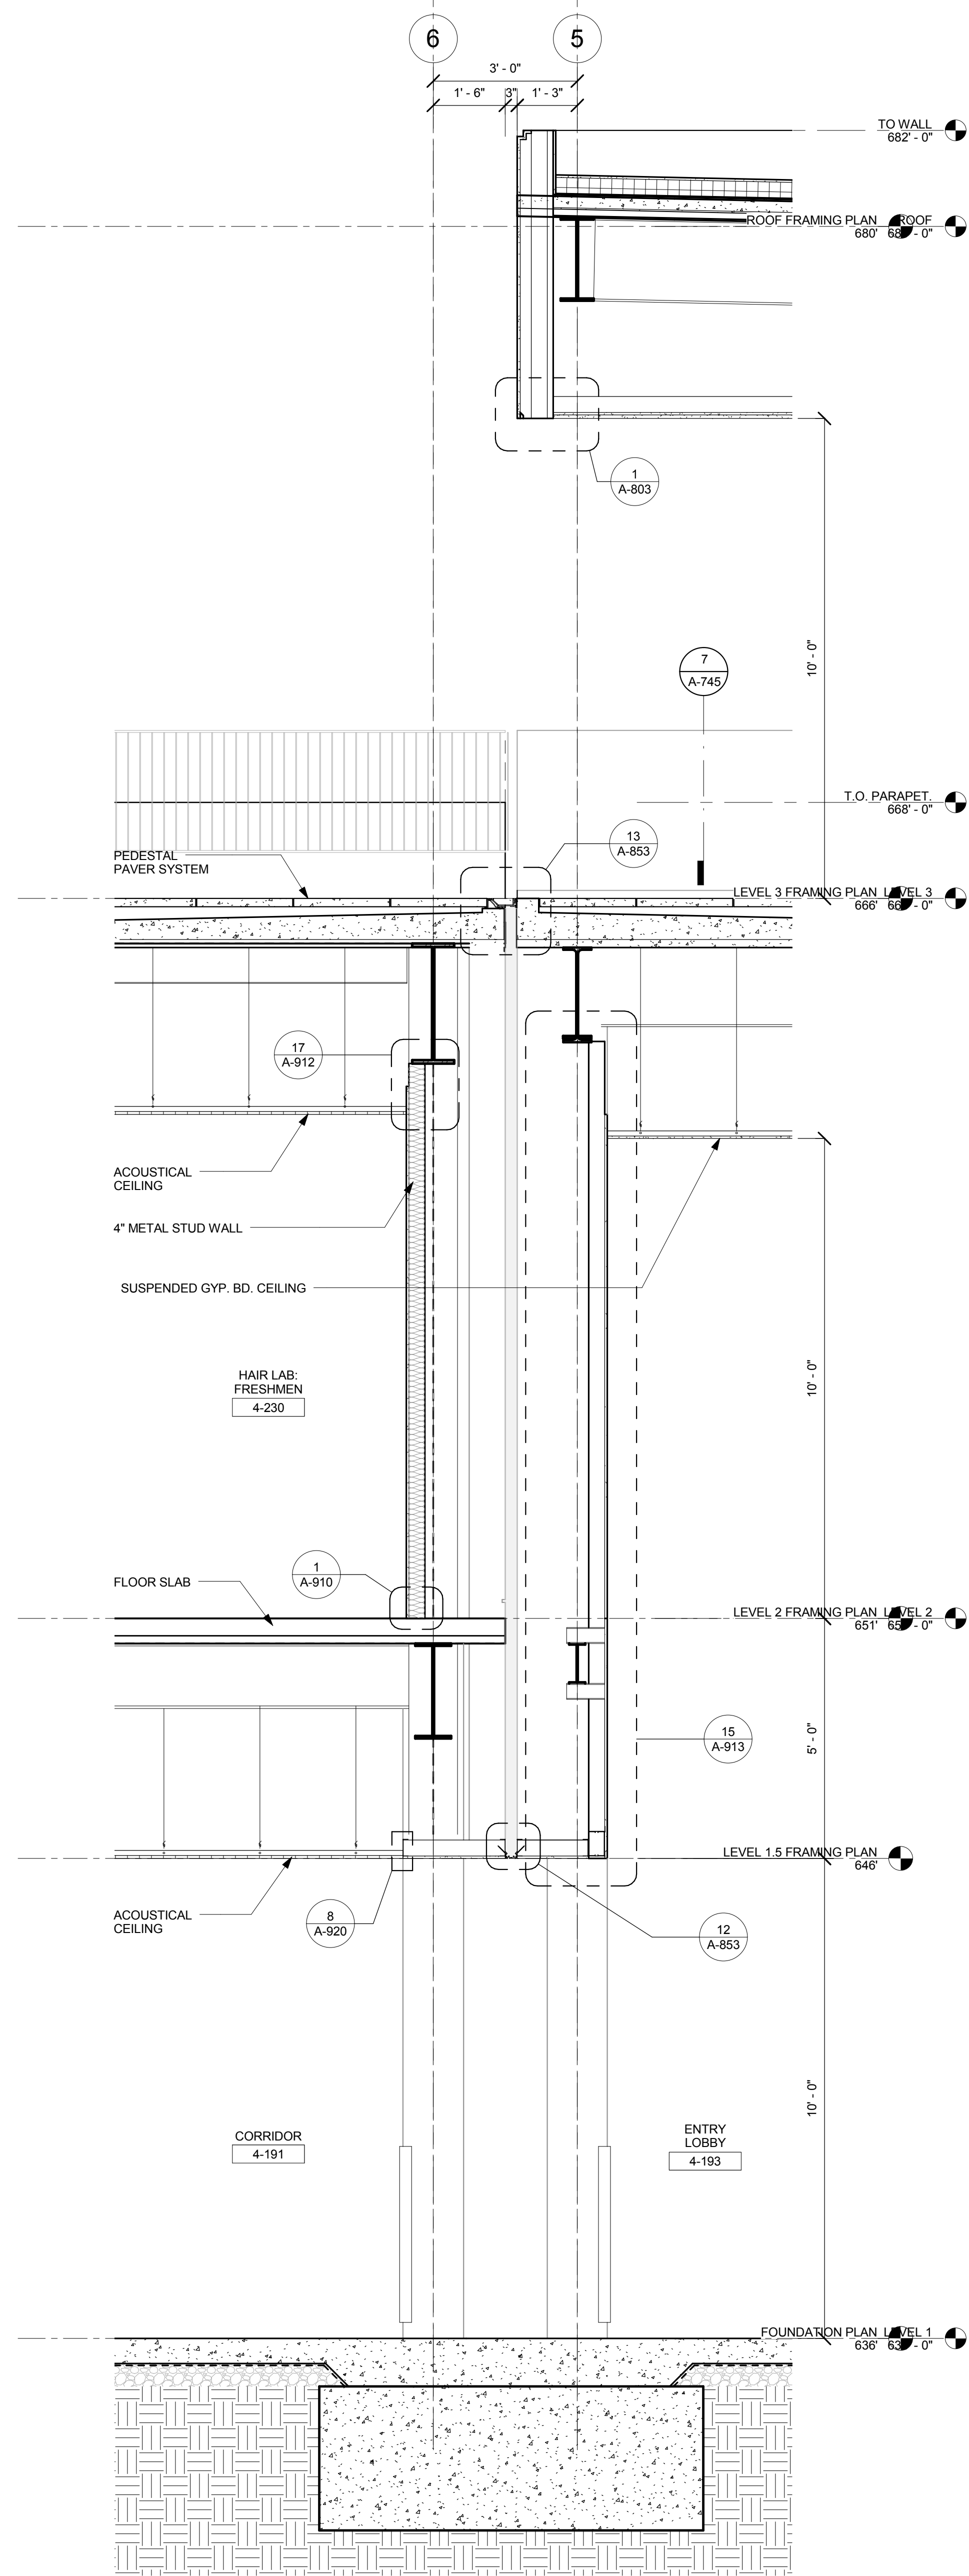

3 WALL SECTION BTWN C.6&C.8  
1/2" = 1'-0"

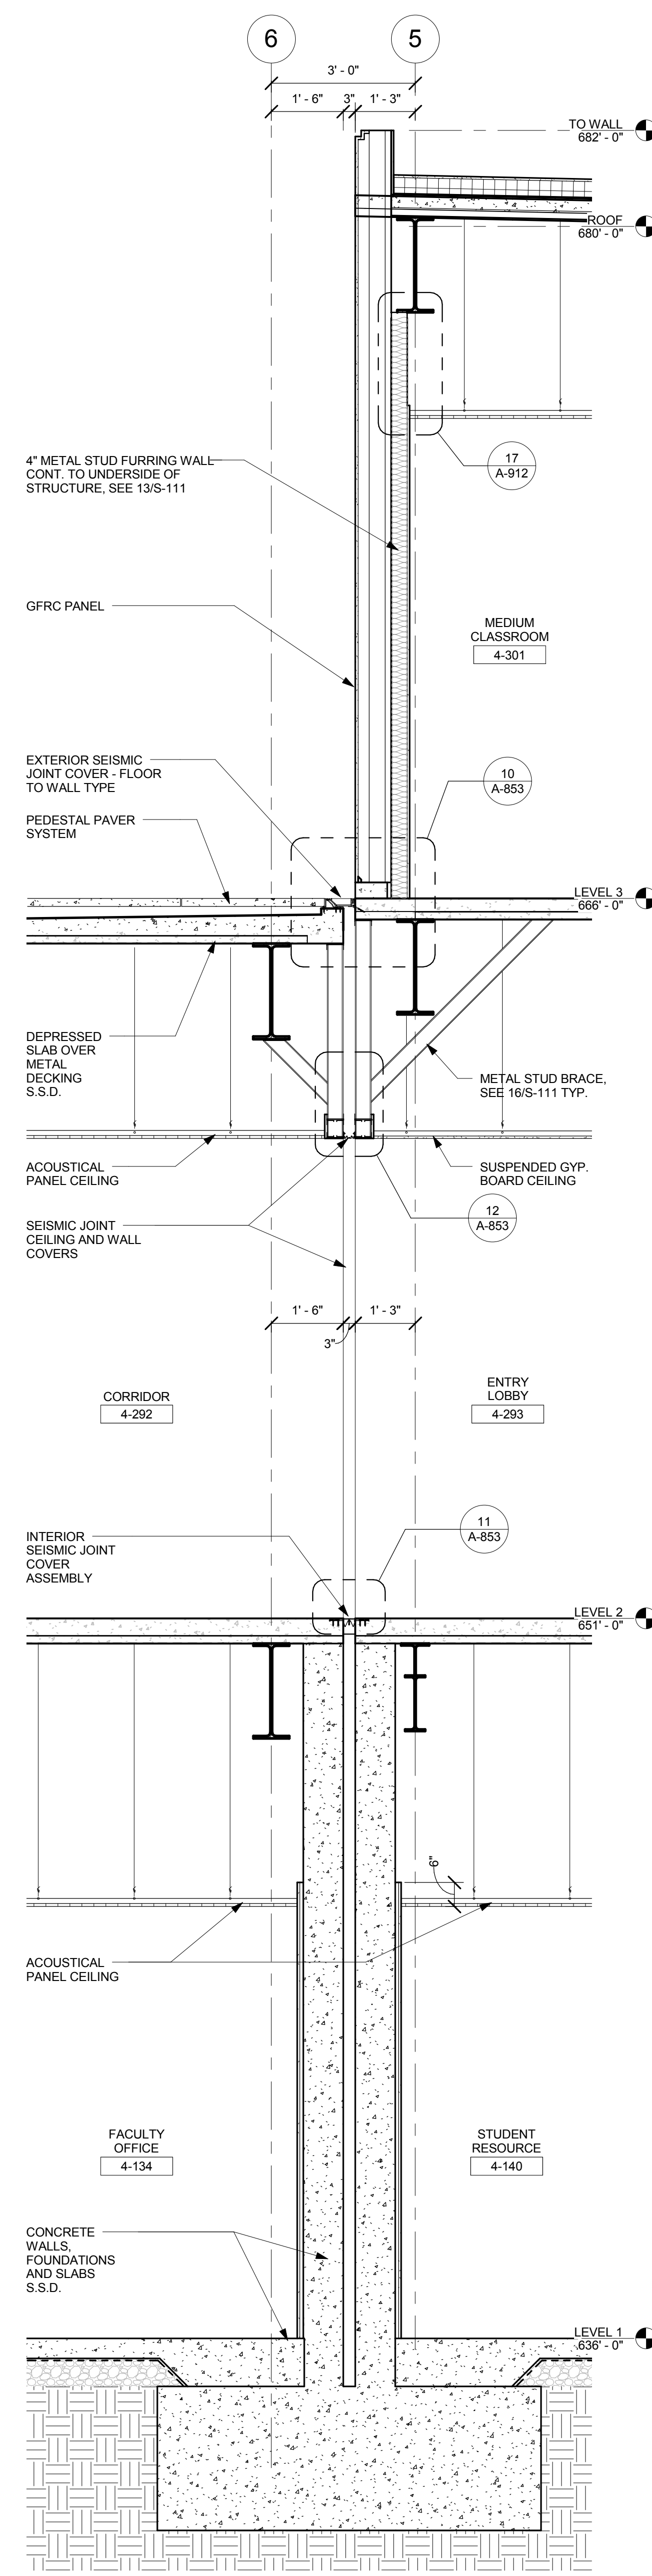

2 WALL SECTION BTWN B.2 & C  
1/2" = 1'-0"

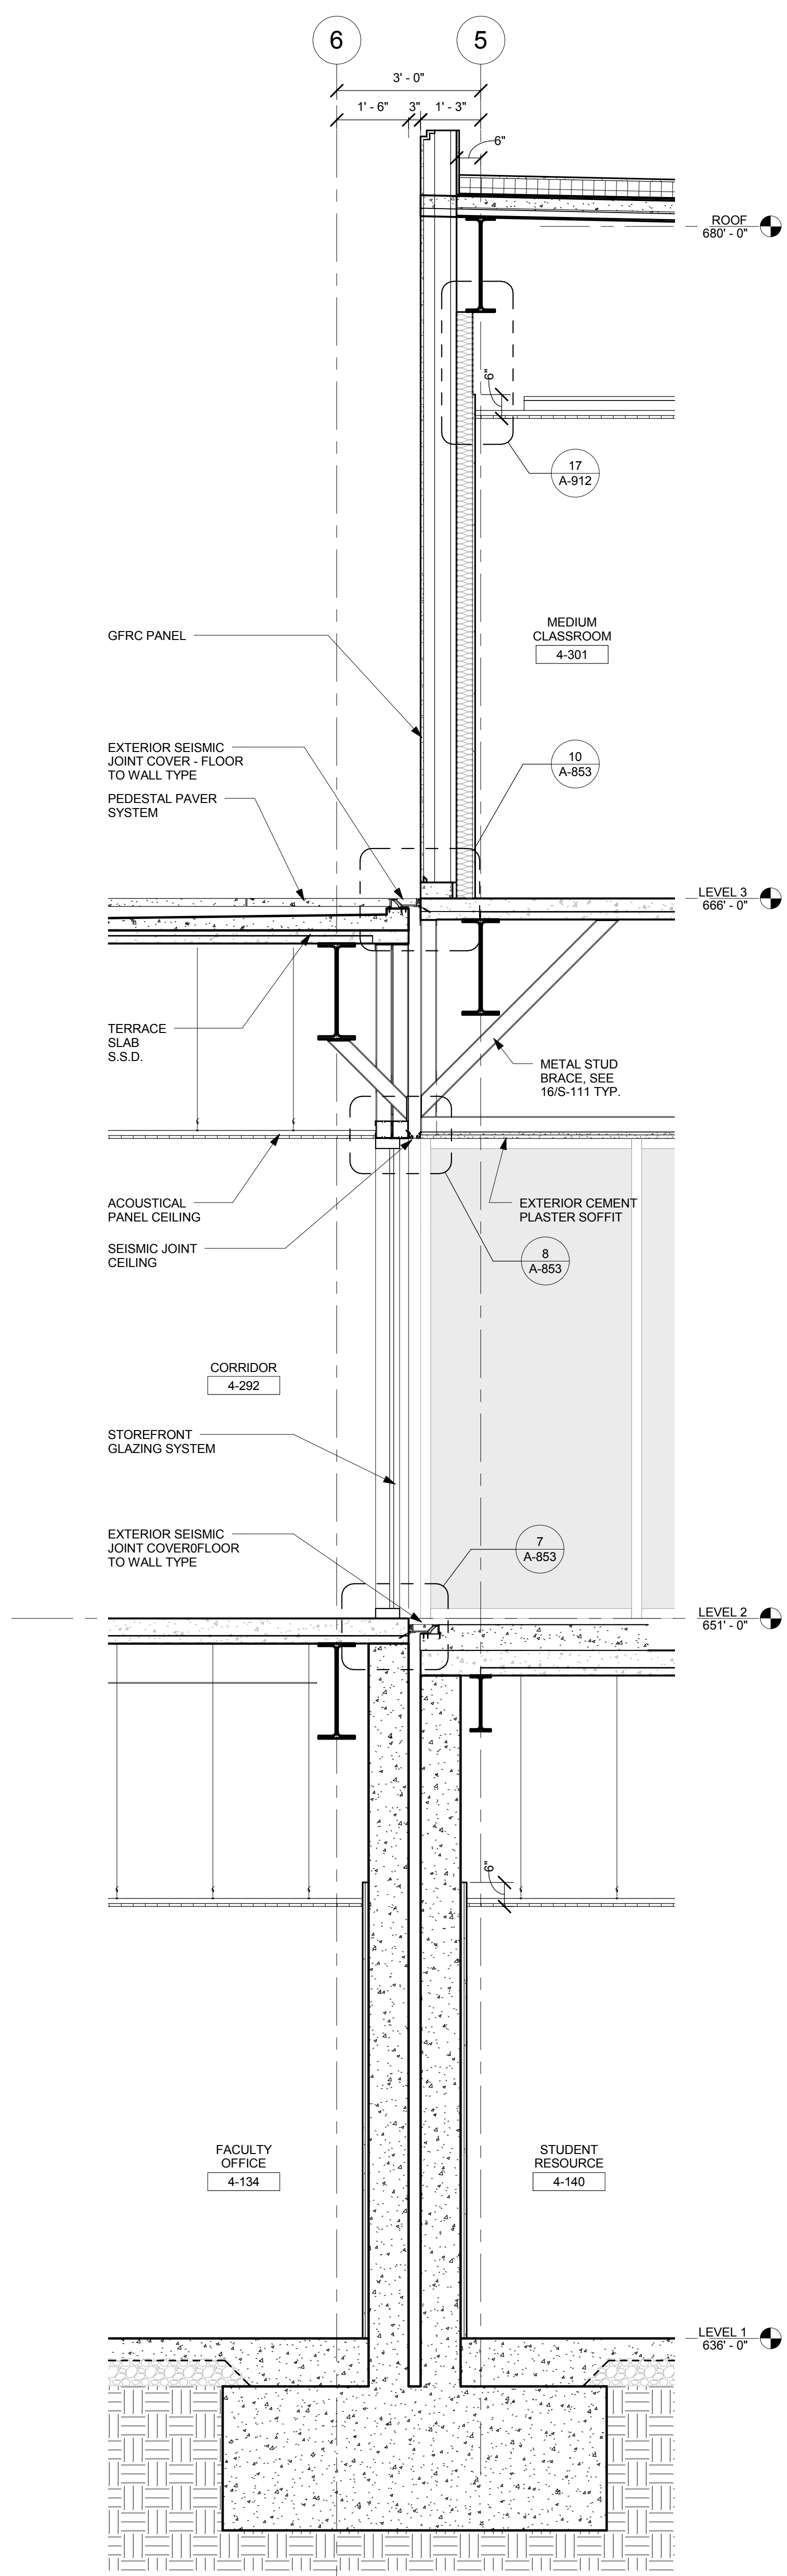

1 WALL SECTION BTWN A&B  
1/2" = 1'-0"