


CABLE SCHEDULE ACAMS			
TYPE	DESCRIPTION	MANUFACTURER	PART #
A	102' RISEMATE EL. EPT ON IS-5078C-10	SELISUN	65004E
B	102' RISEMATE AC. BELAY S. AUM. RS	SELISUN	65004E
C	222' RISEMATE DC. BELAY S. AUM. RS	SELISUN	65004E
E	222' RISEMATE DC. BELAY S. AUM. RS	SELISUN	65004E

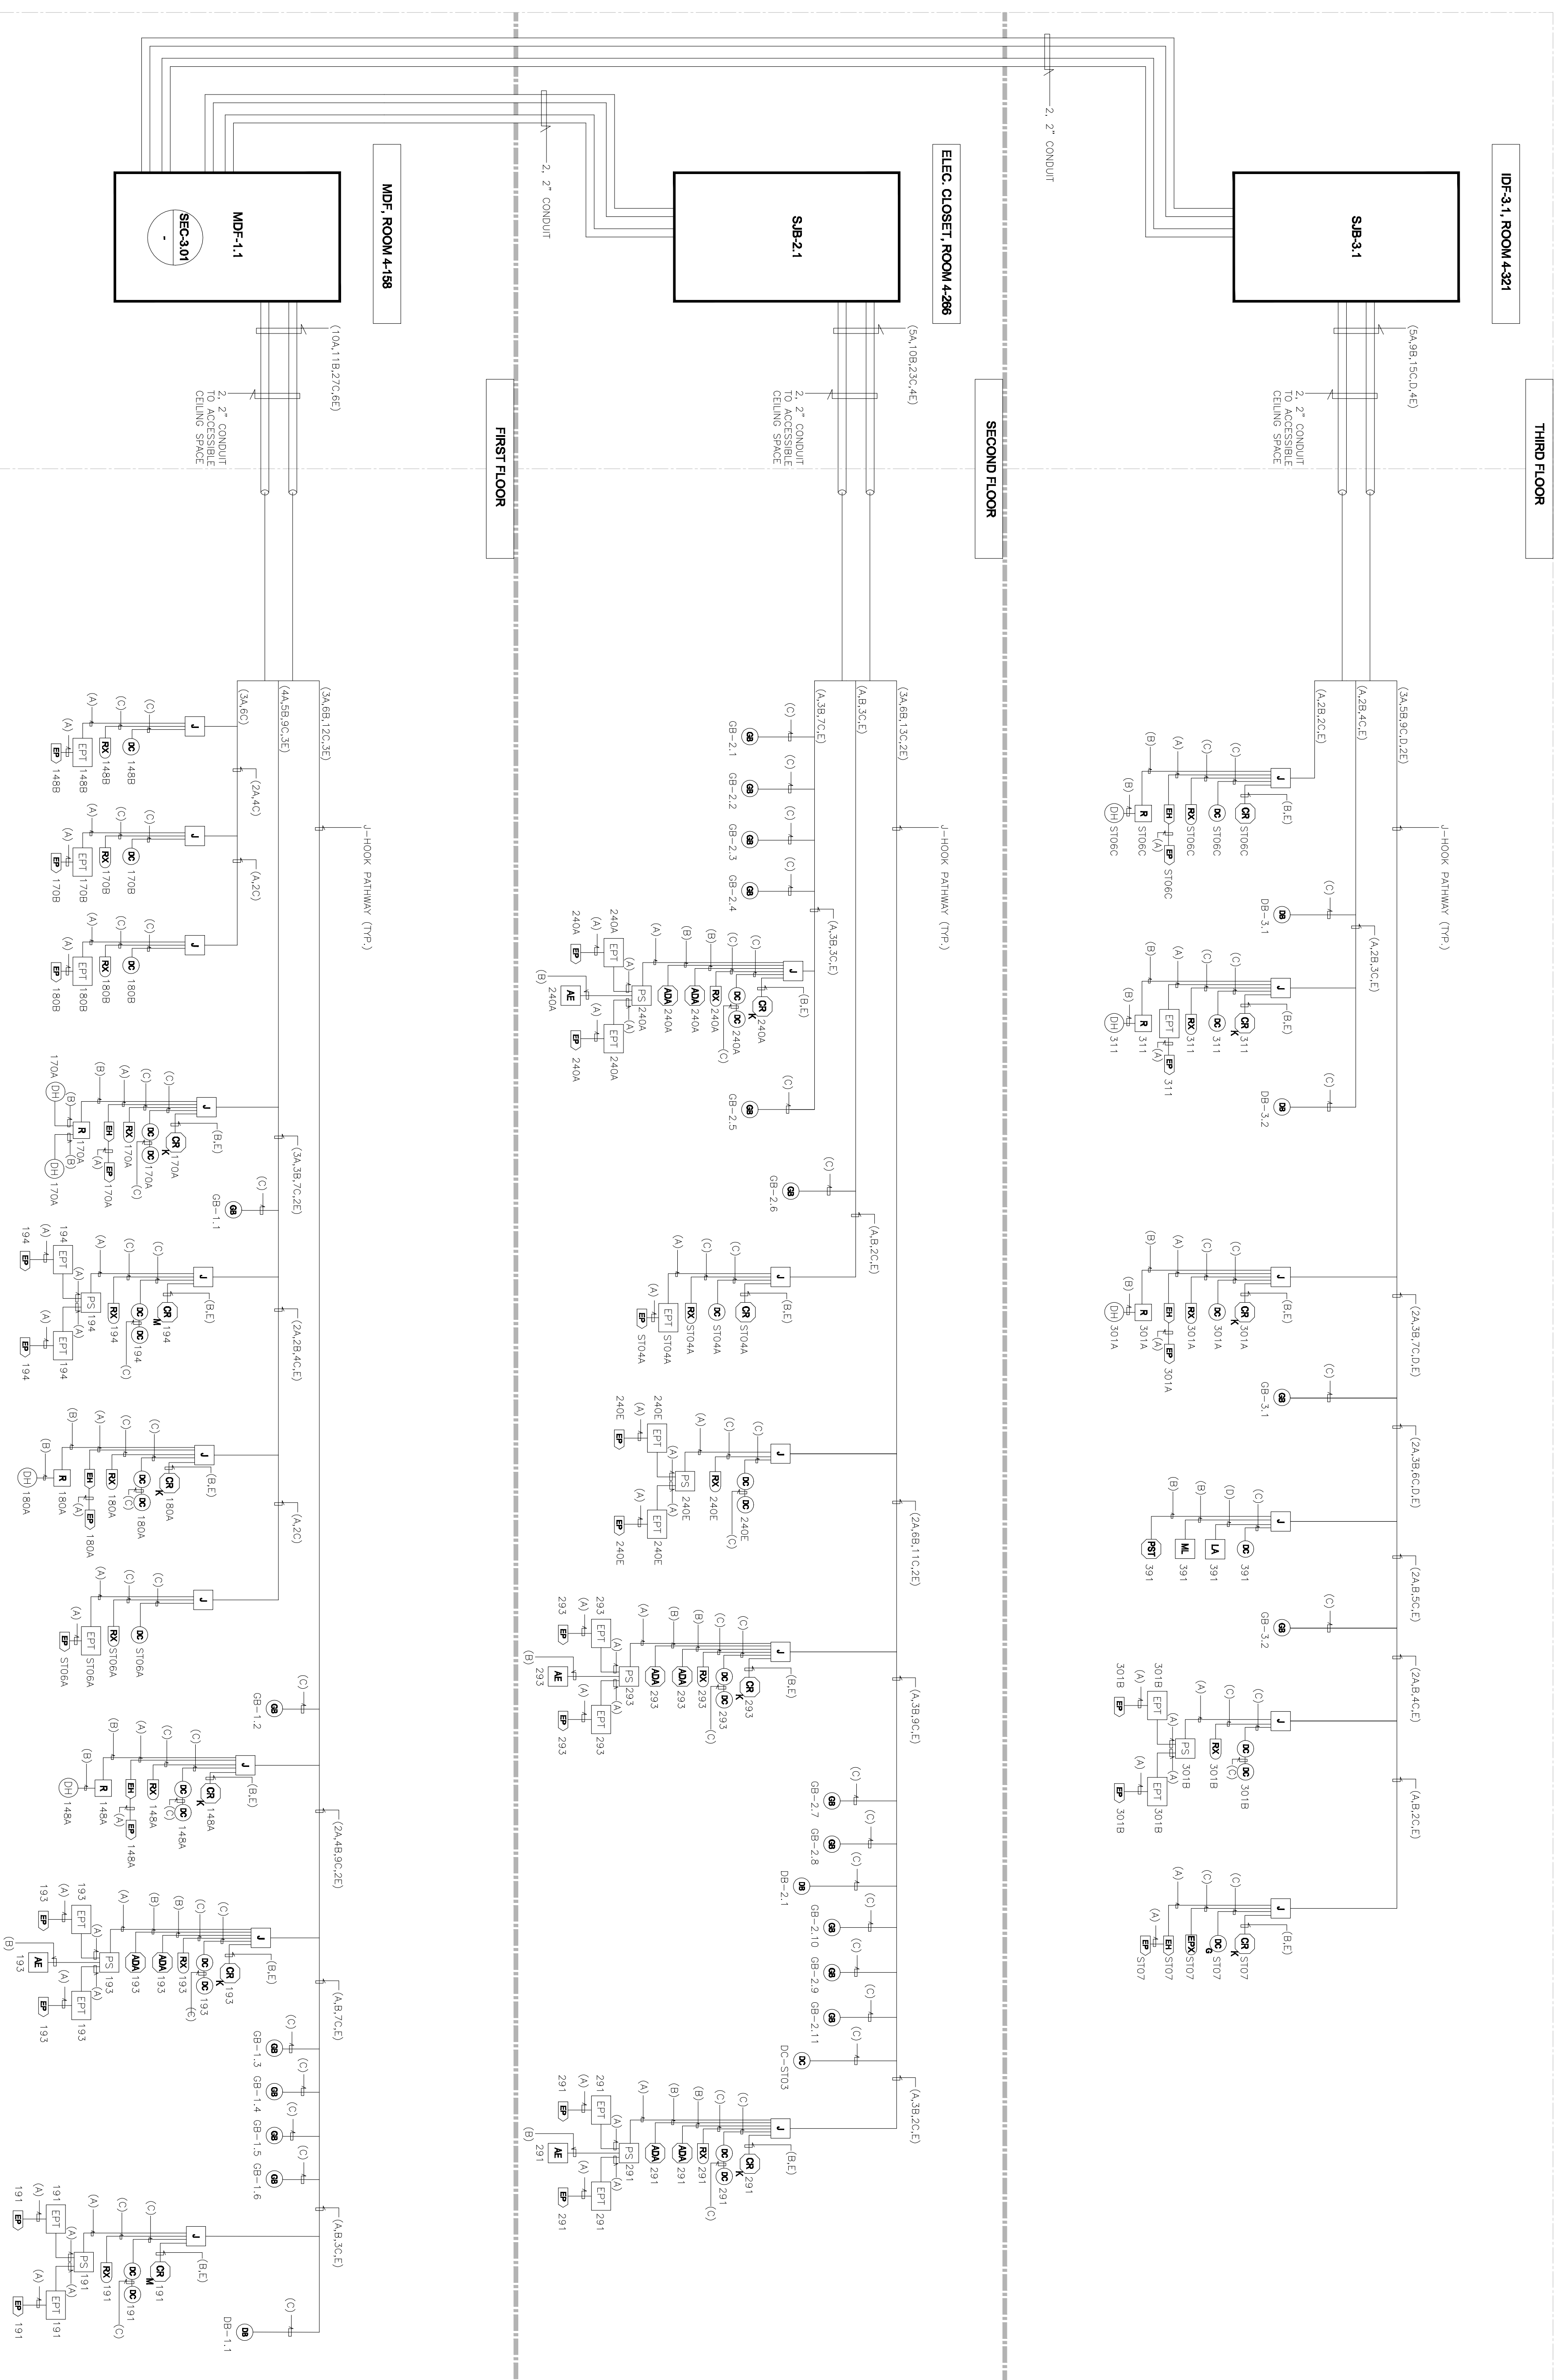

1 ACAMS RISER DIAGRAM

SCALE: N.T.S.

NETVERSANT

Inspiring Technology Solutions

NO.	DESCRIPTION	DATE
1	10% SCHEMATIC DESIGN SUBMITTAL	04/08/08
2	50% DESIGN DEVELOPMENT SUBMITTAL	06/18/08
3	100% DESIGN DEVELOPMENT SUBMITTAL	07/28/08
4	DESIGN DEVELOPMENT INQUIRY	08/28/08
5	PROBING FOR DESIGN INQUIRY	09/28/08
6	PROBING FOR DESIGN INQUIRY	10/28/08
7	DESIGN DEVELOPMENT INQUIRY	11/18/08
8	DESIGN DEVELOPMENT INQUIRY	12/18/08
9	DESIGN DEVELOPMENT INQUIRY	01/18/09
10	DESIGN DEVELOPMENT INQUIRY	02/18/09
11	DESIGN DEVELOPMENT INQUIRY	03/18/09
12	DESIGN DEVELOPMENT INQUIRY	04/18/09
13	DESIGN DEVELOPMENT INQUIRY	05/18/09

PROJECT RECORD SET

SKYLINE COLLEGE CIP2 DESIGN-BUILD BUILDING 4N

PROJECT NO.	070720	DESIGNER	ML
DATE	07/20/11	CHECKED BY	CM/CG
SCALE	AS NOTED		
SHEET TITLE			

ACAMS RISER DIAGRAM