




C1 NOT TO SCALE
PIPE/CONDUIT THROUGH/ON ROOF

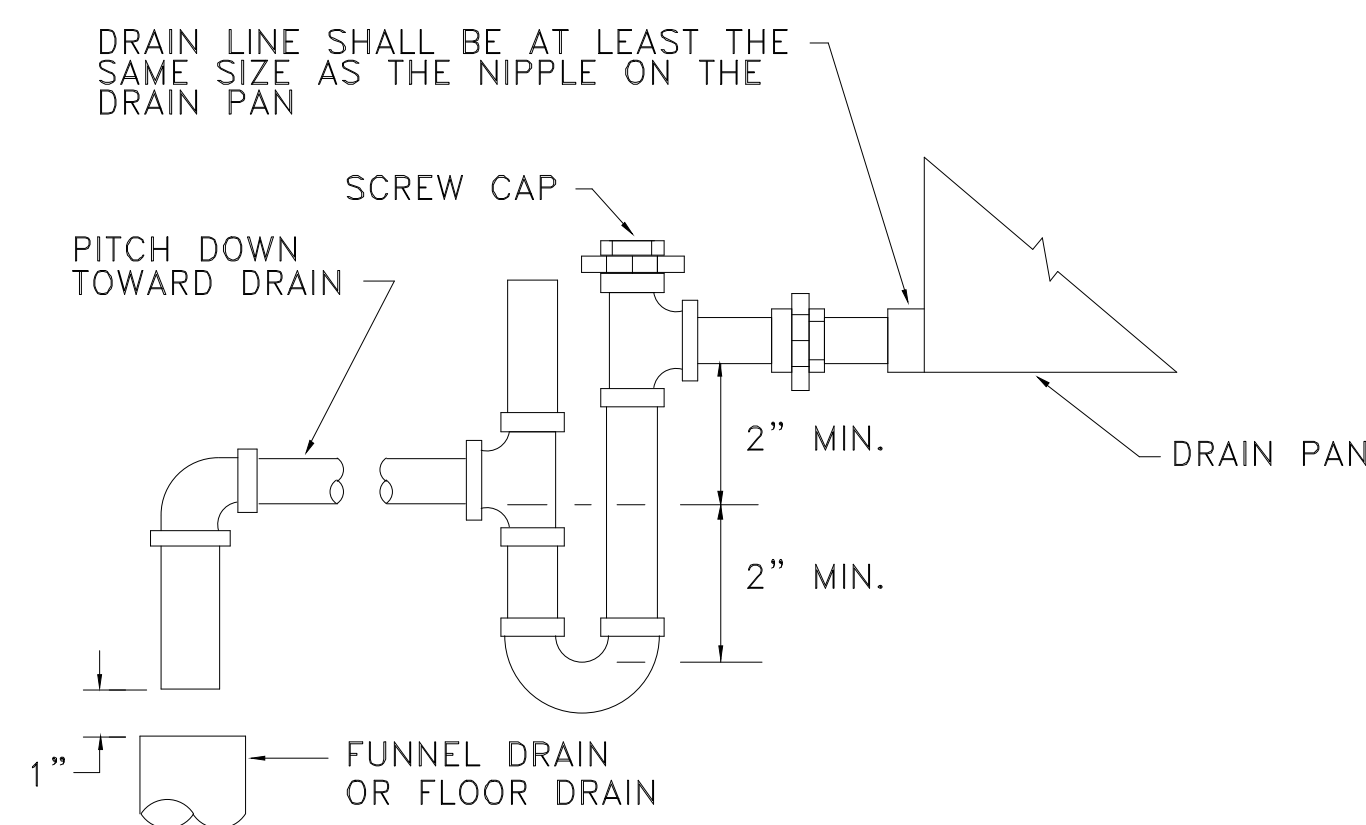

B1 NOT TO SCALE
COOLING COIL CONDENSATE DRAIN TRAP

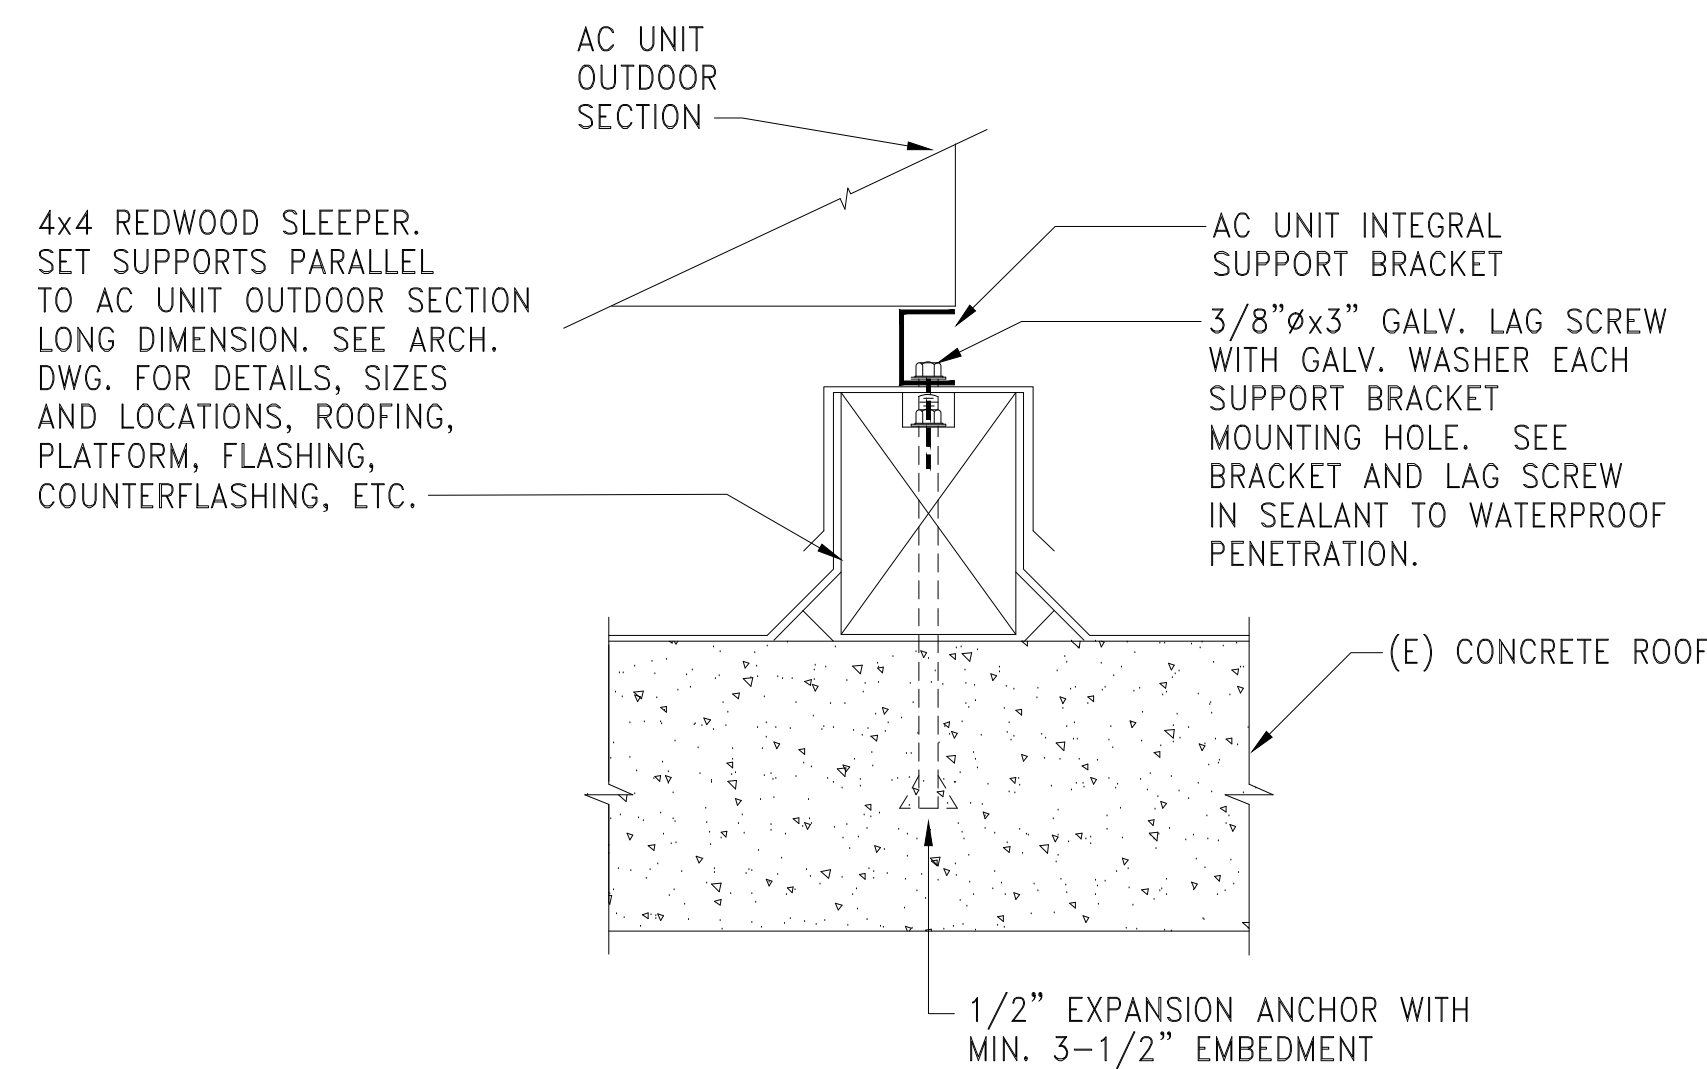

A1 NOT TO SCALE
ACC UNIT OUTDOOR SECTION SUPPORT

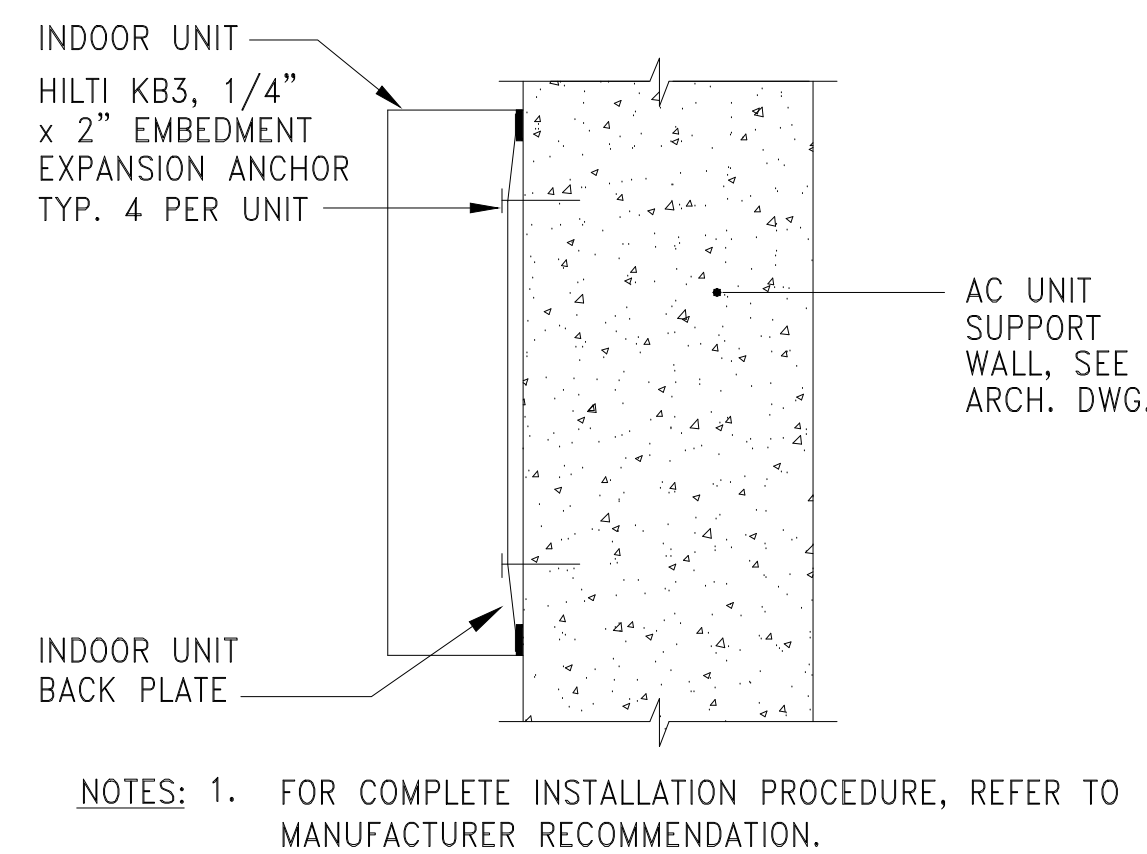


A2 NOT TO SCALE
AC UNIT INDOOR SECTION SUPPORT

ABBREVIATIONS

AFF	ABOVE FINISHED FLOOR	MAX	MAXIMUM
APPROX	APPROXIMATE	MBH	1000 BTUH
ARCH	ARCHITECTURAL	MCA	MINIMUM CIRCUIT AMPS
		MECH	MECHANICAL
BHP	BRAKE HORSEPOWER	MFR	MANUFACTURER
BTU	BRITISH THERMAL UNIT	MIN	MINIMUM
BTUH	BRITISH THERMAL UNIT / HOUR	MISC	MISCELLANEOUS
		NTS	NOT TO SCALE
CC	COOLING COIL	OA	OUTSIDE AIR
CFM	CUBIC FEET PER MINUTE	OC	ON CENTER
CLG	CEILING		
CLR	CLEAR	RA	RETURN AIR
CONC	CONCRETE	REQD	REQUIRED
		RPM	REVOLUTIONS PER MINUTE
DIA	DIAMETER	SA	SUPPLY AIR
DIM	DIMENSION	SF	SQUARE FEET, SUPPLY FAN
DN	DOWN	SIM	SIMILAR
DP	DIFFERENTIAL PRESSURE	SP	STATIC PRESSURE
DPS	DIFFERENTIAL PRESSURE SWITCH		
DWG	DRAWING		
		TCP	TEMPERATURE CONTROL PANEL
E	EXHAUST	TEMP	TEMPERATURE
EA	EXHAUST AIR	THRU	THROUGH
EAD	EXHAUST AIR DAMPER	TYP	TYPICAL
EDB	ENTERING DRY BULB		
ELECT	ELECTRICAL	WG	WATER GAUGE
EQUIP	EQUIPMENT	WT	WEIGHT
EWB	ENTERING WET BULB	W/	WITH
		W/O	WITHOUT
FPM	FEET PER MINUTE	(E)	EXISTING
FT (')	FOOT OR FEET	(N)	NEW
		@	AT
H, HT	HEIGHT	#	NUMBER
HP	HORSEPOWER	&	AND
		Ø	DIAMETER, PHASE
IN (")	INCH OR INCHES	*F	DEGREE FAHRENHEIT
LBS	POUNDS		
LDB	LEAVING DRY BULB		
LWB	LEAVING WET BULB		
LWT	LEAVING WATER TEMPERATURE		

LEGEND

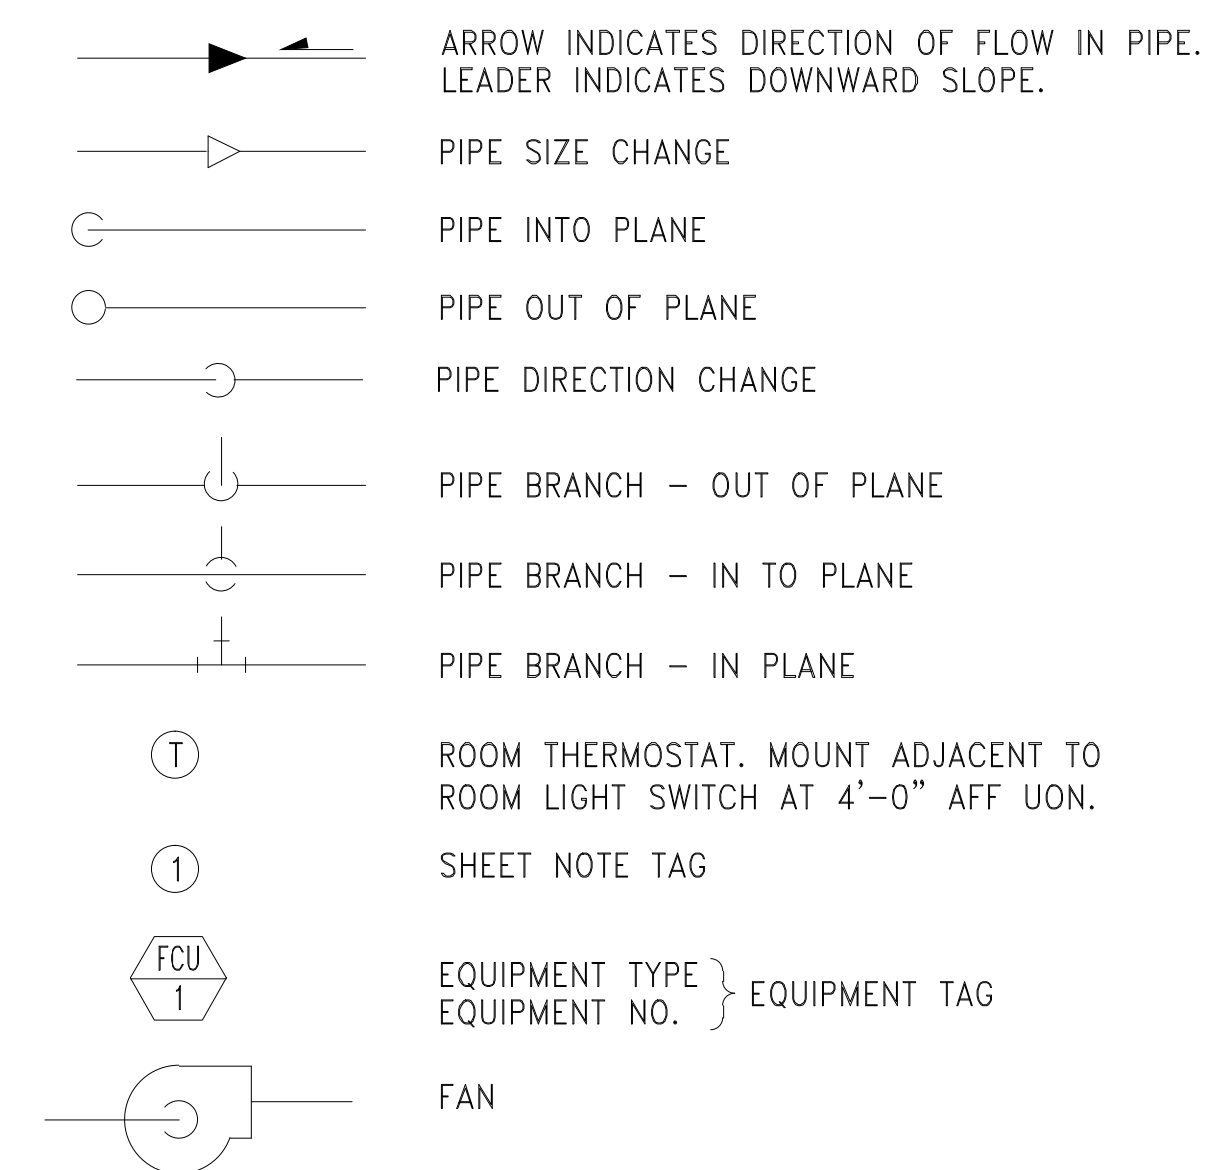

DRAWING INDEX

M-001	ABBREVIATIONS, LEGENDS, GENERAL NOTES AND DETAILS
M-235	MECHANICAL FLOOR PLANS, SCHEDULE AND CONTROL DIAGRAM

GENERAL NOTES

- UNLESS OTHERWISE NOTED, ALL EXISTING INSTALLATION SHALL REMAIN.
- DUCT AND PIPE INSULATION FIRE HAZARD RATINGS SHALL BE IN ACCORDANCE WITH SPECIFICATION SECTION. FLAME SPREAD - MAXIMUM 25. SMOKE CONTRIBUTED - MAXIMUM 50. SMOKE DEVELOPED - MAXIMUM 50.
- PROVIDE FIRE-STOPPING OF ALL PIPE PENETRATIONS THROUGH FIRE RATED WALLS IN ACCORDANCE WITH SPECIFIED REGULATIONS AND SYSTEMS.
- COORDINATE WITH ELECTRICAL LIGHT AND POWER CONDUIT RUNS, LIGHT FIXTURES, SPRINKLER PIPING, PLUMBING PIPING, AND STRUCTURE.

SEISMIC RESTRAINT NOTES

ALL PIPES, DUCTS, AND CONDUITS SHALL BE SUPPORTED AND BRACED PER THE SMACNA "GUIDELINES FOR SEISMIC RESTRAINTS OF MECHANICAL SYSTEMS AND PLUMBING PIPING SYSTEM". A COPY OF THE SEISMIC GUIDELINES PUBLISHED BY SMACNA AND APPROVED BY DSA SHALL BE PROVIDED BY THE CONTRACTOR AND KEPT ON THE JOB SITE AT ALL TIMES.

ALL MECHANICAL AND ELECTRICAL EQUIPMENT SHALL BE BRACED OR ANCHORED TO RESIST A HORIZONTAL FORCE ACTING IN ANY DIRECTION USING THE FOLLOWING CRITERIA.


THE TOTAL DESIGN LATERAL SEISMIC FORCE SHALL BE DETERMINED FROM SECTION 1632A.2 CALIFORNIA BUILDING CODE (CBC) 2001. FORCES SHALL BE APPLIED IN THE HORIZONTAL DIRECTIONS, WHICH RESULT IN THE MOST CRITICAL LOADINGS FOR DESIGN.

THE VALUE OF A_p (COMPONENT AMPLIFICATION FACTOR) AND R_p (COMPONENT RESPONSE MODIFICATION FACTOR) OF SECTION 1632A.2 SHALL BE SELECTED FROM TABLE 16A-0, CBC 2001. THE VALUE OF I_p (SEISMIC IMPORTANCE FACTOR) AND C_a (SEISMIC COEFFICIENT) SHALL BE SELECTED FROM TABLE 16A-K AND 16A-Q, CBC 2001, RESPECTIVELY.

WHERE ANCHORAGE DETAILS ARE NOT SHOWN ON THE DRAWINGS, THE FIELD INSTALLATION SHALL BE SUBJECT TO THE APPROVAL OF THE MECHANICAL /ELECTRICAL ENGINEER AND THE FIELD REPRESENTATIVE OF THE DIVISION OF THE STATE ARCHITECT.



222 SUTTER STREET, 9TH FLOOR
SAN FRANCISCO, CALIFORNIA 94108
phone 415.777.9422 fax 415.777.2755 24/7 bparch.com

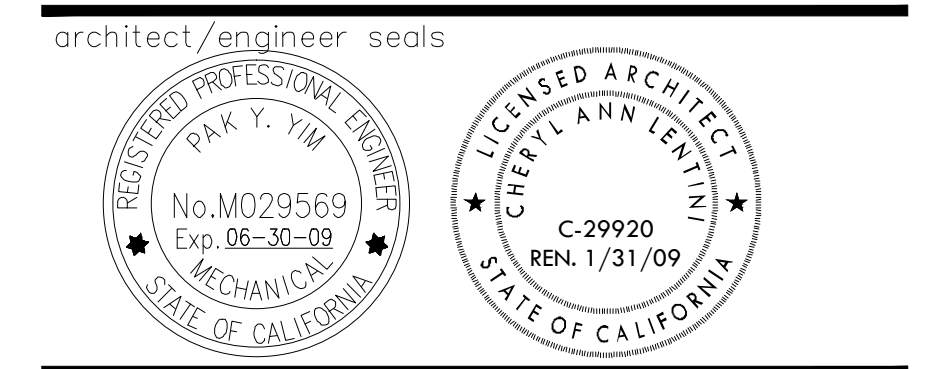

project title
SMCCCD
COLLEGE OF SAN MATEO
FINE ARTS COMPLEX
BUILDINGS 2 & 4
RENOVATIONS
INCREMENT 2
344 CSM DRIVE
SAN MATEO, CA 94402

agency/approvals

IDENTIFICATION STAMP	
DIVISION OF THE STATE ARCHITECT	
APPL. No. 01 - 109243	
AC ______FLS ______SS ______	
DATE _____	

date	description
03.13.2008	PRICING SET
05.08.2008	DSA SUBMITTAL
10.10.2008	DSA BACKCHECK
11.04.2010	RECORD DRAWINGS

sheet title
LEGEND,
ABBREVIATIONS,
GENERAL NOTES,
DRAWING INDEX

project no. 2707.01
sheet no. **M-001**

©Beverly Prior Architects, Inc. 2007 | All Rights Reserved