

NOTES

- ALL PARKING LAYOUT ARE AS FOLLOWS:
S- STANDARD STALLS = 9.0' X 18' MIN.
C- COMPACT STALLS = 8.5' X 16' MIN.
M- MOTORCYCLE STALLS = 4.5' X 18' MIN.
AISLE WIDTH = 24' MIN.
- STANDARD ACCESSIBLE STALLS = 18' X 9' WITH 5' LOADING AISLES
VAN ACCESSIBLE STALLS = 18' X 9' WITH 8' LOADING AISLES
- ALL DIMENSIONS ARE TO FACE OF CURB, UNO
- ALL SITE FEATURE DIMENSIONING BEYOND FACE OF CURB, SEE LANDSCAPE PLANS.
- SAN BRUNO FIRE DEPARTMENT FIRE TRUCK TURNING RADIUS: 32' INSIDE RADIUS AND 52' OUTSIDE RADIUS.
- VEHICLE TURNING RADII ARE AS FOLLOWS:
PASSENGER CAR: RADIUS = 24'
TRUCK: RADIUS = 60' WITH A WHEELBASE OF 50'
BUS: RADIUS = 42'

LEGEND & ABBREVIATIONS


ITEM#	LEGEND	DESCRIPTION	DETAIL
1		CROSSWALK STRIPING	7 (C-907)
2		NO PARKING ZONE	10 (C-907)SM
3		STANDARD/COMPACT STALL	9 (C-907)
4		ACCESSIBLE STALL & SIGN	10 (C-907)
5		SIGN, SEE SIGN SCHEDULE	6 (C-907)
6		"NO PARKING" RED CURB	

SIGN SCHEDULE

ITEM#	DESCRIPTION	DETAIL PER MUTCD STANDARDS
1	STOP	*R1-1
2	YIELD HERE TO PEDESTRIANS	*R1-5
3	STOP AHEAD	*W3-1
4	NO PARKING	*R26(CA) W/ "DROP-OFF AND LOADING ZONE"
5	DISABLED PARKING ONLY	10a (C-907)
6	VAN ACCESSIBLE	10c (C-907)
7	DISABLED TOW AWAY	10b (C-907)
8	LOW-EMITTING VEHICLE	5 (C-903)
9	DO NOT ENTER & WRONG WAY	*R5-1 & *R5-1A
10	PREFERRED PARKING ONLY	5 (C-903)


*MANUAL ON UNIFORM CONTROL DEVICES (MUTCD), LATEST EDITION

REFERENCE

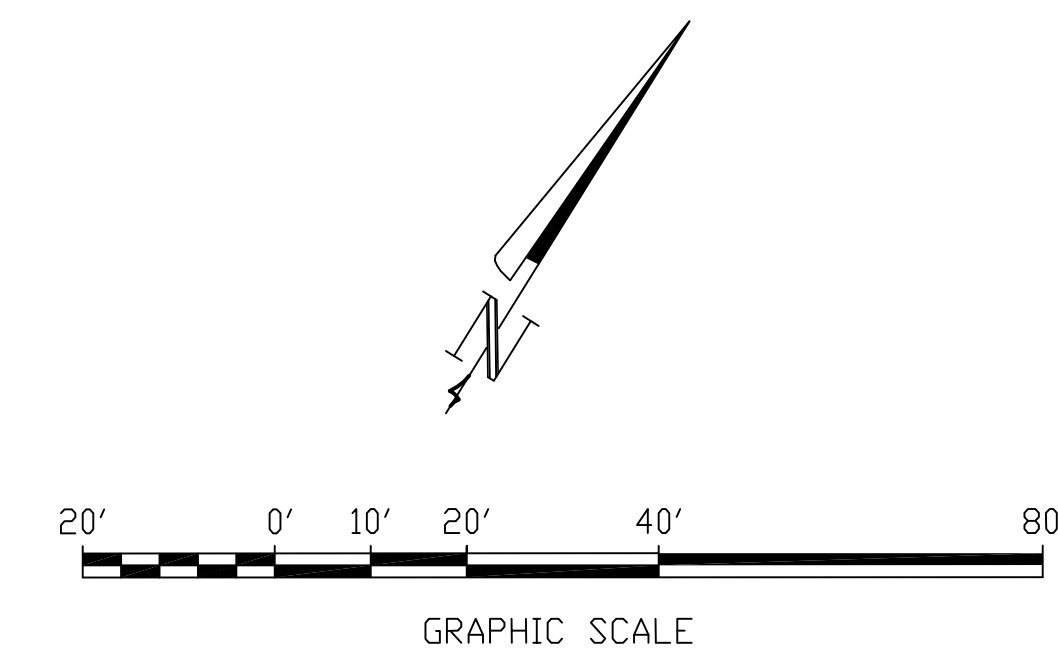

PROJECT RECORD SET

SKYLINE COLLEGE
3300 COLLEGE DRIVE
SAN BRUNO, CA 94066
SAN MATEO COUNTY
COMMUNITY COLLEGE DISTRICT
CIP2 DESIGN-BUILD PROJECT
CAMPUS SITE IMPROVEMENTS

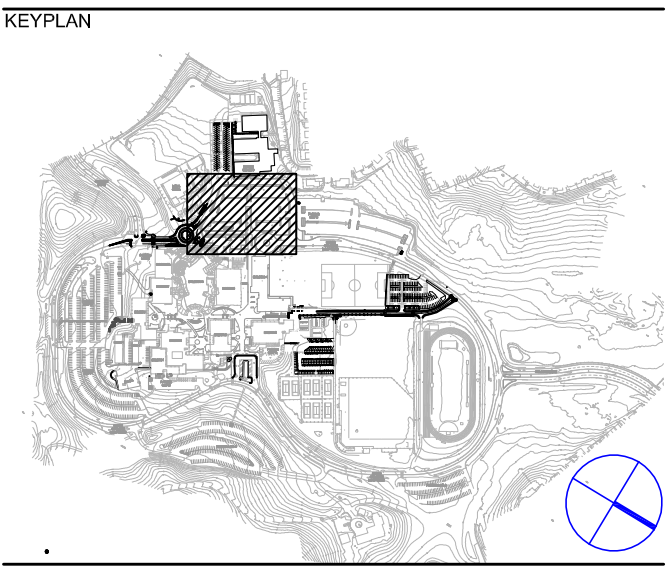

PROJECT NO.: 07012.02 DRAWN BY: EK
DATE: 12/22/2008 CHECKED BY: EK
SCALE: 1" = 20'

HORIZONTAL CONTROL & DIMENSIONING PLAN
PARKING LOT N
STRIPING & SIGNAGE

