




MECHANICAL ROOM SECTION

1/2" = 1'-0"

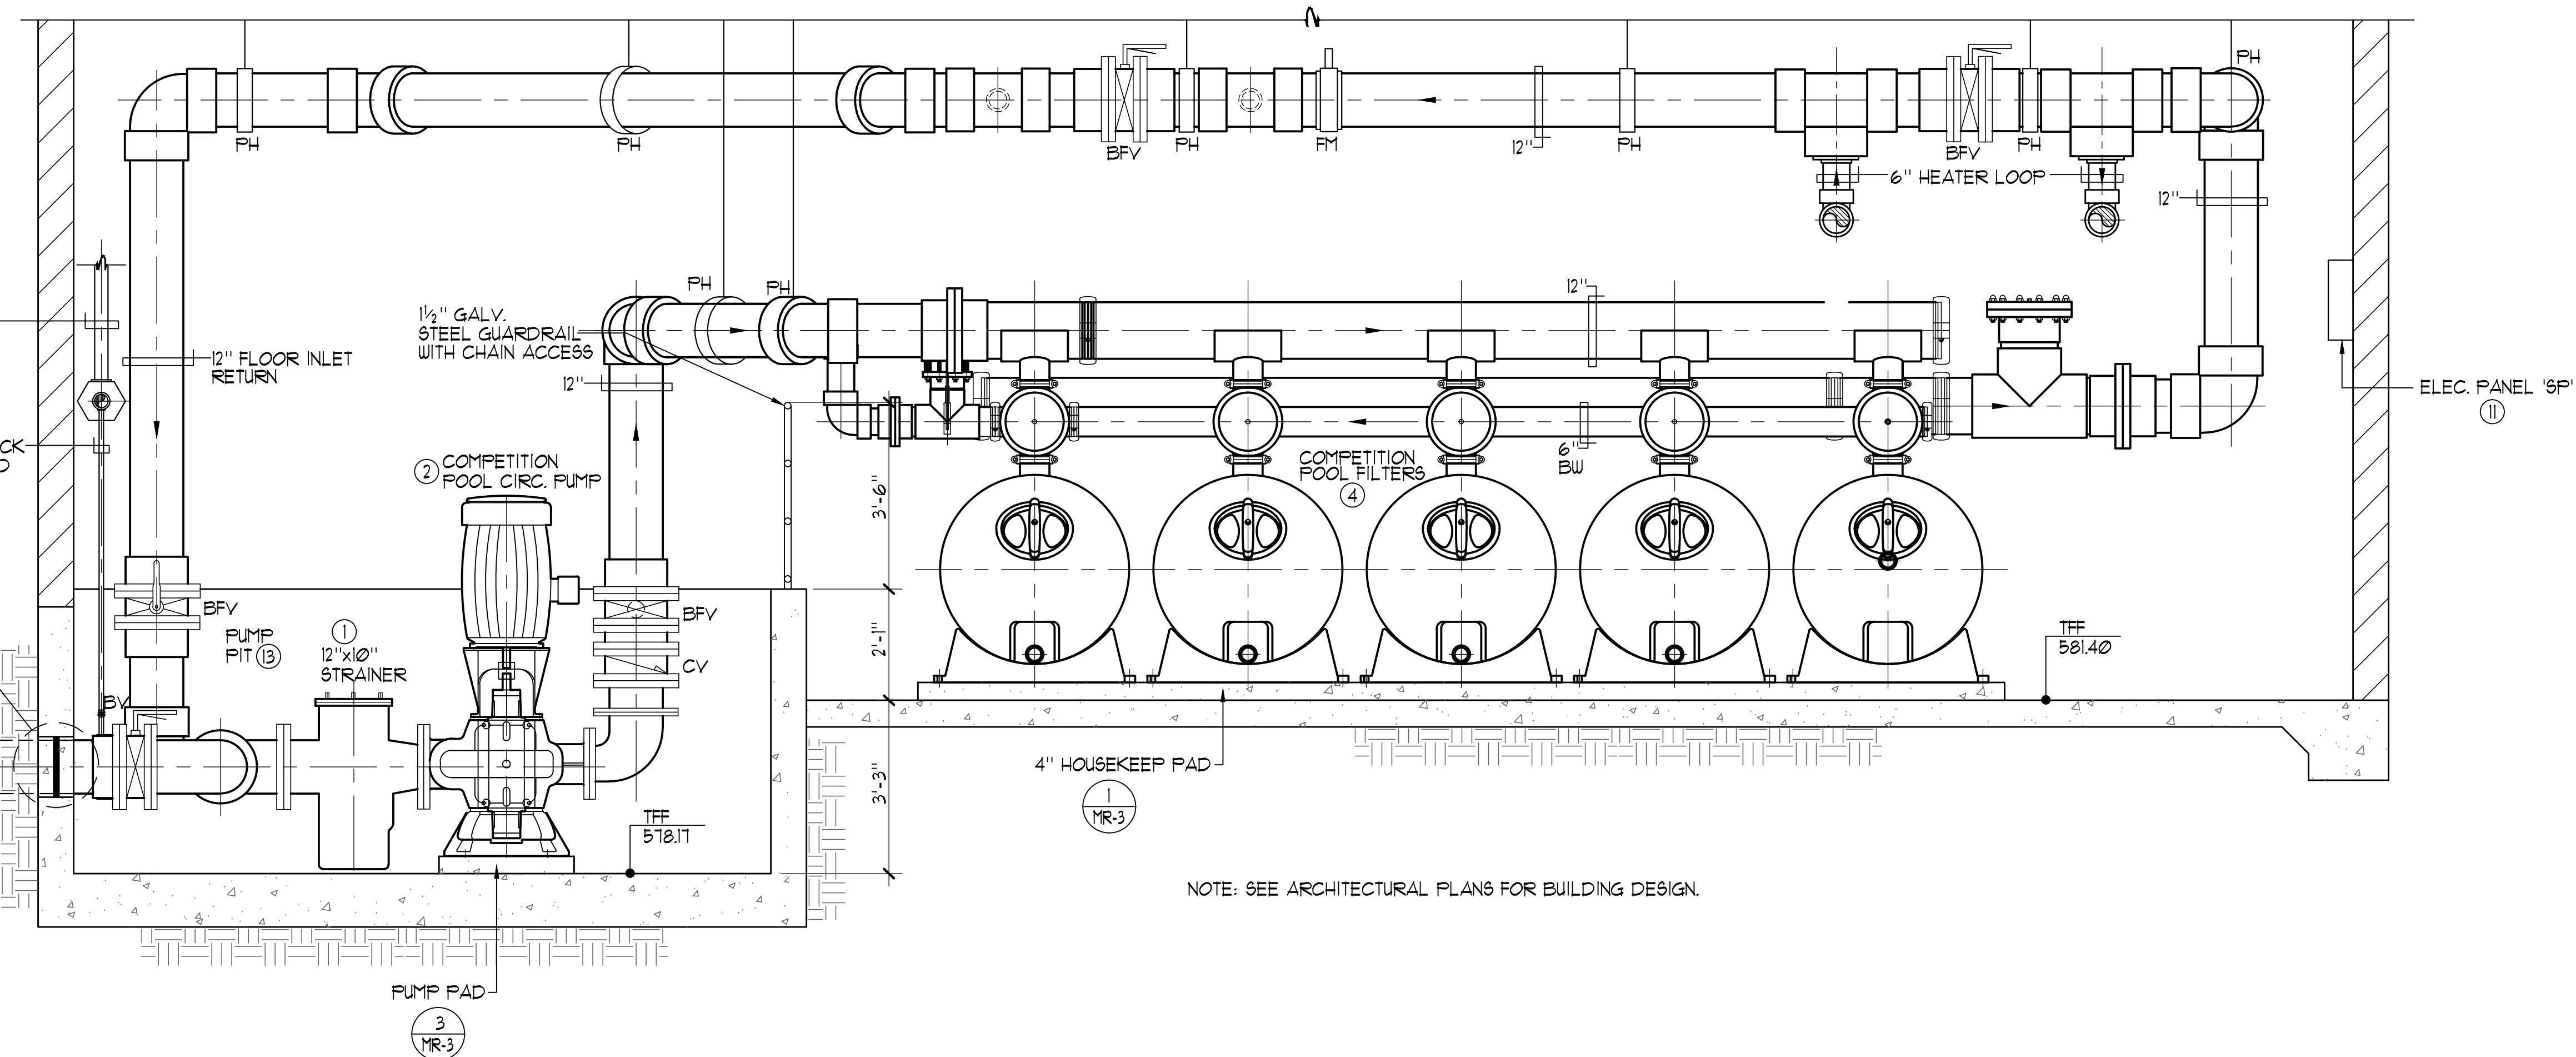

MECHANICAL ROOM SECTION

1/2" = 1'-0"

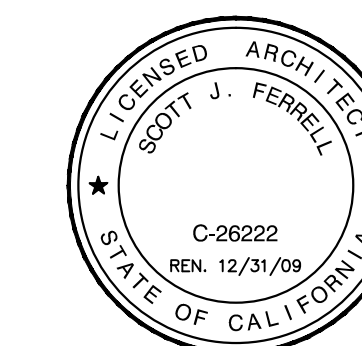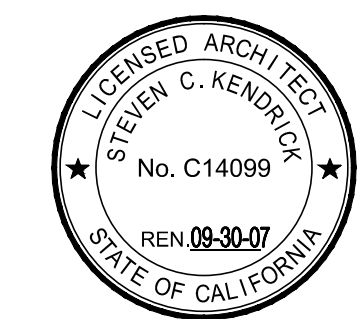

IDENTIFICATION STAMP
 DIV. OF THE STATE ARCHITECT
 OFFICE OF REGULATION SERVICE
 APPL. #: 01-110097
 AC: _____ FLS: _____ SS: _____
 DATE: _____
 FILE NUMBER: 41-C1

This and all other project documents and all their contents, methods and design measurements herein are the property of LPA, Inc. (LPA) and cannot be copied, reproduced, or used in whole or in part for any other project without the express written consent of LPA. LPA hereby grants license to the user of this project document for the use of the information contained herein for the project only. LPA's liability is limited to the amount of the fee paid for this project document. LPA and LPA's Consultants make no representation concerning the accuracy of documents and are not responsible for any discrepancies between project documents and the existing conditions.
 © Copyright 2008

College of San Mateo
Site Package
 San Mateo, CA
 Developed for
 San Mateo County Community College District

Revision	Description	Date

Revision	Description	Date
19	DSA SUBMITTAL	SEPT 2008
09	DSA FINAL	APRIL 2009
	PROJECT RECORD DRAWING	JUNE 2011

Job No.	27082.30
Date	09 APRIL 2009
Drawn by	NFC
Checked by	SJF
Scale	1/2" = 1'-0"

MECHANICAL ROOM SECTIONS

MR-2