

MATCH LINE - SEE SHEET C2.07

BUILDING 4

PARKING LOT 2



PARKING LOT 1

MATCH LINE - SEE SHEET C2.03

MATCH LINE - SEE SHEET C2.05

MATCH LINE - SEE SHEET C2.01

MATCH LINE - SEE SHEET C2.01

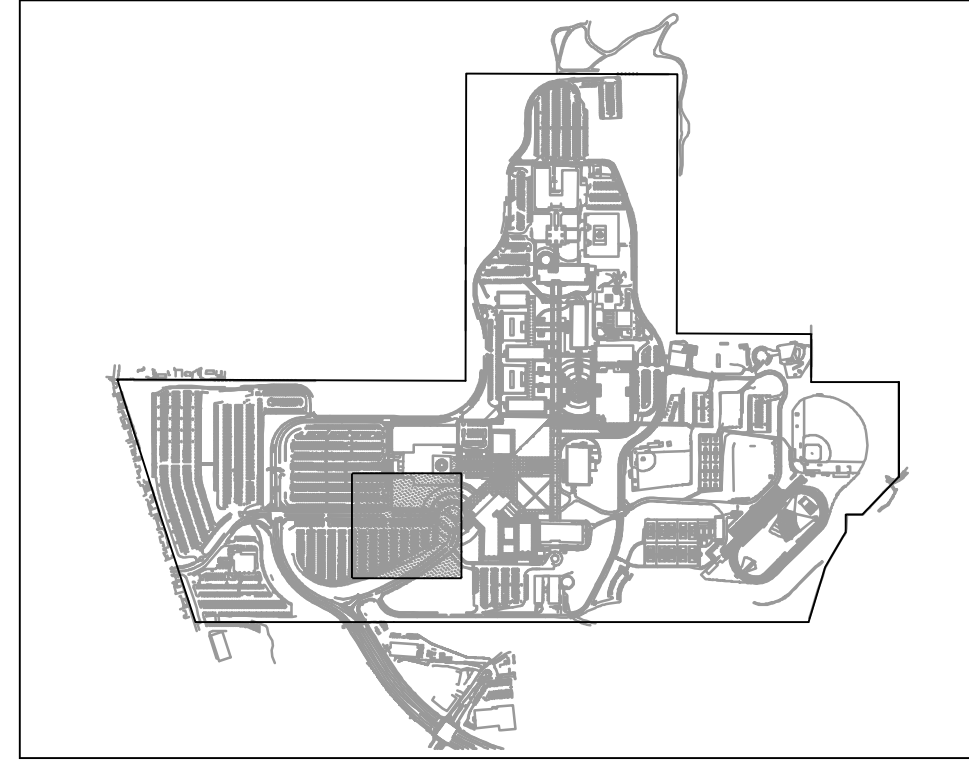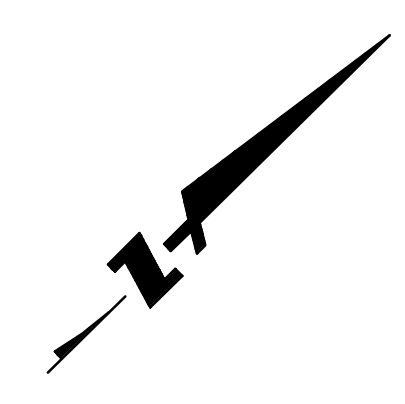

KEYMAP

**RECORD DRAWINGS**  
 THESE RECORD DOCUMENTS HAVE BEEN PREPARED BASED ON INFORMATION PROVIDED BY OTHERS. BKF ENGINEERS HAS NOT VERIFIED THE ACCURACY AND/OR COMPLETENESS OF THIS INFORMATION AND SHALL NOT BE RESPONSIBLE FOR ANY ERRORS OR OMISSIONS THAT MAY BE INCORPORATED HEREIN AS A RESULT. BKF ENGINEERS DOES NOT ASSUME ANY RESPONSIBILITY FOR THE FIELD MODIFICATIONS TO THE PLANS.

BY: BKF ENGINEERS      DATE: JUNE 2011



McCarthy Building Companies, Inc.  
 343 Sansome Street, 14th Floor  
 San Francisco, California 94104  
 P 415 | 364-1339  
 F 415 | 397-5999



255 SHORELINE DRIVE, SUITE 200  
 REDWOOD CITY, CA 94065  
 PHONE: (650) 482-6300  
 FAX: (650) 482-6399



IDENTIFICATION STAMP  
 DIV. OF THE STATE ARCHITECT  
 OFFICE OF REGULATION SERVICE  
 APPL. # 01-110097  
 DATE: \_\_\_\_\_  
 FILE NUMBER: \_\_\_\_\_

The use of other project documents and all data, including and design incorporated therein on instruments of service, all project documents are the registered property of LPA, Inc. (LPA) and cannot be further used in whole or in part for any project other than that for which they were prepared. No warranty, express or implied, is made by LPA, Inc. for the use of these documents for any purpose other than that for which they were prepared. LPA, Inc. and its consultants shall not be held responsible for any reproduction or modification (re-use) of any project documents without the prior written consent of LPA, Inc. and its consultants. LPA, Inc. and its consultants shall not be held responsible for any reproduction or modification (re-use) of any project documents without the prior written consent of LPA, Inc. and its consultants. LPA, Inc. and its consultants shall not be held responsible for any reproduction or modification (re-use) of any project documents without the prior written consent of LPA, Inc. and its consultants.

College of San Mateo  
 Site Package  
 San Mateo, CA  
 Developed for  
 San Mateo County Community College District

| Revision | Description | Date |
|----------|-------------|------|
|          |             |      |
|          |             |      |
|          |             |      |

| Revision | Description            | Date          |
|----------|------------------------|---------------|
| 1        | DSN SUBMITTAL          | 19 SEPT 2008  |
| 2        | DSN FINAL              | 09 APRIL 2009 |
| 3        | PROJECT RECORD DRAWING | JUNE 2011     |

|            |               |
|------------|---------------|
| Job No.    | 27082.30      |
| Date       | 02 APRIL 2009 |
| Drawn by   | MD, JT        |
| Checked by | RH            |
| Scale      | 1"=20'        |

EXISTING TOPOGRAPHY

C2.04