



MATCH LINE - SEE SHEET C2.05

MATCH LINE - SEE SHEET C2.09

MATCH LINE - SEE SHEET C2.02



McCarthy Building Companies, Inc.
343 Sansome Street, 14th Floor
San Francisco, California 94104
P 415 | 364-1339
F 415 | 397-5999

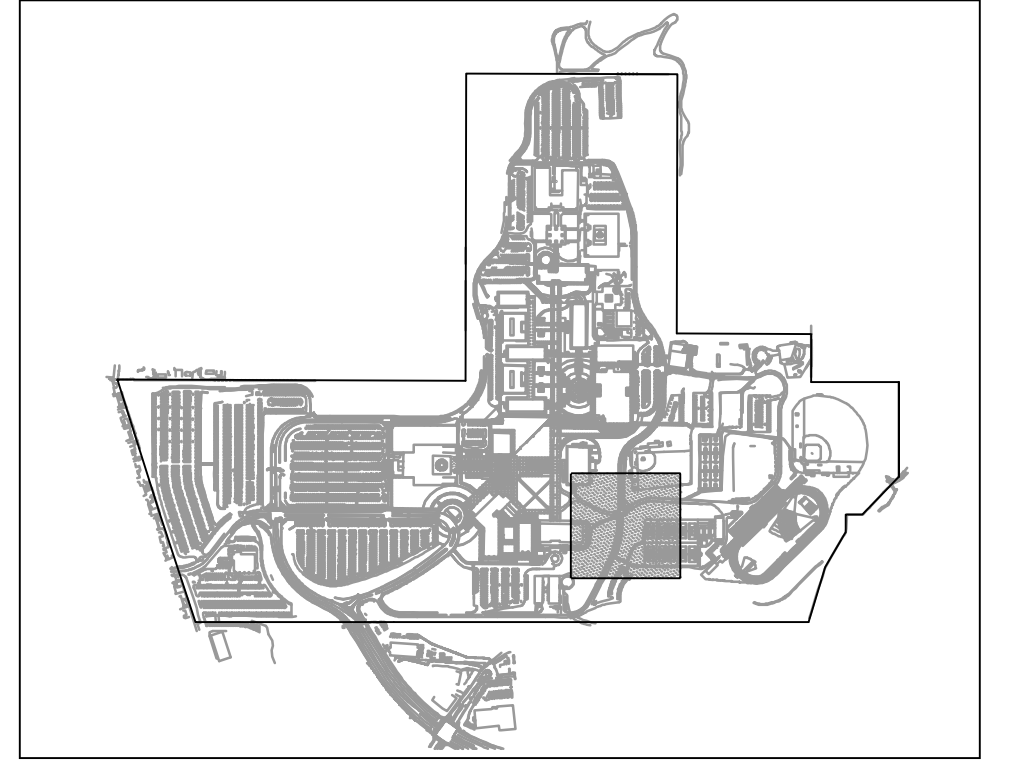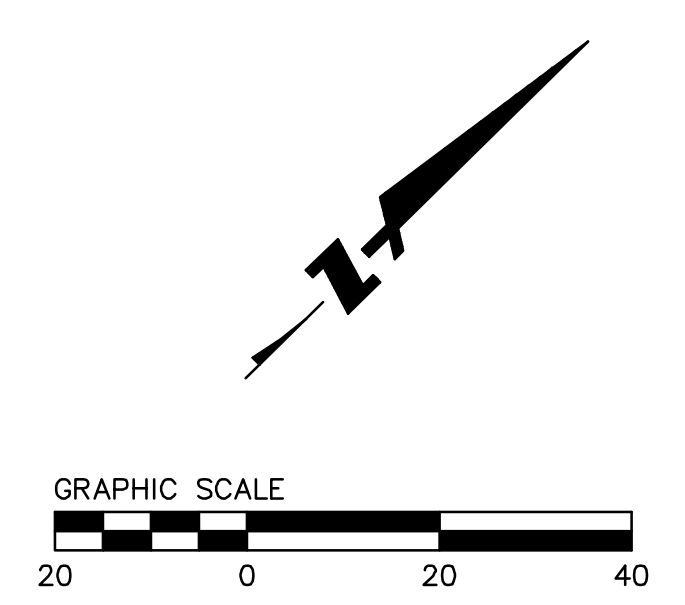

IDENTIFICATION STAMP
DIV. OF THE STATE ARCHITECT
OFFICE OF REGULATION SERVICE

APPL. # 01-110097

AC: _____ FLS: _____ SS: _____

DATE: _____

FILE NUMBER: _____

This set of other project documents and all their contents and design incorporated herein are the property of LPA, Inc. (LPA) and cannot be further used in whole or in part for any other project without the express written consent of LPA, Inc. LPA hereby grants permission to the recipient to reproduce or modify the information or modification (revised) is not only unlawful but also constitutes a violation of the professional seal of the recipient. LPA and LPA's Consultants make no representation or warranty for any design or construction of any project or any other project documents or any other project documents on the existing conditions.

© Copyright 2008

College of San Mateo
Site Package
San Mateo, CA

Developed for
San Mateo County Community College District

Revision	Description	Date

Revision	Description	Date
1	DSN SUBMITTAL	19 SEPT 2008
2	DSN FINAL	09 APRIL 2009
3	PROJECT RECORD DRAWING	JUNE 2011

RECORD DRAWINGS

THESE RECORD DOCUMENTS HAVE BEEN PREPARED BASED ON INFORMATION PROVIDED BY OTHERS. BKF ENGINEERS HAS NOT VERIFIED THE ACCURACY AND/OR COMPLETENESS OF THIS INFORMATION AND SHALL NOT BE RESPONSIBLE FOR ANY ERRORS OR OMISSIONS THAT MAY BE INCORPORATED HEREIN AS A RESULT. BKF ENGINEERS DOES NOT ASSUME ANY RESPONSIBILITY FOR THE FIELD MODIFICATIONS TO THE PLANS.

BY: BKF ENGINEERS DATE: JUNE 2011

Job No.	27082.30
Date	02 APRIL 2009
Drawn by	MD, JT
Checked by	RH
Scale	1"=20'

EXISTING TOPOGRAPHY

C2.06