
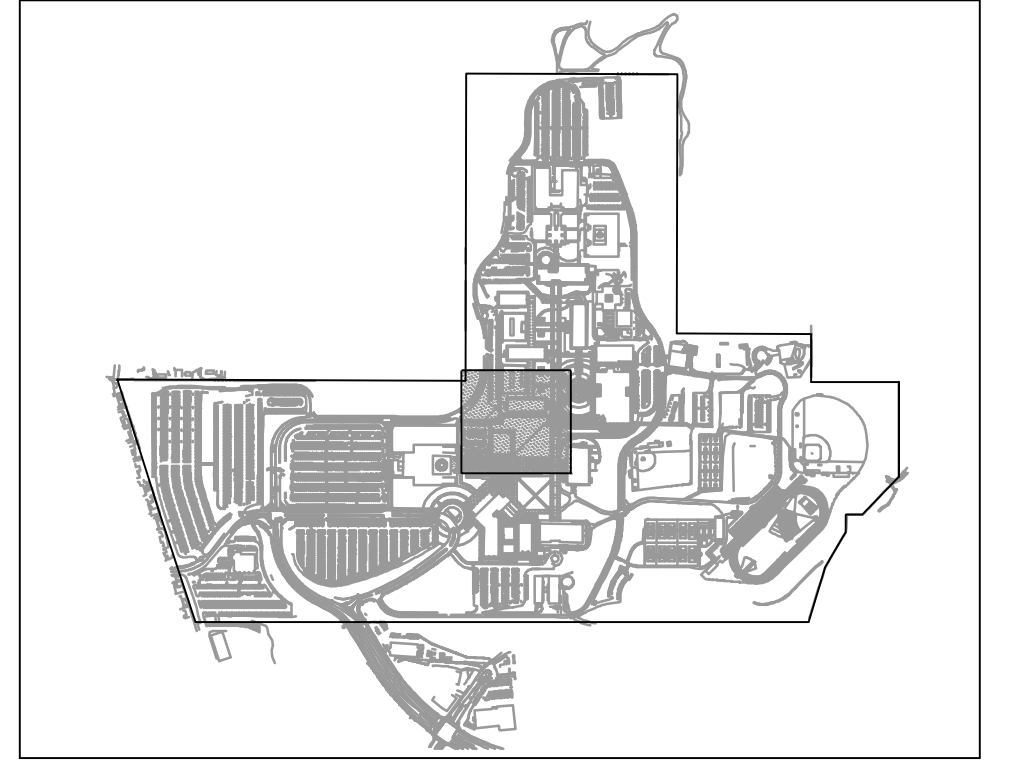
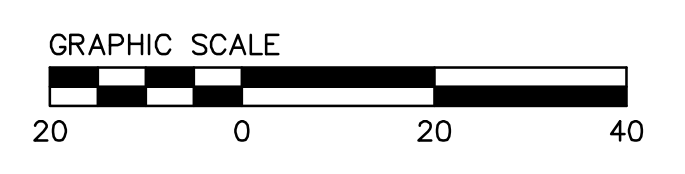


MATCH LINE - SEE SHEET C2.07

MATCH LINE - SEE SHEET C2.11

MATCH LINE - SEE SHEET C2.09

MATCH LINE - SEE SHEET C2.05

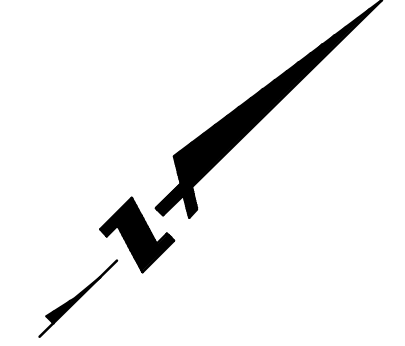

KEYMAP

RECORD DRAWINGS

THESE RECORD DOCUMENTS HAVE BEEN PREPARED BASED ON INFORMATION PROVIDED BY OTHERS. BKF ENGINEERS HAS NOT VERIFIED THE ACCURACY AND/OR COMPLETENESS OF THIS INFORMATION AND SHALL NOT BE RESPONSIBLE FOR ANY ERRORS OR OMISSIONS THAT MAY BE INCORPORATED HEREIN AS A RESULT. BKF ENGINEERS DOES NOT ASSUME ANY RESPONSIBILITY FOR THE FIELD MODIFICATIONS TO THE PLANS.


BY: BKF ENGINEERS DATE: JUNE 2011



McCarthy Building Companies, Inc.
343 Sansome Street, 14th Floor
San Francisco, California 94104
P 415 364-1339
F 415 397-5999



255 SHORELINE DRIVE, SUITE 200
REDWOOD CITY, CA 94065
PHONE: (650) 482-6300
FAX: (650) 482-6399

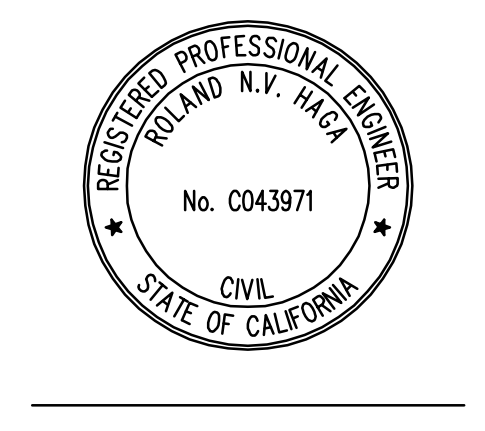

IDENTIFICATION STAMP
DIV. OF THE STATE ARCHITECT
OFFICE OF REGULATION SERVICE

APPL. # 01-110097

AC: _____ FLS: _____ SS: _____

DATE: _____

FILE NUMBER: _____

This set of other project documents and all sheets, including and design incorporated therein are instruments of service. All project documents are the registered property of LPA, Inc. (LPA) and cannot be copied, used, in whole or in part, for any other project without the written consent of LPA, Inc. Any unauthorized copying, reproduction or modification (reproduction) is not only unlawful but also constitutes a violation of the laws of the State of California. LPA hereby grants permission to the recipient of these project documents to reproduce or modify them for their own use, provided that the recipient indemnifies LPA and LPA's Consultants from any and all liability arising directly or indirectly from project documents. These project documents shall remain the property of LPA and LPA's Consultants and shall not be used for any other project. LPA and LPA's Consultants make no representation concerning the accuracy of documents and are not responsible for any discrepancies between project documents and the existing conditions.

© Copyright 2008

College of San Mateo
Site Package
San Mateo, CA

Developed for
San Mateo County Community College District

Revision	Description	Date

Revision	Description	Date
19	DSN SUBMITTAL	SEPT 2008
09	DSN FINAL	APRIL 2009
	PROJECT RECORD DRAWING	JUNE 2011

Job No.	27082.30
Date	02 APRIL 2009
Drawn by	MD, JT
Checked by	RH
Scale	1"=20'

EXISTING TOPOGRAPHY

C2.08