
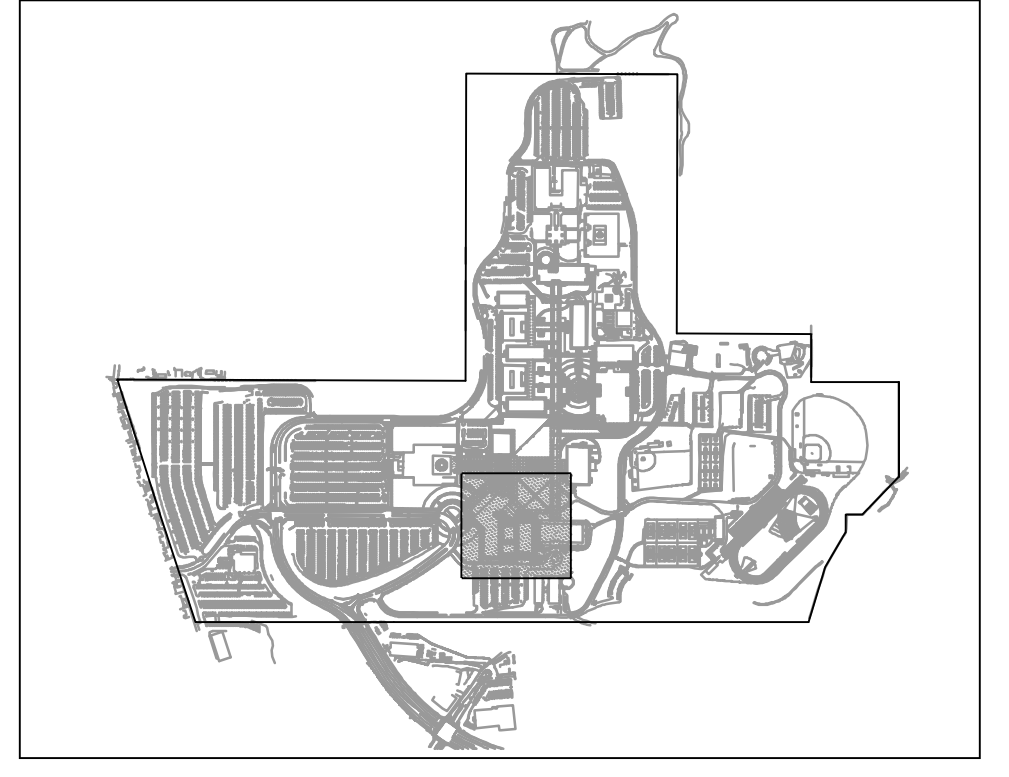
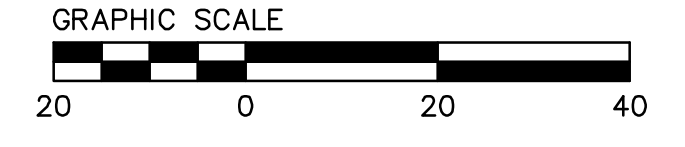


**BUILDING 5N
(TO BE REMOVED)**
SEE DEMOLITION NOTES

**BUILDING 8
(TO REMAIN)**

PARKING LOT 3

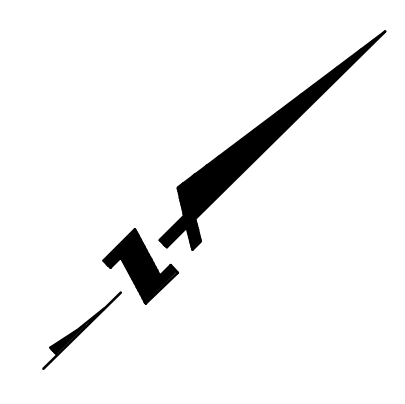

KEYMAP

NOTES

- SEE SHEET C3.01 FOR DEMOLITION NOTES, SYMBOLS, AND LEGEND.

DEMOLITION SYMBOLS

- TO BE REMOVED
- TO REMAIN, PROTECT IN PLACE
- TO BE RELOCATED. SALVAGED ITEMS TO BE STORED & INSTALLED UNDER DIRECTION OF ENGINEER.
- ADJUST TO GRADE
- GRIND OFF EXISTING STRIPING & PAVEMENT MARKINGS. SEE HORIZONTAL CONTROL SHEETS 4.01 TO 4.18 FOR PROPOSED STRIPING & PAVEMENT MARKINGS.
- TO REMAIN, PROTECT IN PLACE. INSTALL BOLT-ON COVER.
- TO BE REMOVED & RETURNED TO COLLEGE.

DEMOLITION LEGEND

- HARDSCAPE TO BE DEMOLISHED & REMOVED (INCLUDING AC PAVEMENT, AB, SIDEWALK, MISC CONCRETE.)
- LANDSCAPE TO BE REMOVED
- EXISTING UTILITY TO BE DEMOLISHED & REMOVED
- EXISTING CURB TO BE DEMOLISHED & REMOVED
- SAWCUT LINE
- LIMITS OF DEMOLITION
- TREE TO BE REMOVED
- TREE TO REMAIN

RECORD DRAWINGS

THESE RECORD DOCUMENTS HAVE BEEN PREPARED BASED ON INFORMATION PROVIDED BY OTHERS. BKF ENGINEERS HAS NOT VERIFIED THE ACCURACY AND/OR COMPLETENESS OF THIS INFORMATION AND SHALL NOT BE RESPONSIBLE FOR ANY ERRORS OR OMISSIONS THAT MAY BE INCORPORATED HEREIN AS A RESULT. BKF ENGINEERS DOES NOT ASSUME ANY RESPONSIBILITY FOR THE FIELD MODIFICATIONS TO THE PLANS.

BY: BKF ENGINEERS DATE: JUNE 2011



McCarthy Building Companies, Inc.
343 Sansome Street, 14th Floor
San Francisco, California 94104
P 415 | 364-1339
F 415 | 397-5999



255 SHORELINE DRIVE, SUITE 200
REDWOOD CITY, CA 94065
PHONE: (650) 482-6300
FAX: (650) 482-6399



IDENTIFICATION STAMP
DIV. OF THE STATE ARCHITECT
OFFICE OF REGULATION SERVICE
APPL. # 01-110097
AC: _____ FLS: _____ SS: _____
DATE: _____
FILE NUMBER: _____

This set of other project documents and all sheets, sections and details incorporated herein are instruments of service. All project documents are the intellectual property of LPA, Inc. LPA and cannot be further used in whole or in part for any other project without the express written consent of LPA. Any reuse of project documents without the express written consent of LPA constitutes a violation of the terms of the agreement between LPA and the Client. LPA hereby disclaims any liability for any errors or omissions in the reproduction or modification (revised) is not only intended but is also intended to be a part of the project documents. LPA and LPA's Consultants are not responsible for any errors or omissions in the reproduction or modification (revised) is not only intended but is also intended to be a part of the project documents. LPA and LPA's Consultants make no representation concerning the accuracy of documents not prepared by LPA or LPA's Consultants.

© Copyright 2008

College of San Mateo
Site Package
San Mateo, CA

Developed for
San Mateo County Community College District

Revision	Description	Date

Revision	Description	Date
1.0	DSN SUBMITTAL	19 SEPT 2008
2.0	DSA FINAL	09 APRIL 2009
3.0	RFI #87	30 OCT 2009
4.0	PROJECT RECORD DRAWING	JUNE 2011

Job No.	27082.30
Date	02 APRIL 2009
Drawn by	MD, JT
Checked by	RH
Scale	1"=20'

DEMOLITION PLAN

C3.05