
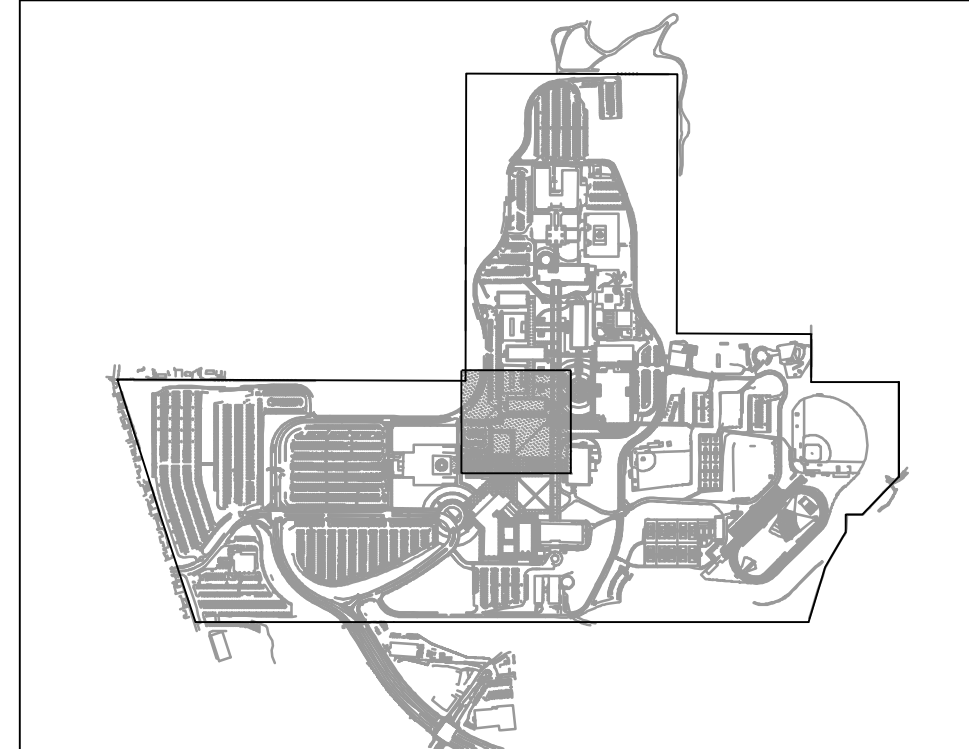


IDENTIFICATION STAMP
DIV. OF THE STATE ARCHITECT
OFFICE OF REGULATION SERVICE
APPL. # 01-110097
AC: _____ FLS: _____ SS: _____
DATE: _____
FILE NUMBER: _____

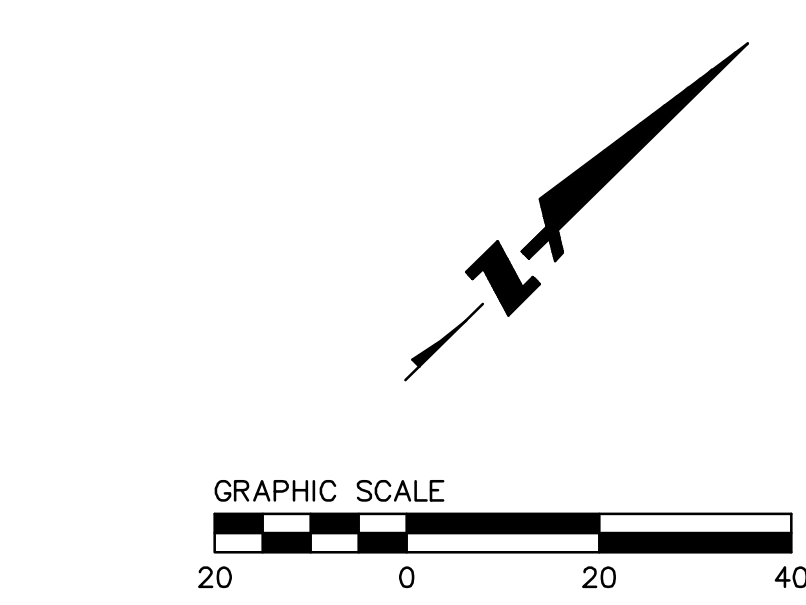

NOTES

- SEE SHEET C3.01 FOR DEMOLITION NOTES, SYMBOLS, AND LEGEND.

DEMOLITION SYMBOLS

- TO BE REMOVED
- TO REMAIN, PROTECT IN PLACE
- TO BE RELOCATED. SALVAGED ITEMS TO BE STORED & INSTALLED UNDER DIRECTION OF ENGINEER.
- ADJUST TO GRADE
- GRIND OFF EXISTING STRIPING & PAVEMENT MARKINGS. SEE HORIZONTAL CONTROL SHEETS 4.01 TO 4.18 FOR PROPOSED STRIPING & PAVEMENT MARKINGS.
- TO REMAIN, PROTECT IN PLACE. INSTALL BOLT-ON COVER.
- TO BE REMOVED & RETURNED TO COLLEGE.

DEMOLITION LEGEND

- HARDSCAPE TO BE DEMOLISHED & REMOVED (INCLUDING AC PAVEMENT, AB, SIDEWALK, MISC CONCRETE.)
- LANDSCAPE TO BE REMOVED
- EXISTING UTILITY TO BE DEMOLISHED & REMOVED
- EXISTING CURB TO BE DEMOLISHED & REMOVED
- SAWCUT LINE
- LIMITS OF DEMOLITION
- TREE TO BE REMOVED
- TREE TO REMAIN

RECORD DRAWINGS
THESE RECORD DOCUMENTS HAVE BEEN PREPARED BASED ON INFORMATION PROVIDED BY OTHERS. BKF ENGINEERS HAS NOT VERIFIED THE ACCURACY AND/OR COMPLETENESS OF THIS INFORMATION AND SHALL NOT BE RESPONSIBLE FOR ANY ERRORS OR OMISSIONS THAT MAY BE INCORPORATED HEREIN AS A RESULT. BKF ENGINEERS DOES NOT ASSUME ANY RESPONSIBILITY FOR THE FIELD MODIFICATIONS TO THE PLANS.
BY: BKF ENGINEERS DATE: JUNE 2011

College of San Mateo
Site Package
San Mateo, CA
Developed for
San Mateo County Community College District

| Revision | Description | Date |
|----------|-------------|------|
| | | |
| | | |
| | | |

| Revision | Description | Date |
|----------|------------------------|------------|
| 19 | DSK SUBMITTAL | SEPT 2008 |
| 09 | DSK FINAL | APRIL 2009 |
| | PROJECT RECORD DRAWING | JUNE 2011 |

| | |
|------------|---------------|
| Job No. | 27082.30 |
| Date | 02 APRIL 2009 |
| Drawn by | MD, JT |
| Checked by | RH |
| Scale | 1"=20' |

DEMOLITION PLAN