

MATCH LINE - SEE SHEET C3-08

MATCH LINE - SEE SHEET C3-12

MATCH LINE - SEE SHEET C3-10

MATCH LINE - SEE SHEET C3-06



McCarthy Building Companies, Inc.  
343 Sansome Street, 14th Floor  
San Francisco, California 94104  
P 415 | 364-1339  
F 415 | 397-5999





255 SHORELINE DRIVE, SUITE 200  
REDWOOD CITY, CA 94065  
PHONE: (650) 482-6300  
FAX: (650) 482-6399



IDENTIFICATION STAMP  
DIV. OF THE STATE ARCHITECT  
OFFICE OF REGULATION SERVICE  
APPL. # 01-110097  
AC: \_\_\_\_\_ FLS: \_\_\_\_\_ SS: \_\_\_\_\_  
DATE: \_\_\_\_\_  
FILE NUMBER: \_\_\_\_\_

The use of other project documents and all data, methods, and design incorporated herein are hereby accepted as part of this project documents and the registered property of LPA, Inc. LPA, Inc. and its affiliates shall not be held liable for any errors or omissions in this project documents or any other project documents. LPA, Inc. and its affiliates shall not be held liable for any errors or omissions in this project documents or any other project documents. LPA, Inc. and its affiliates shall not be held liable for any errors or omissions in this project documents or any other project documents. LPA, Inc. and its affiliates shall not be held liable for any errors or omissions in this project documents or any other project documents.

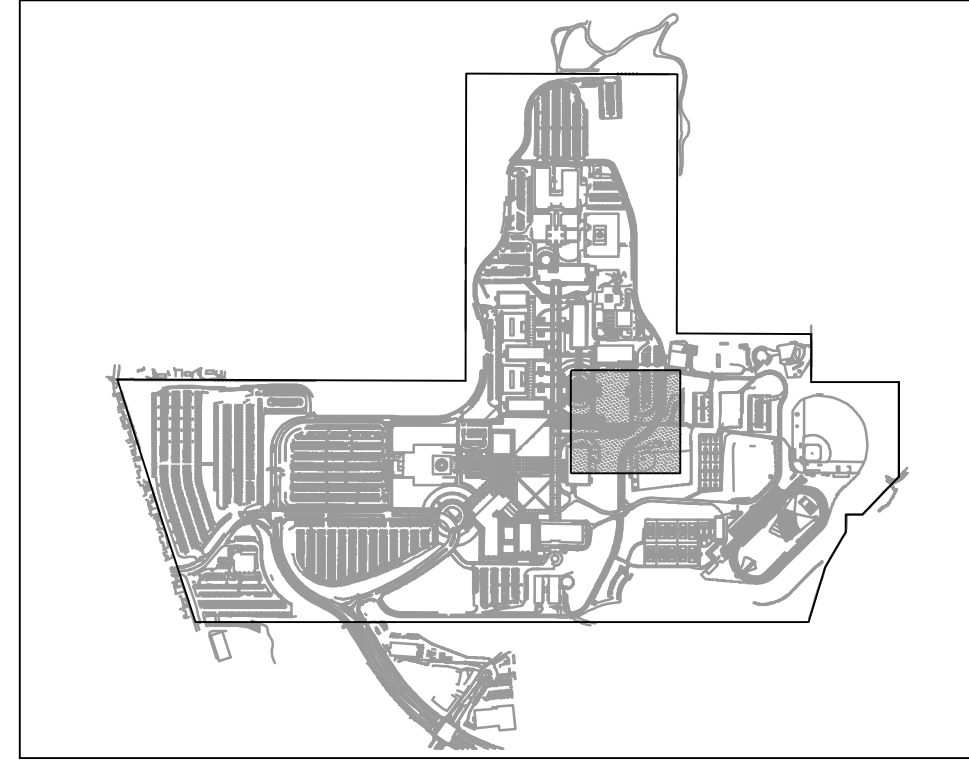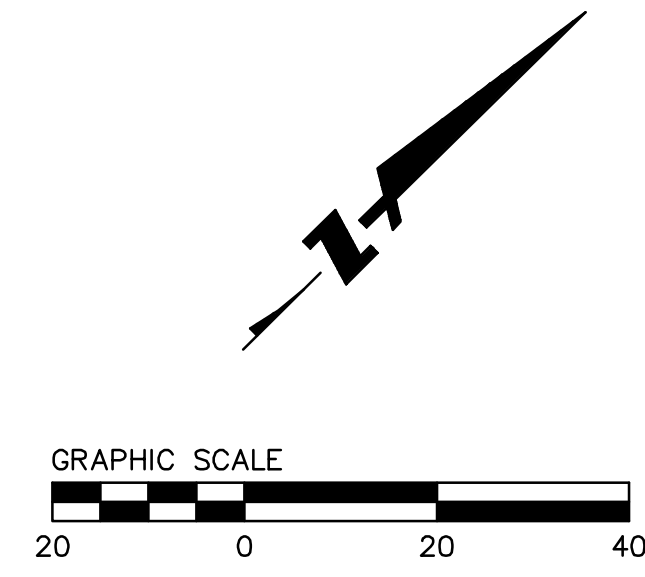

**NOTES**  
1. SEE SHEET C3.01 FOR DEMOLITION NOTES, SYMBOLS, AND LEGEND.

- DEMOLITION SYMBOLS**
- 1 TO BE REMOVED
  - 2 TO REMAIN, PROTECT IN PLACE
  - 3 TO BE RELOCATED. SALVAGED ITEMS TO BE STORED & INSTALLED UNDER DIRECTION OF ENGINEER.
  - 4 ADJUST TO GRADE
  - 5 GRIND OFF EXISTING STRIPING & PAVEMENT MARKINGS. SEE HORIZONTAL CONTROL SHEETS 4.01 TO 4.18 FOR PROPOSED STRIPING & PAVEMENT MARKINGS.
  - 6 TO REMAIN, PROTECT IN PLACE. INSTALL BOLT-ON COVER.
  - 7 TO BE REMOVED & RETURNED TO COLLEGE.

- DEMOLITION LEGEND**
- HARDSCAPE TO BE DEMOLISHED & REMOVED (INCLUDING AC PAVEMENT, AB, SIDEWALK, MISC CONCRETE.)
  - LANDSCAPE TO BE REMOVED
  - EXISTING UTILITY TO BE DEMOLISHED & REMOVED
  - EXISTING CURB TO BE DEMOLISHED & REMOVED
  - SAWCUT LINE
  - LIMITS OF DEMOLITION
  - TREE TO BE REMOVED
  - TREE TO REMAIN

**RECORD DRAWINGS**  
THESE RECORD DOCUMENTS HAVE BEEN PREPARED BASED ON INFORMATION PROVIDED BY OTHERS. BKF ENGINEERS HAS NOT VERIFIED THE ACCURACY AND/OR COMPLETENESS OF THIS INFORMATION AND SHALL NOT BE RESPONSIBLE FOR ANY ERRORS OR OMISSIONS THAT MAY BE INCORPORATED HEREIN AS A RESULT. BKF ENGINEERS DOES NOT ASSUME ANY RESPONSIBILITY FOR THE FIELD MODIFICATIONS TO THE PLANS.  
BY: BKF ENGINEERS DATE: JUNE 2011

College of San Mateo  
Site Package  
San Mateo, CA

Revision	Description	Date

Revision	Description	Date

Job No.	27062.30
Date	02 APRIL 2009
Drawn by	MD, JT
Checked by	RH
Scale	1"=20'

**DEMOLITION PLAN**

**C3.09**