



Revision	Description	Date

Revision	Description	Date
01	SUBMITTAL	19 SEPT 2008
02	FINAL	09 APRIL 2009
03	REVISION OF 82	14 FEB 2011
04	PROJECT RECORD DRAWING	JUNE 2011

Job No.	27082.30
Date	02 APRIL 2009
Drawn by	MD, JT
Checked by	RH
Scale	1"=20'

**GRADING AND DRAINAGE PLAN ENLARGEMENTS**

**C5.35**

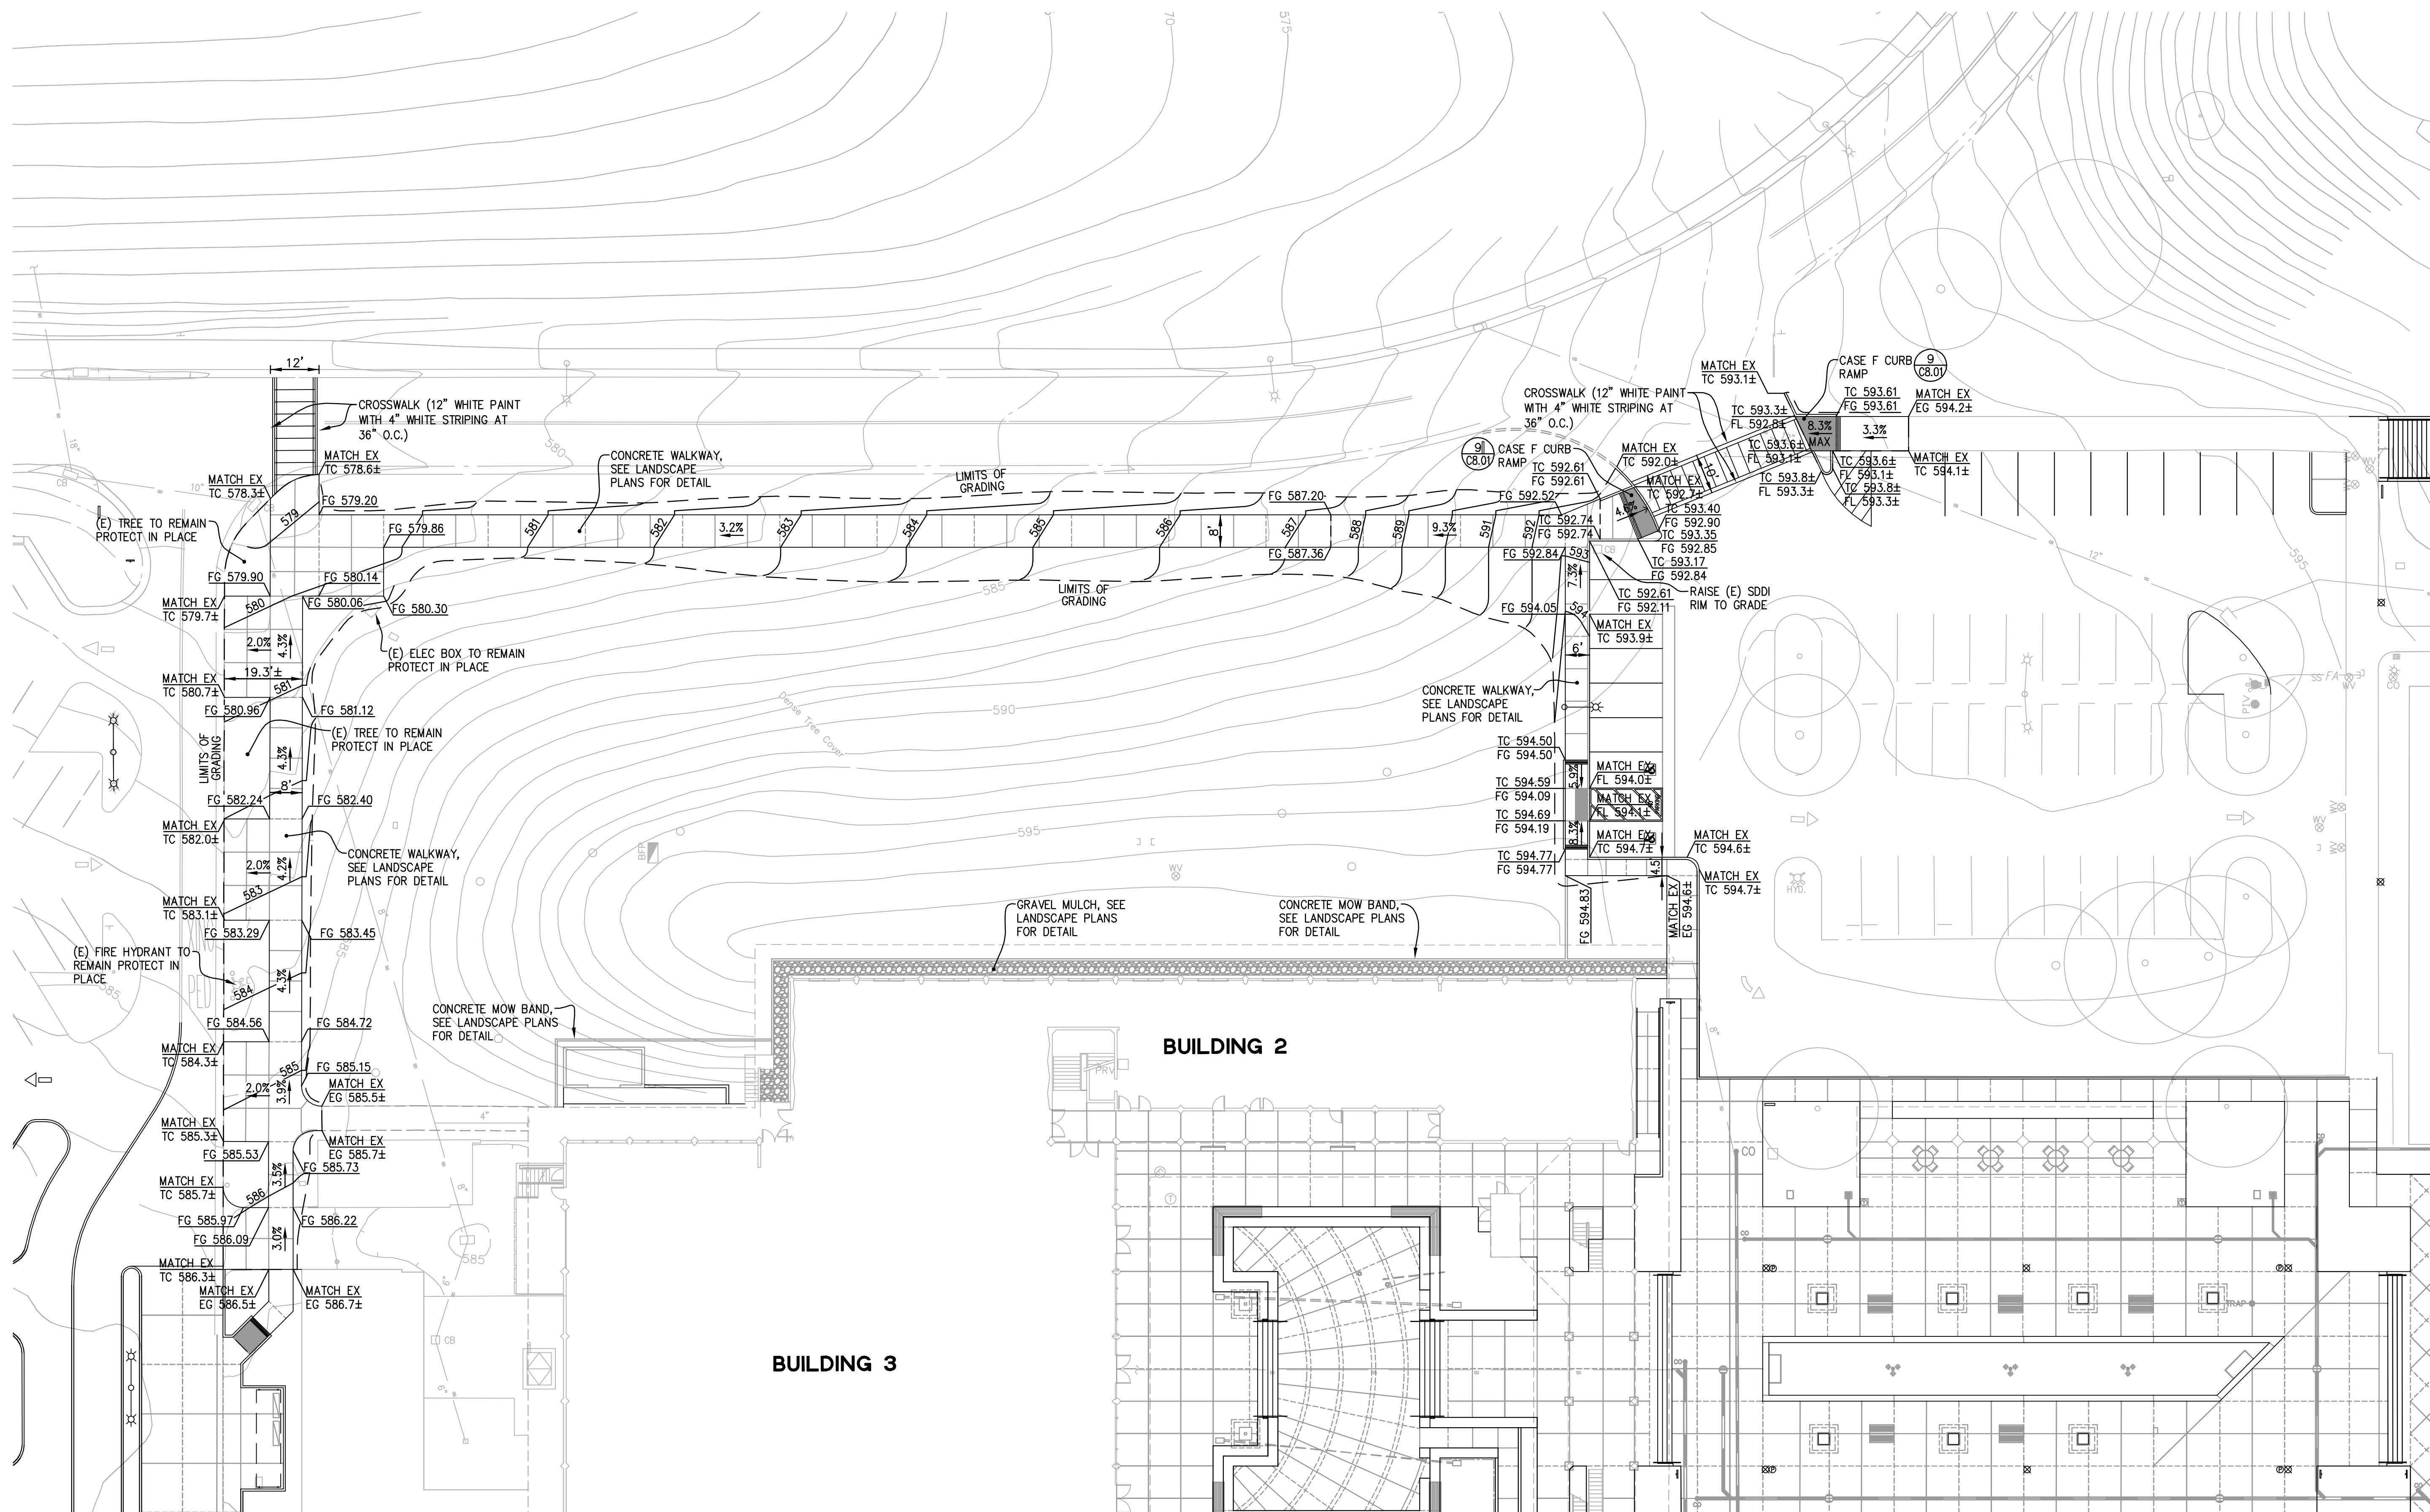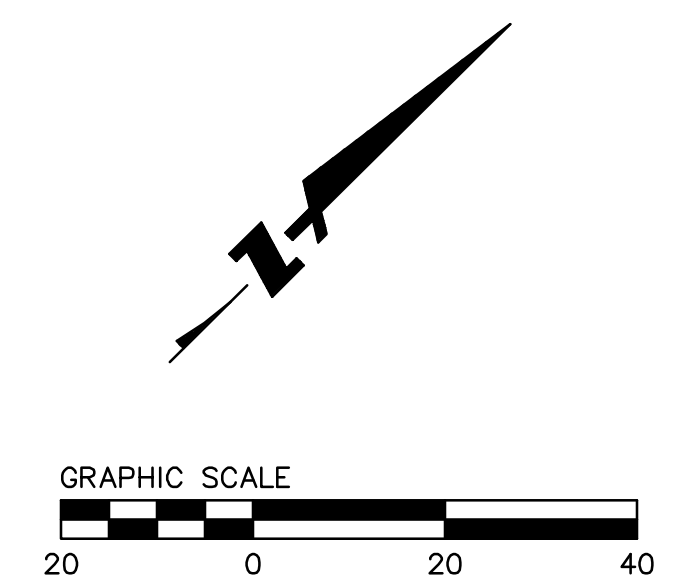

**RECORD DRAWINGS**  
 THESE RECORD DOCUMENTS HAVE BEEN PREPARED BASED ON INFORMATION PROVIDED BY OTHERS. BKF ENGINEERS HAS NOT VERIFIED THE ACCURACY AND/OR COMPLETENESS OF THIS INFORMATION AND SHALL NOT BE RESPONSIBLE FOR ANY ERRORS OR OMISSIONS THAT MAY BE INCORPORATED HEREIN AS A RESULT. BKF ENGINEERS DOES NOT ASSUME ANY RESPONSIBILITY FOR THE FIELD MODIFICATIONS TO THE PLANS.  
 BY: BKF ENGINEERS      DATE: JUNE 2011