



McCarthy Building Companies, Inc.
343 Sansome Street, 14th Floor
San Francisco, California 94104
P 415 | 364-1339
F 415 | 397-5999



BKF ENGINEERS / SURVEYORS / PLANNERS
255 SHORELINE DRIVE, SUITE 200
REDWOOD CITY, CA 94065
PHONE: (650) 482-6300
FAX: (650) 482-6399



IDENTIFICATION STAMP
DIV. OF THE STATE ARCHITECT
OFFICE OF REGULATION SERVICE
APPL. #: 01-110097
AC: FLS SS
FILE NUMBER:

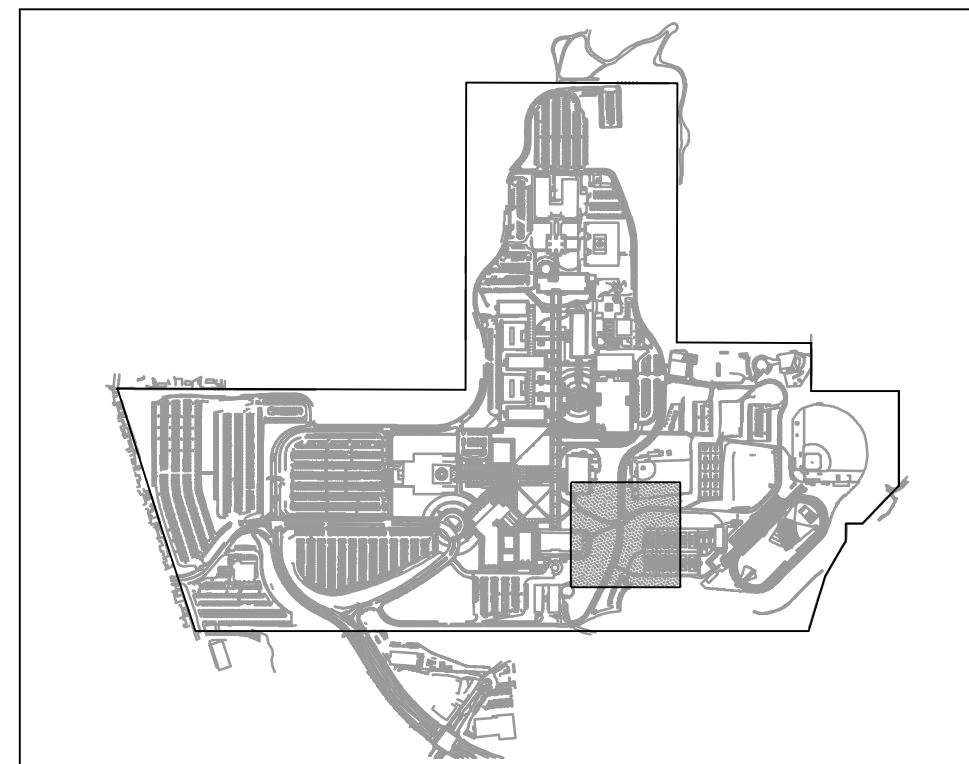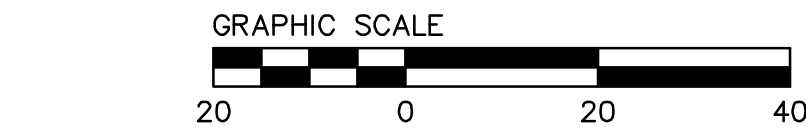

NOTES

- 1. SEE SHEETS C8.03 THROUGH C8.05 FOR UTILITY DETAILS.

This set of other project documents and all items, including and design incorporated therein are instruments of service. All project documents are the registered property of LPA, INC. LPA, INC. and cannot be made, used, in whole or in part, for any other project without the written consent of LPA, INC. The user of this set of project documents is deemed to be in agreement with LPA, INC. and the State of California. LPA, INC. hereby grants the user the right to use this set of project documents for reproduction or modification (revised) is not only authorized but is required. User shall retain all rights, including but not limited to, all intellectual property rights in this set of project documents. LPA, INC. and LPA, INC. Consultants make no representation concerning the accuracy of documents and are not responsible for any discrepancies between project documents and the existing conditions.

© Copyright 2008

RECORD DRAWINGS
THESE RECORD DOCUMENTS HAVE BEEN PREPARED BASED ON INFORMATION PROVIDED BY OTHERS. BKF ENGINEERS HAS NOT VERIFIED THE ACCURACY AND/OR COMPLETENESS OF THIS INFORMATION AND SHALL NOT BE RESPONSIBLE FOR ANY ERRORS OR OMISSIONS THAT MAY BE INCORPORATED HEREIN AS A RESULT. BKF ENGINEERS DOES NOT ASSUME ANY RESPONSIBILITY FOR THE FIELD MODIFICATIONS TO THE PLANS.

BY: BKF ENGINEERS DATE: JUNE 2011

Revision	Description	Date
01	ISSUED FOR PERMIT	08 SEPT 2008
02	FOR CONSTRUCTION	09 APRIL 2009
03	PROJECT RECORD DRAWING	JUNE 2011

Job No.	27082.30
Date	02 APRIL 2009
Drawn by	MD, JT
Checked by	RH
Scale	1"=20'

UTILITY PLAN

C6.06