



IDENTIFICATION STAMP	DIV. OF THE STATE ARCHITECT	OFFICE OF REGULATION SERVICE
		APPL. # 01-110097
AC.	FLS	SS
DATE		
FILE NUMBER		

This is a copy of the project document and it does not contain any confidential or sensitive information. All plans and designs incorporated herein are instruments of service. All rights reserved. LPA and McCarthy Building Companies, Inc. (LPA) and cannot be lawfully used in whole or in part for any purpose without the express written consent of McCarthy and the District. LPA hereby grants permission to McCarthy to use this drawing in its entirety or in part, or any portion thereof, for the purpose of reproduction or modification. Printed is not only unlawful but unauthorized use of this drawing by anyone other than the intended and defined LPA and LPA's Consultants to the project, or anyone else, is a violation of state and federal laws, and is liable for damages. Any unauthorized use of this drawing, or any portion thereof, is a violation of state and federal laws, and is liable for damages. LPA grants no express or implied warranties with respect to the accuracy of documents and does not assume responsibility for any discrepancies between project documents and the existing conditions.

© Copyright 2008


**College of San Mateo**  
**Site Package**  
San Mateo, CA

Developed for  
San Mateo County Community College District


Revision Description	Date
DSA SUBMITTAL	19 SEPT 2009
DSA FINAL	09 APRIL 2010
PLAN CHECK COMMENTS REV 9 OCT 2009	
DRAWING GF RECORD	19 OCT 2009
POOL LTC & TEL/DATA REV 19 OCT 2009	
PHASE 1	05 AUG 2010
FINE ARTS COURTYARD	04 NOV 2011
DRAWING OF RECORD	

Revision Description	Date
DSA SUBMITTAL	19 SEPT 2009
DSA FINAL	09 APRIL 2010
PLAN CHECK COMMENTS REV 9 OCT 2009	
DRAWING GF RECORD	19 OCT 2009
POOL LTC & TEL/DATA REV 19 OCT 2009	
PHASE 1	05 AUG 2010
FINE ARTS COURTYARD	04 NOV 2011
DRAWING OF RECORD	

Job No.	300085
Date	09 APRIL 2009
Drawn by	REI CAD TEAM
Checked by	THSFRW
Scale	AS SHOWN
ELECTRICAL PLAN SITE	
<b>E2.09</b>	

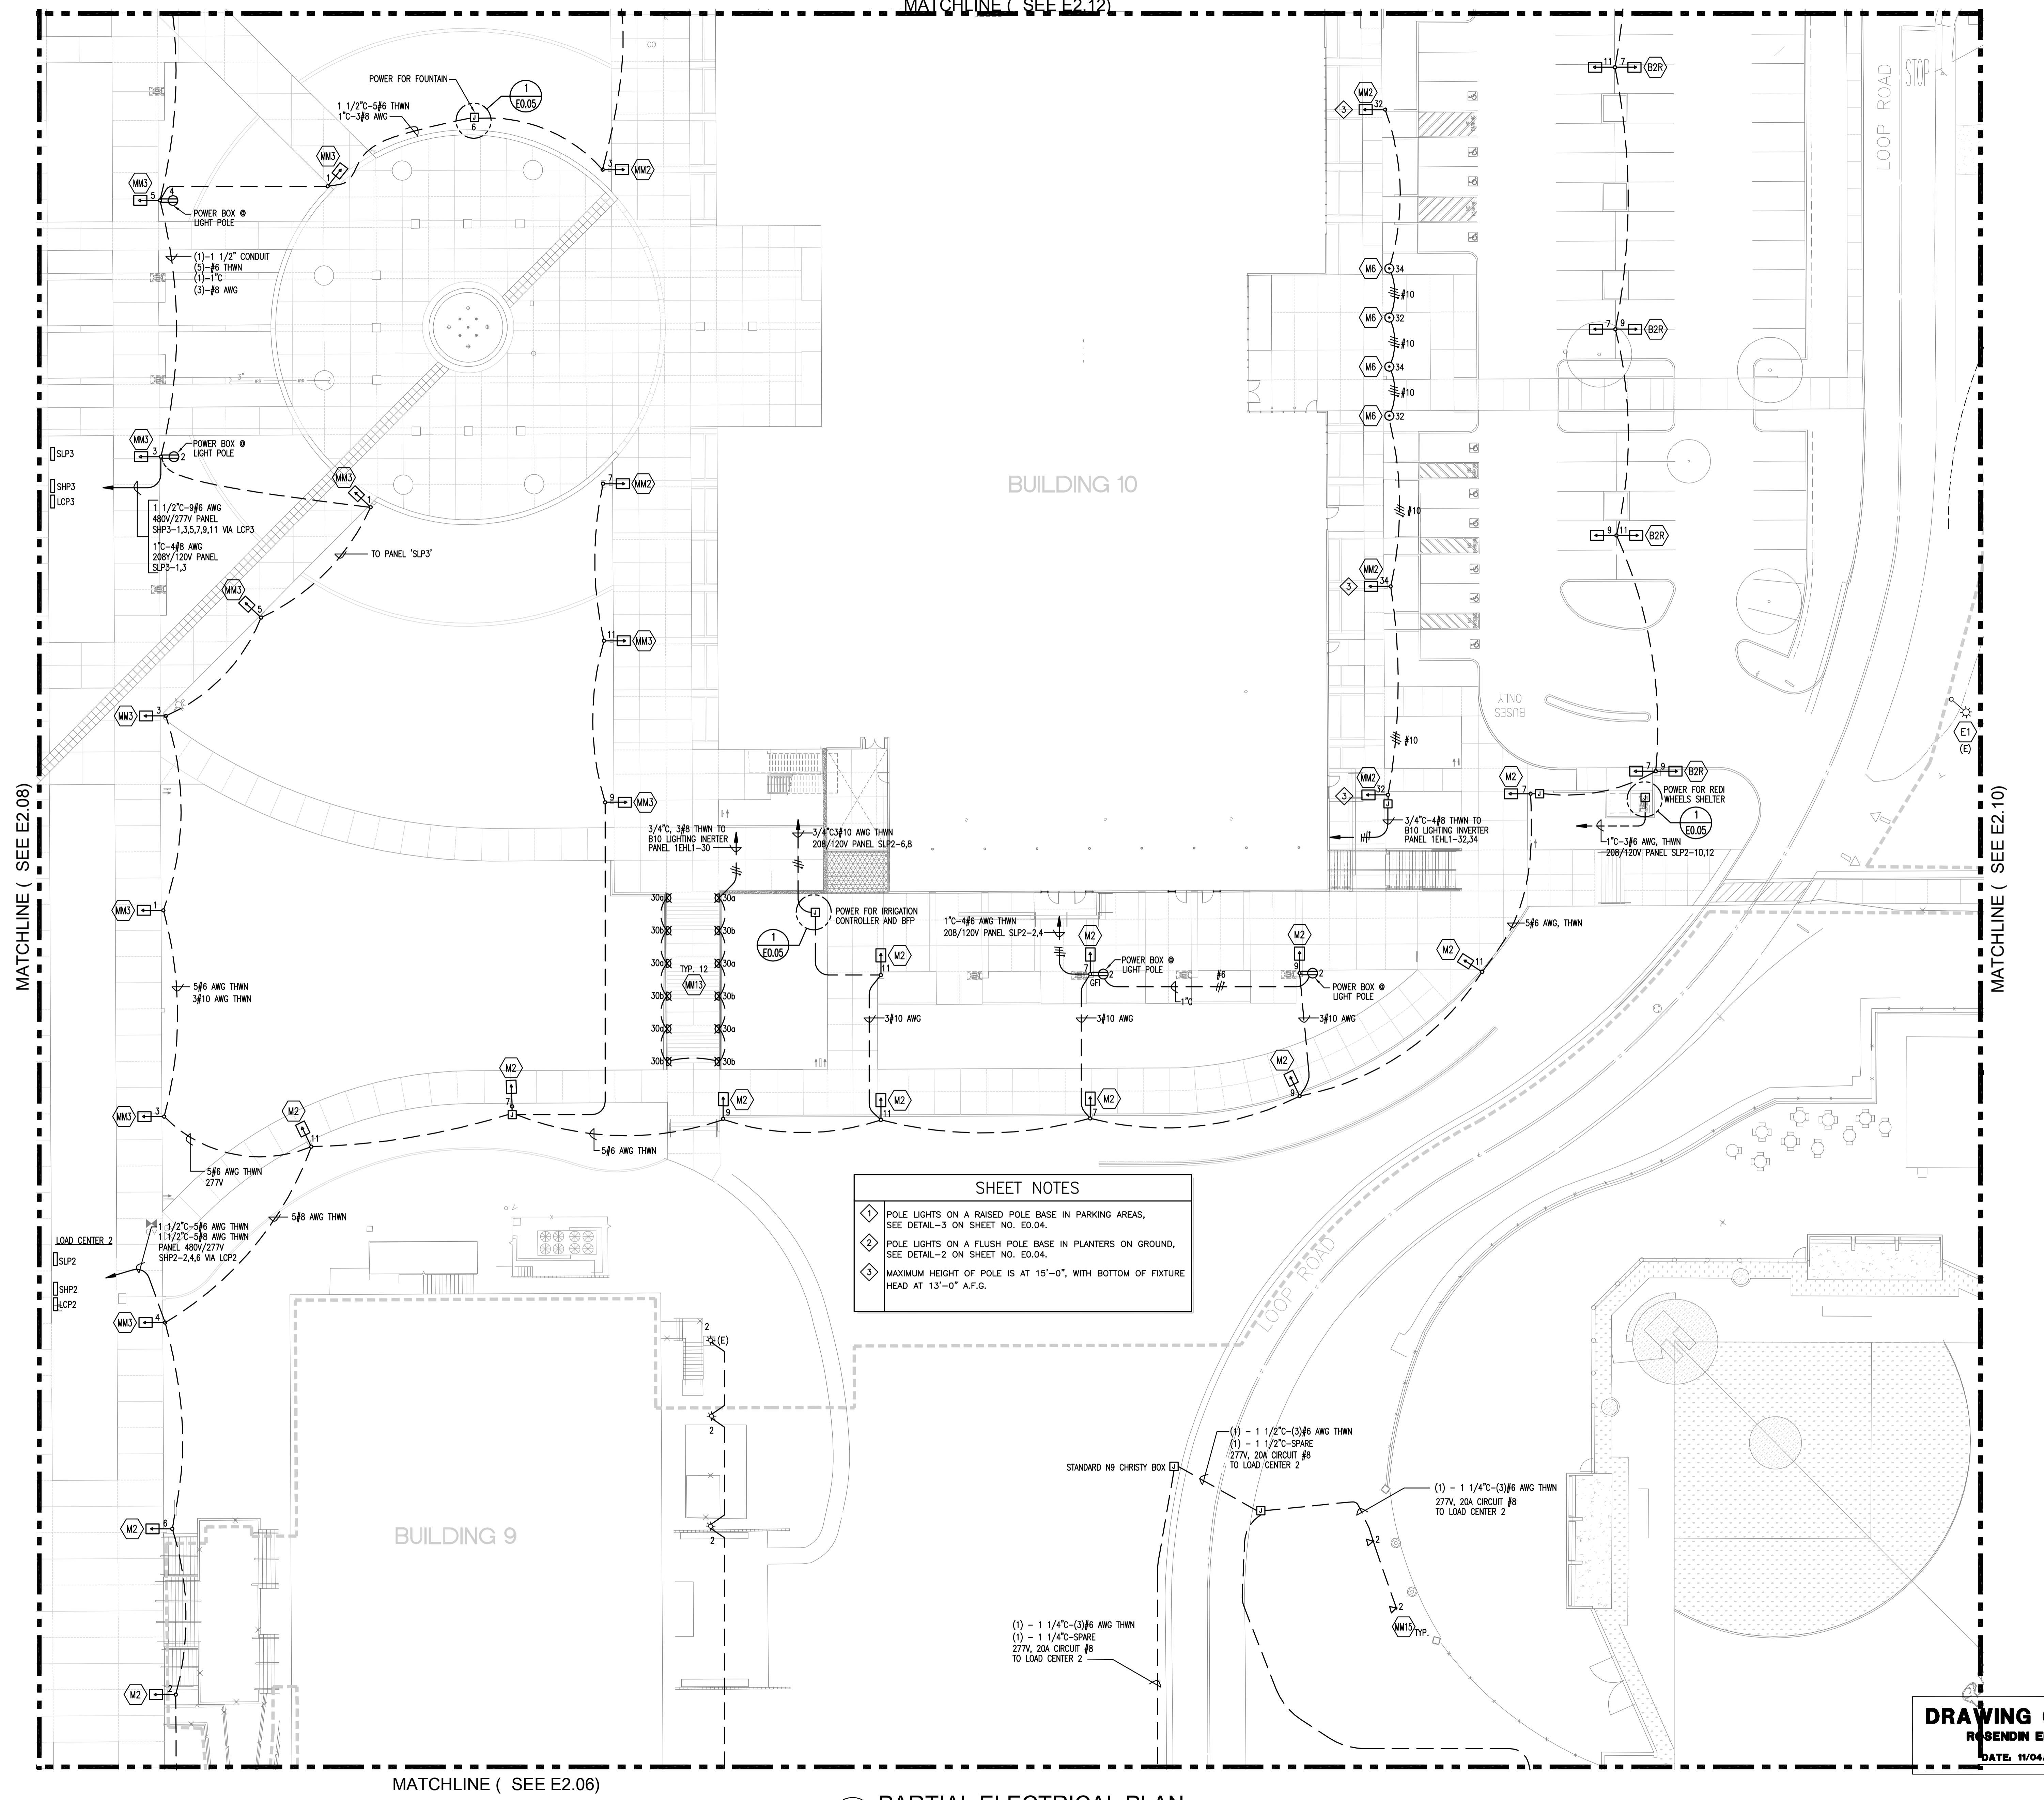



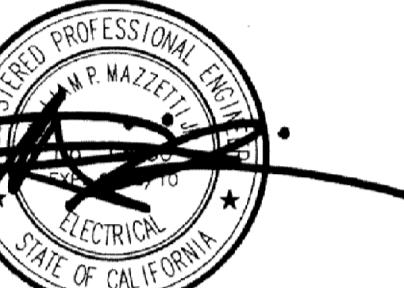

IDENTIFICATION STAMP	DIV. OF THE STATE ARCHITECT	OFFICE OF REGULATION SERVICE
	APPL. #:	01-110097
AC.	FLS	SS
DATE:		
FILE NUMBER:		

No part of this project document and of McCarthy and Rosendin incorporated therein are instruments of service. All rights reserved. This document is the sole property of McCarthy and Rosendin and cannot be lawfully used in whole or in part for any purpose without the express written consent of McCarthy and Rosendin. LPA hereby grants a limited license to the user to make one copy of this document for internal use only. Any other use, including but not limited to reproduction or modification, printed or otherwise, is not only unlawful but unauthorized. It is the intent of McCarthy and Rosendin that the information contained herein be used only for the internal use and defined use and LPA's Consents to the same. Any unauthorized use, including but not limited to reproduction, printed or otherwise, or any other use, including but not limited to modification, printed or otherwise, is not only unlawful but unauthorized. It is the intent of McCarthy and Rosendin that the information contained herein be used only for the internal use and defined use and LPA's Consents to the same. LPA grants no rights to the user to reproduce, print or otherwise use or copy any portion of this document or any other document between project documents and the existing conditions.

© Copyright 2008

**College of San Mateo**  
**Site Package**  
San Mateo, CA

Developed for  
San Mateo County Community College District

Revision Description	Date
DSA SUBMITTAL	19 SEPT 2009
DSA FINAL	09 APRIL 2009
PLAN CHECK COMMENTS REV 9 OCT 2009	
DRAWING OF RECORD	19 OCT 2009
PHASE 1 POL. LIG. & TEL/DATA REV 19 OCT 2009	
PHASE 1 BOLLARDS REV 05 AUG 2010	
FINE ARTS COURTYARD DRAWING OF RECORD	04 NOV 2011

Revision Description	Date
DSA SUBMITTAL	19 SEPT 2009
DSA FINAL	09 APRIL 2009
PLAN CHECK COMMENTS REV 9 OCT 2009	
DRAWING OF RECORD	19 OCT 2009
PHASE 1 POL. LIG. & TEL/DATA REV 19 OCT 2009	
PHASE 1 BOLLARDS REV 05 AUG 2010	
FINE ARTS COURTYARD DRAWING OF RECORD	04 NOV 2011

Job No.	300085
Date	09 APRIL 2009
Drawn by	REI CAD TEAM
Checked by	THSR/FRW
Scale	AS SHOWN
ELECTRICAL PLAN SITE	
E2.11	

**SHEET NOTES**


(E) POLE LIGHTS ON A RAISED POLE BASE IN PARKING AREAS, SEE DETAIL-3 ON SHEET NO. E0.04.


(E) POLE LIGHTS ON A FLUSH POLE BASE IN PLANTERS ON GROUND, SEE DETAIL-2 ON SHEET NO. E0.04.

1 PARTIAL ELECTRICAL PLAN  
E2.11 SCALE: 1" = 20'-0"

**DRAWING OF RECORD**  
ROSENDIN ELECTRIC, INC.  
DATE: 11/04/11

MATCHLINE ( SEE E2.08)

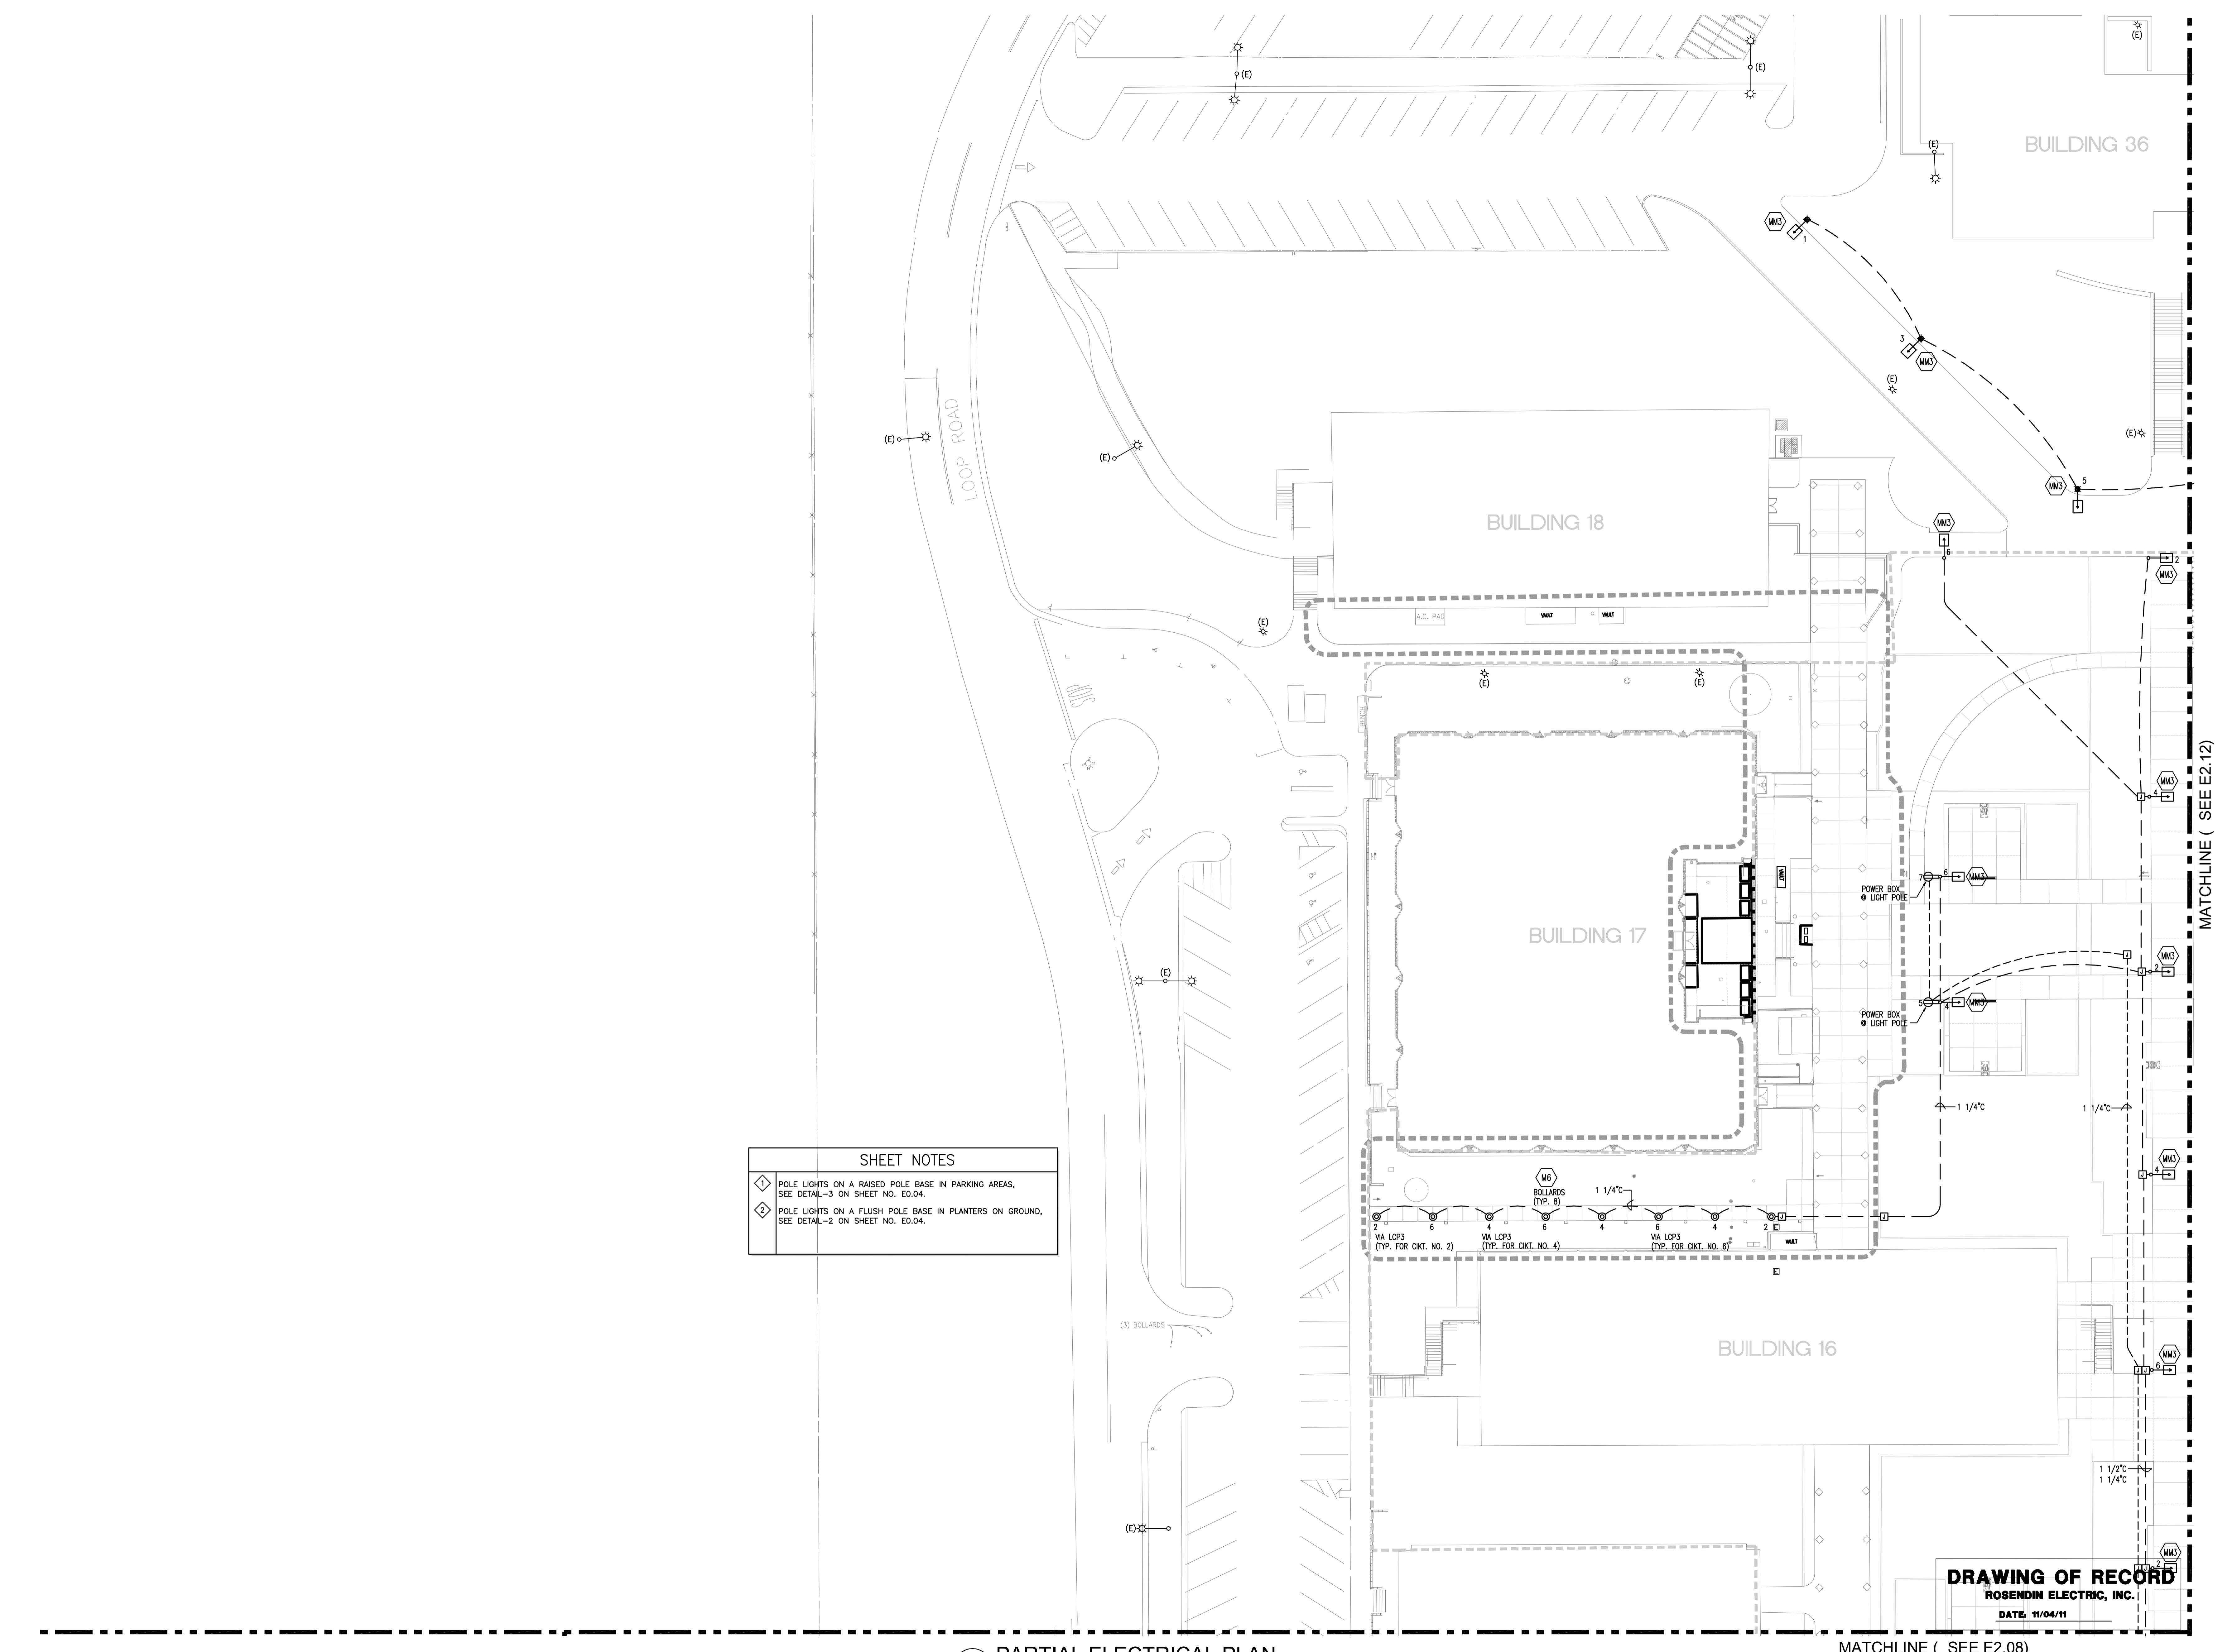

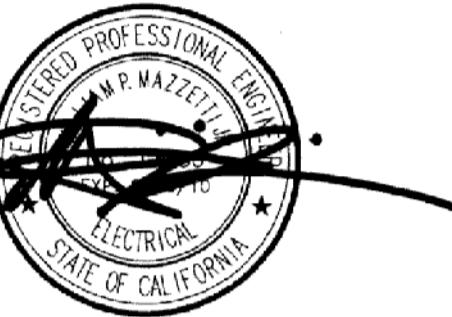

IDENTIFICATION STAMP	APPL. #:	01-110097
DIV. OF THE STATE ARCHITECT	OFFICE OF REGULATION SERVICE	
AC.	FLS	SS
DATE		
FILE NUMBER:		

This sheet and all other project documents and all plans, drawings, specifications, and designs incorporated therein are instruments of service. All plans, drawings, specifications, and designs are the property of McCarthy Building Companies, Inc. (MBCI) and cannot be lawfully used in whole or in part for any purpose without the written consent of MBCI. LPA hereby grants to McCarthy Building Companies, Inc. (MBCI) a non-exclusive license to reproduce or modify the same. LPA's grant of rights herein is not only limited but also subject to MBCI's right to cancel such license at any time if MBCI determines and defines LPA and LPA's Consultants to be in violation of the terms and conditions of this agreement. LPA and LPA's Consultants shall be liable for damages arising directly or indirectly from project documents and drawings and are not responsible for any damages resulting from any misinterpretation of documents and are not responsible for any discrepancies between project documents and the existing conditions.


© Copyright 2008


College of San Mateo  
Site Package  
San Mateo, CA

Developed for  
San Mateo County Community College District

Revision Description	Date
DSA SUBMITTAL	19 SEPT 2009
DSA FINAL	09 APRIL 2010
PLAN CHECK COMMENTS REV 9 OCT 2009	
DRAWING GF RECORD	19 OCT 2009
POL, LTC & TEL/DATA REV 19 OCT 2009	
PHASE 1	05 AUG 2010
FINE ARTS COURTYARD	04 NOV 2011
DRAWING OF RECORD	

Job No.	300085
Date	09 APRIL 2009
Drawn by	REI CAD TEAM
Checked by	THSF/RW
Scale	AS SHOWN
ELECTRICAL PLAN SITE	
E2.12	

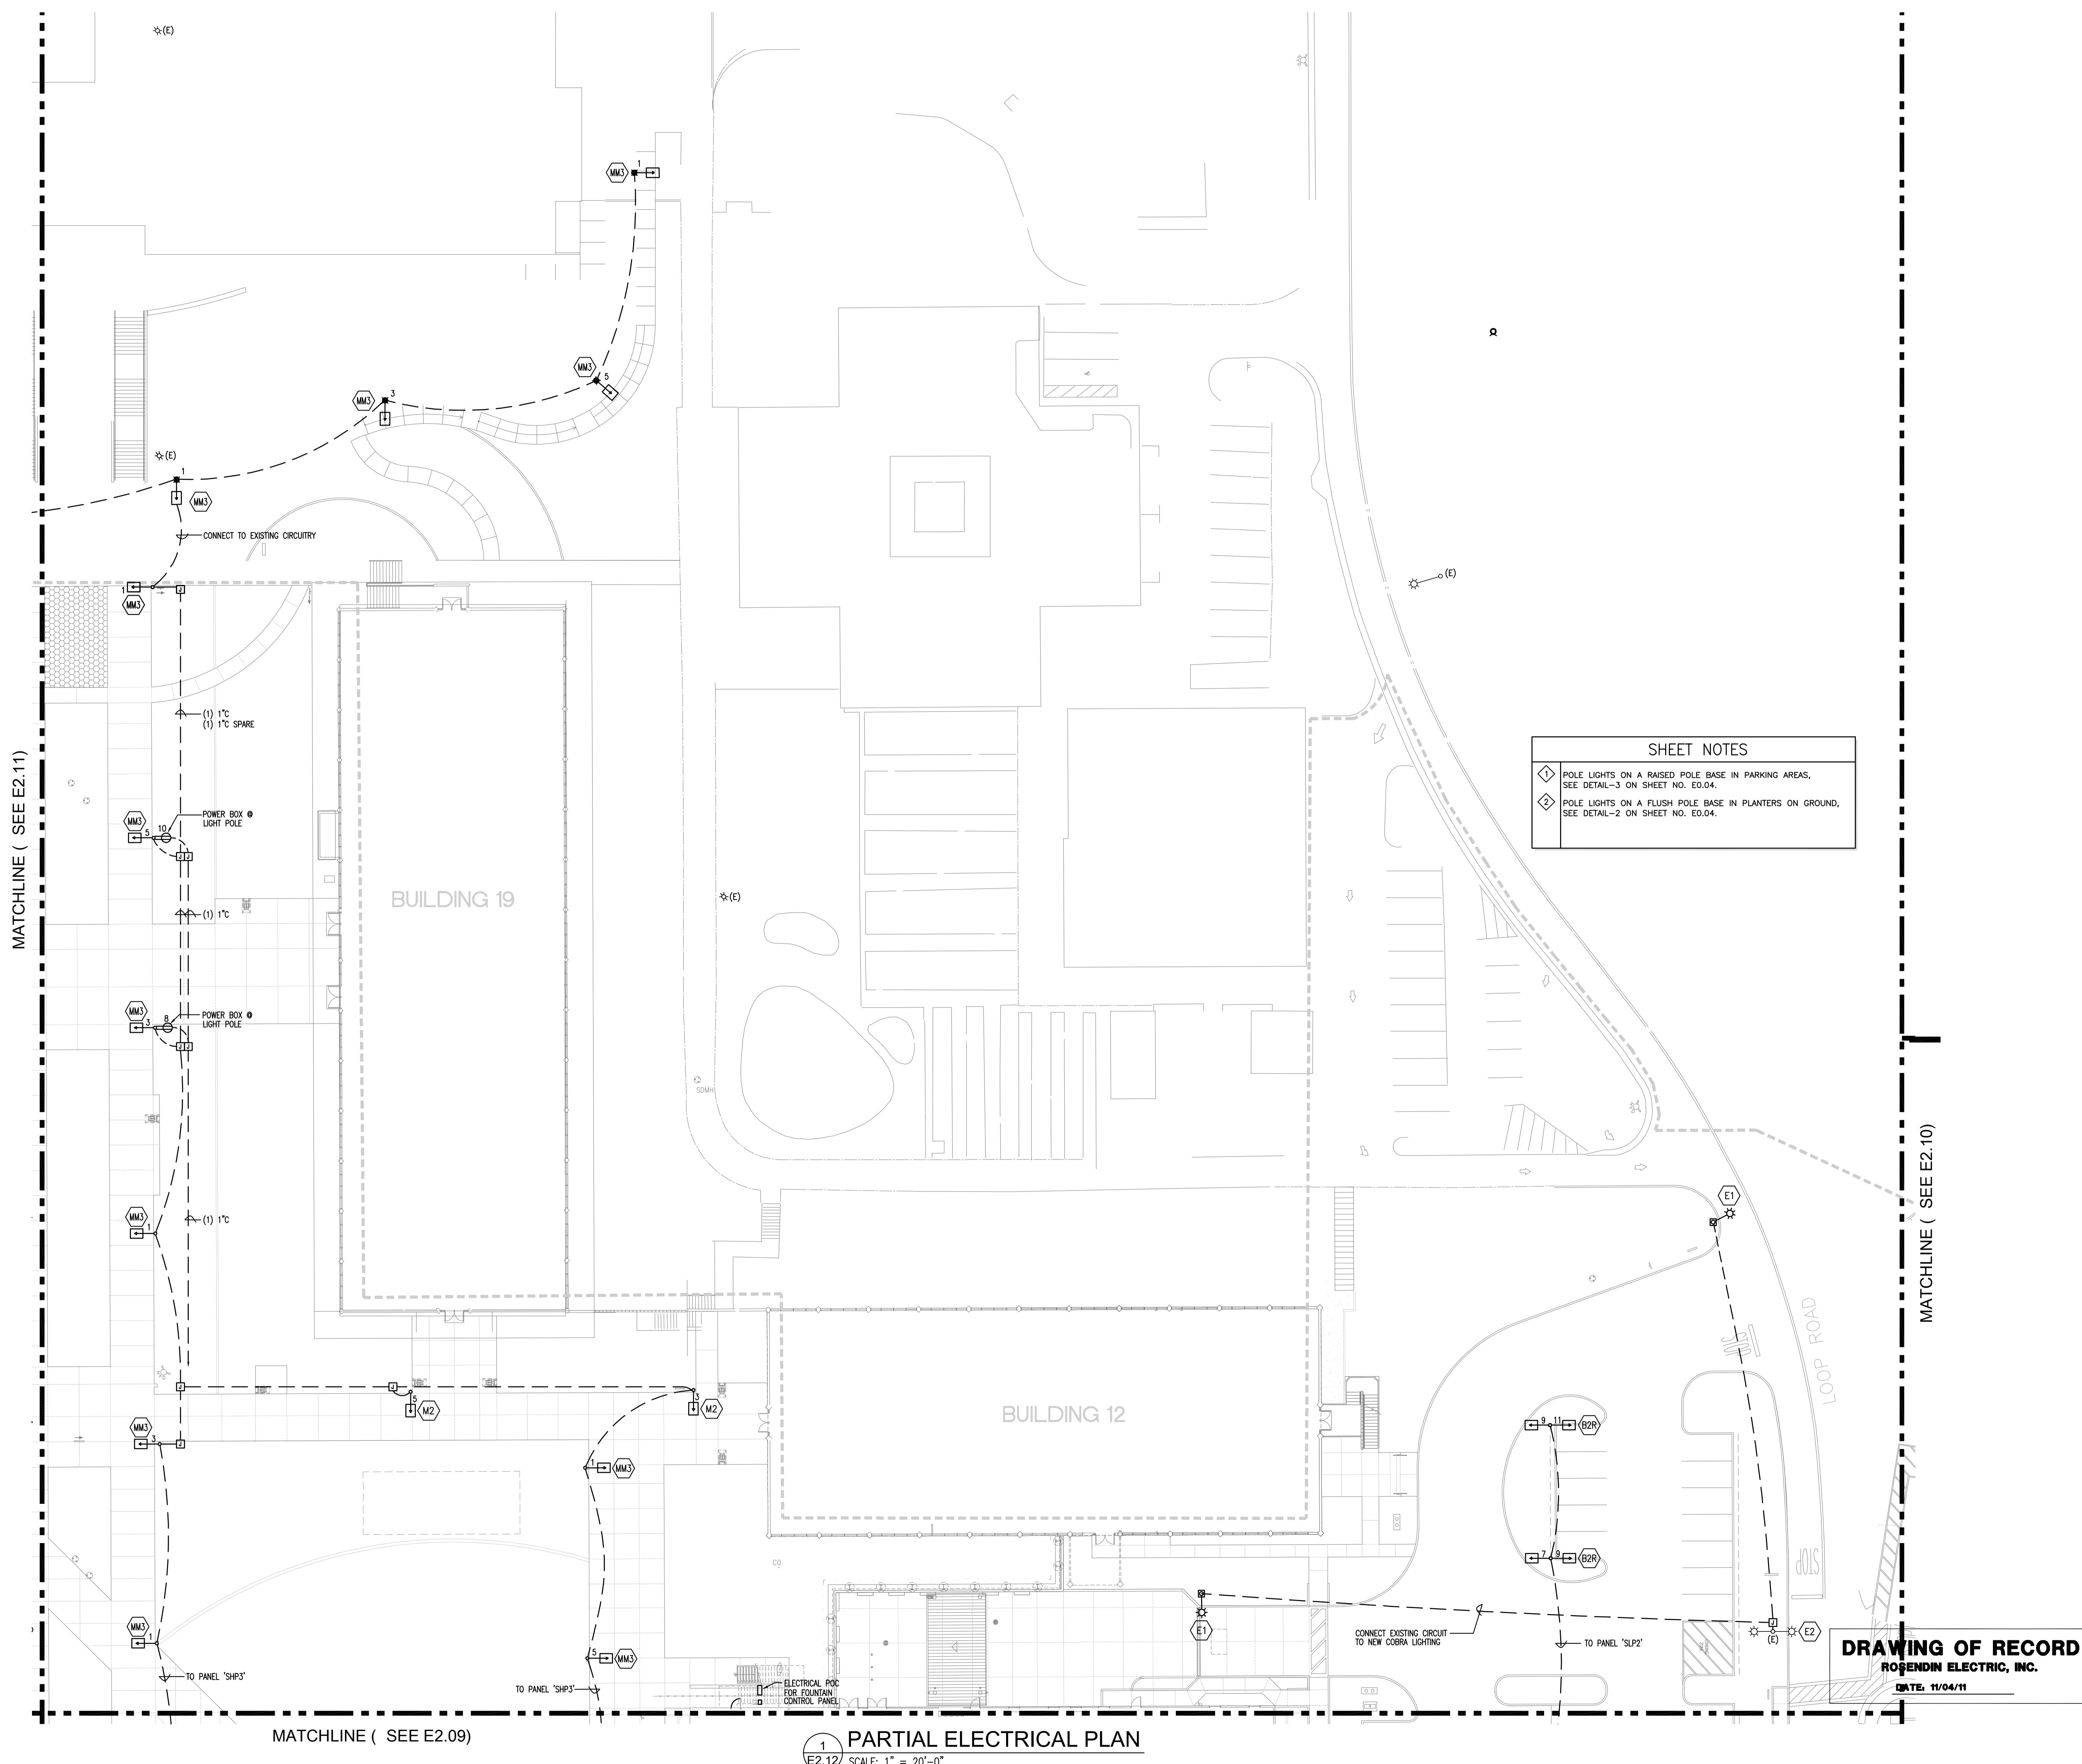

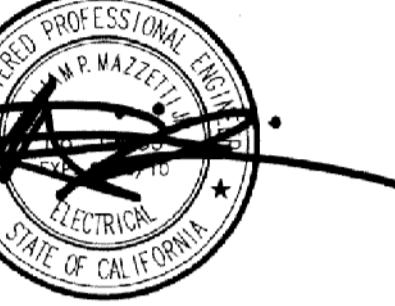

IDENTIFICATION STAMP
DIV. OF THE STATE ARCHITECT
OFFICE OF REGULATION SERVICE
APPL. # 01-110097
AC. FLS SS
DATE
FILE NUMBER

This set of project documents and all associated designs incorporated therein are instruments of service. All rights reserved. No part of these documents (DPA) and content can be lawfully used in whole or in part for any purpose without the express written consent of McCarthy and LPA. Any unauthorized use, reproduction or modification (revised) is not only unlawful but also violates the terms of the contract between McCarthy and defendant LPA and LPA's Consultants for the issuance of the original documents. The revised documents are not a representation of as-built or existing conditions. LPA does not accept responsibility for any discrepancy in the accuracy of documents and the existing conditions between project documents and the existing conditions.

© Copyright 2008


**College of San Mateo**  
**Site Package**  
San Mateo, CA


Developed for  
San Mateo County Community College District

Revision Description	Date
DSA SUBMITTAL	19 SEPT 2009
DSA FINAL	09 APRIL 2010
PLAN CHECK COMMENTS REV 9 OCT 2009	19 OCT 2009
DRAWINGS OF RECORD	19 OCT 2009
POOL LIC & TEL/DATA REV 19 OCT 2009	19 OCT 2009
PHASE 1	05 AUG 2010
FINE ARTS COURTYARD	04 NOV 2011
DRAWING OF RECORD	04 NOV 2011

Revision Description	Date
DSA SUBMITTAL	19 SEPT 2009
DSA FINAL	09 APRIL 2010
PLAN CHECK COMMENTS REV 9 OCT 2009	19 OCT 2009
DRAWINGS OF RECORD	19 OCT 2009
POOL LIC & TEL/DATA REV 19 OCT 2009	19 OCT 2009
PHASE 1	05 AUG 2010
FINE ARTS COURTYARD	04 NOV 2011
DRAWING OF RECORD	04 NOV 2011

Job No.	300085
Date	09 APRIL 2009
Drawn by	REI CAD TEAM
Checked by	THSF/RW
Scale	AS SHOWN
ELECTRICAL PLAN SITE	
<b>E2.13</b>	

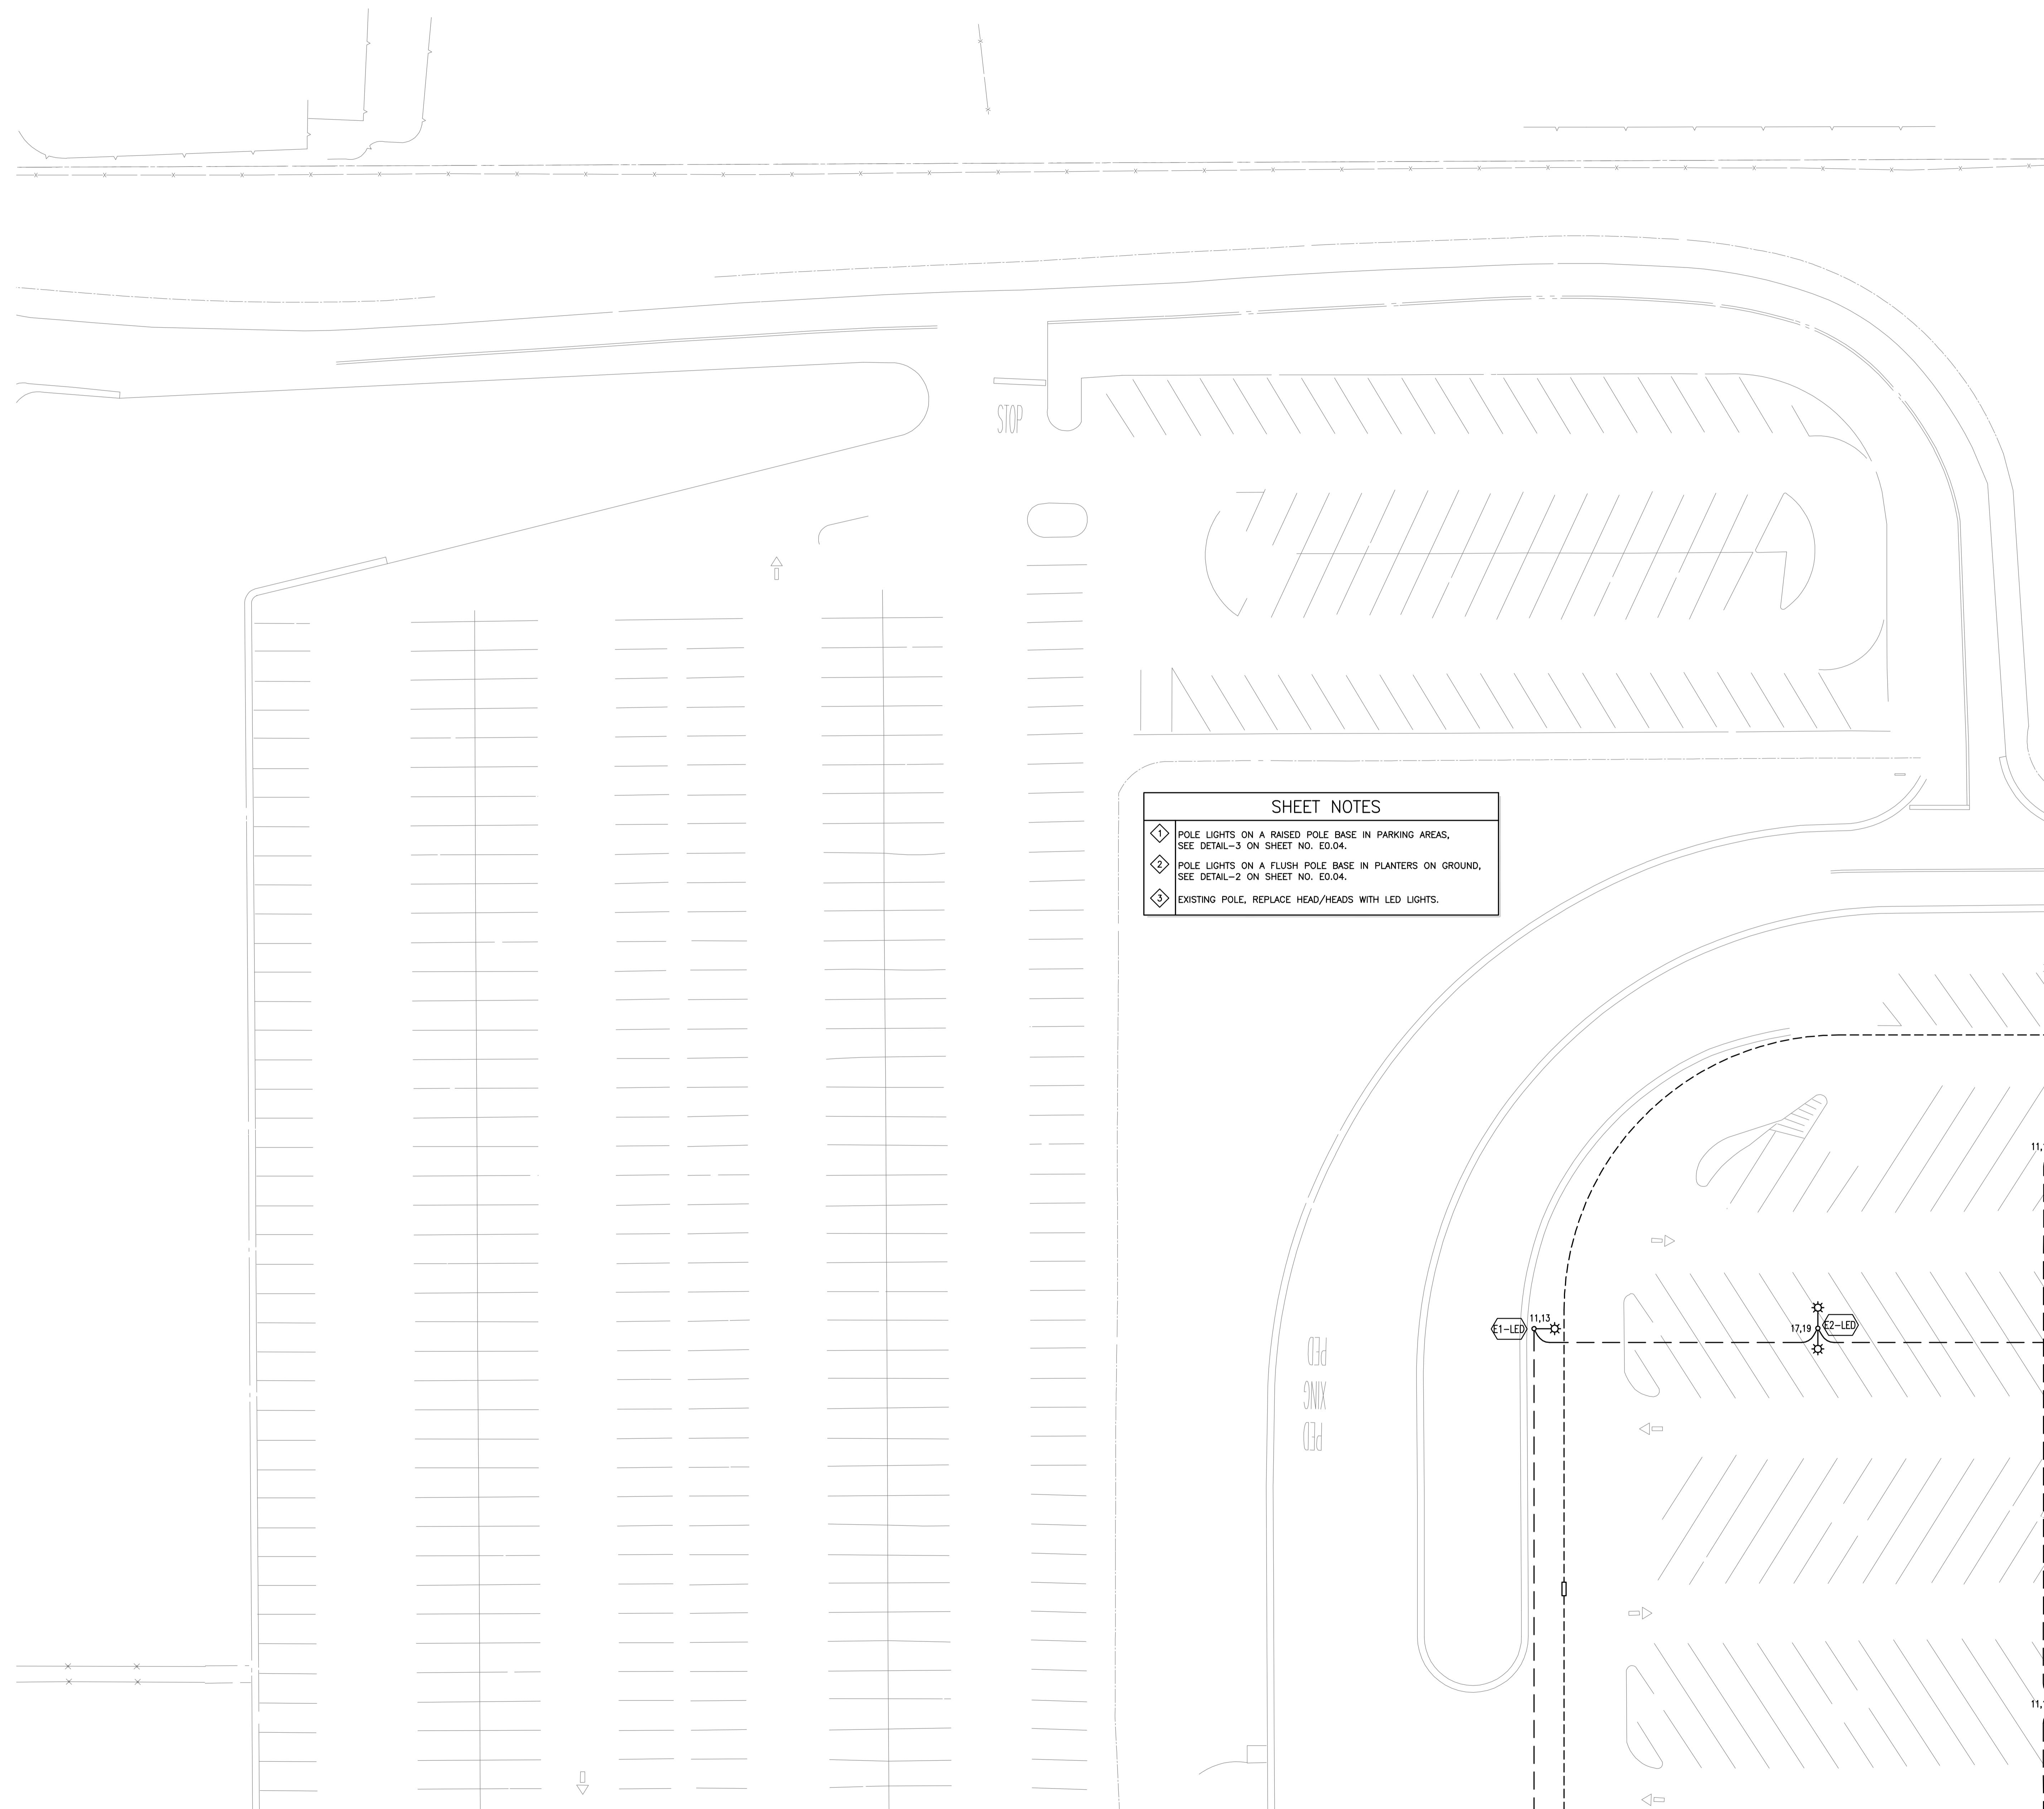

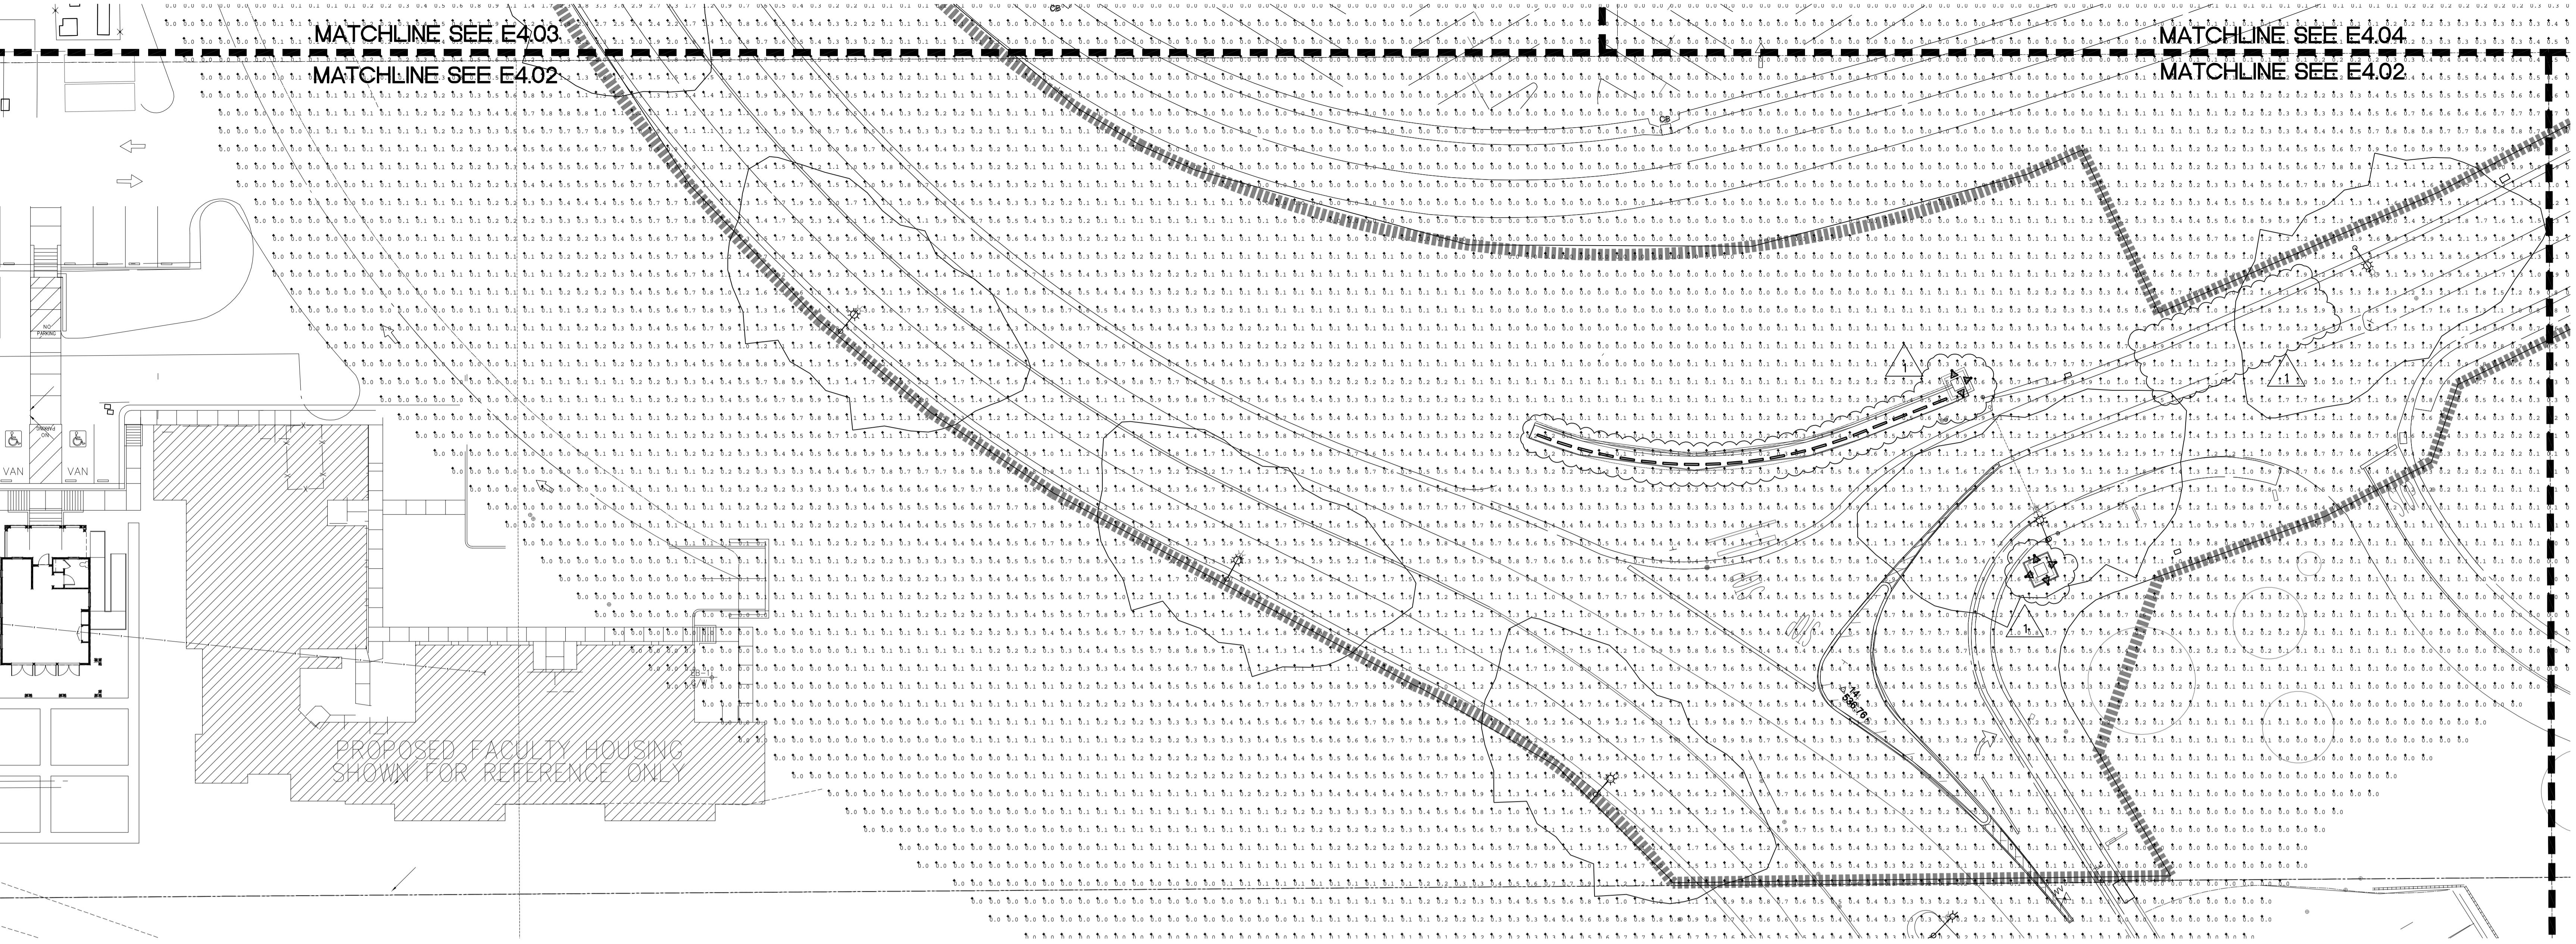

**MCCARTHY**

LPA

KH

McCarthy Building Companies, Inc.  
43 Sansome Street, 14th Floor  
San Francisco, California 94104  
415 | 364-1339  
415 | 397-5999

IDENTIFICATION STAMP  
DIV. OF THE STATE ARCHITECT  
OFFICE OF REGULATION SERVICE

This and all other project documents and all ideas, aesthetic and designs incorporated therein are instruments of service. project documents are the registered property of LPA, INC. (LPA) and cannot be lawfully used in whole or in part for any project or purpose except as described in the contractual agreement between McCarthy and the District. LPA hereby gives formal notice that any such project document use, reproduction or modification (misuse) is not only unlawful but automatically binds all parties involved with misuse to fully indemnify and defend LPA and LPA's Consultants to the maximum legal extent against all losses, demands, claims or liabilities arising directly or indirectly from project document misuse. Project documents describe design intent of work and are not a representation of as-built or existing conditions. LPA and LPA's Consultants make no representations concerning the accuracy of documents and are not responsible for any discrepancies between project documents and the existing conditions.

Copyright 2008

# **College of San Mateo**

## **Site Package**

San Mateo, CA

# **College of San Mateo**

## **Site Package**

San Mateo, CA

Revision	Description	Date
	</td	

Revision	Description	Date
	DSA SUBMITTAL	19 SEPT 2008
	DSA FINAL	09 APRIL 2009
 1	PLAN CHECK COMMENTS-REV 19 OCT 2009	
 2	DRAWING OF RECORD	19 OCT 2009
 3	POOL LTG & TEL/DATA REV	19 OCT 2009

Job. No.	300085
Date	09 APRIL 2009
Drawn by	REI CAD TEAM
Checked by	TH/SF/RW
Scale	AS SHOWN

**REFERENCE ONLY**  
**NOT FOR AS-BUILTS**  
**ROSENDIN ELECTRIC, INC.**

L:\Eng\_2\Current Projects\College of San Mateo Site Ltg\_300085\Cad\300085\_Site Lt\_E4.01-E4.12.dwg – Feb 07, 2012 Tuesday – 8:17am – 30x42–Plt\_E4.01 – wecheverria



**IDENTIFICATION STAMP**  
**DIV. OF THE STATE ARCHITECT**  
**OFFICE OF REGULATION SERVICE**

This and all other project documents and all ideas, concepts and designs incorporated therein are instruments of service. Project documents are the registered property of LPA, INC. (LPA) and cannot be lawfully used in whole or in part for project or purpose except as described in the contractual agreement between McCarthy and the District. LPA hereby gives formal notice that any such project document use, reproduction or modification (misuse) is not only unlawful; automatically binds all parties involved with misuse to fully indemnify and defend LPA and LPA's Consultants to the maximum legal extent against all losses, demands, claims and liabilities arising directly or indirectly from project document misuse. Project documents describe design intent of work and are not a representation of as-built or existing conditions. LPA and LPA's Consultants make no representations concerning the accuracy of documents and are not responsible for discrepancies between project documents and the existing conditions.


Copyright 2008

# **College of San Mateo Site Package**

**College  
Site Pack**

Date								
------	--	--	--	--	--	--	--	--

Job. No.	30008
Date	09 APRIL 2008
Drawn by	REI CAD TEAM
Checked by	TH/SF/RV
Scale	AS SHOWN
<p><b>Site Lighting Plan -</b> <b>Ltg. Extended</b> <b>Photometric</b></p> <p><b>E4.03</b></p>	

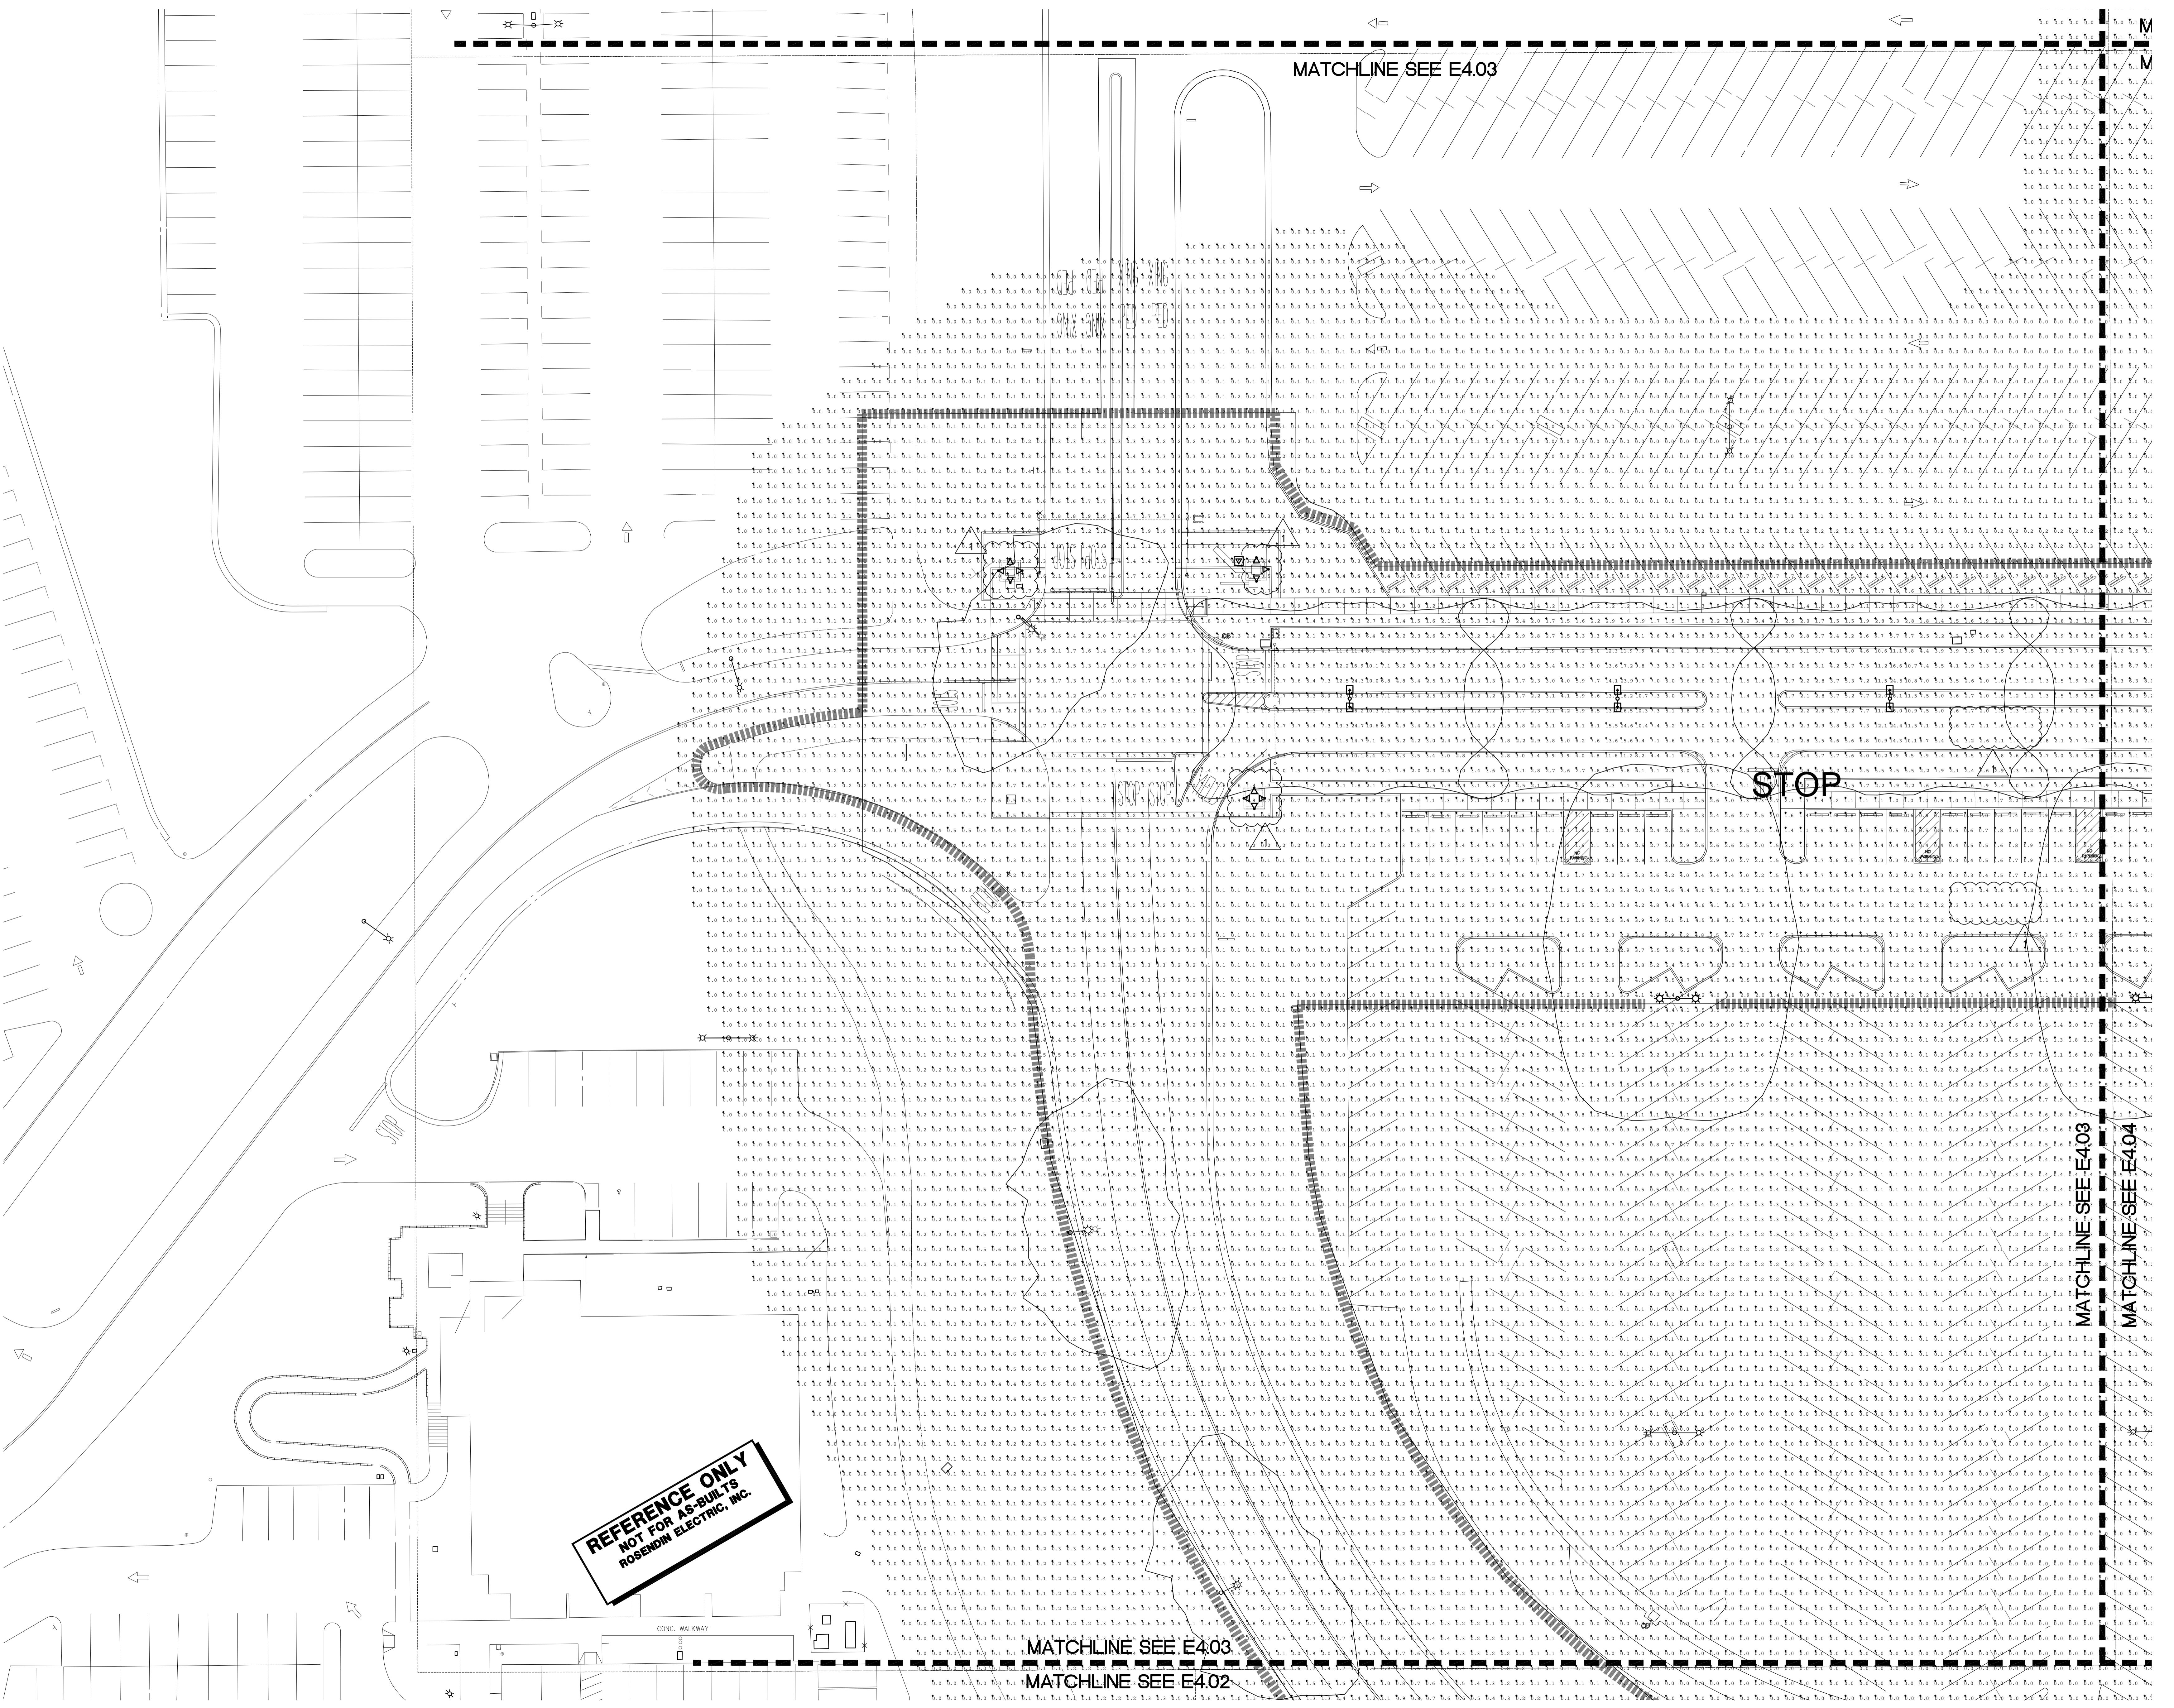



**IDENTIFICATION STAMP**  
**DIV. OF THE STATE ARCHITECT**  
**OFFICE OF REGULATION SERVICE**

This and all other project documents and all ideas, aesthetics and designs incorporated therein are instruments of service. Project documents are the registered property of LPA, INC. (LPA) and cannot be lawfully used in whole or in part for project or purpose except as described in the contractual agreement between McCarthy and the District. LPA hereby gives formal notice that any such project document use, reproduction or modification (misuse) is not only unlawful but automatically binds all parties involved with misuse to fully indemnify and defend LPA and LPA's Consultants to the maximum legal extent against all losses, demands, claims and liabilities arising directly or indirectly from project document misuse. Project documents describe design intent of work and are not a representation of as-built or existing conditions. LPA and LPA's Consultants make no representations concerning the accuracy of documents and are not responsible for any discrepancies between project documents and the existing conditions.

 Copyright



# BUILDING 4 Pathway

# BUILDING 4

**BUILDING 4**

**Building 4 Pathway**

**STOP**

**MATCHLINE SEE E4.07**

**MATCHLINE SEE E4.04**

**MATCHLINE SEE E4.03**

**MATCHLINE SEE E4.05**

**MATCHLINE SEE E4.02**

**MATCHLINE SEE E4.01**

**MATCHLINE SEE E4.04**

**MATCHLINE SEE E4.01**

**REFERENCE ONLY**  
NOT FOR AS-BUILTS  
**ROSENDIN ELECTRIC, INC.**

**TCHLINE SEE E404**

**TCHLINE SEE E402**

k	Error Rate
1	0.38
2	0.28
3	0.25
4	0.22
5	0.20
6	0.18
7	0.17
8	0.16
9	0.15
10	0.14

4 0.3 0.3 0.3 0.2 0.2 0.2 0.1 0.1 0.1 0.1 0.1 0.1 0.1 0

3 0.3 0.2 0.2 0.2 0.2 0.1 0.1 0.1 0.1 0.1 0.1 0.1 0.1 0

**WE SEE E4.01**

0.1 0.1 0.1 0.1 0.1 0.1 0.1 0.1 0.2 0.2 0.2 0.2  
0.1 0.1 0.1 0.1 0.1 0.1 0.1 0.1 0.2 0.2 0.2 0.2



IDENTIFICATION STAMP		
DIV. OF THE STATE ARCHITECT		
OFFICE OF REGULATION SERVICE		
APPL. #: 01-110097		
AC _____	FLS _____	SS _____
DATE _____		

This and all other project documents and all ideas, aesthetical designs incorporated therein are instruments of service. Project documents are the registered property of LPA, INC. (LPA) and cannot be lawfully used in whole or in part for project or purpose except as described in the contractual agreement between McCarthy and the District. LPA hereby gives formal notice that any such project document use, reproduction or modification (misuse) is not only unlawful, automatically binds all parties involved with misuse to full indemnify and defend LPA and LPA's Consultants to the maximum legal extent against all losses, demands, claims and liabilities arising directly or indirectly from project documents misuse. Project documents describe design intent of work and are not a representation of as-built or existing conditions. LPA and LPA's Consultants make no representations concerning the accuracy of documents and are not responsible for discrepancies between project documents and the existing conditions.

Copyright 2008

# **College of San Mateo Site Package**

**College  
Site Pack**

**College of  
Site Pack  
San Mateo,  
Developed for**

Revision	Description	Date

Revision	Description	Date
	DSA SUBMITTAL	19 SEPT 2008
	DSA FINAL	09 APRIL 2009
	PLAN CHECK COMMENTS-REV 19	OCT 2009
	DRAWING OF RECORD	19 OCT 2009
	POOL LTG & TEL/DATA REV	19 OCT 2009

Job. No.	30008
Date	09 APRIL 2008
Drawn by	REI CAD TEAM
Checked by	TH/SF/RV
Scale	AS SHOWN
<p><b>Site Lighting Plan -</b> <b>Ltg. Extended</b> <b>Photometric</b></p> <p><b>E4.05</b></p>	

**REFERENCE ONLY**  
**NOT FOR AS-BUILTS**  
**POSENDIN ELECTRIC, INC.**

**REFERENCE ONLY**  
**NOT FOR AS-BUILTS**  
**ROSENDIN ELECTRIC, INC.**

This architectural site plan illustrates the layout of Building 5 and its surroundings. The building itself is a multi-story structure with a rectangular footprint, featuring numerous windows and a prominent entrance. A vertical dashed line labeled "BUILDING 5" indicates the building's orientation. Two boundary lines are shown: "BLDG 5N FEED BOUNDARY" and "BLDG 5N LEED BOUNDARY". The plan includes contour lines representing different grade levels across the site. Utility connections are depicted as various lines, including "WATER", "SEWER", "GAS", "POWER", and "TELECOM". Several labels provide specific information: "MATCHLINE SEE E4.08", "MATCHLINE SEE E4.05", "pathway", and "BLDG 5N FEED BOUNDARY". The plan also shows a "BLDG 5N LEED BOUNDARY" and "BLDG 5N FEED BOUNDARY" near the bottom center. The entire site is enclosed by a dashed line labeled "BLDG 5N FEED BOUNDARY".




**IDENTIFICATION STAMP**  
**DIV. OF THE STATE ARCHITECT**  
**OFFICE OF REGULATION SERVICE**

This and all other project documents and all ideas, concepts and designs incorporated therein are instruments of service. Project documents are the registered property of LPA, INC. (LPA) and cannot be lawfully used in whole or in part for any project or purpose except as described in the contractual agreement between McCarthy and the District. LPA hereby gives formal notice that any such project document use, reproduction or modification (misuse) is not only unlawful but automatically binds all parties involved with misuse to full indemnify and defend LPA and LPA's Consultants to the maximum legal extent against all losses, demands, claims and liabilities arising directly or indirectly from project documents misuse. Project documents describe design intent of work and are not a representation of as-built or existing conditions. LPA and LPA's Consultants make no representations concerning the accuracy of documents and are not responsible for discrepancies between project documents and the existing conditions.

© Copyright

# JILDING 8

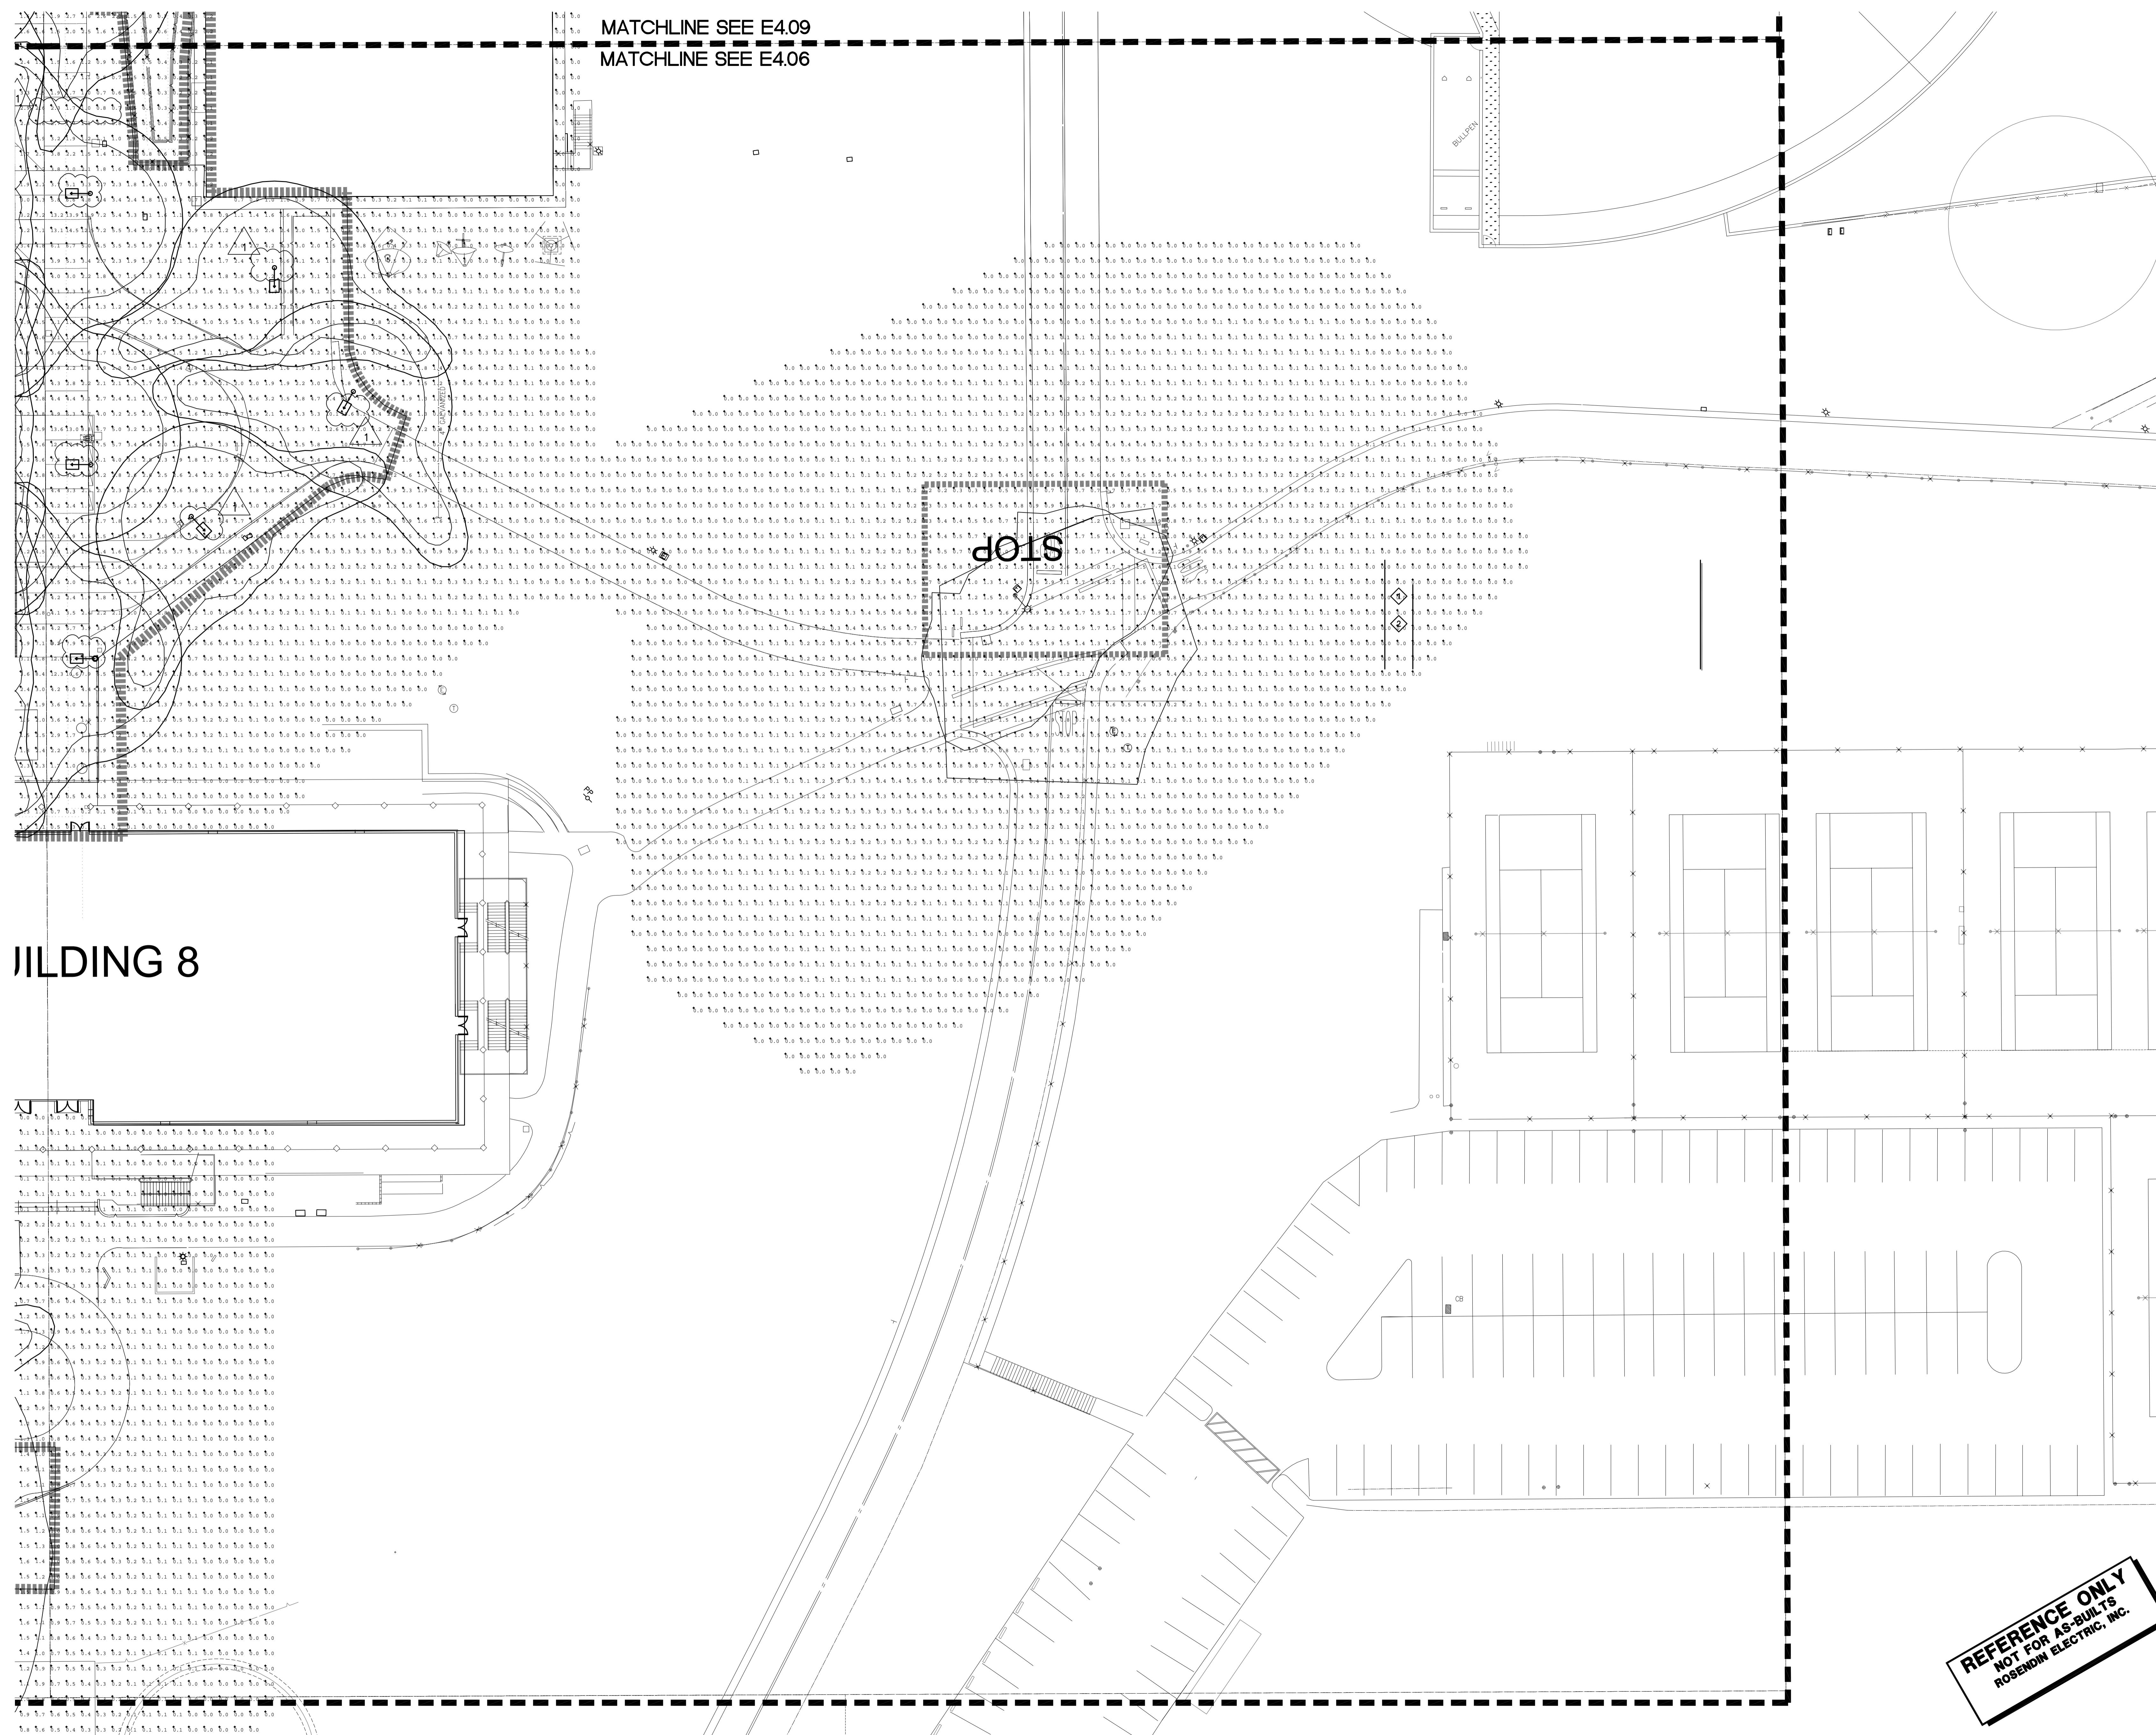

**REFERENCE ONLY**  
**NOT FOR AS-BUILTS**  
**ROSENDIN ELECTRIC, INC.**

revision	Description	Date
	DSA SUBMITTAL	19 SEPT 2008
	DSA FINAL	09 APRIL 2009
1	PLAN CHECK COMMENTS-REV 19	OCT 2009
2	DRAWING OF RECORD	19 OCT 2009
3	POOL LTG & TEL/DATA REV	19 OCT 2009

Job. No.	30008
Date	09 APRIL 200
Drawn by	REI CAD TEA
Checked by	TH/SF/RV
Scale	AS SHOW
<p><b>Site Lighting Plan - Ltg. Extended Photometric <b>E4.06</b></b></p>	