

SINGLE LINE DIAGRAM


NOT

	PANEL	CL1				LOCAT	ION:		POOL EQ	MT. RM.	CONCES	SSION STAND
YPE	DESCRIPTION	LOAD	BKR	CIR	Α	В	С	CIR	BKR	LOAD	TYPE	DESCRIPTION
R	EQMT. RM. RECS.	540	20/1P	1	722			2	20/1P	182	L	CONCESSIONS
R	STORAGE RMS.	750	20/1P	3		900		4	20/1P	150	L	CONCESSIONS EXTERIOR
	STORAGE RMS. FANS	1200	20/1P	5			2000	6	20/1P	800	R	CONCESSIONS
R	REC GFI-LT POLES	1800	20/1P	7	2600			8	20/1P	800	R	CONCESSIONS
R	REC GFI-POOL AREA	500	20/1P	9		1300		10	20/1P	800	R	CONCESSIONS
	SPARE		20/1P	11			800	12	20/1P	800	R	CONCESSIONS
	FC-1	350	20/1P	13	1150			14	20/1P	800	R	CONCESSIONS
	SPARE		20/1P	15		800		16	20/1P	800	R	CONCESSIONS
	SPARE		20/1P	17			530	18	20/1P	530	L	POOL EQMT. RM.
	SPACE			19	159			20	20/1P	159	L	EM POOL EQMT. RM.
	SPACE			21		1800		22	20/1P	1800	L	CONTROL CABMUSCO LTS
	SPACE			23			1000	24	20/1P	1000		BMS-POOL BLDG
	SPACE			25	0			26	1 ' 1			SPACE
	SPACE			27		0		28				SPACE
	SPACE			29			0	30				SPACE
	SPACE			31				32				SPACE
	SPACE			33		0		34				SPACE
	SPACE			35			0	36				SPACE
	SPACE			37	0			38				SPACE
	SPACE			39		0		40				SPACE
	SPACE			41			0	42				SPACE
					4631	4800	4330					
					39	40	36					
	SIZE:	150			GROUND:	•	•	STANDA	ARD			NOTES:
	VOLTAGE:	208	/120V		MOUNTING:	:		SURFA	CE			1
	PHASE:	3			<b>ENCLOSUR</b>	E:		NEMA	1			1
	WIRE:	4			FEED:							
	LUGS:	M.L.O.			CONNECTE	D KVA PAN	NEL .			13.8	3	
	AIC RATING:	10,000			CONNECTE	D AMPS PA	ANEL			38.2	2	
	BUS:	COPPER			RECEPTACI	LE KVA LO	AD PANEL			0.	1	
	NEUTRAL:	100%			OTHER KV	A LOAD PA	NEL			5.4	<u> </u>	
						LOAD (W/	DMD FCTR	2)	65%	0.0		
	MAX. ALLOWED AMPS	120			LOAD (AMI	PS) PANEL				15.3	3	

	COPPER FEEDER	SCHEDULE - 3	3 PHASE, 3 WIRE	
FEEDER No.	AMPERE	FEEDER	GROUND	CONDUIT
153	15A, 3PH3W	3-#12	#12	1/2"
203	20A, 3PH3W	3-#12	#12	1/2"
303	30A, 3PH3W	3-#10	#10	1/2"
403	40A, 3PH3W	3-#8	#10	3/4"
503	50A, 3PH3W	3-#8	#10	3/4"
603	60A, 3PH3W	3-#6	#10	1"
703	70A, 3PH3W	3-#4	#8	1"
803	80A, 3PH3W	3-#4	#8	1"
1003	100A, 3PH3W	3-#2	#8	1 1/4"
1253	125A, 3PH3W	3-#1	#6	1 1/2"
1503	150A, 3PH3W	3-#1/0	#6	1 1/2"
1753	175A, 3PH3W	3-#2/0	#6	2"
2003	200A, 3PH3W	3-#3/0	#6	2"
2253	225A, 3PH3W	3-#4/0	#4	2 1/2"
2503	250A, 3PH3W	3-#250K	#4	2 1/2"
3003	300A, 3PH3W	3-#350K	#4	2 1/2"
3503	350A, 3PH3W	3-#400K	#2	3"
4003	400A, 3PH3W	3-#500K	#2	3"
5003	500A, 3PH3W	6-#250K	2-#2	(2) 2 1/2"
6003	600A, 3PH3W	6-#350K	2-#1	(2) 3"
8003	800A, 3PH3W	6-#500K	2-#1/0	(2) 3"
10003	1000A, 3PH3W	9-#400K	3-#2/0	(3) 3"
12003	1200A, 3PH3W	9-#600K	3-#3/0	(3) 4"
16003	1600A, 3PH3W	12-#600K	4-#4/0	(4) 4"
20003	2000A, 3PH3W	15-#600K	5-#250K	(5) 4"

20003	2000A, 3PH3W	15-#600K	1 5-#250K	(5) 4
	COPPER FEEDER	R SCHEDULE - 3	PHASE, 4 WIRE	-
FEEDER No.	AMPERE	FEEDER	GROUND	CONDUIT
154	15A, 3PH4W	4-#12	#12	1/2"
204	20A, 3PH4W	4-#12	#12	1/2"
304	30A, 3PH4W	4-#10	#10	1/2"
404	40A, 3PH4W	4-#8	#10	3/4"
504	50A, 3PH4W	4-#6	#10	1"
604	60A, 3PH4W	4-#6	#10	1"
704	70A, 3PH4W	4-#4	#8	1 1 /4"
804	80A, 3PH4W	4-#4	#8	1 1 /4"
1004	100A, 3PH4W	4-#2	#8	1 1/4"
1254	125A, 3PH4W	4-#1	#6	1 1/2"
1504	150A, 3PH4W	4-#1/0	#6	1 1/2"
1754	175A, 3PH4W	4-#2/0	#6	2"
2004	200A, 3PH4W	4-#3/0	#6	2"
2254	225A, 3PH4W	4-#4/0	#4	2 1/2"
2504	250A, 3PH4W	4-#250K	#4	2 1/2"
3004	300A, 3PH4W	4-#350K	#4	3"
3504	350A, 3PH4W	4-#400K	#2	3"
4004	400A, 3PH4W	4-#500K	#3	3 1/2"
5004	500A, 3PH4W	8-#250K	2-#2	(2) 2 1/2"
6004	600A, 3PH4W	8-#350K	2-#1	(2) 3"
8004	800A, 3PH4W	8-#500K	2-#1/0	(2) 3"
10004	1000A, 3PH4W	12-#400K	3-#2/0	(3) 3"
12004	1200A, 3PH4W	12-#600K	3-#3/0	(3) 4"
16004	1600A, 3PH4W	16-#600K	4-#4/0	(4) 4"
20004	2000A, 3PH4W	20-#600K	5-#250K	(5) 4"

		GENERAL NOTES
	A.	ALL LIGHTING AND POWER CIRCUITRY SHOWN ON PLAN IS CONNECTED TO PANEL 'CL1', UNLESS OTHERWISE NOTED.
$\sqrt{\frac{3}{3}}$	<u>В</u> .	CONTROL OF MUSCO LIGHTING VIA CONTROL CABINET IN THE POOL HOUSE SHALL INTERPHASE WITH THE "BMS" LOCATED AT BLDG. 7.

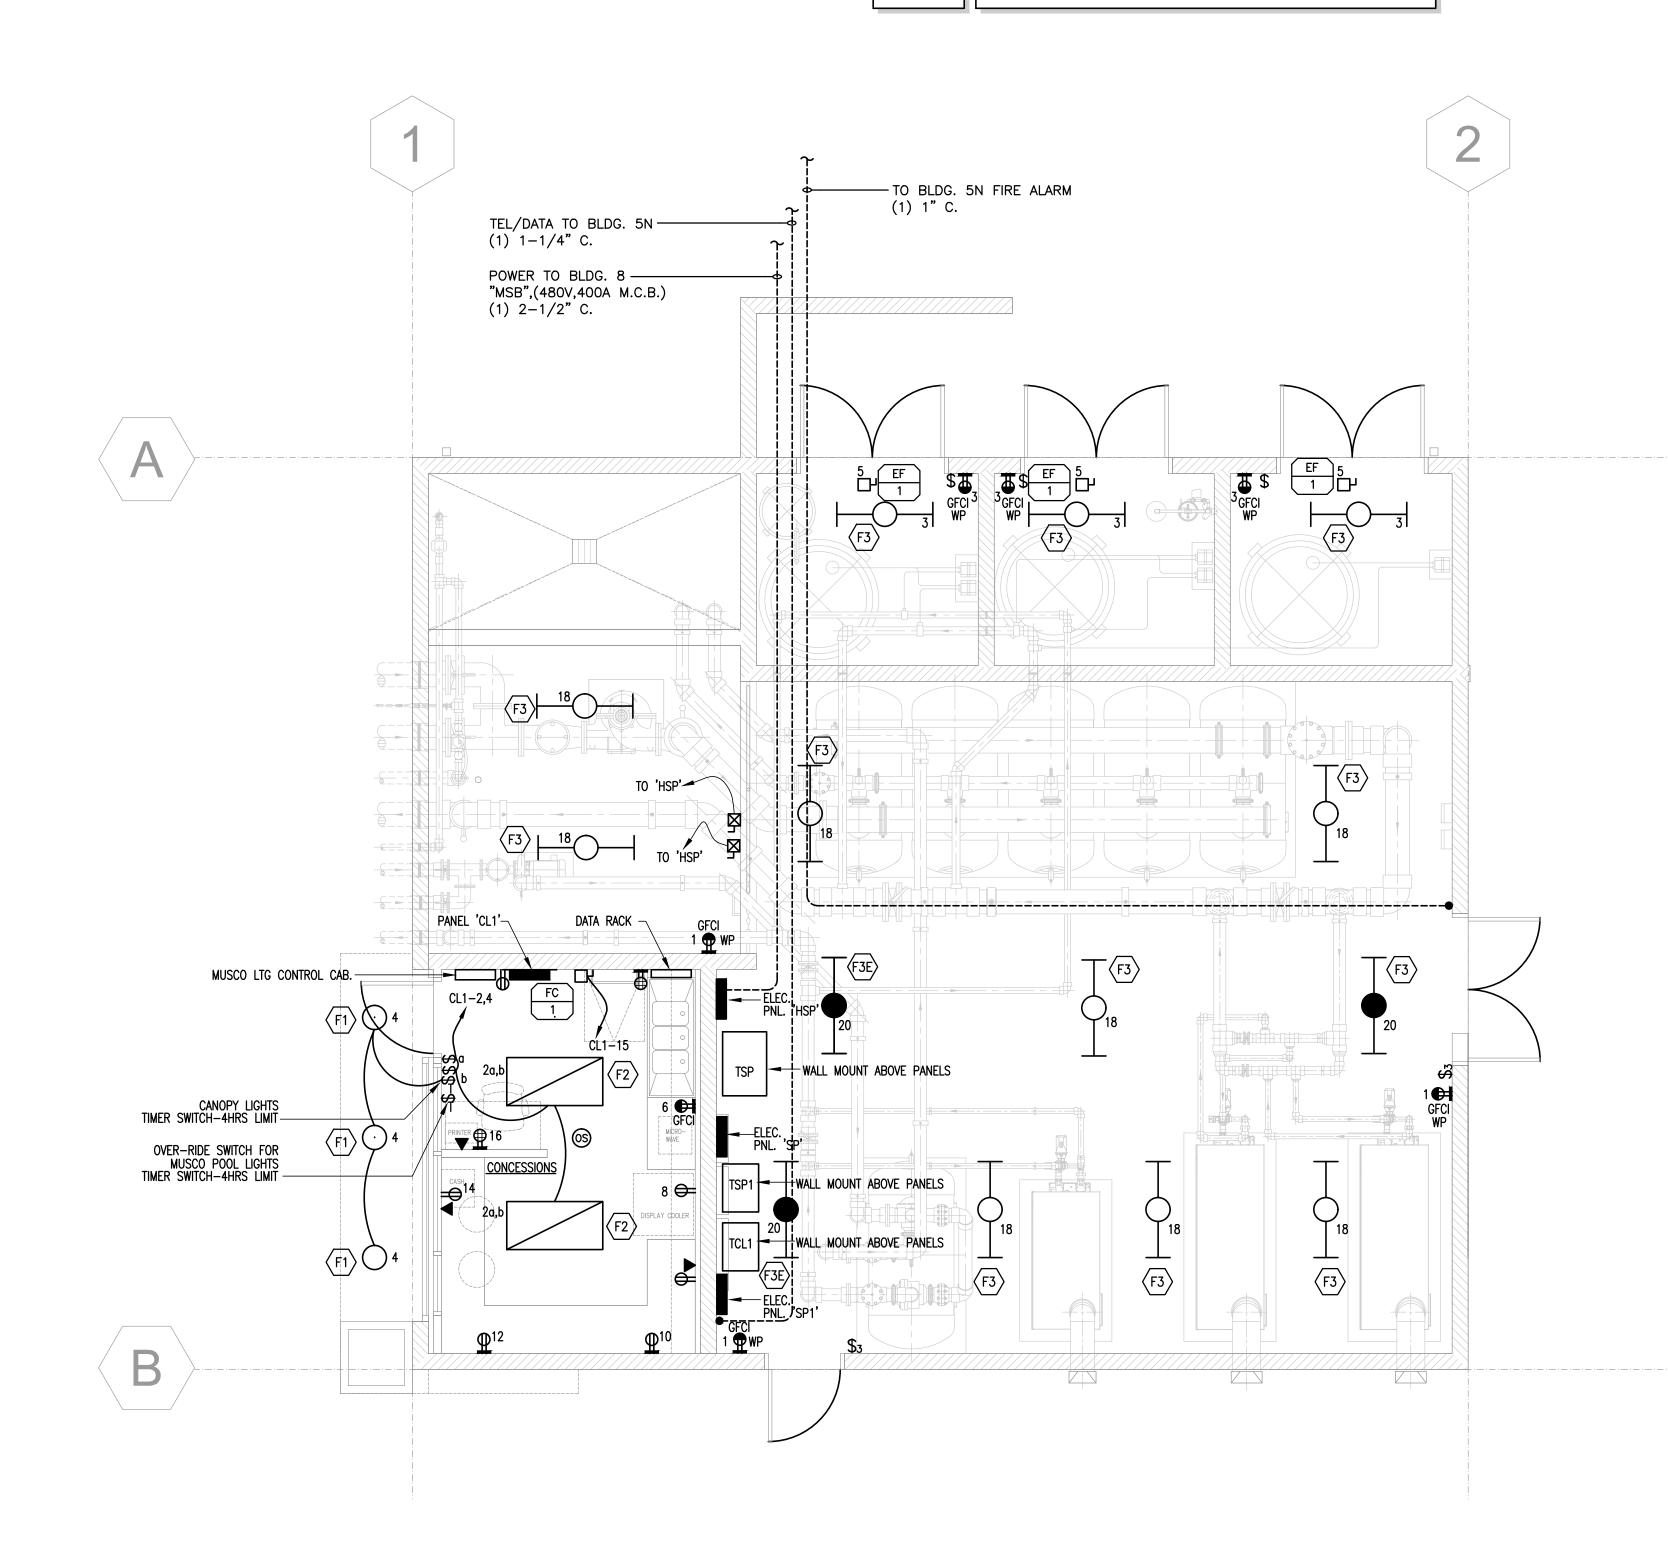

SCALE: 1/4"=1'-0"


LIGHTING, POWER & DATA PLAN

DRAWING OF RECORD ROSENDIN ELECTRIC, INC. DATE: 11/17/2010

129.9KVA 156.5A@480V,3ø

McCarthy Building Companies, Inc. 343 Sansome Street, 14th Floor San Francisco, California 94104 P 415 |364-1339 F 415 397-5999

BUILDING QUALITY BUILDING VALUE BUILDING PEOPLE CORPORATE HEADQUARTERS SAN JOSE, CA (408) 286–2800 Arizona California Nevada New Mexico Oregon

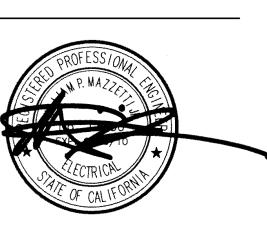

IDENTIFICATION STAMP
DIV. OF THE STATE ARCHITECT
OFFICE OF REGULATION SERVICE APPL. #: 01-110097

FILE NUMBER: This and all other project documents and all ideas, aesthetics and designs incorporated therein are instruments of service. All project documents are the registered property of LPA, INC. (LPA) and cannot be lawfully used in whole or in part for any project or purpose except as described in the contractual agreement between McCarthy and the District. LPA hereby gives formal notice that any such project document use, reproduction or modification (misuse) is not only unlawful but automatically binds all parties involved with misuse to fully indemnify and defend LPA and LPA's Consultants to the maximum legal extent against all losses, demands, claims or liabilities arising directly or indirectly from project document misuse. Project documents describe design intent of work and are not a representation of as-built or existing conditions. are not a representation of as-built or existing conditions.

LPA and LPA's Consultants make no representations concerning the accuracy of documents and are not responsible for any discrepancies between project documents and the existing conditions.

Revision Description	DRAWING OF RECORD				
Revis					


09 APR 2009

Pool Bldg. Lighting, Power Plan & Single

Line Diagram E10.10

			LEGEND AND A				
	LIGHTING FIXTURES		EQUIPMENT		SINGLE LINE AND SCHEMATICS		ABBREVIATIONS
	FLUORESCENT CEILING FIXTURE		SWITCHBOARD	AF	CIRCUIT BREAKER:	A, AMP	AMPERES
Ю	FLUORESCENT: OPEN STRIP		PANELBOARD — SURFACE MOUNTED	_AT _P	AF = AMP FRAME AT = AMP TRIP	AFF	ABOVE FINISHED FLOOR
0	CEILING SURFACE OR RECESSED DOWNLIGHT		PANELBOARD — FLUSH MOUNTED	_AIC	P = POLE AIC = AMPERES INTERRUPTING CAPACITY	AIC	AMPERES INTERRUPTING CAPACITY
₹9	WALL MOUNTED FIXTURE OR SCONCE	Т	TRANSFORMER	1	FUSIBLE SWITCH:	ATS A/V	AUTOMATIC TRANSFER SWITCH  AUDIO/VISUAL
0>	WALL WASHER	R	RELAY	_/3	_/3 = SWITCH SIZE AND POLES	BMS	BUILDING MANAGEMENT SYSTEM
$\begin{array}{c c} \nabla \nabla \nabla \\ \hline \Delta \Delta \end{array}$	TRACK MOUNTED FIXTURES (TRACK LENGTHS AS INDICATED WITH FITTINGS AND CONNECTORS AS REQUIRED)	© _	CONTACTOR	FU FU	= FUSE SIZE	С	CONDUIT: WITH PULLCORD IF OTHERWISE EMPTY
0	BOLLARD LUMINAIRE		MAGNETIC STARTER	<u>                                     </u>		CB, C/B	CIRCUIT BREAKER
오 모	POLE OR POST MOUNTED CUTOFF LUMINAIRE		COMBINATION MAGNETIC STARTER/DISCONNECT	↑ _AF	DRAWOUT CIRCUIT BREAKER:	CLG	CEILING
	EMERGENCY LIGHTING UNIT: MOUNT AT LOWER OF +96" AFF OR 12" BELOW CEILING	- B - E	NON-FUSIBLE DISCONNECT SWITCH  FUSIBLE DISCONNECT SWITCH	_AT _P	AF = AMP FRAME AT = AMP TRIP	DPDT	DOUBLE POLE DOUBLE THROW
<b>₩</b>	COMBINATION EMERGENCY LIGHTING UNIT & EXIT LIGHT	VFD	VARIABLE FREQUENCY DRIVE	↓ _AIC	P = POLE AIC = AMPERES INTERRUPTING CAPACITY	DPST (E)	DOUBLE POLE SINGLE THROW  EXISTING TO REMAIN
<b>⊗ ⊗ ⊗</b> . ETC.	EXIT LIGHT: FACES AND ARROWS AS INDICATED ON PLANS	<u> </u>	JUNCTION BOX — SIZE AS REQUIRED BY NEC	<b>^</b>	DRAWOUT FUSIBLE SWITCH:	EC	EMPTY CONDUIT
<b>♥</b> , E1C.	LOW LEVEL EXIT LIGHT: MOUNT AT BETWEEN +6" & +8" A.F.F. TO BOTTOM OF FIXTURE; & 4" MAX. FROM EDGE OF FIXTURE		PLUG MOLD SURFACE RACEWAY AND DEVICES	/ _/3 H ====	_/3 = SWITCH SIZE AND POLES = FUSE SIZE	EM	EMERGENCY
	TO LATCH SIDE OF DOOR OR EXIT WAY OPENING.	TP	TELEPOWER POLE	∐ FU ¥		EMT	ELECTRIC METALLIC TUBING
	RECEPTACLES	P	POWER POLE		NORMALLY OPEN CONTACT	FACP	FIRE ALARM CONTROL PANEL
Ψ	SINGLE: 20A, 125V, NEMA 5-20R, +15" AFF TO BOTTOM UON		CIRCUITING	<del></del>	NORMALLY CLOSED CONTACT	FB0	FURNISHED BY OTHERS
Ψ •	DUPLEX: 20A, 125V, NEMA 5-20R, +15" AFF TO BOTTOM UON		IN WALL OR ABOVE CEILING	©	CONTACTOR COIL	FLUOR FU	FLUORESCENT  FUSE: DUAL-ELEMENT, TIME DELAY
	SINGLE: 30A, 250V, NEMA 6-30R, +15" AFF TO BOTTOM UON		IN FLOOR OR BELOW GRADE	R	RELAY COIL	GFCI	GROUND FAULT CIRCUIT INTERRUPTER
₩	DOUBLE DUPLEX: 20A, 125V, NEMA 5-20R, +15" AFF TO BOTTOM UON	— P —	CIRCUITING TYPE: T = TELEPHONE C = CONTROL  S = SECONDARY TV = TELEVISION P = PRIMARY	6 ,0	TRANSFER SWITCH	G,GND	GROUND
•	HALF SWITCHED DUPLEX: 20A, 125V, NEMA 5-20R, +15" AFF TO BOTTOM UON (TOP HALF SWITCHED)		OH = OVERHEAD SERVICE FO = FIBER OPTIC	[ d	(AUTOMATIC OR MANUAL PER PLANS)	HOA	HAND-OFF-AUTOMATIC
•	DUPLEX GFCI: 20A, 125V, GFCI, NEMA 5-20R GFCI, +15"	<del></del>	STUB OUT: MARK AND CAP  CIRCUITING UP	- July	TRANSFORMER	HID	HIGH INTENSITY DISCHARGE
GFCI	AFF TO BOTTOM UON	•	CIRCUITING DOWN		WASI STAMEN	HP	HORSEPOWER
	DUPLEX I.G.: 20A, 125V, ISO. GND., NEMA 5-20R IG, +15" AFF TO BOTTOM UON (ORANGE DEVICE AND FACEPLATE)		TICS = No. OF #12 WIRES IF MORE THAN TWO  // = NUMBER OF PHASE WIRES / = GROUND WIRE	PANEL	PANEL — SEE PANEL SCHEDULE FOR DETAILS	HPS IG	HIGH PRESSURE SODIUM  ISOLATED GROUND
φ	SPECIAL RECEPTACLE - AS INDICATED ON PLANS, +15" AFF	— <i>///<del>}}</del></i>	/ = NEUTRAL WIRE		TANKEE SEE TANKEE SSHEBSEE TON BEHAVES	INCAND	INCANDESCENT
<b>6</b>	TO BOTTOM UON  CLOCK HANGER: MOUNTED AT +80" AFF UON	<del>-€////</del> - A-1,3,5	HOMERUN = 1/2" C. UON, 4-#12, 1-#12G TO PANEL 'A',	<u> </u>		Kcmil	THOUSAND CIRCULAR MILS (1in. = 1000MILS)
Ψ		□ A-1,3,5		  PANEL	PANEL WITH MAIN BREAKER — SEE PANEL SCHEDULE FOR DETAILS	KW	KILOWATT
_	SIGNAL OUTLETS	FACP	FIRE ALARM  FIRE ALARM CONTROL PANEL: SURFACE MOUNTED UON			KVA	KILOVOLT AMPS
<b>V</b>	TELEPHONE OUTLET: 1-LINK, CAT6; +15" AFF TO BOTTOM UON	FATO	FIRE ALARM TERMINAL CABINET: SURFACE MOUNTED UON	<u></u>	MOTOR CTARTER. NUMBER NEWS CTARTER CITE	LPS	LOW PRESSURE SODIUM
$\nabla$	TEL/DATA OUTLET: 3-LINKS, CAT6; +15" AFF TO BOTTOM UON  DATA OUTLET: 2-LINKS, CAT6; +15" AFF TO BOTTOM UON	FARA	FIRE ALARM REMOTE ANNUNCIATOR: FLUSH MOUNTED UON	T'	MOTOR STARTER: NUMBER=NEMA STARTER SIZE	LTG LV	LIGHTING  LOW VOLTAGE
♦	TELEVISION OUTLET: +15" AFF TO BOTTOM UON	F	MANUAL PULL STATION: AT +48" TO TOP UON	J		MCB	MAIN CIRCUIT BREAKER
	CAMERA OUTLET	<b>(5)</b>	FIRE SPRINKLER WATER FLOW SWITCH	Ŝ	MOTOR OVERLOADS	MCC	MOTOR CONTROL CENTER
<u> </u>	MICROPHONE OUTLET	(TS)	FIRE SPRINKLER TAMPER SWITCH	(		MCP	MOTOR CIRCUIT PROTECTOR
<b>O</b>	VOLUME CONTROL OUTLET	SD	SMOKE DETECTOR: CEILING MOUNTED		CURRENT TRANSFORMERS	MPOE	MINIMUM POINT OF ENTRY FOR TEL/DATA SERVICES
S	SPEAKER: CEILING MOUNTED UON	H	HEAT DETECTOR: CEILING MOUNTED	( 0		(N)	NEW
CR	CARD READER: +48" AFF UON	DD	DUCT SMOKE DETECTOR	$\longleftarrow M$	UTILITY COMPANY METER WITH CURRENT TRANSFORMERS	NACB NEMA	NON-ADJUSTABLE CIRCUIT BREAKER  NATIONAL ELECTRICAL MANUFACTURERS ASSOCIATION
DS	DOOR SECURITY: SYSTEM POWERED AND CONTROLLED, UON		HORN: WALL MOUNT AT LOWER OF 80" AFF OR 6" BELOW CEILING, UON		INDICATOR LIGHT	N,NEUT	NEUTRAL
	SWITCHES		CHIME: WALL MOUNT	$\boxtimes$	A=AMBER G=GREEN R=RED	NIC	NOT IN CONTRACT
\$	SINGLE POLE: 20A, 120V OR 277V, +48" AFF TO TOP UON		AT LOWER OF 80" AFF OR 6" BELOW CEILING, UON	GFR	GROUND FAULT RELAY	NL	NIGHT LIGHT
\$2	DOUBLE POLE: 20A, 120V OR 277V, +48" AFF TO TOP UON		SPEAKER: WALL MOUNT AT LOWER OF 80" AFF OR 6" BELOW CEILING, UON	S	SHUNT TRIP UNIT	NTS	NOT TO SCALE
\$3	THREE WAY: 20A, 120V OR 277V, +48" AFF TO TOP UON	F	STROBE: WALL MOUNT AT LOWER OF 80" AFF OR 6" BELOW CEILING, UON	A	AMMETER	OC PNL	ON CENTER PANEL
\$4 \$T	FOUR WAY: 20A, 120V OR 277V, +48" AFF TO TOP UON  TIMER SWITCH: 20A, 120V OR 277V, +48" AFF TO TOP UON		HORN AND STROBE: WALL MOUNT AT LOWER OF 80" AFF OR 6" BELOW CEILING, UON	V	VOLTMETER	PNL	POLYVINL CHLORIDE CONDUIT
\$P	'P' = PILOT LIGHT SWITCH (LIGHTED WHEN "ON"), +48" AFF TO TOP UON		CHIME AND STROBE: WALL MOUNT	PF)	POWER FACTOR METER	(R)	EXISTING TO BE RELOCATED
\$к Ф	'K' = KEY OPERATED SWITCH, +48" AFF TO TOP UON  MANUAL MOTOR STARTER WITH THERMAL OVERLOAD:		AT LOWER OF 80" AFF OR 6" BELOW CEILING, UON	AS VS	AMMETER SWITCH  VOLTMETER SWITCH	RGS	RIGID GALVANIZED STEEL
\$м	20A, 120V OR 277V		SPEAKER STROBE: WALL MOUNT AT LOWER OF 80" AFF OR 6" BELOW CEILING, UON		METHODS	SPDT	SINGLE POLE DOUBLE THROW
\$мс	MOMENTARY CONTACT: 20A, 120V OR 277V, SPDT CENTER NORMALLY OFF UON, +48" TO TOP UON	₿	BUILDING MOUNTED ALARM BELL PER LOCAL CODE		SHADING INDICATES: FIXTURE ON EMERGENCY 'X' OR NIGHT LIGHT 'NL' CIRCUIT	SPST	SINGLE POLE SINGLE THROW
\$p	DIMMER: 600 WATT UON, ELECTRONIC SLIDER, WITH	DH	MAGNETIC DOOR HOLDER: SYSTEM POWERED AND CONTROLLED, UON	HH •		TYP UG	TYPICAL  UNDER GROUND
	ON/OFF TOGGLE, +48" TO TOP UON (PLANS SHALL INDICATE TYPE: FLUOR, INCAND OR LOW-VOLTAGE)	<b>▼</b> FP	FIREFIGHTERS TELEPHONE OUTLET: MOUNTED AT +48" TO TOP UON	a,b O	LETTERS INDICATE FIXTURE CONTROLLED BY SWITCHES 'a' & 'b'.	UNSW	UNSWITCHED
LV	LOW VOLTAGE SWITCH - WALL MOUNTED AT +48" TO TOP UON	FSD	FIRE SMOKE DAMPER	<u>\$\$</u> \$	DEVICES MOUNTED IN A MULTIGANG BOX UNDER COMMON COVER MAXIMUM HEIGHT ON WALL SHALL BE +48" TO TOP UON	UON UPS	UNLESS OTHERWISE NOTED  UNINTERRUPTABLE POWER SUPPLY
os	MOTION/OCCUPANCY SENSOR SWITCH WITH OFF-AUTO SELECTOR - WALL MOUNTED AT +48" TO TOP UON	(F1)	DESIGNATIONS  LIGHTING FIXTURE: F1 = TYPE, 3 = QTY., TYP = TYPICAL		DEVICES MOUNTED IN OR ABOVE BACKSPLASH:  MAXIMUM HEIGHT ON WALLS SHALL BE +48" TO TOP UON	٧	VOLTS
<u></u>	MOTION/OCCUPANCY SENSOR SWITCH WITH OFF-AUTO	F1	TYPES:  A = INCANDESCENT	<b>₩</b> •	FLUSH FLOOR MOUNTED WIRING DEVICES  FLUSH FLOOR MOUNTED WIRING DEVICES IN SINGLE MULTI—	WP (X)	WEATHER PROOF (NEMA 3R)  EXISTING TO BE REMOVED
	SELECTOR — CEILING MOUNTED	3 F1	A = INCANDESCENT F = FLUORESCENT H = HIGH INTENSITY DISCHARGE	<b>₩</b> ■□	COMPARTMENT BOX	XFMR	TRANSFORMER
<u></u>	PHOTOCELL ELECTRIC SWITCH: 1600VA UON  MISCELLANEOUS	TYP	X = EMERGENCY	⊕ф	RECEPTACLE MOUNTED IN CASEWORK	XP	EXPLOSION PROOF
	THERMOSTAT: MOUNT AT +48' TO TOP UON	(1)	SHEET NOTE	₩ΦΦ	RECEPTACLE OR JUNCTION BOX MOUNTED IN CEILING	_	
0	(PER MECHANICAL PLANS)	$\left\langle \begin{array}{c} AC \\ 1 \end{array} \right\rangle$	MECHANICAL EQUIPMENT	Ф Er ⊢О⊢	FINE DASHING INDICATES EXISTING EQUIPMENT AND DEVICES TO BE REMOVED	_	_
(F)	EXHAUST FAN: FRACTIONAL HORSEPOWER		EEEDED CIDCUITOV TAC	<u> </u>			<del>-</del>
1	MOTOR: NUMBER = HORSEPOWER	XXX X1 X2	FEEDER CIRCUITRY TAG  X1 = CONDUIT  X2 = FEEDER				_
EPO 🕌	EMERGENCY POWER OFF PUSH BUTTON  GROUND ROD	X3	X3 = GROUND			_	_
×	GROUND WELL	$\begin{pmatrix} x \\ xx \end{pmatrix}$	DETAIL CALLOUT ON PLANS  X= DETAIL NUMBER			_	_
<del>\</del>	SHOOMS WELL		XX= SHEET NUMBER				

	DRAWING SCHEDULE									
				/1	/2	/3\	4	<u>/</u> 5	6	<u>/</u> .
SHEET	DESCRIPTION	DSA SUBMITTAL DATE: 09/19/08	DSA FINAL DATE: 04/09/09	PANEL "SP1" REVISION DATE: 07/25/09	REV DATE:	POOL LTG & TEL/DATA REV DATE: 10/19/09		OWNER'S CHANGES DATE: 11/16/09	POOL BLDG LTG REV (Per Availability) DATE: 12/15/-09	NG OF F
E10.01	LEGEND, ABBREVIATIONS AND DRAWING SCHEDULE	•	•							•
E10.02	TITLE-24 COMPLIANCE FORM	•	•							•
E10.03	NOT USED									
E10.04	ELECTRICAL MISCELLANEOUS DETAILS	•	•							•
E10.05	ELECTRICAL MISCELLANEOUS DETAILS	•	•							•
E10.10	LTG, POWER, DATA PLAN, SINGLE LINE DIAGRAM, PANEL SCHEDULE, LT. FIXTURE SCHEDULE	•	•	•		•	•	•	•	•
FA-01	COVER SHEET/FIRE ALARM EQUIPMENT LIST/SCOPE OF WORK		•							
FA-02	MISCELLANEOUS NOTES/EXISTING SEQUENCE OF OPERATIONS		•							
FA-03	SITE PLAN		•							
FA-04	EXISTING MXL PANEL AND UPDATED CALCULATIONS		•							
FA-05	WIRING OF DEVICES		•							
FA-06	POOL ROOM FIRE ALARM RISER DIAGRAM		•							
FA-07	POOL ROOM FIRE ALARM PLAN		•							
			-				-			
			-				-			
				-	-		-	<del>                                     </del>	<u> </u>	₩

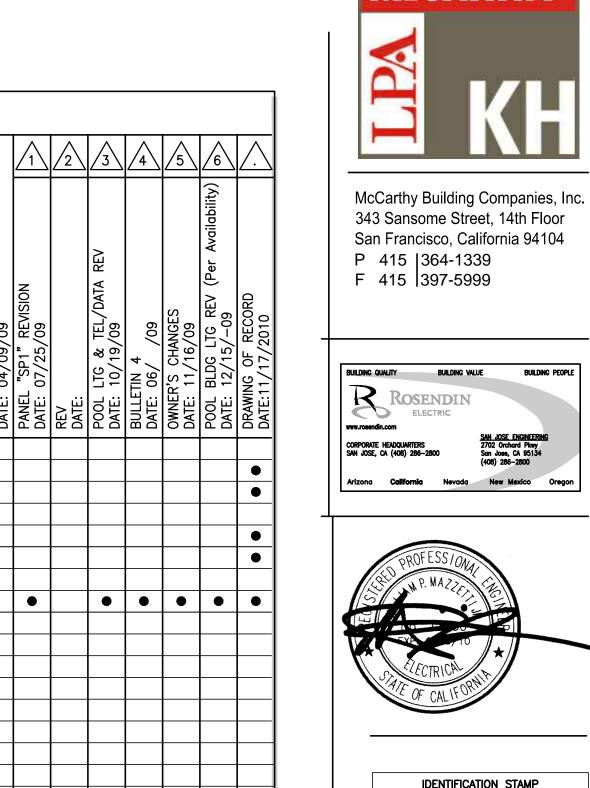

IDENTIFICATION STAMP
DIV. OF THE STATE ARCHITECT
OFFICE OF REGULATION SERVICE

This and all other project documents and all ideas, aesthetics and designs incorporated therein are instruments of service. All project documents are the registered property of LPA, N.C. (LPA) and cannot be lawfully used in whole or in part for any project or purpose except as described in the contractual agreement between McCarthy and the District. LPA hereby gives formal notice that any such project document use, reproduction or modification (misuse) is not only unlawful but automatically binds all parties involved with misuse to fully indemnify and defend LPA and LPA's Consultants to the maximum legal extent against all losses, demands, claims or liabilities arising directly or indirectly from project document misuse. Project documents describe design intent of work and are not a representation of as-built or existing conditions.

are not a representation of as-built or existing conditions.

LPA and LPA's Consultants make no representations concerning the accuracy of documents and are not responsible for any discrepancies between project documents and the existing conditions.

APPL. #: 01-110097

FILE NUMBER:

Pool Bldg. Legend,
Abbreviations &
Drawing Schedules

E10.01

DRAWING OF RECORD ROSENDIN ELECTRIC, INC.

DATE: 11/17/2010

PROJECT NAME	OF COMPLIANCE	(Part 1 of	DATE
COLLEGE OF SAN MATE PROJECT ADDRESS	O POOL EQUIPMENT BLDG	•	09/19/08
SAN MATEO, CA			
PRINCIPAL DESIGNER-LIGHTING TOM SATER		TELEPHONE 408-321-2207	Building Permit
DOCUMENTATION AUTHOR		TELEPHONE	Checked by/Date
TOM SATER		408-321-2207	Enforcement Agency Use
GENERAL INFORMATION	T = = = = = = =		
DATE OF PLANS 09-19-08	BUILDING CONDITIONED FLOC	1 1,21 = 2 = 11 11	CLIMATE ZONE 3
BUILDING TYPE	■ NONRESIDENTIAL	RISE RESIDENTIAL	☐ HOTEL/MOTEL GUE
CONDITIONED SPACES	■ UNCONDITIONED SPACES	☐ INDOOR / OUTDOOR SIG	NS
PHASE OF CONSTRUCTION	■ NEW □ ADD	OITION ALTERATION	
METHOD OF COMPLIANCE	•		
performance co	MPLETE BUILDING AREA CATE	GORY TAILORED	COMMON LIGHTING
STATEMENT OF COMPLIANCE	7.11.2.7.2.30.1.2.1.1.2	- 17 HE ONE B	
	e building features and performance specific	cations need to comply with Title 2	4, Parts 1 and 6 of the California C
	s only to building lighting requirements. ertifies that the documentation is accurate a	nd complete	
DOCUMENTATION AUTHOR	SIGNATURE	na complete.	DATE
TOM SATER			
has been designed to meet lighting red  The plans & specifications me Part 6 (10-103a 3).  The operation & maintenance inf Please check one: (These section  I hereby affirm that I am eligib	ets, with the specifications, and with any oth quirements contained in applicable parts of seet the requirements of Part 6 (Sections formation meet the requirements of Part 6 (20) ons of the Business and Professions Code at the under the provisions of Division 3 of the	ner calculations submitted with this Sections 110, 119,130–132, 146, 10-103a).   The installation 10-103c).   The printed in full in the Nonresiden the Business and Professions Co	permit application. The proposed to 148, & 149 of Title 24, Part 6. certificates meet the requirement tial Manual.)
other compliance forms and workshee has been designed to meet lighting rec The plans & specifications me Part 6 (10-103a 3). The operation & maintenance inf Please check one: (These section I hereby affirm that I am eligible responsible for its preparation; a I affirm that I am eligible under the as the person responsible for its I affirm that I am eligible under	ets, with the specifications, and with any oth quirements contained in applicable parts of seet the requirements of Part 6 (Sections formation meet the requirements of Part 6 (10 ons of the Business and Professions Code at the United Health of the Provisions of Division 3 of the Business of Division 3 of the Business preparation; and that I am a licensed contract Division 3 of the Business and Professions	ner calculations submitted with this Sections 110, 119,130–132, 146, 10-103a).   The installation 10-103c).   The installation 10-10	permit application. The proposed to 148, & 149 of Title 24, Part 6. certificates meet the requirement tial Manual.)  I do to sign this document as the engineer, or I am a licensed architect 5537.2 or 6737.3 to sign this docur
other compliance forms and workshee has been designed to meet lighting received.  The plans & specifications may part 6 (10-103a 3).  The operation & maintenance information please check one: (These sections of the please check one: (These sections).  I hereby affirm that I am eligible responsible for its preparation; and I affirm that I am eligible under the state of the person responsible for its of the person responsible for its I affirm that I am eligible under work described as exempt pursue principal Lighting Designer-Nami	ets, with the specifications, and with any oth quirements contained in applicable parts of seet the requirements of Part 6 (Sections formation meet the requirements of Part 6 (10 ons of the Business and Professions Code at the United Provisions of Division 3 of the Business and Professions Code Sections Code Sections Code Sections (10 of Sections Code Section	ner calculations submitted with this Sections 110, 119,130–132, 146, 10-103a).   The installation 10-103c).   The installation 10-10	permit application. The proposed to 148, & 149 of Title 24, Part 6. certificates meet the requirement tial Manual.)  Indeed to sign this document as the engineer, or I am a licensed architect 5537.2 or 6737.3 to sign this document as the engineer.
other compliance forms and workshee has been designed to meet lighting recall to the plans & specifications may part 6 (10-103a 3).  The operation & maintenance informal please check one: (These sections of the please check one) in the please check one of the please che	ets, with the specifications, and with any oth quirements contained in applicable parts of seet the requirements of Part 6 (Sections formation meet the requirements of Part 6 (Some of the Business and Professions Code alle under the provisions of Division 3 of the Hamiltonian of Division 3 of the Business preparation; and that I am a licensed contrained by the Business and Professions of Division 3 of the Business and Professions Some Division 3 of the Business and Professions Code Section Signature	ner calculations submitted with this Sections 110, 119,130–132, 146, 10-103a).   The installation 10-103c).   The installation 10-10	permit application. The proposed to 148, & 149 of Title 24, Part 6. certificates meet the requirement tial Manual.)  Indeed to sign this document as the engineer, or I am a licensed architect 5537.2 or 6737.3 to sign this document as the engineer.
other compliance forms and workshee has been designed to meet lighting received.  The plans & specifications may part 6 (10-103a 3).  The operation & maintenance informal please check one: (These sections of the please check one) in the please check one: (These sections of the please check one) in the please check one: (These sections of the please check one) in the please check one: (These sections of the please check one) in the please check one: (These sections of the please check one) in the please check one; (These sections of the please check one) in the please check one; (These se	ets, with the specifications, and with any oth quirements contained in applicable parts of seet the requirements of Part 6 (Sections formation meet the requirements of Part 6 (Sections of the Business and Professions Code at le under the provisions of Division 3 of the under the provisions of Division 3 of the Business preparation; and that I am a licensed contrained provision 3 of the Business preparation; and that I am a licensed contrained business and Professions Code Section Signature	ner calculations submitted with this Sections 110, 119,130–132, 146, 10-103a).   The installation of the installation of the Business and Professions Comia as a civil engineer or electrical and Professions Code by section of the performing this work.  Code to sign this document because is 5537, 5538 and 6737.1.	permit application. The proposed to 148, & 149 of Title 24, Part 6. certificates meet the requirement tial Manual.)  Indeed to sign this document as the engineer, or I am a licensed architect 5537.2 or 6737.3 to sign this document as the engineer.
other compliance forms and workshee has been designed to meet lighting recall to the plans & specifications may part 6 (10-103a 3).  The operation & maintenance informal please check one: (These sections of the please check one) in the please check one of the please check one; (These sections of the please check one) in the please check one; (These sections of the please check one) in the please check one; (These sections of the please check one) in the please check one; (These sections on the please check one) in the please check one; (These sections on please check one) in the please check one; (These sections on please check one) in the please check one; (These sections on please check one) in the please check one; (These sections on please check one) in the please check one; (These sections on please check one) in the please check one; (These sections on please check one) in the please check one; (These sections one) in the please check one; (These sections one) in the please check one; (These sections) in the please check one; (These sections one) in the plea	ets, with the specifications, and with any oth quirements contained in applicable parts of seet the requirements of Part 6 (Sections formation meet the requirements of Part 6 (Some of the Business and Professions Code alle under the provisions of Division 3 of the Hamiltonian of Division 3 of the Business preparation; and that I am a licensed contrained provision 3 of the Business and Professions Code Section 1 of Note Block for Mandatory Not	ner calculations submitted with this Sections 110, 119,130–132, 146, 10-103a).   The installation 10-103c).  The installation 10-103c).  The installation 10-103c).  The installation 10-103c in the Nonresident 10-103c in the Nonresident 10-103c in the Rusiness and Professions Code and Professions Code by section 10-103c in this work.  The Code to sign this document because 10-103c in the Nonresident 10-103c in the Nonreside	permit application. The proposed to 148, & 149 of Title 24, Part 6. certificates meet the requirement tial Manual.)  Indeed to sign this document as the engineer, or I am a licensed architect 5537.2 or 6737.3 to sign this document as the engineer.
other compliance forms and workshee has been designed to meet lighting received.  The plans & specifications may part 6 (10-103a 3).  The operation & maintenance informal please check one: (These sections of the please check one: (These sections).  I hereby affirm that I am eligible responsible for its preparation; at a sthe person responsible for its as the person responsible for its.  I affirm that I am eligible under work described as exempt pursue.  PRINCIPAL LIGHTING DESIGNER-NAMINAZZETTI  LIGHTING MANDATORY MEASURE  Indicate location on plus of the plant of the pla	ets, with the specifications, and with any oth quirements contained in applicable parts of seet the requirements of Part 6 (Sections formation meet the provisions of Division 3 of the Business of Livision 3 of the Business preparation; and that I am a licensed contract Division 3 of the Business and Professions Code Section Signature  SIGNATURE  ES  ans of Note Block for Mandatory Mandat	ner calculations submitted with this Sections 110, 119,130–132, 146, 10-103a).   The installation of the Installation of the Business and Professions Could as a civil engineer or electrical of and Professions Code by section of the England Professions Code to Sign this document because the England Professions 5537, 5538 and 6737.1.	permit application. The proposed to 148, & 149 of Title 24, Part 6. certificates meet the requirement to tial Manual.)  I do do sign this document as the engineer, or I am a licensed architect 5537.2 or 6737.3 to sign this document as the engineer.
other compliance forms and workshee has been designed to meet lighting recall to the plans & specifications may part 6 (10-103a 3).  The operation & maintenance informal please check one: (These sections of the please check one) in the please check one of the please check one; (These sections of the please check one) in the please check one; (These sections of the please check one) in the please check one; (These sections of the please check one) in the please check one; (These sections on the please check one) in the please check one; (These sections on please check one) in the please check one; (These sections on please check one) in the please check one; (These sections on please check one) in the please check one; (These sections on please check one) in the please check one; (These sections on please check one) in the please check one; (These sections on please check one) in the please check one; (These sections one) in the please check one; (These sections one) in the please check one; (These sections) in the please check one; (These sections one) in the plea	ets, with the specifications, and with any oth quirements contained in applicable parts of seet the requirements of Part 6 (Sections formation meet the requirements of Part 6 (Some of the Business and Professions Code alle under the provisions of Division 3 of the Hamiltonian of Division 3 of the Business preparation; and that I am a licensed contrained provision 3 of the Business and Professions Code Section 1 of Note Block for Mandatory Not	ner calculations submitted with this Sections 110, 119,130–132, 146, 10-103a).   The installation 10-103c).  The installation 10-103c).  The installation 10-103c).  The installation 10-103c).  The installation 10-103c  The ins	permit application. The proposed to 148, & 149 of Title 24, Part 6. certificates meet the requirement to tial Manual.) and to sign this document as the engineer, or I am a licensed architect 5537.2 or 6737.3 to sign this document as the engineer to I am a licensed architect because it pertains to a structure or type I LIC. #
other compliance forms and workshee has been designed to meet lighting reclassional part 6 (10-103a 3).  The plans & specifications may part 6 (10-103a 3).  The operation & maintenance informal please check one: (These sections of the please check one: (These sections on please check one: (These sections on the please check one: (These sections on the please check one: (These sections on the please check one: (These sections one) and the please check one: (These sections one) and the please check one: (These sections one) and the please check one: (These sections one) are please check one: (These sections one) and the please check one: (These sections one) and the please check one: (These sections one) are please check one:	ets, with the specifications, and with any oth quirements contained in applicable parts of seet the requirements of Part 6 (Sections ormation meet the requirements of Part 6 (Social Parts of Social Parts of Par	ner calculations submitted with this Sections 110, 119,130–132, 146, 10-103a).   The installation of the installation of the Business and Professions Code and Professions Code by section of the Section	permit application. The proposed by 148, & 149 of Title 24, Part 6. certificates meet the requirement tial Manual.) by the to sign this document as the engineer, or I am a licensed architect 5537.2 or 6737.3 to sign this document as the engineer that is the engineer of I am a licensed architect by the sign this document as the engineer.  LIC. #
other compliance forms and workshee has been designed to meet lighting reclassional part 6 (10-103a 3).  The plans & specifications may part 6 (10-103a 3).  The operation & maintenance informal please check one: (These sections of the please check one: (These sections on the please check one: (These sections on please check one: (These sections on please check one: (These sections on the please check one: (These sections one) as the please check one: (These sections one) and the please check one: (These sections one) are the please check one: (These sections one) are the please check one: (These sections one) and the please check one: (These sections one) are t	ets, with the specifications, and with any oth quirements contained in applicable parts of seet the requirements of Part 6 (Sections formation meet the provisions of Division 3 of the Business and Professions of Division 3 of the Business preparation; and that I am a licensed contrained business and Professions Code Section Signature  SIGNATURE  ES  ans of Note Block for Mandatory Mandat	ner calculations submitted with this Sections 110, 119,130–132, 146, 10-103a).   The installation of the installation of the Business and Professions Code and Professions Code by section of the Section	permit application. The proposed by 148, & 149 of Title 24, Part 6. certificates meet the requirement tial Manual.) by the to sign this document as the engineer, or I am a licensed architect 5537.2 or 6737.3 to sign this document as the engineer that is the engineer of I am a licensed architect by the sign this document as the engineer.  LIC. #
other compliance forms and workshee has been designed to meet lighting received by the plans & specifications may part 6 (10-103a 3).  ☐ The plans & specifications may part 6 (10-103a 3).  ☐ The operation & maintenance informal please check one: (These sections of the please check one: (These sections on the please check one: (These sections of the please check one: (These sections on the please check	ets, with the specifications, and with any oth quirements contained in applicable parts of seet the requirements of Part 6 (Sections formation meet the requirements of Part 6 (Sons of the Business and Professions Code and that I am licensed in the State of Californ the provisions of Division 3 of the Business preparation; and that I am a licensed contract Division 3 of the Business and Professions Code Section Signature  SIGNATURE  SIGNATURE  Certificate of Compliance. Part 1 of 4 Certificate of Compliance. Part 3 of 4 Certificate of Compliance. Part 4 of 4	ner calculations submitted with this Sections 110, 119,130–132, 146, 10-103a).   The installation of the installation of the Business and Professions Code and Professions Code by section of the Section	permit application. The proposed by 148, & 149 of Title 24, Part 6. certificates meet the requirement tial Manual.) by the to sign this document as the engineer, or I am a licensed architect 5537.2 or 6737.3 to sign this document as the engineer that is the engineer of I am a licensed architect by the sign this document as the engineer.  LIC. #
other compliance forms and workshee has been designed to meet lighting reclassional part 6 (10-103a 3).  ☐ The plans & specifications may part 6 (10-103a 3).  ☐ The operation & maintenance informal please check one: (These sections of the please check one: (These sections on the please check one: (These sections one) as the please check one: (These sections one) as the please check one: (These sections one) as the please check one: (These sections one) are the please check one: (These sections one	ets, with the specifications, and with any oth quirements contained in applicable parts of seet the requirements of Part 6 (Sections formation meet the provisions of Division 3 of the Business and Professions of Division 3 of the Business preparation; and that I am a licensed contrained provision 3 of the Business and Professions and to Business and Professions Code Section SIGNATURE  ES  ans of Note Block for Mandatory Note Block for M	ner calculations submitted with this Sections 110, 119,130–132, 146, 10-103a).   The installation of the installation of the Business and Professions Code and Professions Code by section of the Section	permit application. The proposed by 148, & 149 of Title 24, Part 6. certificates meet the requirement tial Manual.) by the to sign this document as the engineer, or I am a licensed architect 5537.2 or 6737.3 to sign this document as the engineer that is the engineer of I am a licensed architect by the sign this document as the engineer.  LIC. #
other compliance forms and workshee has been designed to meet lighting received by the plans & specifications may part 6 (10-103a 3).  ☐ The plans & specifications may part 6 (10-103a 3).  ☐ The operation & maintenance informal please check one: (These sections of the please check one: (These sections on the please check one: (These sections of the please check one: (These sections on the please check	ets, with the specifications, and with any oth quirements contained in applicable parts of seet the requirements of Part 6 (Sections of the requirements of Part 6 (Sections of the Business and Professions Code and that I am licensed in the State of Californ the provisions of Division 3 of the Business preparation; and that I am a licensed contract Division 3 of the Business and Professions and to Business and Professions Code Section Signature  SIGNATURE  SIGNATURE  Certificate of Compliance. Part 1 of 4  Certificate of Compliance. Part 3 of 4  Indoor Lighting Schedule  Portable Lighting Worksheet	ner calculations submitted with this Sections 110, 119,130–132, 146, 10-103a).   The installation of the installation of the Business and Professions Code and Professions Code by section of the Section	permit application. The proposed by 148, & 149 of Title 24, Part 6. certificates meet the requirement tial Manual.) by the to sign this document as the engineer, or I am a licensed architect 5537.2 or 6737.3 to sign this document as the engineer that is the engineer of I am a licensed architect by the sign this document as the engineer.  LIC. #
other compliance forms and workshee has been designed to meet lighting received. The plans & specifications may part 6 (10-103a 3).  ☐ The operation & maintenance informal Please check one: (These sections of the please check one: (These sections) and the please check one: (These sections) are please check one: (These sections) and the please check one: (These sections) are please check one: (These sections) and the please check one: (These sections) are please che	ets, with the specifications, and with any oth quirements contained in applicable parts of seet the requirements of Part 6 (Sections formation meet the requirements of Part 6 (Tons of the Business and Professions Code at the under the provisions of Division 3 of the Under the provisions of Division 3 of the Business preparation; and that I am a licensed contrained provision 3 of the Business and Professions and to Business and Professions Code Section SIGNATURE  SIGNATURE  ES  Certificate of Compliance. Part 1 of 4  Certificate of Compliance. Part 3 of 4  Certificate of Compliance. Part 4 of 4  Indoor Lighting Schedule  Portable Lighting Worksheet  Lighting Controls Credit Worksheet	ner calculations submitted with this Sections 110, 119,130–132, 146, 10-103a).   The installation of the installation of the Business and Professions Code and Professions Code by section of the Section	permit application. The proposed by 148, & 149 of Title 24, Part 6. certificates meet the requirement tial Manual.) by the to sign this document as the engineer, or I am a licensed architect 5537.2 or 6737.3 to sign this document as the engineer that is the engineer of I am a licensed architect by the sign this document as the engineer.  LIC. #
other compliance forms and workshee has been designed to meet lighting received. The plans & specifications may part 6 (10-103a 3).  ☐ The operation & maintenance informal Please check one: (These sections of the please check one: (These sections) and the please check one: (These s	ets, with the specifications, and with any oth quirements contained in applicable parts of seet the requirements of Part 6 (Sections formation meet the provisions of Division 3 of the Business and Professions of Division 3 of the Business preparation; and that I am a licensed contract Division 3 of the Business and Professions Code Sections and to Business and Professions Code Section Signature  ES  Ans of Note Block for Mandatory Manda	ner calculations submitted with this Sections 110, 119,130–132, 146, 10-103a).   The installation of the installation of the Business and Professions Code and Professions Code by section of the Section of the Business and Professions Code by section of the Section of the Business and Professions Code by section of the S	permit application. The proposed by 148, & 149 of Title 24, Part 6. certificates meet the requirement tial Manual.) by the to sign this document as the engineer, or I am a licensed architect 5537.2 or 6737.3 to sign this document as the engineer that is the engineer of I am a licensed architect by the sign this document as the engineer.  LIC. #
other compliance forms and workshee has been designed to meet lighting received. The plans & specifications may part 6 (10-103a 3).  ☐ The operation & maintenance information Please check one: (These sections of the please check one: (These sections).  ☐ I hereby affirm that I am eligible under the section of the person responsible for its preparation; and the person responsible for its as the person responsible for its I affirm that I am eligible under work described as exempt pursue PRINCIPAL LIGHTING DESIGNER-NAMINGUILIAM MAZZETTI  LIGHTING MANDATORY MEASURE  ✓ ☐ Indicate location on plucification of the person of the pe	ets, with the specifications, and with any oth quirements contained in applicable parts of seet the requirements of Part 6 (Sections of the requirements of Part 6 (Sections of the Business and Professions Code and that I am licensed in the State of Californ the provisions of Division 3 of the Business preparation; and that I am a licensed contract Division 3 of the Business and Professions Code Sections of Note Block for Mandatory M	ner calculations submitted with this Sections 110, 119,130–132, 146, 10-103a).   The installation of the installation of the Installation of the Business and Professions Code in as a civil engineer or electrical of the and Professions Code by section of the code to sign this document because of the code o	permit application. The proposed by 148, & 149 of Title 24, Part 6. certificates meet the requirement tial Manual.) by the to sign this document as the engineer, or I am a licensed architect 5537.2 or 6737.3 to sign this document as the engineer that is the engineer of I am a licensed architect by the sign this document as the engineer.  LIC. #
other compliance forms and workshee has been designed to meet lighting received. The plans & specifications may part 6 (10-103a 3).  ☐ The operation & maintenance informal Please check one: (These sections of the please check one: (These sections) and the please check one: (These s	ets, with the specifications, and with any oth quirements contained in applicable parts of seet the requirements of Part 6 (Sections formation meet the provisions of Division 3 of the Business and Professions of Division 3 of the Business preparation; and that I am a licensed contract Division 3 of the Business and Professions Code Sections and to Business and Professions Code Section Signature  ES  Ans of Note Block for Mandatory Manda	ner calculations submitted with this Sections 110, 119,130–132, 146, 10-103a).   The installation of the installation of the Installation of the Business and Professions Code in the Business and Professions Code by section of the Business Code to sign this document because of the Business Sections 5537, 5538 and 6737.1.  The Business and Professions Code by section of the Business Code to sign this document because of the Business Sections 5537, 5538 and 6737.1.  The Installation of the Installation of the Business Advance of the Business Code by section of the Business Code by secti	permit application. The proposed by 148, & 149 of Title 24, Part 6. certificates meet the requirement by tial Manual.) by the to sign this document as the engineer, or I am a licensed architect 5537.2 or 6737.3 to sign this document as the permit by the time of time of

PROJECT NAME COLLEGE OF SAN MA INSTALLED INDOOR LIGHT			(1 3113 = 3	f 4) L7	
			D SPACES	DATE 09-119	8
				ı	INSTALL WATT
		INSTALLED LIGHT	ING, CONDITIONED SPACES	(From LTG-2-C)	
			PORTABLE LIGHTING	(From LTG-3-C)	+
			DIT, CONDITIONED SPACES		-
		CONDITIONED SPACE	E ADJUSTED INSTALLED LIGI	HTING POWER	
		INSTALLED LIGHTING	G, UNCONDITIONED SPACES	(From LTG-2-C)	1,320
	L	IGHITNG CONTROL CREDIT	, UNCONDITIONED SPACES	(From LTG-4-C)	- 0
		UNCONDITIONED SPACE	E ADJUSTED INSTALLED LIGH	HTING POWER	= 1,320
ALLOWED INDOOR LIGHTIN	IG POWER FOR CONDITION	ONED SPACES			
✓ □ COMPLETE BUILDING N	AFTHOD (from LTG-5-C)				
_					
AREA CATEGORY METH					ALLOW
TAILORED METHOD (fro	om LTG-5-C)				WATTS 1,354
ALTERNATE COMPLIANCE			ALLOWED LIGH	HTING POWER	1,004
			•	-	
MANDATORY LIGHTING ME	ASURES FOR INDOOR LI	GHTING AND DAYLIT AREA	s		
MANDATORY LIGHTING ME MANDATORY INDOOR AND			s		
MANDATORY INDOOR AND  CONTROL LOCATION  (Room #, Area #, or  Description)	CONTROL IDENTIFICATION	CONTROLS  CONTROL TYPE (Auto Time Switch, Dimmimg, Photosensor, etc.)	SPACE CONTROLLED Lists the location of controlled lights	- ✓ If Control is for Daylighting	
CONTROL LOCATION (Room #, Area #, or Description) CONCESSIONS	CONTROL IDENTIFICATION OS	CONTROLS  CONTROL TYPE (Auto Time Switch, Dimmimg, Photosensor, etc.)  OCCUPANT SENSOR	SPACE CONTROLLED Lists the location of controlled lights CONCESSIONS	If Control is	
MANDATORY INDOOR AND  CONTROL LOCATION  (Room #, Area #, or  Description)	CONTROL IDENTIFICATION	CONTROLS  CONTROL TYPE (Auto Time Switch, Dimmimg, Photosensor, etc.)	SPACE CONTROLLED Lists the location of controlled lights	If Control is	
CONTROL LOCATION (Room #, Area #, or Description) CONCESSIONS	CONTROL IDENTIFICATION OS	CONTROLS  CONTROL TYPE (Auto Time Switch, Dimmimg, Photosensor, etc.)  OCCUPANT SENSOR	SPACE CONTROLLED Lists the location of controlled lights CONCESSIONS	If Control is	
CONTROL LOCATION (Room #, Area #, or Description) CONCESSIONS	CONTROL IDENTIFICATION OS	CONTROLS  CONTROL TYPE (Auto Time Switch, Dimmimg, Photosensor, etc.)  OCCUPANT SENSOR	SPACE CONTROLLED Lists the location of controlled lights CONCESSIONS	If Control is	
CONTROL LOCATION (Room #, Area #, or Description) CONCESSIONS	CONTROL IDENTIFICATION OS	CONTROLS  CONTROL TYPE (Auto Time Switch, Dimmimg, Photosensor, etc.)  OCCUPANT SENSOR	SPACE CONTROLLED Lists the location of controlled lights CONCESSIONS	If Control is	NOTE T FIELD
CONTROL LOCATION (Room #, Area #, or Description) CONCESSIONS	CONTROL IDENTIFICATION OS	CONTROLS  CONTROL TYPE (Auto Time Switch, Dimmimg, Photosensor, etc.)  OCCUPANT SENSOR	SPACE CONTROLLED Lists the location of controlled lights CONCESSIONS	If Control is	
PROJECT N				(	rail Z (	/1 <i>4</i> }		DATE	
	GE OF SAN MATEO POOL EQUIP  LED LIGHTING POWER FOR UNCONDITION							09-19-08	
INSTAL	Luminaire	MED SPACES	Lamns	/Ballast	ts	I	nstalled	Watts	<u> </u>
Α	В	С	D	E	F	G	Н	I	J
Name	Type Description	Lamp Type	Number of Lamps per Luminaire	Watts Per Lamp	Number of Ballast per Luminaire	Watts per Luminaire	If CEC Default	Number of Luminaires	Watts (H x J)
F1	SEE FIXTURE SCHEDULE	CFL	2	42	1	84	✓	2	168
F2	SEE FIXTURE SCHEDULE	F32T8	2	32	1	64	✓	4	256
F3/F3E	SEE FIXTURE SCHEDULE	F32T8	2	32	1	64	<b>✓</b>	14	896
					BLIII DINIC :	TOTAL (sum	of all pages)	+ 1,32	20
						CREDIT (fr			.0
						JSTED ACTU			20
2005 [	Nonresidential Compliance Forms							eptemb	er

INDOOR LIGHTING POWER ALLOV	VANCE	LTC	G-5-C
PROJECT NAME COLLEGE OF SAN MATEO POOL EQUIPMENT BLDG.			DATE 09-19-08
ALLOWED LIGHTING POWER (Choose One Method)		· · · · · · · · · · · · · · · · · · ·	
COMPLETE BUILDING METHOD- CONDITIONED SPACES			
BUILDING CATEGORY (From § 146 Table 146-B)	PER (ft <sup>2</sup> )	COMPLETE BLDG. AREA	ALLOWED WATTS
AREA CATEGORY METHOD – CONDITIONED SPACES			
A	В	С	D
	WATTS	AREA	ALLOWED
AREA CATEGORY (From § 146 Table 146-C) CONCESSIONS KITCHEN	PER (ft <sup>2</sup> )	(ft <sup>2</sup> ) 204	<b>WATTS</b> 326
	1.6		
MECHANICAL EQUIPMENT ROOMS	.7	1,468	1,028
		1,672	1,354
	TOTAL 0		
TAIL OPEN METUOD, CONDITIONED CDACES	TOTALS	AREA	WATTS
TAILORED METHOD- CONDITIONED SPACES			
	TOTAL AL	LOWED WATTS (From <b>LTG-6-C</b> )	
UNCONDITIONED SPACES		(FIGHTETG-6-C)	
Α	В	С	D
Complete Building and Area Category Methods	WATTS	AREA	ALLOWED
CATEGORY (From § 146 Table 146-B & C)	PER (ft <sup>2</sup> )	(ft <sup>2</sup> )	WATTS
	TOTALS	AREA	WATTS
TAILORED METHOD- UNCONDITIONED SPACES			
	IOONDITIONED CT. CTC.	LOWED	
TOTAL <b>ui</b>	NCONDITIONED SPACES AL From LTG-5	.LOWED WATTS 5-C and LTG-6-C)	
	(110111110-	2 3 a.a. 270-0-0)	
2005 Nonresidential Compliance Forms			eptember

CERTIFICATE OF COMPLIANCE	(Part 4 of 4) L
PROJECT NAME COLLEGE OF SAN MATEO POOL EQUIPMENT BLDG.	DATE 09-19-08
<b>Designer:</b> This form is to be used by the designer and attached to the plans. Listed below	
The designer is required to check the boxes by all acceptance tests that apply a lf all equipment of a certain type requires a test, list the equipment description parentheses. The NJ number designates the Section in the Appendix of the No Also indicate the person responsible for performing the tests (i.e. the installing by the owner). Since this form will be part of the plans, completion of this sect scope of work appropriately.	and the number of systems to be teste onresidential ACM Manual that describe contractor, design professional or an a
Building Departments:  Systems Acceptance. Before an occupancy permit is granted for a newly conconditioning system serving a building or space is operated for normal use, all certified as meeting the Acceptance Requirements for Code Compliance. In adshall be submitted to the building department that:	control devices serving the building or
A. Certifies plans, specifications, installation certificates, and operating a of §10-103(b) and Title 24 Part 6.	nd maintenance information meet the
310-100(b) and Time 241 art 0.	
Total December 1	Test P
Test Description	By:
✓ ■ LTG-2-A: Lighting Control Acceptance Document	
<ul><li>Occupancy Sensor Acceptance</li><li>Manual Daylight Controls Acceptance</li></ul>	
Automatic Time Switch Control Acceptance	
Equipment requiring acceptance testing	
CEILING OCCUPANCY SENSOR	
✓ □ LTG-3-A: Automatic Daylighting Controls Acceptance Document	
Equipment requiring acceptance testing	

TITLE 24 COMPLIANCE NOTES:
----------------------------

1. BUILDING LIGHTING SHUT-OFF:

THE BUILDING LIGHTING SHUT-OFF SYSTEM CONSISTS OF LOCAL OCCUPANCY SENSORS ZONED FOR THE CONCESSIONS ROOM.

OVERRIDE FOR BUILDING LIGHTING SHUT—OFF:
 THE AUTOMATIC BUILDING SHUT—OFF SYSTEM IS PROVIDED WITH SWITCHES FOR OCCUPANCY SENSOR OVERRIDE. THE AREA OF OVERRIDE IS NOT TO EXCEED 5,000 SQUARE FEET.

3. AUTOMATIC CONTROL DEVICES CERTIFIED:
ALL AUTOMATIC CONTROL DEVICES SHALL BE CERTIFIED BY THE STATE OF CALIFORNIA AND INSTALLED AS DIRECTED BY THE MANUFACTURER FOR PROPER CONTROL AND OPERATION.

4. FLUORESCENT BALLAST AND LUMINAIRES CERTIFIED:

ALL FLUORESCENT FIXTURES SPECIFIED SHALL BE LISTED IN THE DIRECTORY OF CERTIFIED LUMINAIRES AND BALLASTS. ALL INSTALLED FIXTURES SHALL BE CERTIFIED BY THE STATE.

5. TANDEM WIRING:

TANDEM WIRING IS NOT APPLICABLE TO THE SURFACE MOUNTED LUMINAIRES SPECIFIED IN THIS PROJECT.

6. INDIVIDUAL ROOM/AREA CONTROLS:

EACH ROOM AND AREA IN THIS BUILDING SHALL BE EQUIPPED WITH A SEPARATE SWITCH OR OCCUPANCY SENSOR DEVICE FOR EACH AREA WITH FLOOR—TO—CEILING WALLS.

7. UNIFORM REDUCTION FOR INDIVIDUAL ROOMS:

ALL ROOMS AND AREAS GREATER THAN 100 SQUARE FEET AND WITH MORE THAN 0.8 WATTS PER SQUARE FOOT OF LIGHTING LOAD SHALL BE CONTROLLED WITH BI-LEVEL SWITCHING FOR UNIFORM REDUCTION OF LIGHTING WITHIN THE ROOM.


8. DAYLIGHT AREA CONTROL:

ALL ROOMS THAT ARE GREATER THAN 250 SQUARE FEET, WITH WINDOWS, AND THAT ALLOW FOR THE EFFECTIVE USE OF DAYLIGHT, SHALL HAVE AT LEAST 50% OF THE LAMPS IN EACH DAYLIT AREA CONTROLLED BY A SEPARATE SWITCH.

9. CONTROL OF EXTERIOR LIGHTS:

EXTERIOR MOUNTED FIXTURES ATTACHED TO OR POWERED BY THE ELECTRICAL SERVICE IN BUILDINGS THAT CONTAIN CONDITIONED SPACE SHALL BE CONTROLLED WITH A DIRECTIONAL PHOTOCELL CONTROL ON THE ROOF OR AN ASTRONOMICAL TIME SWITCH AND A CORRESPONDING ELECTRICAL CONTACTOR THAT AUTOMATICALLY TURNS OFF THE EXTERIOR LIGHTING WHEN DAYLIGHT IS AVAILABLE. EXTERIOR LUMINAIRES WITH LAMPS RATED OVER 100 WATTS THAT HAVE A SOURCE EFFICACY OF LESS THAN 60 LUMENS PER WATT SHALL BE CONTROLLED BY A MOTION SENSOR.

DRAWING OF RECORD
ROSENDIN ELECTRIC, INC.
DATE: 11/17/2010

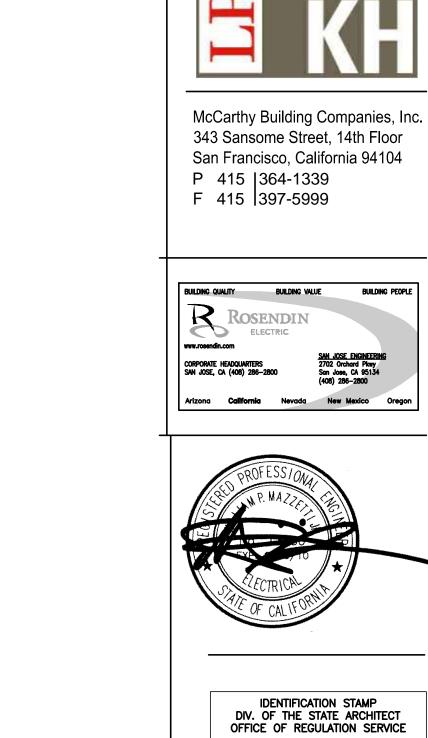

This and all other project documents and all ideas, aesthetics and designs incorporated therein are instruments of service. All project documents are the registered property of LPA, INC. (LPA) and cannot be lawfully used in whole or in part for any project or purpose except as described in the contractual agreement between McCarthy and the District. LPA hereby gives formal notice that any such project document use, reproduction or modification (misuse) is not only unlawful but automatically binds all parties involved with misuse to fully indemnify and defend LPA and LPA's Consultants to the maximum legal extent against all losses, demands, claims or liabilities arising directly or indirectly from project document misuse. Project documents describe design intent of work and are not a representation of as-built or existing conditions. LPA and LPA's Consultants make no representations concerning the accuracy of documents and are not responsible for any discrepancies between project documents and the existing conditions.

APPL. #: 01-110097

**College of San Mateo Site Package**San Mateo, CA

Date	17 NOV 2010				
Revision Description	DRAWING OF RECORD				

SVIS	Revision Description	Date
	100% DESIGN DEVELOPMENT SUBMITTAL	16 JUN 2008
	50% CONSTRUCTION DOCUMENTS SUBMITTAL 08 AUG 2008	08 AUG 2008
	DSA SUBMITTAL	19 SEP 2008
	DSA FINAL	O9 APR 2009
	BULLETIN 4	
	POOL LTG. & TEL/DATA REVISIONS	19 OCT 2009
	POOL BLDG CANOPY LTG CONTROL-OWNER'S CHANGE	16 NOV 2009


 Job. No.
 300085

 Date
 09 APR 2009

 Drawn by
 FF/AA

 Checked by
 TS

Pool Bldg.Title-24
Forms & Lighting
Fixture Schedule
E10.02

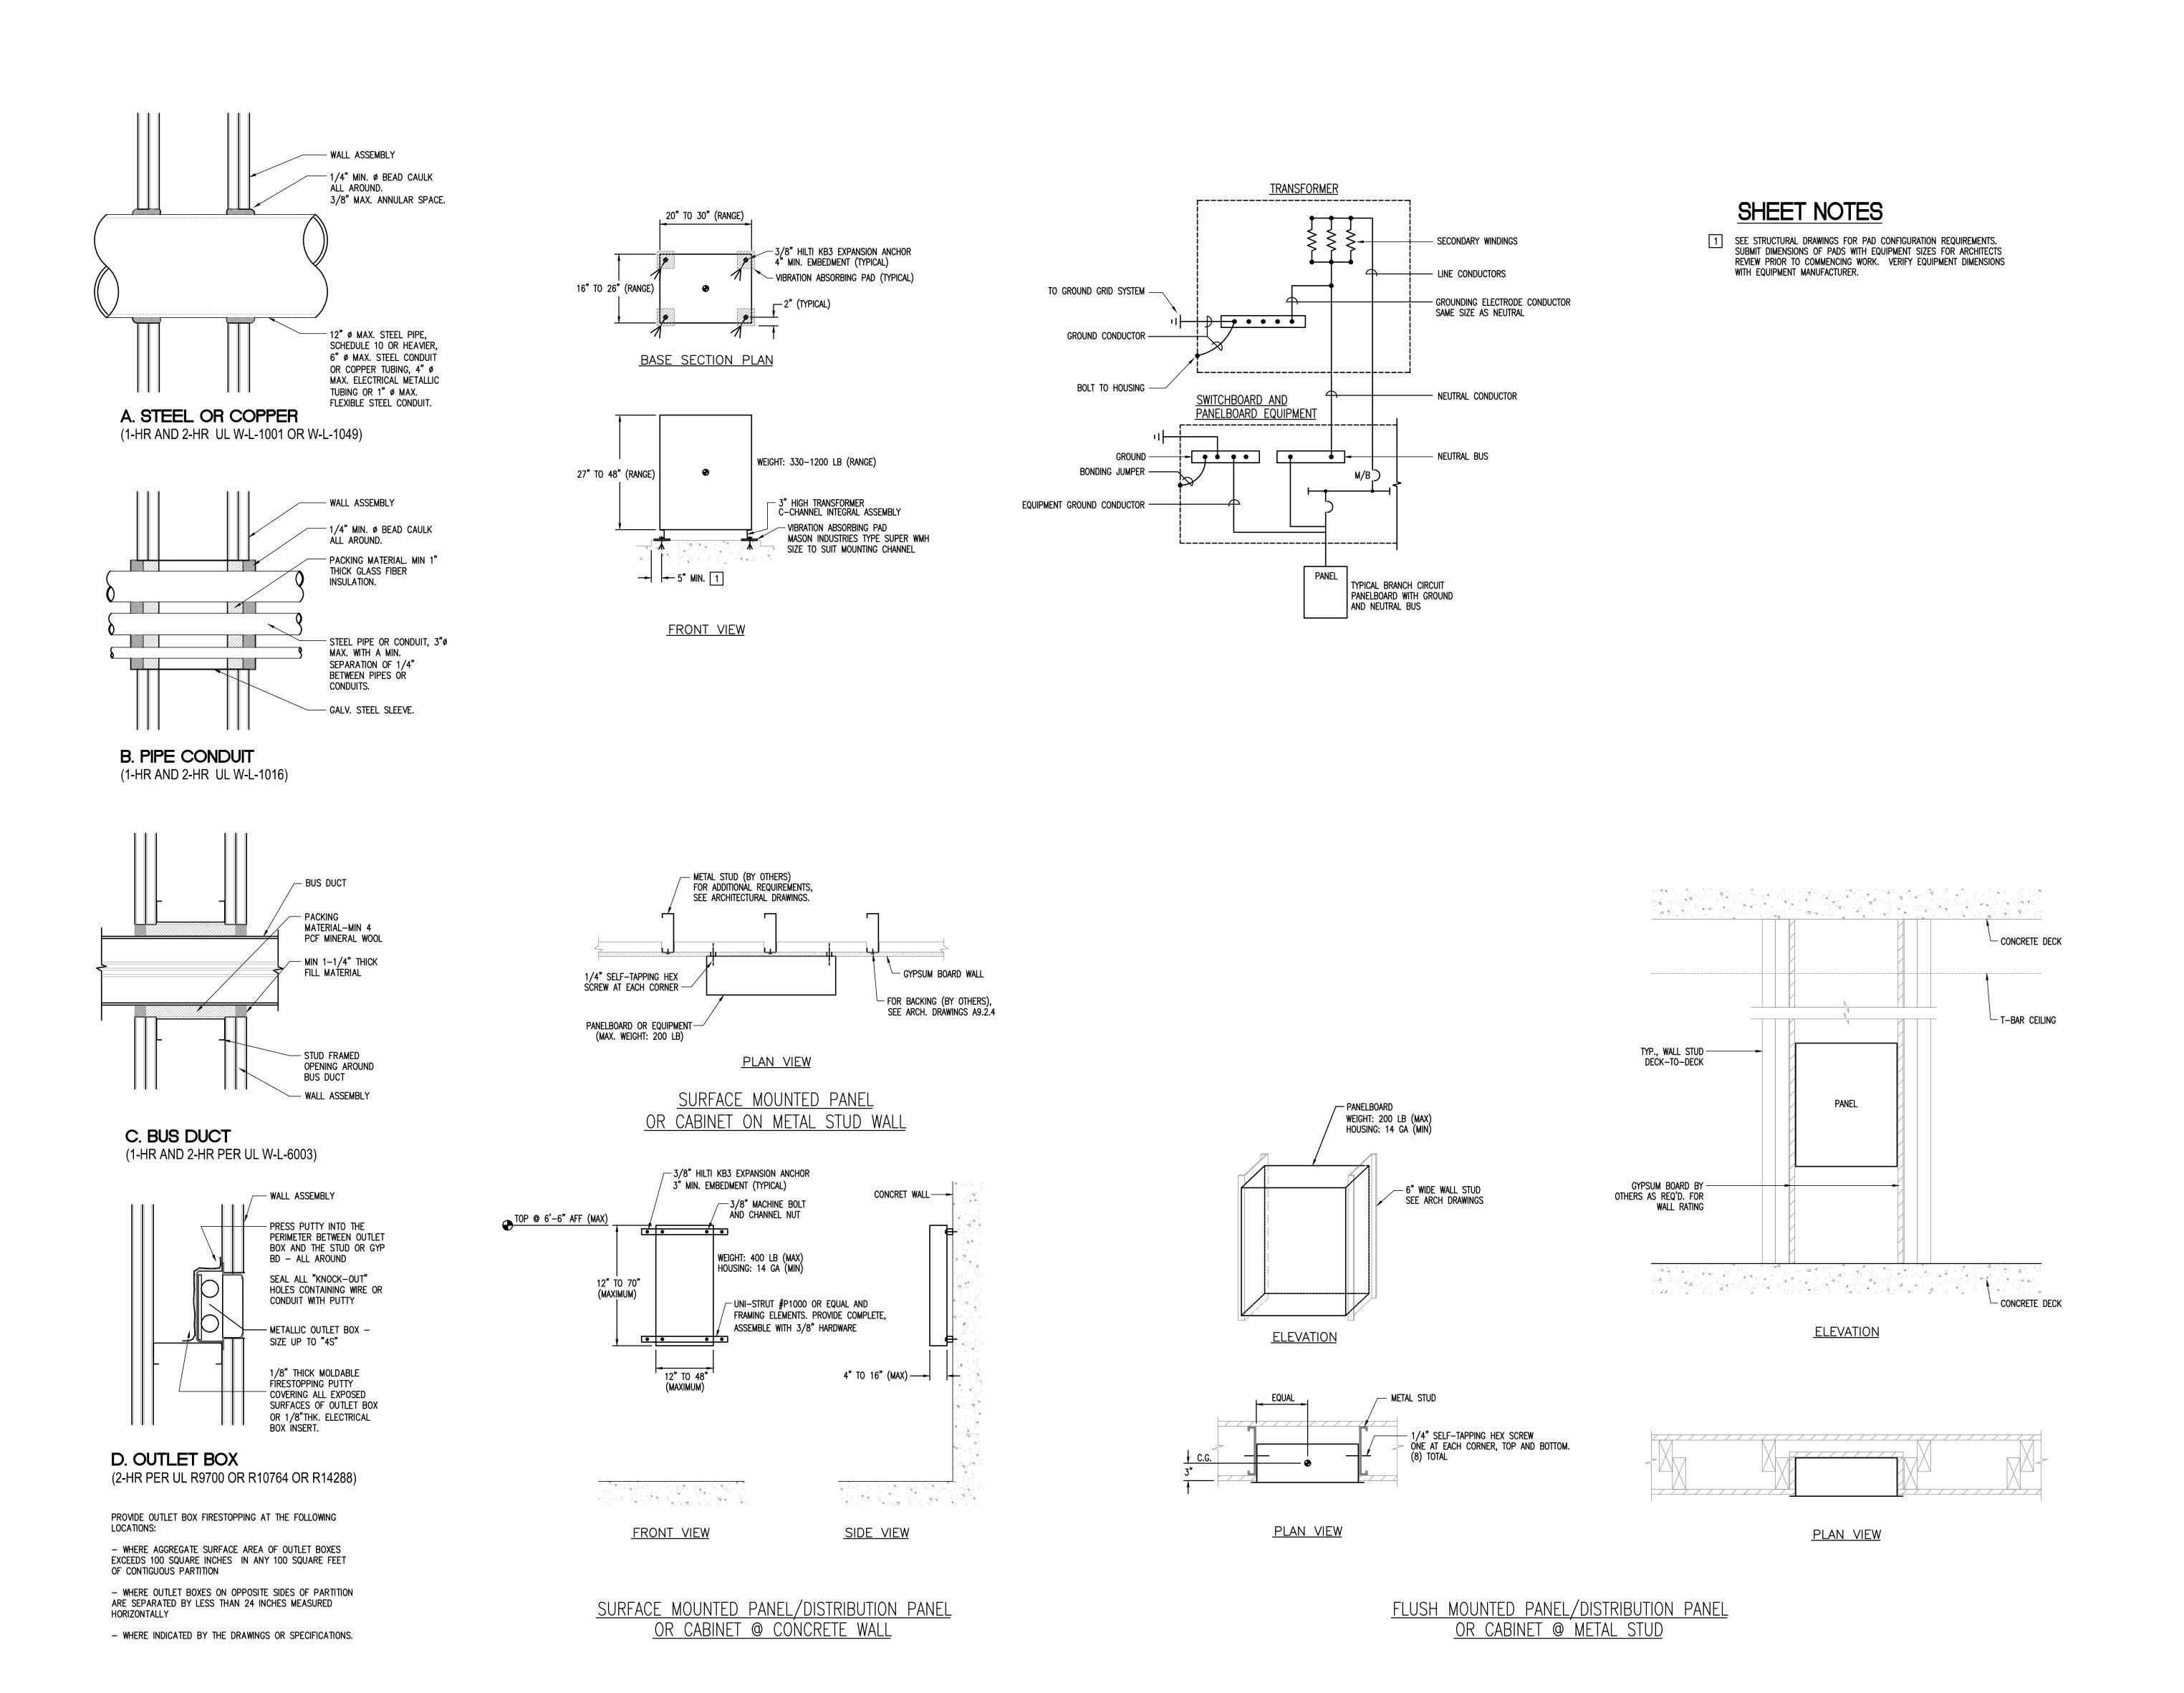

DRAWING OF RECORD ROSENDIN ELECTRIC, INC.
DATE: 11/17/2010

Checked by TS
Scale AS SHOWN

Pool Bldg. Electrical Miscellaneous Details

E10.04

09 APR 2009

McCarthy Building Companies, Inc. 343 Sansome Street, 14th Floor San Francisco, California 94104

BUILDING QUALITY BUILDING VALUE BUILDING PEOPLE

Arizona California Nevada New Mexico Oregon

IDENTIFICATION STAMP DIV. OF THE STATE ARCHITECT OFFICE OF REGULATION SERVICE

APPL. #: 01-110097

This and all other project documents and all ideas, aesthetics and designs incorporated therein are instruments of service. All project documents are the registered property of LPA, INC. (LPA) and cannot be lowfully used in whole or in part for any project or purpose except as described in the contractual agreement between InCorthy and the District. LPA hereby gives formal notice that any such project document use, reproduction or modification (misuse) is not only unlowful but automatically binds all parties involved with misuse to fully indemnify and defend LPA and LPA's Consultants to the maximum legal extent against all losses, demands, claims or liabilities orising directly or indirectly from project document misuse. Project documents describe design intent of work and are not a representation of as-built or existing conditions.

ore not a representation of as-built or existing conditions.

LPA and LPA's Consultants make no representations concerning the accuracy of documents and are not responsible for any discrepancies between project documents and the existing conditions.

C Copyright 2008

FILE NUMBER:


P 415 |364-1339

F 415 397-5999

CORPORATE HEADQUARTERS SAN JOSE, CA (408) 286–2800

## EQUIPMENT ANCHORAGE AND SUPPORT NOTES

- 1. ANCHOR ALL CONDUITS, RACEWAY AND ELECTRICAL EQUIPMENT TO BUILDING STRUCTURE OR STRUCTURAL MEMBERS.
- 2. CONDUITS 1/2" TO 2": ATTACH TO STRUCTURE PER CALIFORNIA BUILDING CODE AND CALIFORNIA ELECTRICAL CODE ATTACHMENT REQUIREMENTS.
- 3. CONDUITS 2 1/2" AND LARGER: ANCHOR TO STRUCTURE PER SPECIFICATION SECTION 16180.
- 4. ALL CONDUITS TO BE SUPPORTED AT 10 FEET ON CENTERS AND WITHIN FEET OF ENDS.

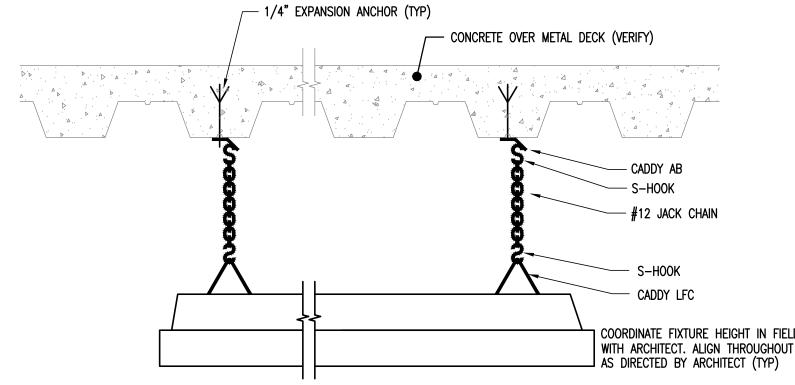

SUSPENDED CHAIN-HUNG FLUORESCENT

CADDY LFC


COORDINATE FIXTURE HEIGHT IN FIELD
WITH ARCHITECT. ALIGN THROUGHOUT
AS DIRECTED BY ARCHITECT (TYP)


INTERMEDIATE/END SUPPORT

- BACKING PLATE: FOR ADDITIONAL REQUIREMENTS, - BAR HANGER SEE ARCHITECTURAL DRAWING A9.2.4 — WALL STUD (TYP) -#8 TEK SCREW (TYP) MOUNT FIXTURE WALL BRACKET ASSEMBLY - JUNCTION BOX AND TO BACKING PLATE PER FIXTURE PLASTER RING TO SUIT MANUFACTURER'S REQUIREMENTS (MINIMUM #8 TEK SCREWS) MOUNT FIXTURE WALL BRACKET ASSEMBLY TO J-BOX PER FIXTURE • LIGHTING FIXTURE LIGHTING FIXTURE — MANUFACTURER'S REQUIREMENTS WEIGHT < 20 LBS (MINIMUM 2 SCREWS) FEED-END SUPPORT


ARRANGEMENT B
PROVIDE ONLY WHERE ARRANGEMENT 'A' IS
NOT AVAILABLE DUE TO SPATIAL CONSTRAINTS


WALL SURFACE MOUNTED FLUORESCENT

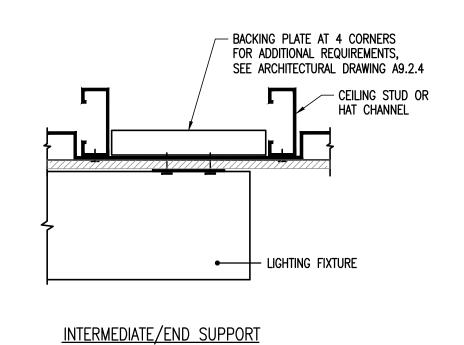

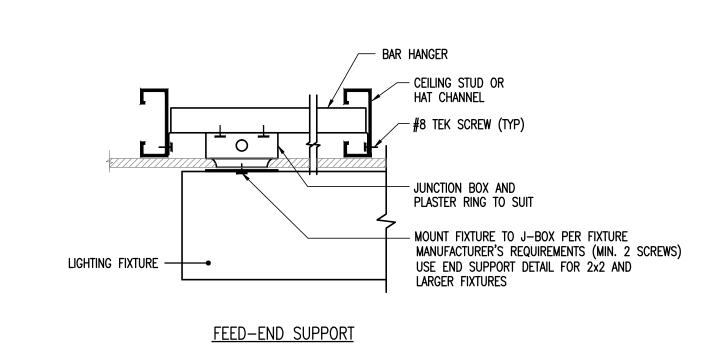


CEILING SURFACE MOUNTED FLUORESCENT

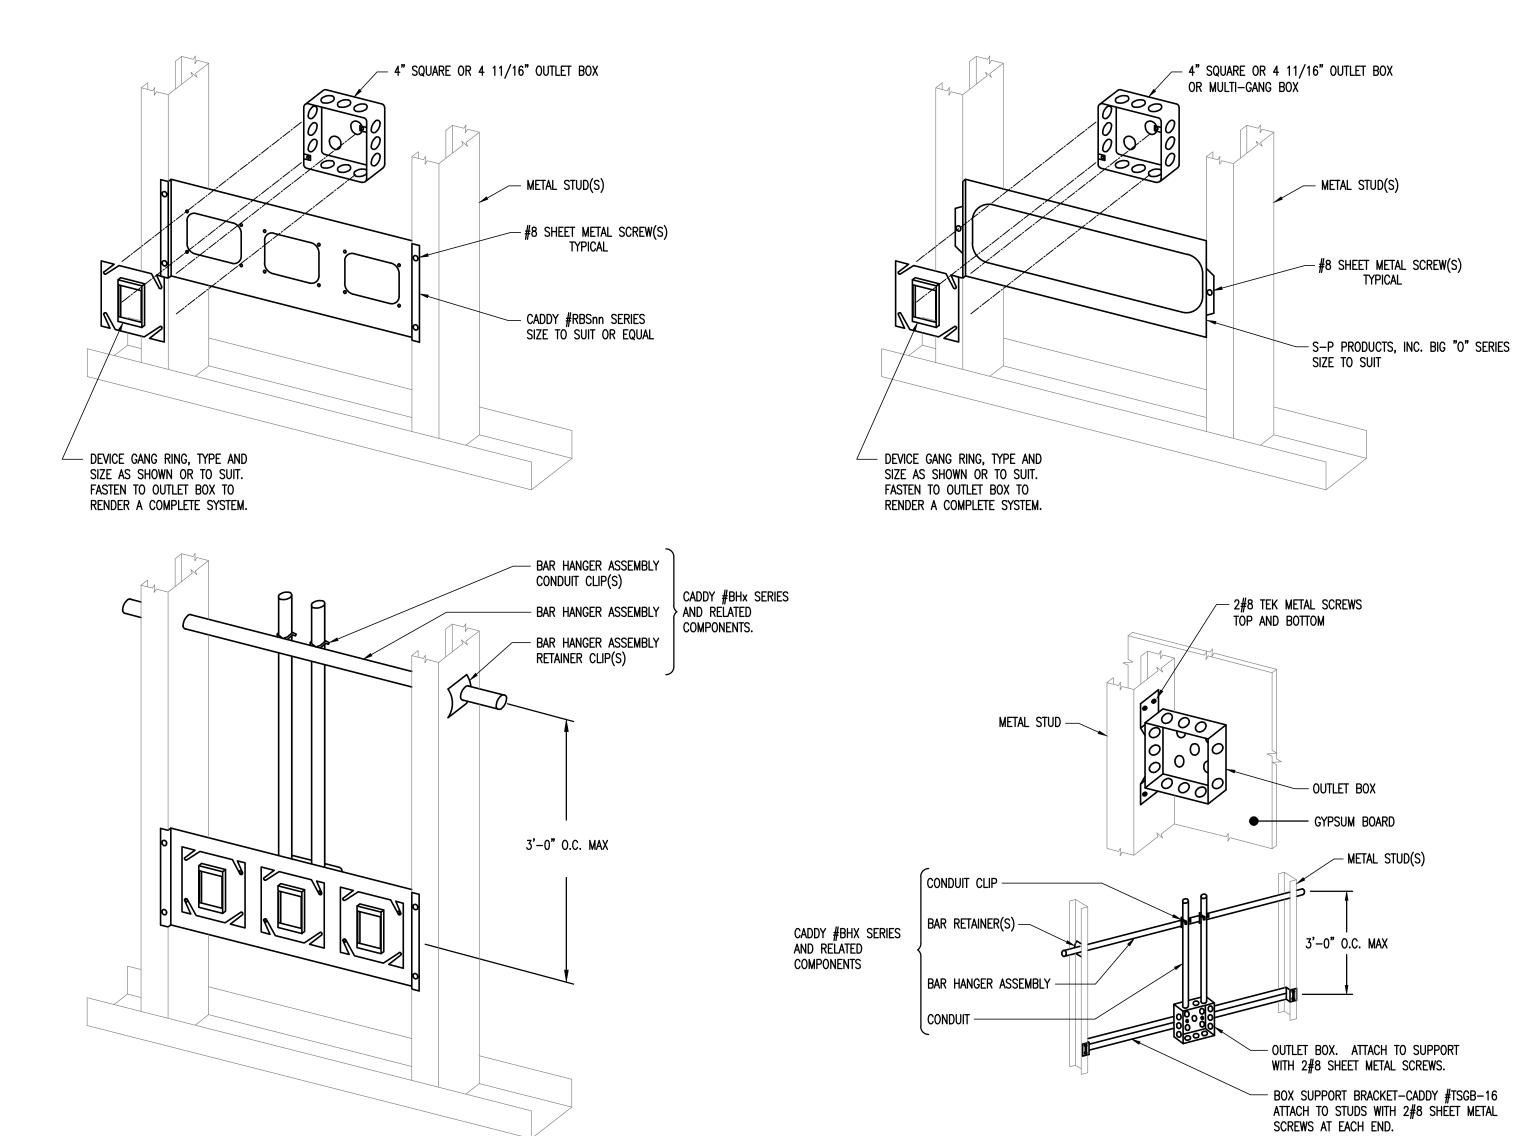

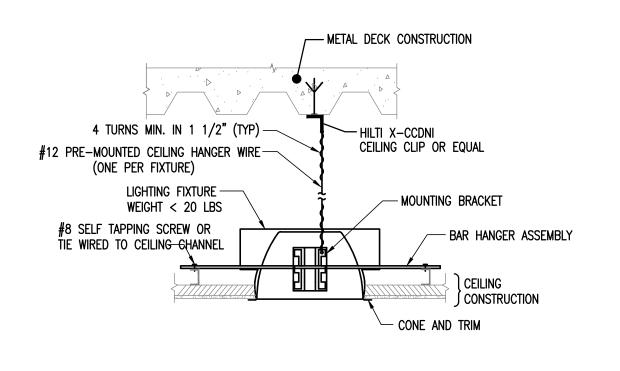

RECESSED DOWNLIGHT
GYPSUM BOARD CEILING

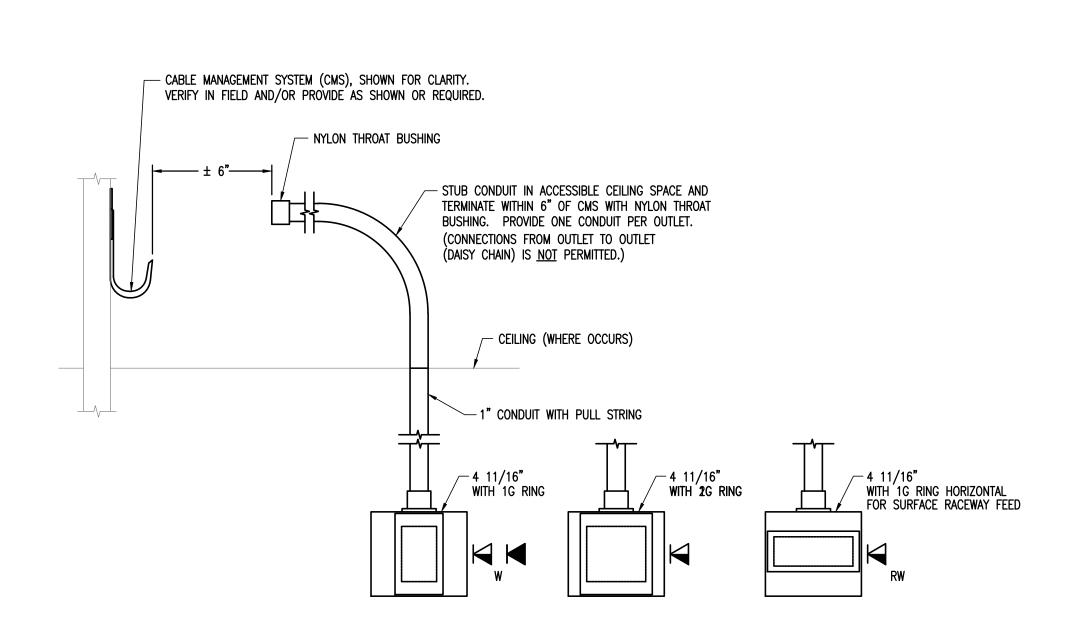

DRAWING OF RECORD ROSENDIN ELECTRIC, INC.
DATE: 11/17/2010



McCarthy Building Companies, Inc. 343 Sansome Street, 14th Floor San Francisco, California 94104 P 415 | 364-1339 F 415 | 397-5999

BUILDING QUALITY

BUILDING VALUE

BUILDING PEOPLE


ROSENDIN


ELECTRIC

WWW.rosendin.com

CORPORATE HEADQUARTERS
SAN JOSE ENGINEERING
2702 Orchard Pkmy
San Jose, CA (408) 286–2800

Arizona California Nevada New Mexico Oregon

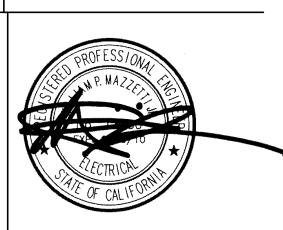

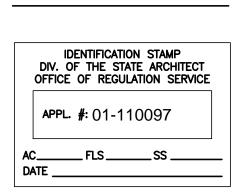

This and all other project documents and all ideas, aesthetics and designs incorporated therein are instruments of service. All project documents are the registered property of LPA, N.C. (LPA) and cannot be lawfully used in whole or in part for any project or purpose except as described in the contractual agreement between McCarthy and the District. LPA hereby gives formal notice that any such project document use, reproduction or modification (misuse) is not only unlawful but automatically binds all parties involved with misuse to fully indemnify and defend LPA and LPA's Consultants to the maximum legal extent against all losses, demands, claims or liabilities arising directly or indirectly from project document misuse. Project documents describe design intent of work and are not a representation of as—built or existing conditions. LPA and LPA's Consultants make no representations concerning the accuracy of documents and are not responsible for any discrepancies between project documents and the existing conditions.

© Copyright 2008

Site Package
San Mateo, CA
Developed for

	Revision Description	DRAWING OF RECORD						
_	ate	N 2008	3 2008	2008	ر د 2009	L 2009	, 2009	

 Job. No.
 300085

 Date
 09 APR 2009

 Drawn by
 FF/AA


Checked by TS


Scale AS SHOWN

Pool Bldg. Electrical Miscellaneous Details

E10.05

ARRANGEMENT A
PROVIDE WHERE STUD(S) ARRANGEMENT ALLOWS

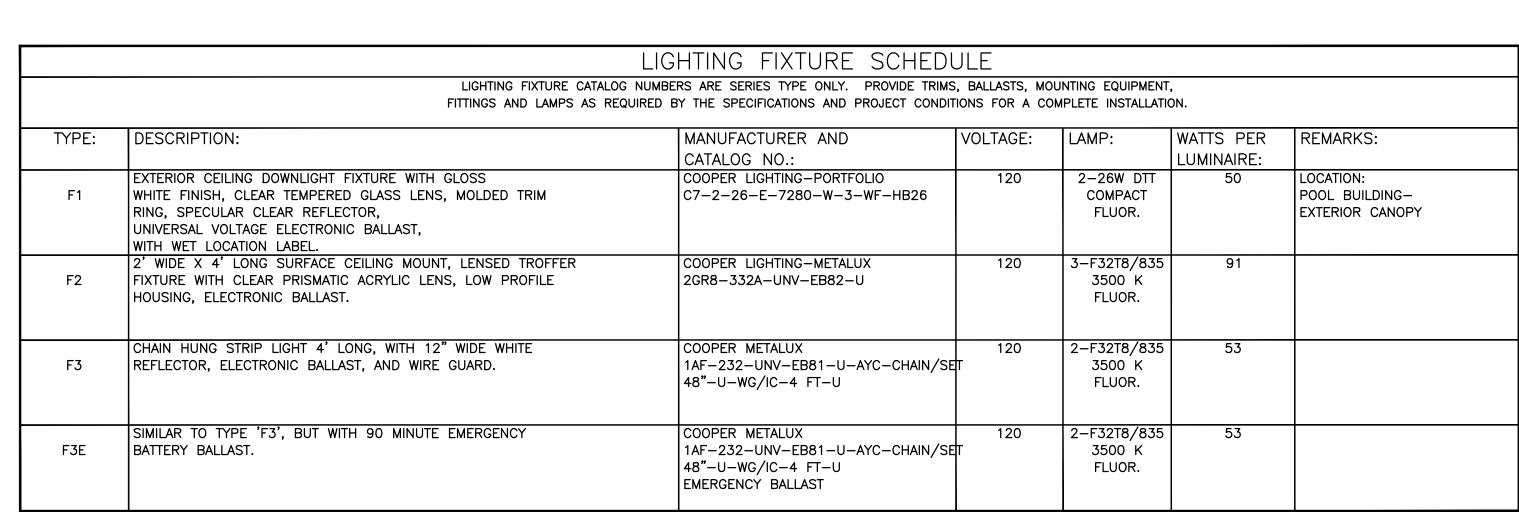

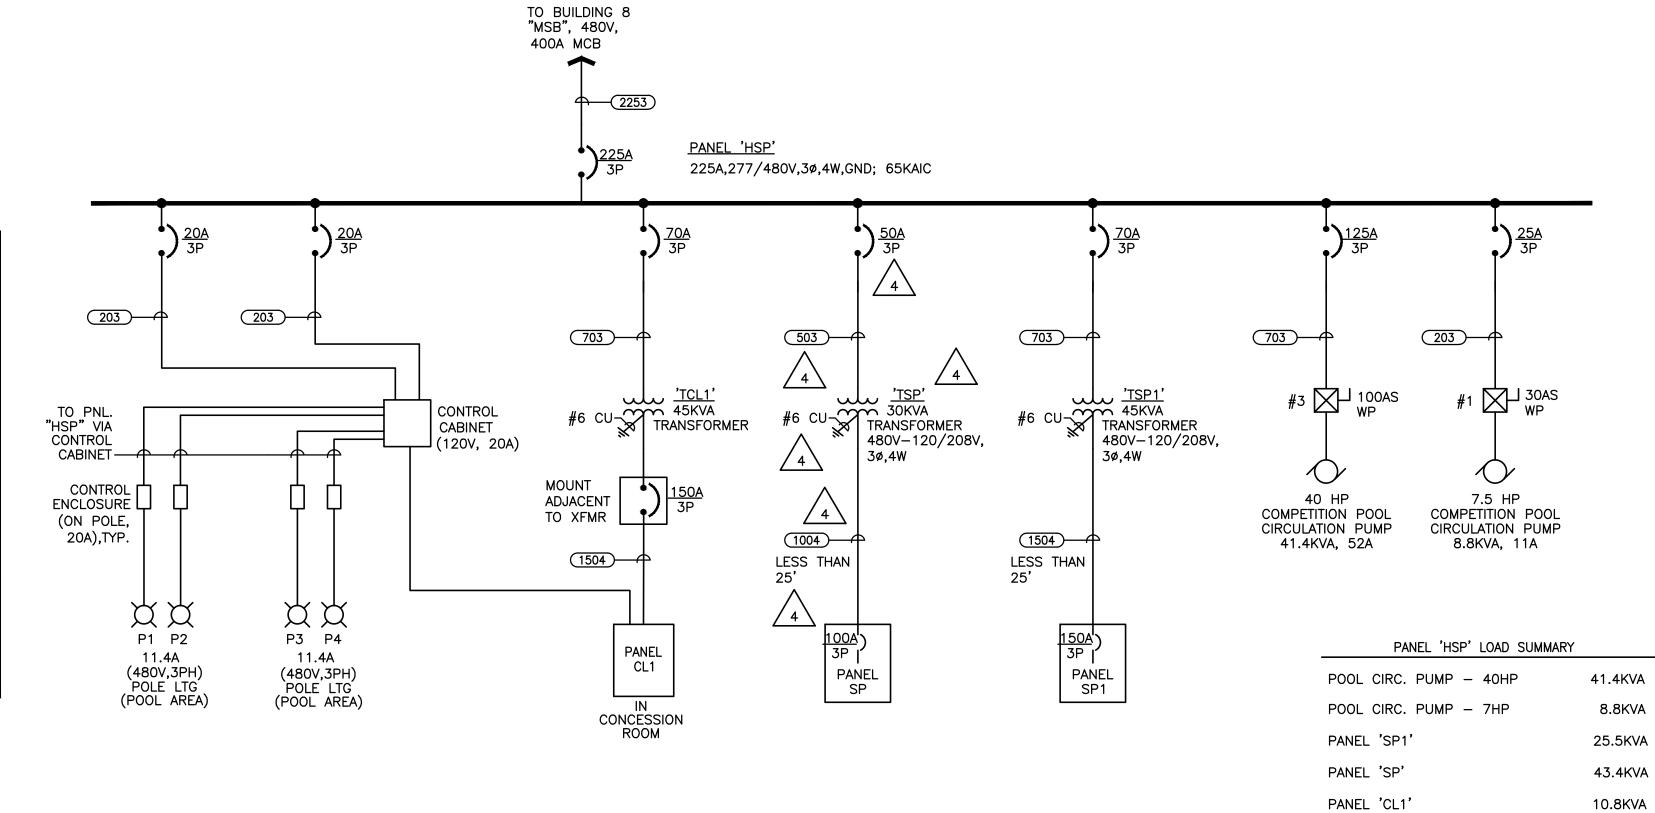

SINGLE LINE DIAGRAM


NOT

	PANEL	CL1				LOCAT	ION:		POOL EQ	MT. RM.	CONCES	SSION STAND	
YPE	DESCRIPTION	LOAD	BKR	CIR	Α	В	С	CIR	BKR	LOAD	TYPE	DESCRIPTION	
R	EQMT. RM. RECS.	540	20/1P	1	722			2	20/1P	182	L	CONCESSIONS	
R	STORAGE RMS.	750	20/1P	3		900		4	20/1P	150	L	CONCESSIONS EXTERIOR	
	STORAGE RMS. FANS	1200	20/1P	5			2000	6	20/1P	800	R	CONCESSIONS	
R	REC GFI-LT POLES	1800	20/1P	7	2600			8	20/1P	800	R	CONCESSIONS	
R	REC GFI-POOL AREA	500	20/1P	9		1300		10	20/1P	800	R	CONCESSIONS	
	SPARE		20/1P	11			800	12	20/1P	800	R	CONCESSIONS	
	FC-1	350	20/1P	13	1150			14	20/1P	800	R	CONCESSIONS	
	SPARE		20/1P	15		800		16	20/1P	800	R	CONCESSIONS	
	SPARE		20/1P	17			530	18	20/1P	530	L	POOL EQMT. RM.	
	SPACE			19	159			20	20/1P	159	L	EM POOL EQMT. RM.	
	SPACE			21		1800		22	20/1P	1800	L	CONTROL CABMUSCO LTS	
	SPACE			23			1000	24	20/1P	1000		BMS-POOL BLDG	
	SPACE			25				26	1 - 7 - 1			SPACE	
	SPACE			27		0		28				SPACE	
	SPACE			29			0	30				SPACE	
	SPACE			31				32				SPACE	
	SPACE			33		0		34				SPACE	
	SPACE			35			0	36				SPACE	
	SPACE			37	0			38				SPACE	
	SPACE			39		0		40				SPACE	
	SPACE			41			0	42				SPACE	
					4631	4800	4330	. —			•		
					39	40	36						
	SIZE:	150			GROUND:	•	•	STANDA	ARD			NOTES:	
	VOLTAGE:	208	/120V		MOUNTING:	;		SURFA	CE			1	
	PHASE:	3			<b>ENCLOSUR</b>	E:		NEMA	1			1	
	WIRE:	4			FEED:								
	LUGS:	S: M.L.O.			CONNECTED KVA PANEL				13.8			7	
	AIC RATING: 10,000			CONNECTED AMPS PANEL					38.2				
BUS: COPPER			RECEPTACLE KVA LOAD PANEL					0.1		]			
	NEUTRAL:	100%			OTHER KVA LOAD PANEL					5.4			
						LOAD (W/	DMD FCTR	)	65%	0.0			
	MAX. ALLOWED AMPS	120			LOAD (AMI	PS) PANEL				15.3			

	COPPER FEEDER	SCHEDULE - 3	3 PHASE, 3 WIRE	
FEEDER No.	AMPERE	FEEDER	GROUND	CONDUIT
153	15A, 3PH3W	3-#12	#12	1/2"
203	20A, 3PH3W	3-#12	#12	1/2"
303	30A, 3PH3W	3-#10	#10	1/2"
403	40A, 3PH3W	3-#8	#10	3/4"
503	50A, 3PH3W	3-#8	#10	3/4"
603	60A, 3PH3W	3-#6	#10	1"
703	70A, 3PH3W	3-#4	#8	1"
803	80A, 3PH3W	3-#4	#8	1"
1003	100A, 3PH3W	3-#2	#8	1 1/4"
1253	125A, 3PH3W	3-#1	#6	1 1/2"
1503	150A, 3PH3W	3-#1/0	#6	1 1/2"
1753	175A, 3PH3W	3-#2/0	#6	2"
2003	200A, 3PH3W	3-#3/0	#6	2"
2253	225A, 3PH3W	3-#4/0	#4	2 1/2"
2503	250A, 3PH3W	3-#250K	#4	2 1/2"
3003	300A, 3PH3W	3-#350K	#4	2 1/2"
3503	350A, 3PH3W	3-#400K	#2	3"
4003	400A, 3PH3W	3-#500K	#2	3"
5003	500A, 3PH3W	6-#250K	2-#2	(2) 2 1/2"
6003	600A, 3PH3W	6-#350K	2-#1	(2) 3"
8003	800A, 3PH3W	6-#500K	2-#1/0	(2) 3"
10003	1000A, 3PH3W	9-#400K	3-#2/0	(3) 3"
12003	1200A, 3PH3W	9-#600K	3-#3/0	(3) 4"
16003	1600A, 3PH3W	12-#600K	4-#4/0	(4) 4"
20003	2000A, 3PH3W	15-#600K	5-#250K	(5) 4"

20003	2000A, 3PH3W	15-#600K	5-#250K	(5) 4
	COPPER FEEDER	R SCHEDULE - 3	PHASE, 4 WIRE	•
FEEDER No.	AMPERE	FEEDER	GROUND	CONDUIT
154	15A, 3PH4W	4-#12	#12	1/2"
204	20A, 3PH4W	4-#12	#12	1/2"
304	30A, 3PH4W	4-#10	#10	1/2"
404	40A, 3PH4W	4-#8	#10	3/4"
504	50A, 3PH4W	4-#6	#10	1"
604	60A, 3PH4W	4-#6	#10	1"
704	70A, 3PH4W	4-#4	#8	1 1 /4"
804	80A, 3PH4W	4-#4	#8	1 1 /4"
1004	100A, 3PH4W	4-#2	#8	1 1/4"
1254	125A, 3PH4W	4-#1	#6	1 1/2"
1504	150A, 3PH4W	4-#1/0	#6	1 1/2"
1754	175A, 3PH4W	4-#2/0	#6	2"
2004	200A, 3PH4W	4-#3/0	#6	2"
2254	225A, 3PH4W	4-#4/0	#4	2 1/2"
2504	250A, 3PH4W	4-#250K	#4	2 1/2"
3004	300A, 3PH4W	4-#350K	#4	3"
3504	350A, 3PH4W	4-#400K	#2	3"
4004	400A, 3PH4W	4-#500K	#3	3 1/2"
5004	500A, 3PH4W	8-#250K	2-#2	(2) 2 1/2"
6004	600A, 3PH4W	8-#350K	2-#1	(2) 3"
8004	800A, 3PH4W	8-#500K	2-#1/0	(2) 3"
10004	1000A, 3PH4W	12-#400K	3-#2/0	(3) 3"
12004	1200A, 3PH4W	12-#600K	3-#3/0	(3) 4"
16004	1600A, 3PH4W	16-#600K	4-#4/0	(4) 4"
20004	2000A, 3PH4W	20-#600K	5-#250K	(5) 4"

		GENERAL NOTES
	A.	ALL LIGHTING AND POWER CIRCUITRY SHOWN ON PLAN IS CONNECTED TO PANEL 'CL1', UNLESS OTHERWISE NOTED.
$\sqrt{\frac{3}{3}}$	<u>В</u> .	CONTROL OF MUSCO LIGHTING VIA CONTROL CABINET IN THE POOL HOUSE SHALL INTERPHASE WITH THE "BMS" LOCATED AT BLDG. 7.

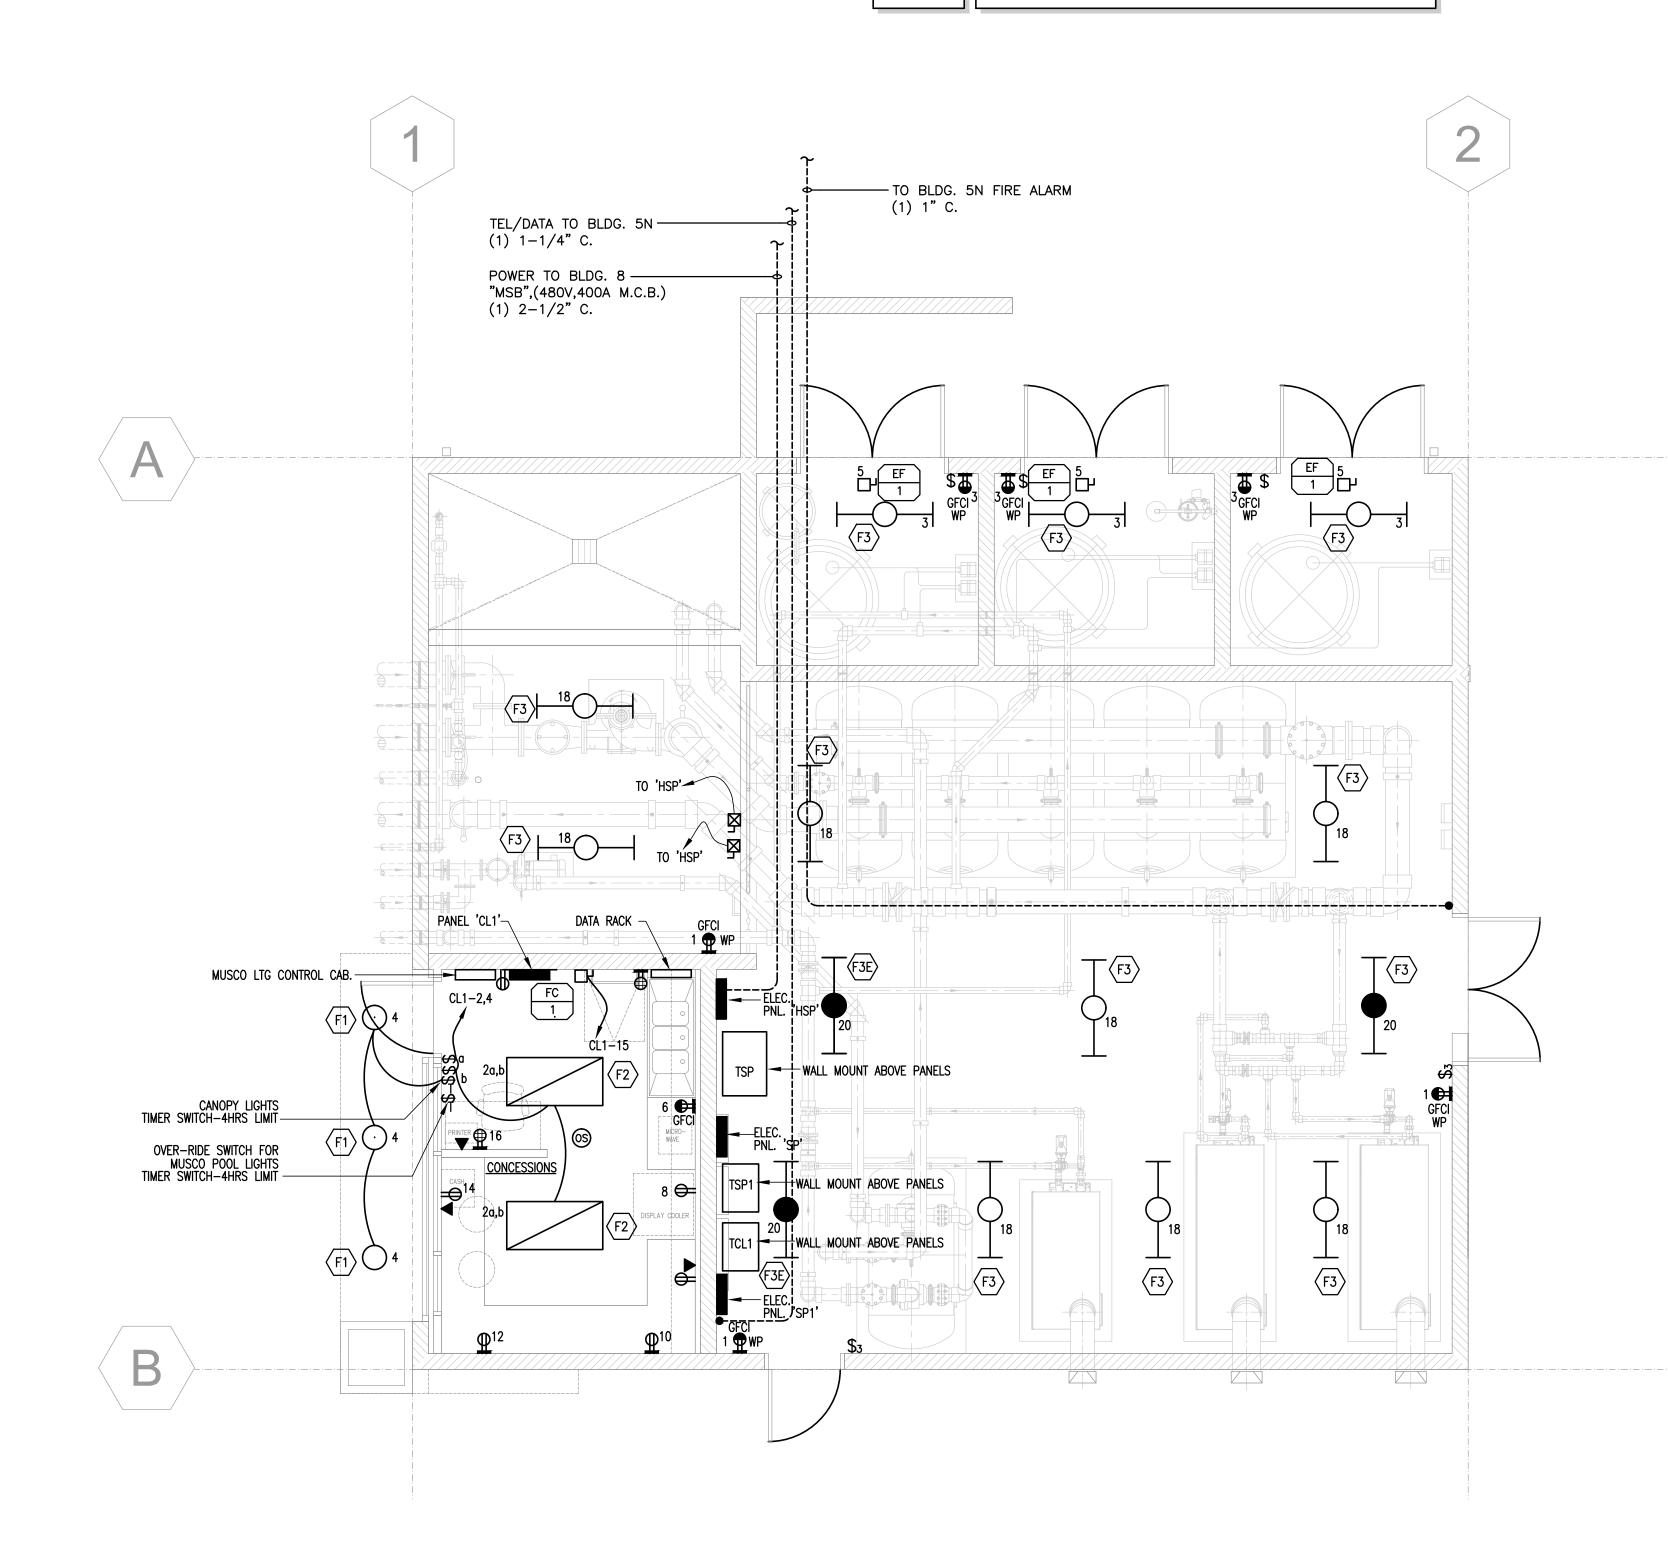

SCALE: 1/4"=1'-0"


LIGHTING, POWER & DATA PLAN

DRAWING OF RECORD ROSENDIN ELECTRIC, INC. DATE: 11/17/2010

129.9KVA 156.5A@480V,3ø

McCarthy Building Companies, Inc. 343 Sansome Street, 14th Floor San Francisco, California 94104 P 415 |364-1339 F 415 397-5999

BUILDING QUALITY BUILDING VALUE BUILDING PEOPLE CORPORATE HEADQUARTERS SAN JOSE, CA (408) 286–2800 Arizona California Nevada New Mexico Oregon

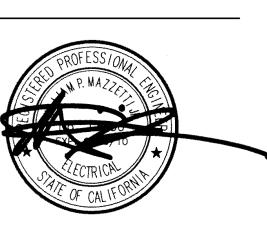

IDENTIFICATION STAMP
DIV. OF THE STATE ARCHITECT
OFFICE OF REGULATION SERVICE APPL. #: 01-110097

FILE NUMBER: This and all other project documents and all ideas, aesthetics and designs incorporated therein are instruments of service. All project documents are the registered property of LPA, INC. (LPA) and cannot be lawfully used in whole or in part for any project or purpose except as described in the contractual agreement between McCarthy and the District. LPA hereby gives formal notice that any such project document use, reproduction or modification (misuse) is not only unlawful but automatically binds all parties involved with misuse to fully indemnify and defend LPA and LPA's Consultants to the maximum legal extent against all losses, demands, claims or liabilities arising directly or indirectly from project document misuse. Project documents describe design intent of work and are not a representation of as-built or existing conditions. are not a representation of as-built or existing conditions.

LPA and LPA's Consultants make no representations concerning the accuracy of documents and are not responsible for any discrepancies between project documents and the existing conditions.

Revision Description	DRAWING OF RECORD				
Revis					

09 APR 2009

Pool Bldg. Lighting, Power Plan & Single

Line Diagram E10.10