

Rev	Date	Description	Author	Checked
1	12.02.10	PROGRESS		
2	12.02.10	REVISION #1		
3	12.02.10	REVISION #2		
4	12.02.10	REVISION #3		
101	12.02.10	REVISION #100		

RECORD DOCUMENT
 Date: 09.16.11


City of San Mateo
 County of San Mateo
 State of California

Prepared Under the Direction of:


ELECTRICAL SCHEDULE/
 SITE PLAN/
 DETAIL

Sheet **E-1**


Scale: AS NOTED
 Date: 1-28-11
 File:
 Plan File:

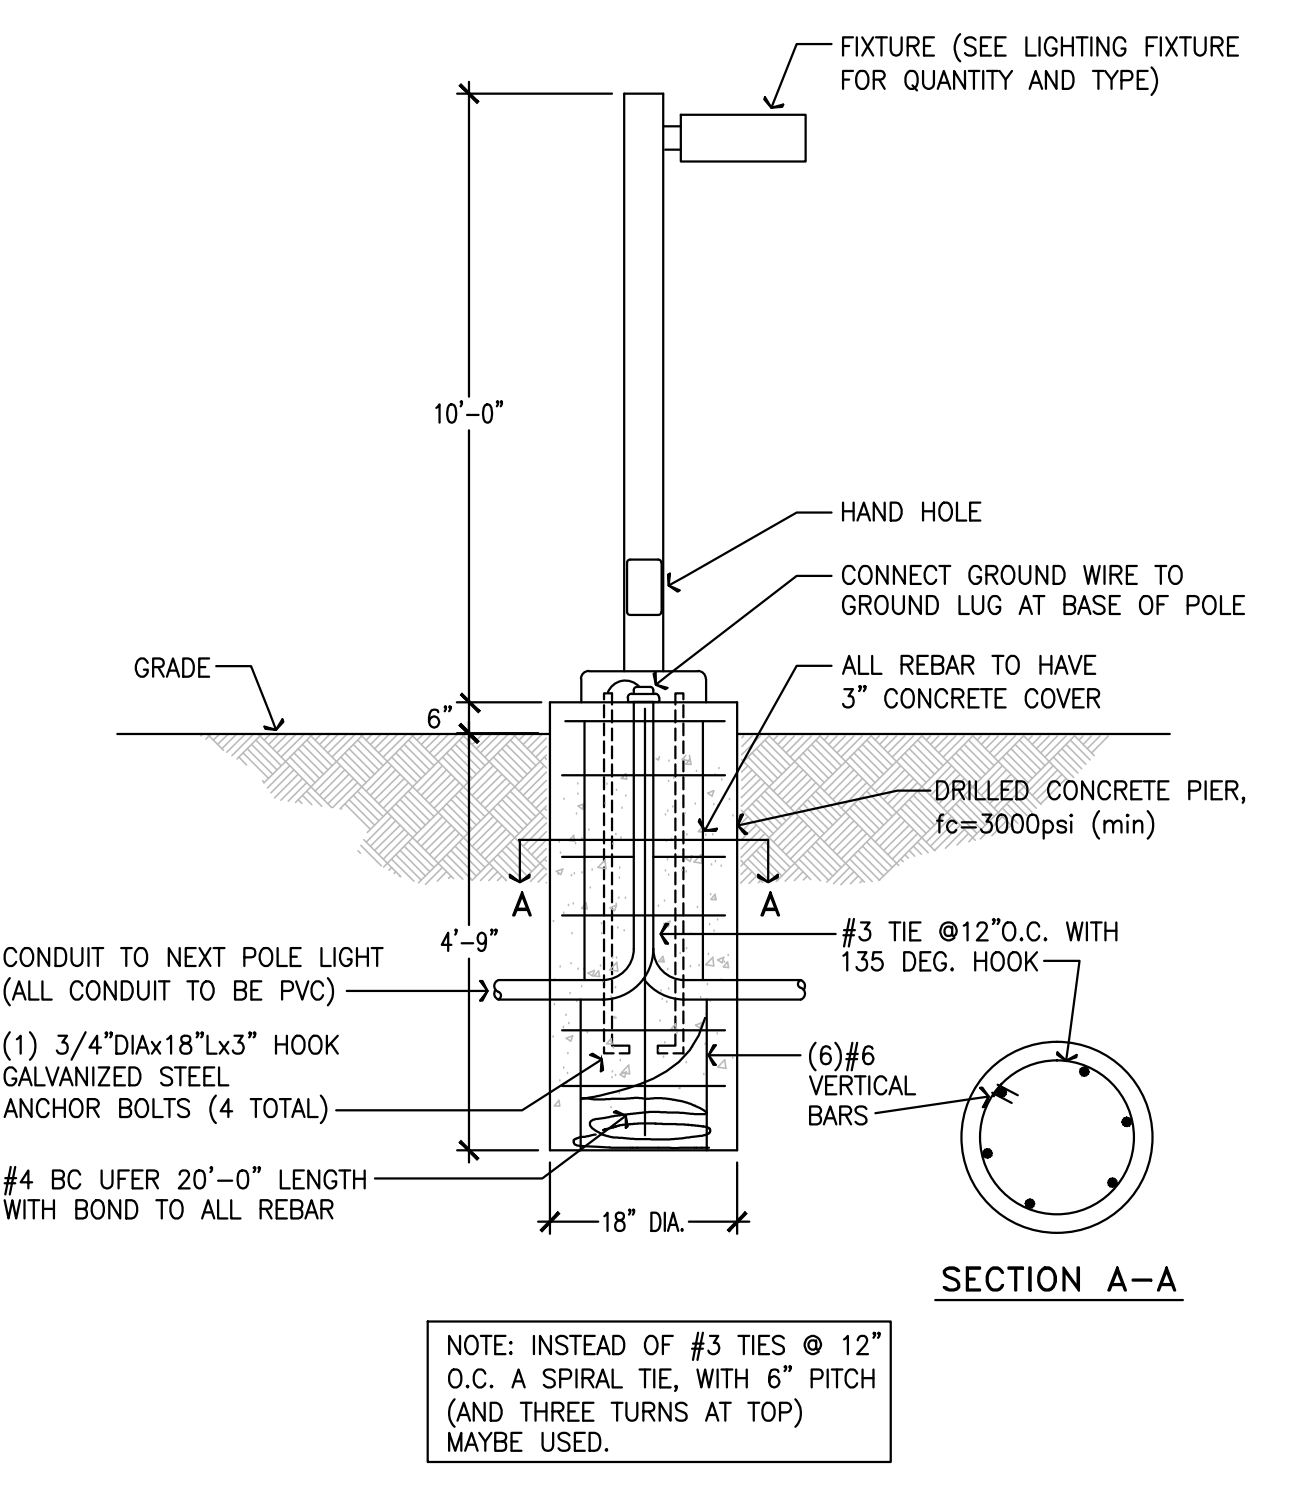


4 POLE FIXTURE MOUNTING DETAIL
 SCALE: NTS

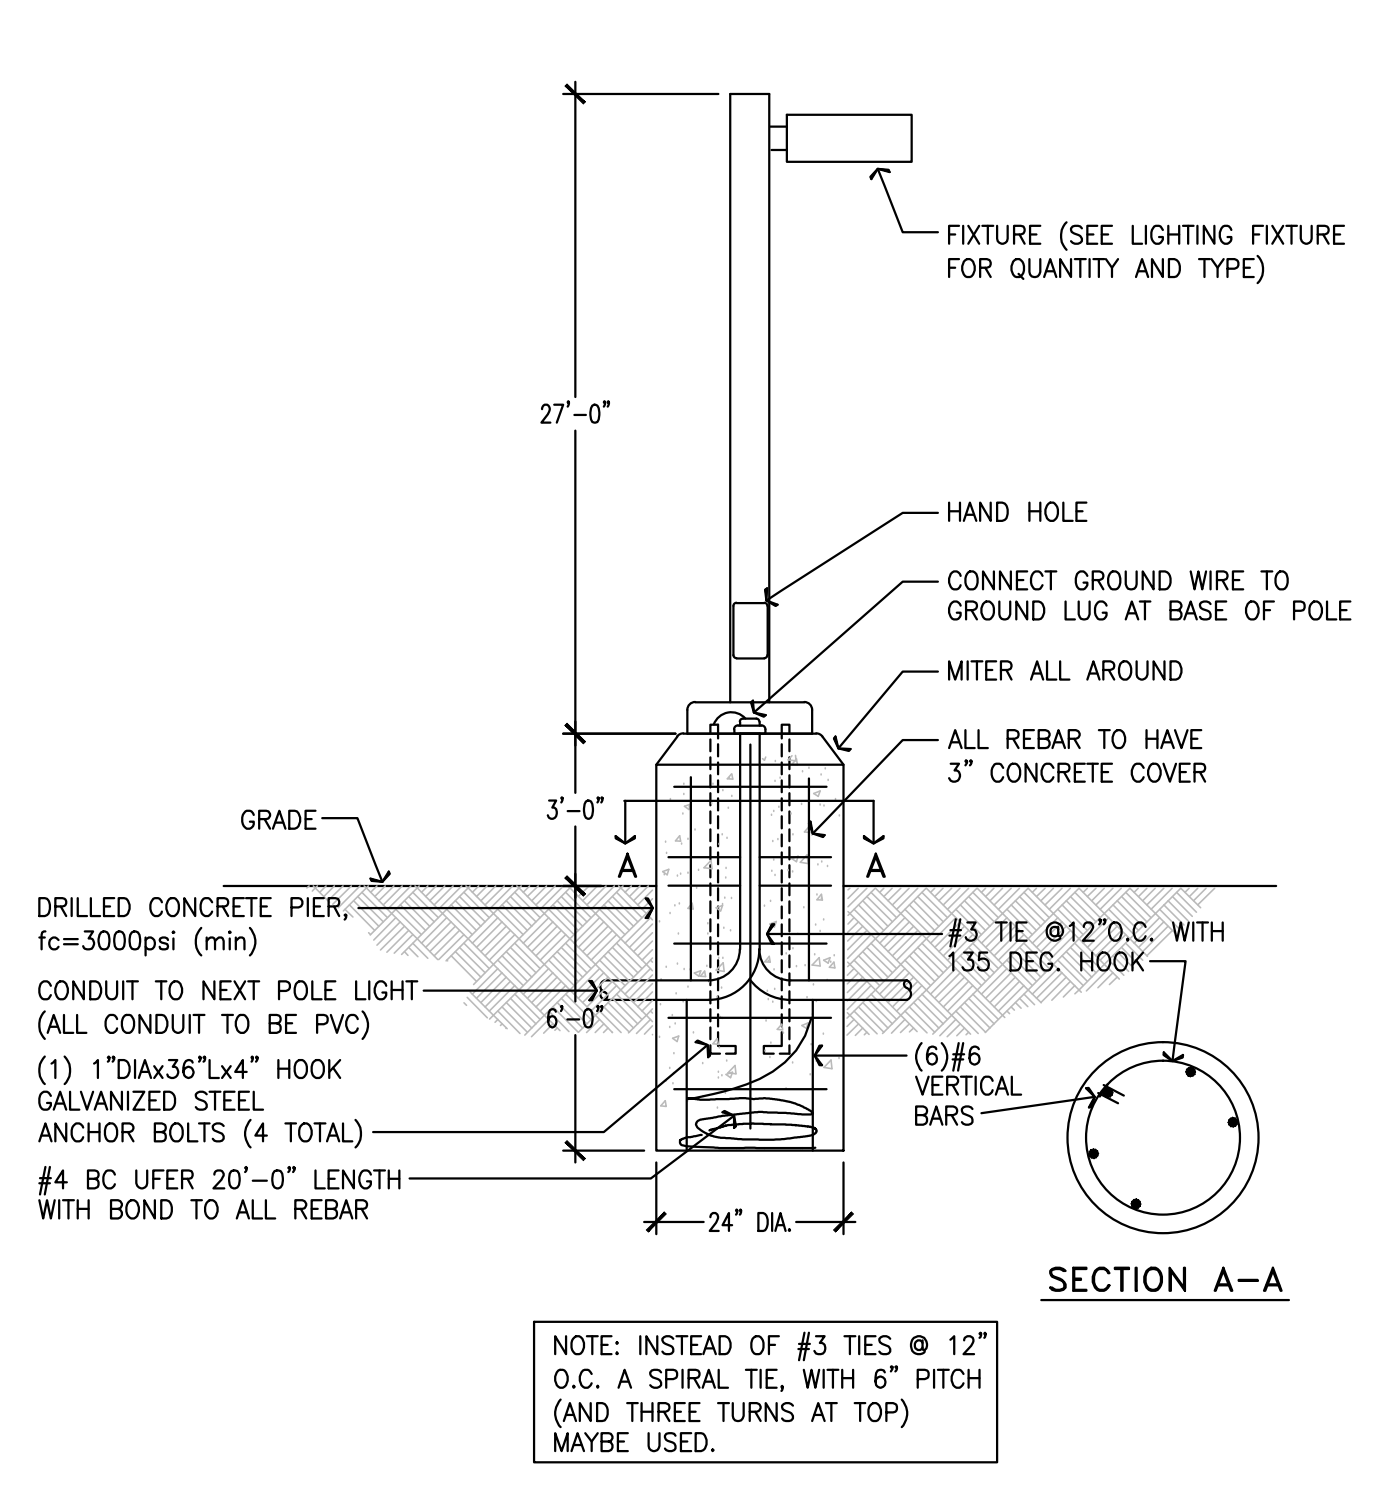


3 POLE FIXTURE MOUNTING DETAIL
 SCALE: NTS

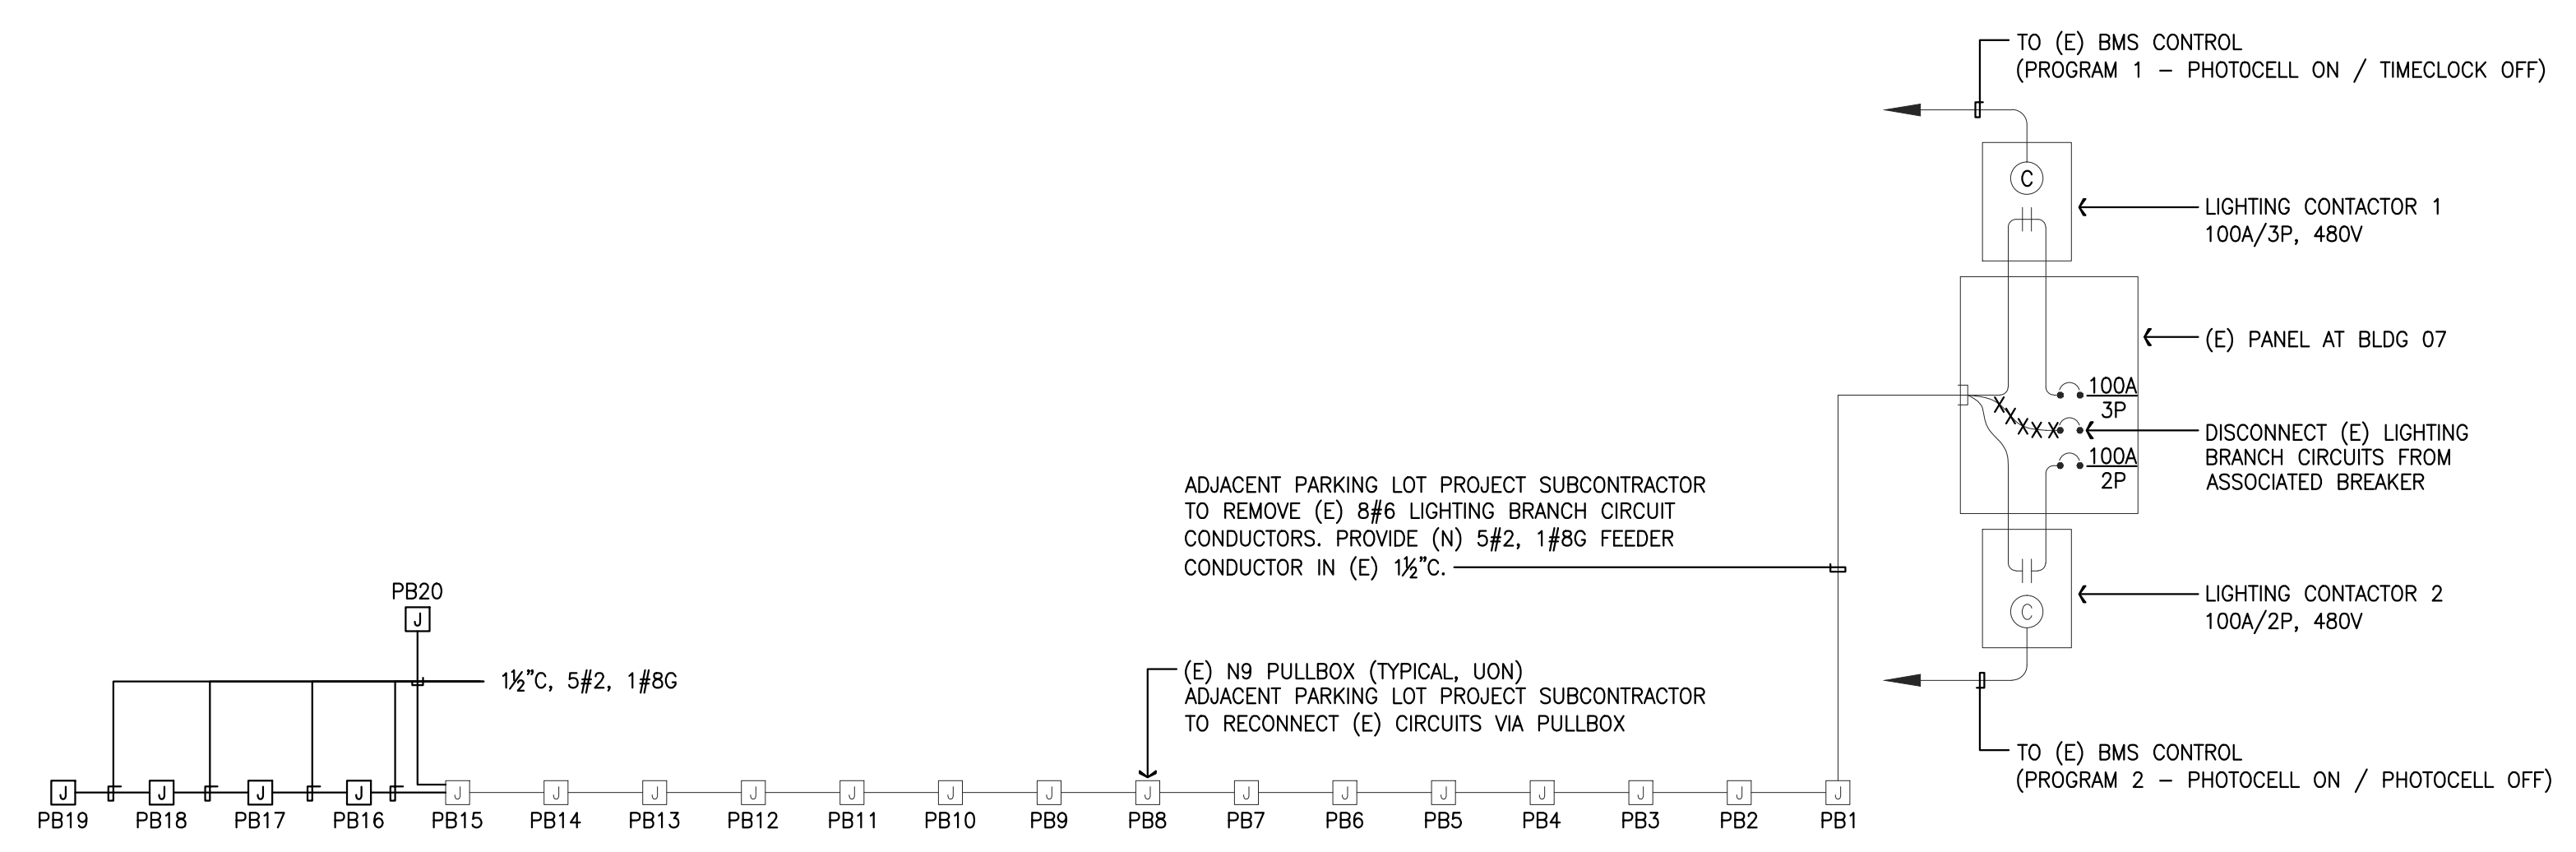


5 SINGLE LINE DIAGRAM
 SCALE: NTS

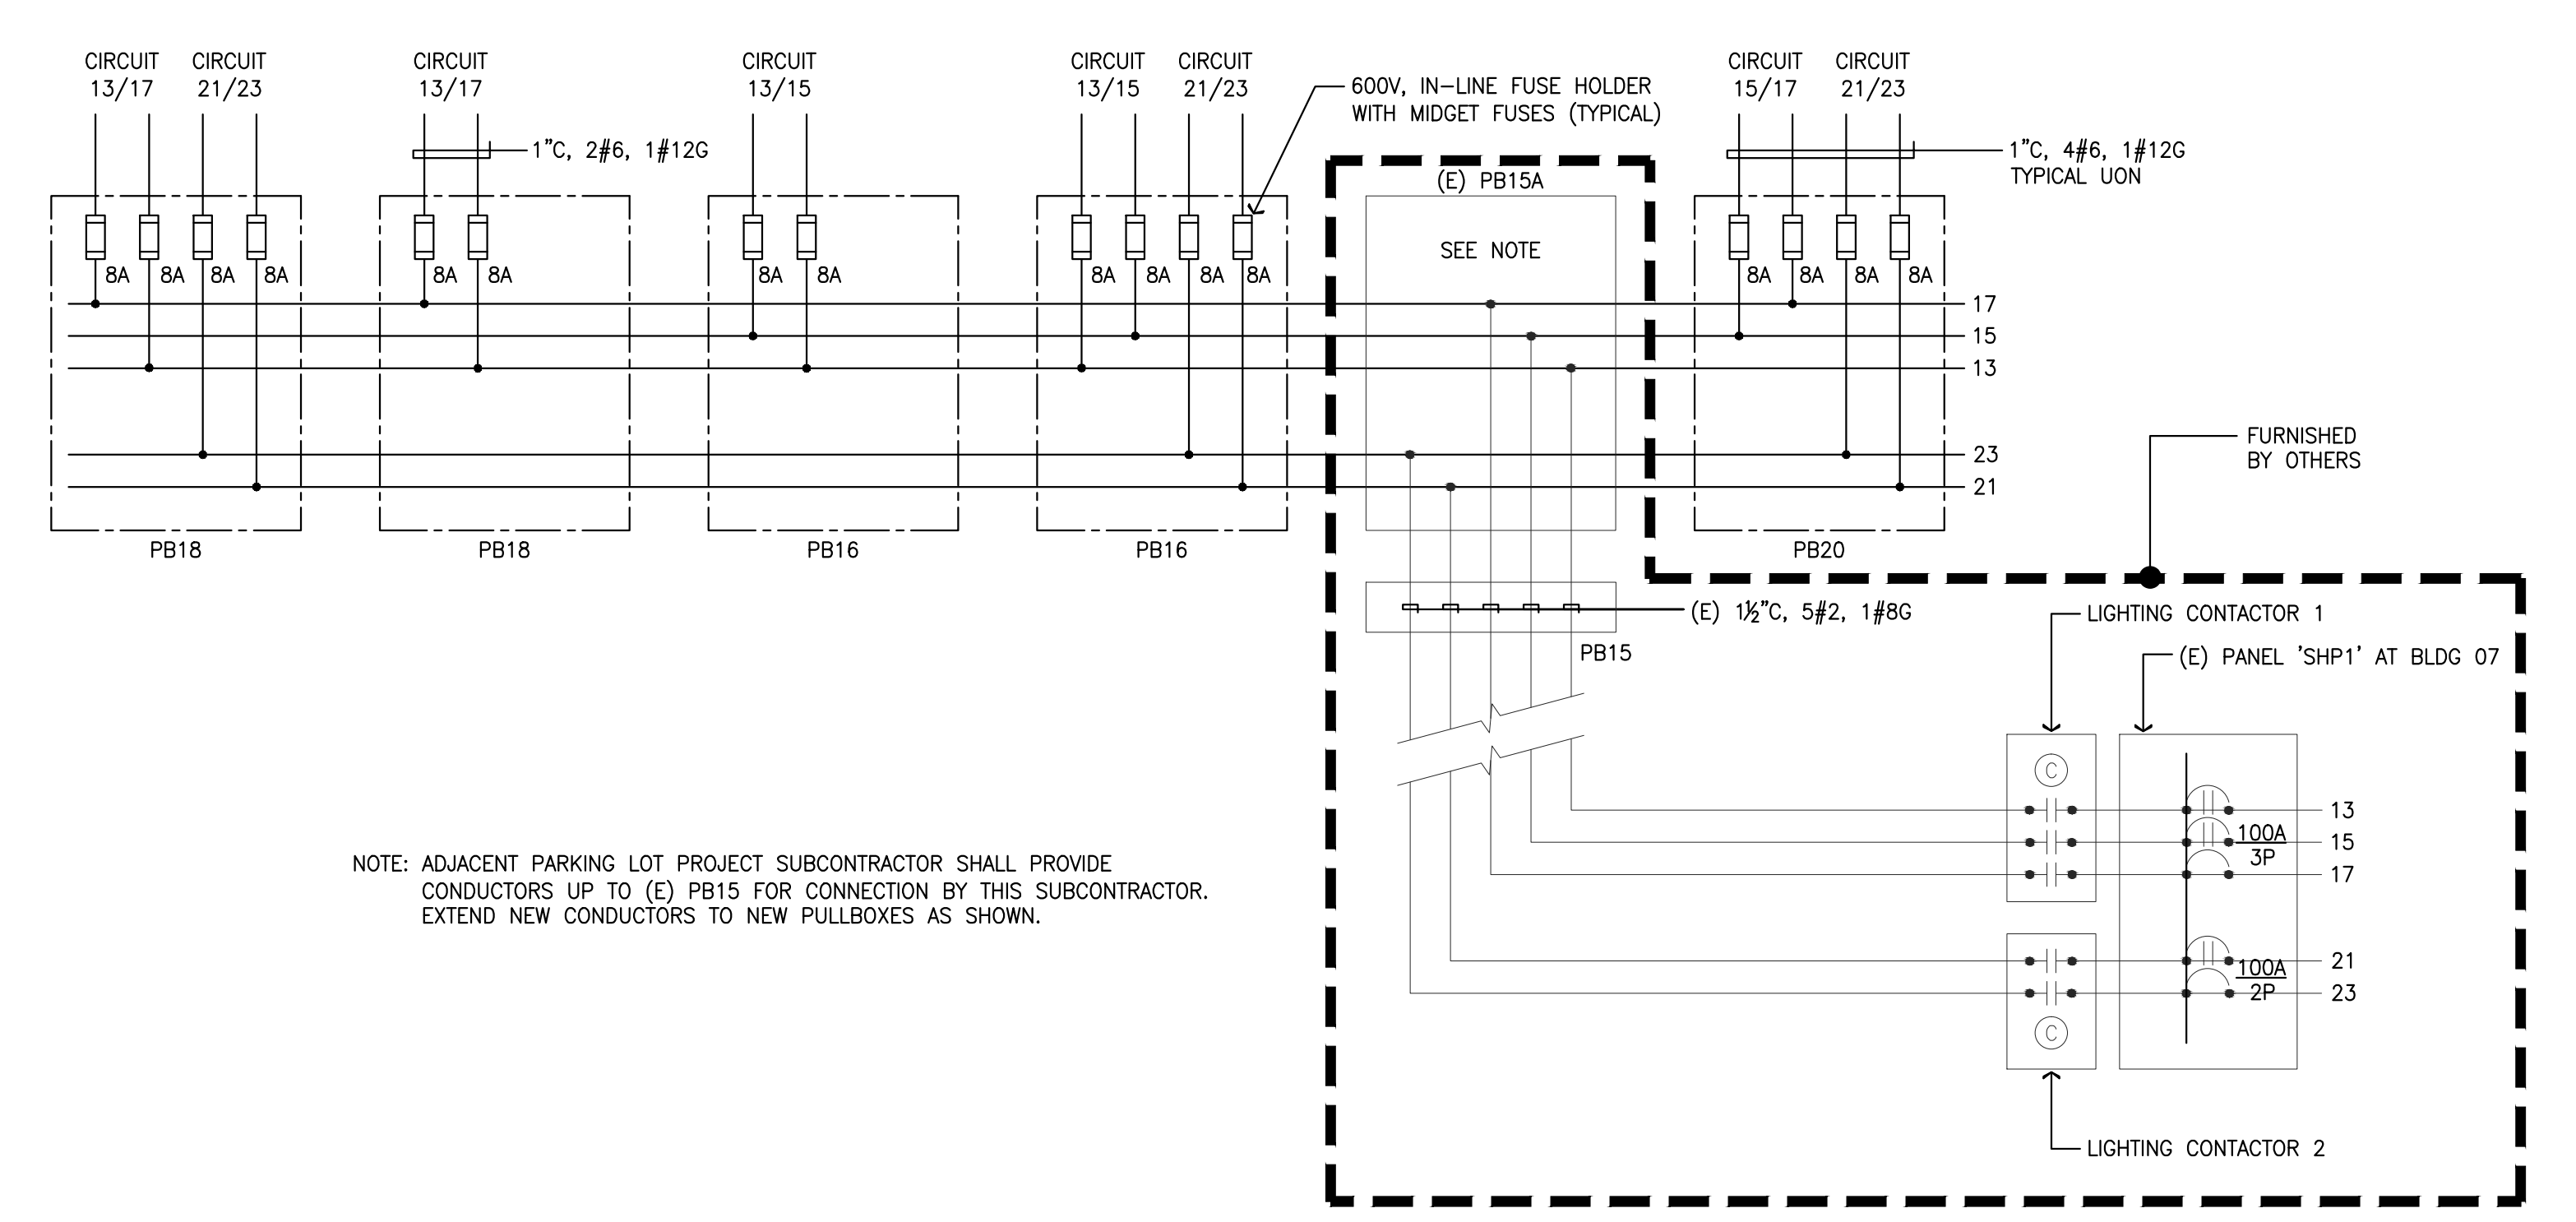

6 LIGHTING CONTROL DIAGRAM
 SCALE: NTS

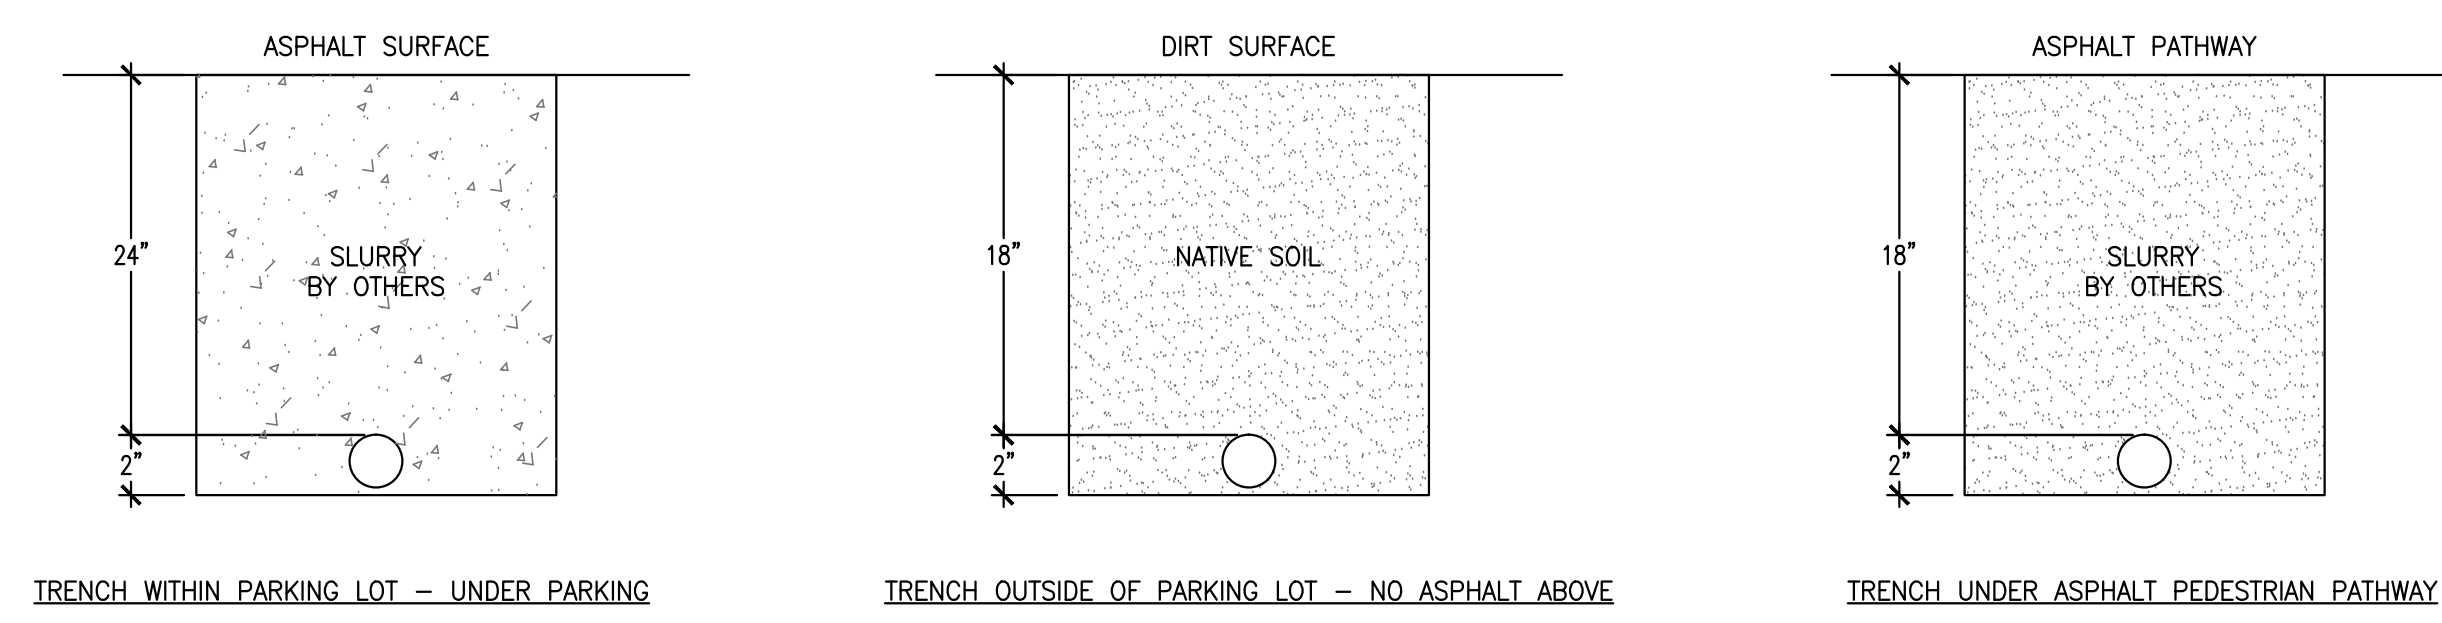

7 TRENCHING DETAILS
 SCALE: NTS

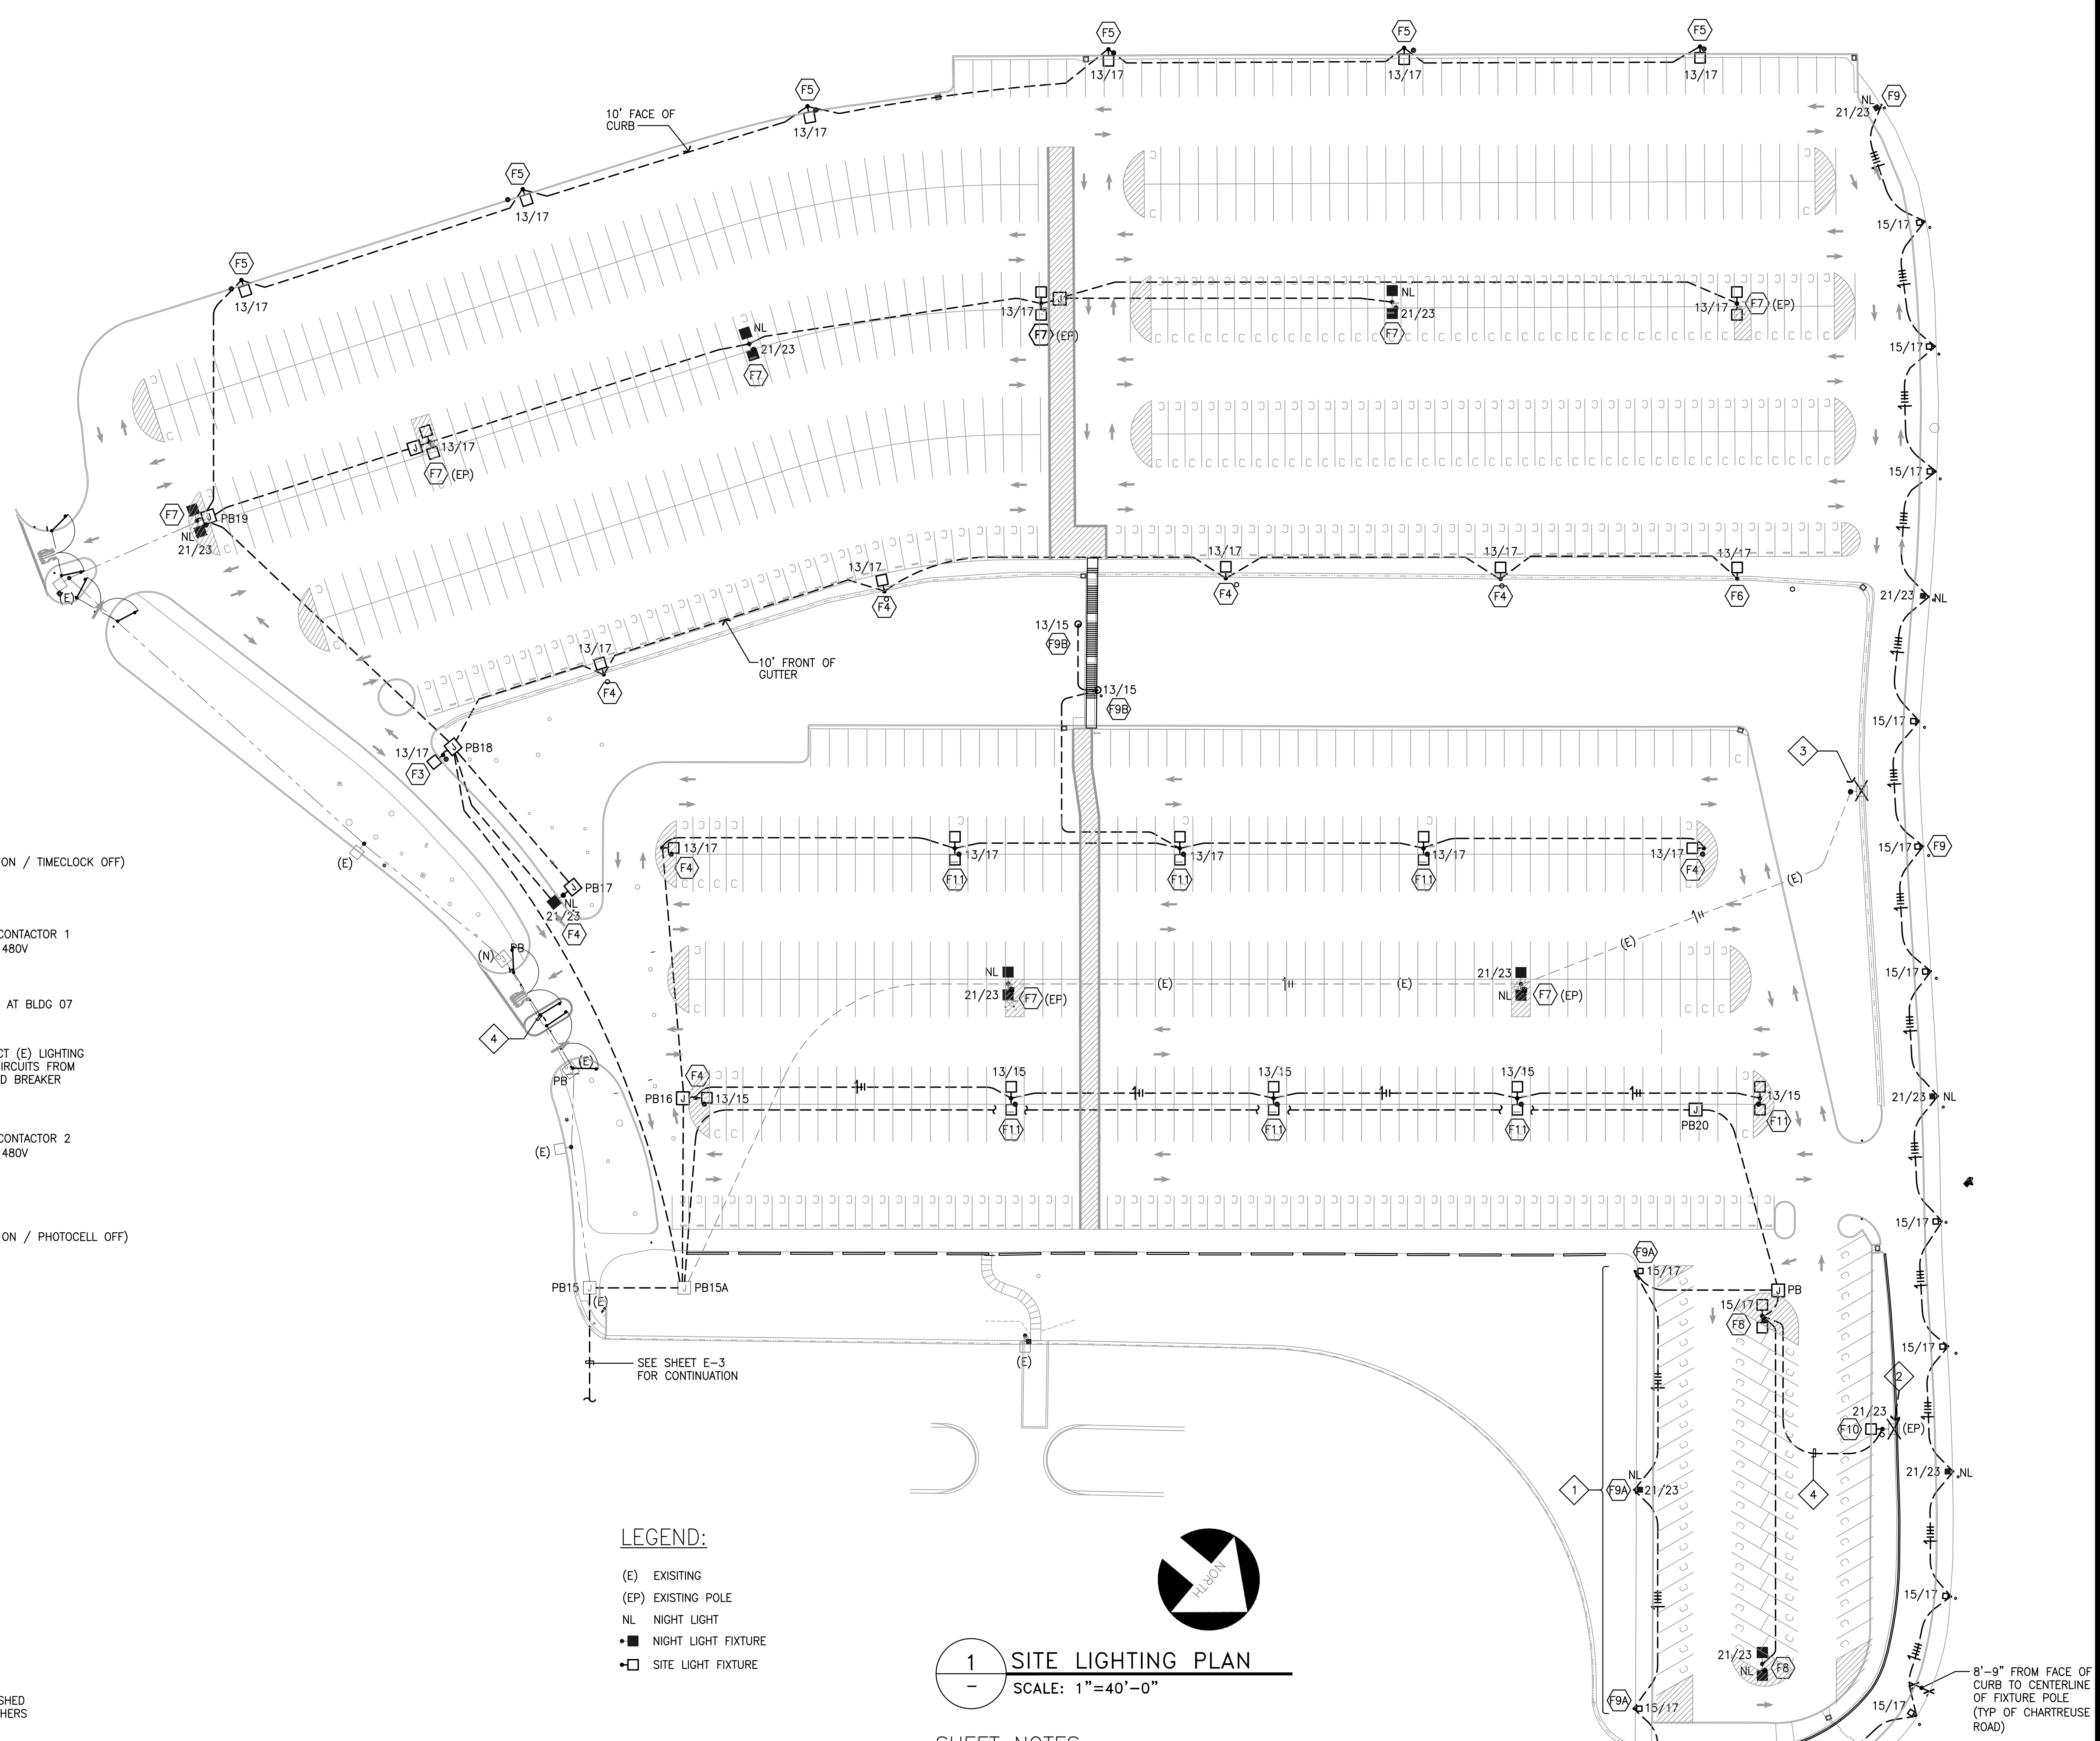

1 SITE LIGHTING PLAN
 SCALE: 1"=40'-0"

- LEGEND:**
- (E) EXISTING
 - (EP) EXISTING POLE
 - NL NIGHT LIGHT
 - NIGHT LIGHT FIXTURE
 - SITE LIGHT FIXTURE

- SHEET NOTES:**
- 1 REMOVE EXISTING TEMPORARY CONSTRUCTION LIGHTING.
 - 2 REMOVE EXISTING FIXTURE HEAD, EXISTING POLE TO REMAIN.
 - 3 REMOVE EXISTING FIXTURE HEAD AND LIGHT POLE, CONCRETE POLE BASE TO REMAIN.
 - 4 REPAIRED DAMAGED UNDERGROUND CONDUIT AND WIRING.

TYPE	SYMBOL	CATALOG #	DESCRIPTION	QTY	LAMP DESCRIPTION	WATTS	FIXTURE VOLTAGE
F3	BETA LED STR-LWY-QM-12-C-UH-XX		TYPE II LED PARKING AREA FIXTURE - 27' POLE	120	LED	234	480
F4	BETA LED STR-LWY-3M-12-C-UH-XX		TYPE III LED PARKING AREA FIXTURE - 27' POLE	120	LED	234	480
F5	BETA LED STR-LWY-3MB-12-C-UH-XX		TYPE III WITH BACKLIGHT CONTROL LED PARKING AREA FIXTURE - 27' POLE	120	LED	234	480
F6	BETA LED STR-LWY-4M-12-C-UH-XX		TYPE IV LED PARKING AREA FIXTURE - 27' POLE	120	LED	234	480
F7	BETA LED STR-LWY-5M-12-C-UH-XX		TYPE V LED PARKING AREA FIXTURE - 27' POLE	120	LED	468	480
F8	BETA LED STR-LWY-5S-12-C-UH-XX		TYPE V SHORT LED PARKING AREA FIXTURE - 27' POLE	120	LED	468	480
F9	BETA LED ARE-EDG-3MB-04-C-UH-XX		TYPE III LED PARKING AREA FIXTURE - 10' POLE	40	LED	75	480
F9A	BETA LED ARE-EDG-4M-04-C-UH-XX		TYPE IV LED PARKING AREA FIXTURE - 10' POLE	40	LED	75	480
F9B	BETA LED ARE-EDG-3M-04-C-UH-XX		TYPE III LED PARKING AREA FIXTURE - 10' POLE	40	LED	75	480
F10	BETA LED STR-LWY-4MB-12-C-UH-XX		TYPE IV LED PARKING AREA FIXTURE - 27' POLE	60	LED	119	480
F11	BETA LED STR-LWY-5S-06-C-UH-XX		TYPE V LED PARKING AREA FIXTURE - 27' POLE	90	LED	348	480

2 LIGHTING FIXTURE SCHEDULE
 SCALE: NTS



CUPERTINO ELECTRIC

1740 CESAR CHAVEZ ST.
SAN FRANCISCO, CA
(415)970-3400
C-10 LIC. NO. 174637

Rev.	Date	Description	Designed	Drawn	Checked
1	12.28.10	PROGRESS			
2	12.22.10	REVISION #1			
3	12.22.10	REVISION #2			
4	12.22.10	REVISION #3			
101	12.22.10	REVISION #100			

COLLEGE OF SAN MATEO HILLSDALE PARKING LOT RENOVATIONS
SAN MATEO COMMUNITY COLLEGE DISTRICT

RECORD DOCUMENT
Date: 09.16.11

City Of
San Mateo
County Of
San Mateo
State Of
California

Prepared Under the Direction of:

ELECTRICAL
SITE PLAN

Sheet
E-3

Scale: AS NOTED
Date: 1-28-11
File:
Plan File:

