


1 LEVEL 1 - ENLARGED FLOOR PLAN - SECTOR B
1/8" = 1'-0"

LEGEND

- CONCRETE WALL; S.S.D.
- METAL STUD WALL FOR INTERIOR PARTITION SCHEDULE, SEE A-902
- RATED PARTITION FOR INTERIOR PARTITION SCHEDULE, SEE A-902

GENERAL NOTES

1. SEE INTERIOR ELEVATIONS FOR EXTENT OF SPECIAL WALL FINISHES.
2. SEE INTERIOR ELEVATIONS FOR ACCESSORIES AND EQUIPMENT LOCATIONS.
3. ALL ITEMS NEW UNLESS OTHERWISE NOTED.
4. ALL DIMENSIONS ARE TO FACE OF FINISH U.O.N.
5. SEE SHEET A-900 FOR ACCESSIBILITY STANDARDS.
6. LOCATE DOOR OPENING FROM ADJACENT PERPENDICULAR WALLS, AS SHOWN, U.O.N. 15" MIN. INT. 24" MIN. EXT.
7. S.S.D. FOR EDGE OF SLAB LOCATION AND DIMENSIONS
8. FURNITURE SHOWN FOR REFERENCE ONLY
9. DIMENSIONS OF TIERS IN LARGE CLASSROOM 4-70 IS SIMILAR TO LARGE CLASSROOM 4-180.
10. FURNITURE LAYOUT IN LARGE CLASSROOMS 4-180 AND 4-148 IS SIMILAR TO LARGE CLASSROOM 4-170.
11. SEE A SERIES FOR ACOUSTICAL WALL PANEL, WALL PROTECTION, AND CORNER GUARD LOCATIONS AND TYPES.

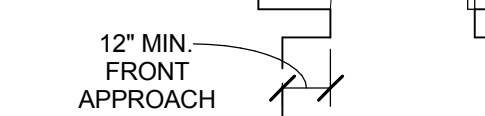


PROJECT RECORD SET

**BUILDING 4
SKYLINE COLLEGE**

SAN MATEO COUNTY
COMMUNITY COLLEGE
DISTRICT

**CIP2 DESIGN-BUILD
PROJECT
BUILDING 4**

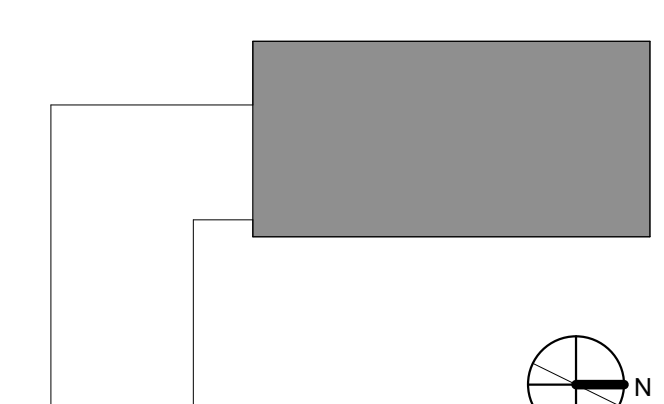

PROJECT NO.: 07012.00 DRAWN BY: LT
DATE: 05/01/08 CHECKED BY: LG
SCALE: As indicated

**SHEET TITLE:
LEVEL 1-
ENLARGED
FLOOR PLAN-
SECTOR B**

SHEET NO. **A-101B**