


1 EXTERIOR SOUTH ELEVATION
3/32" = 1'-0"

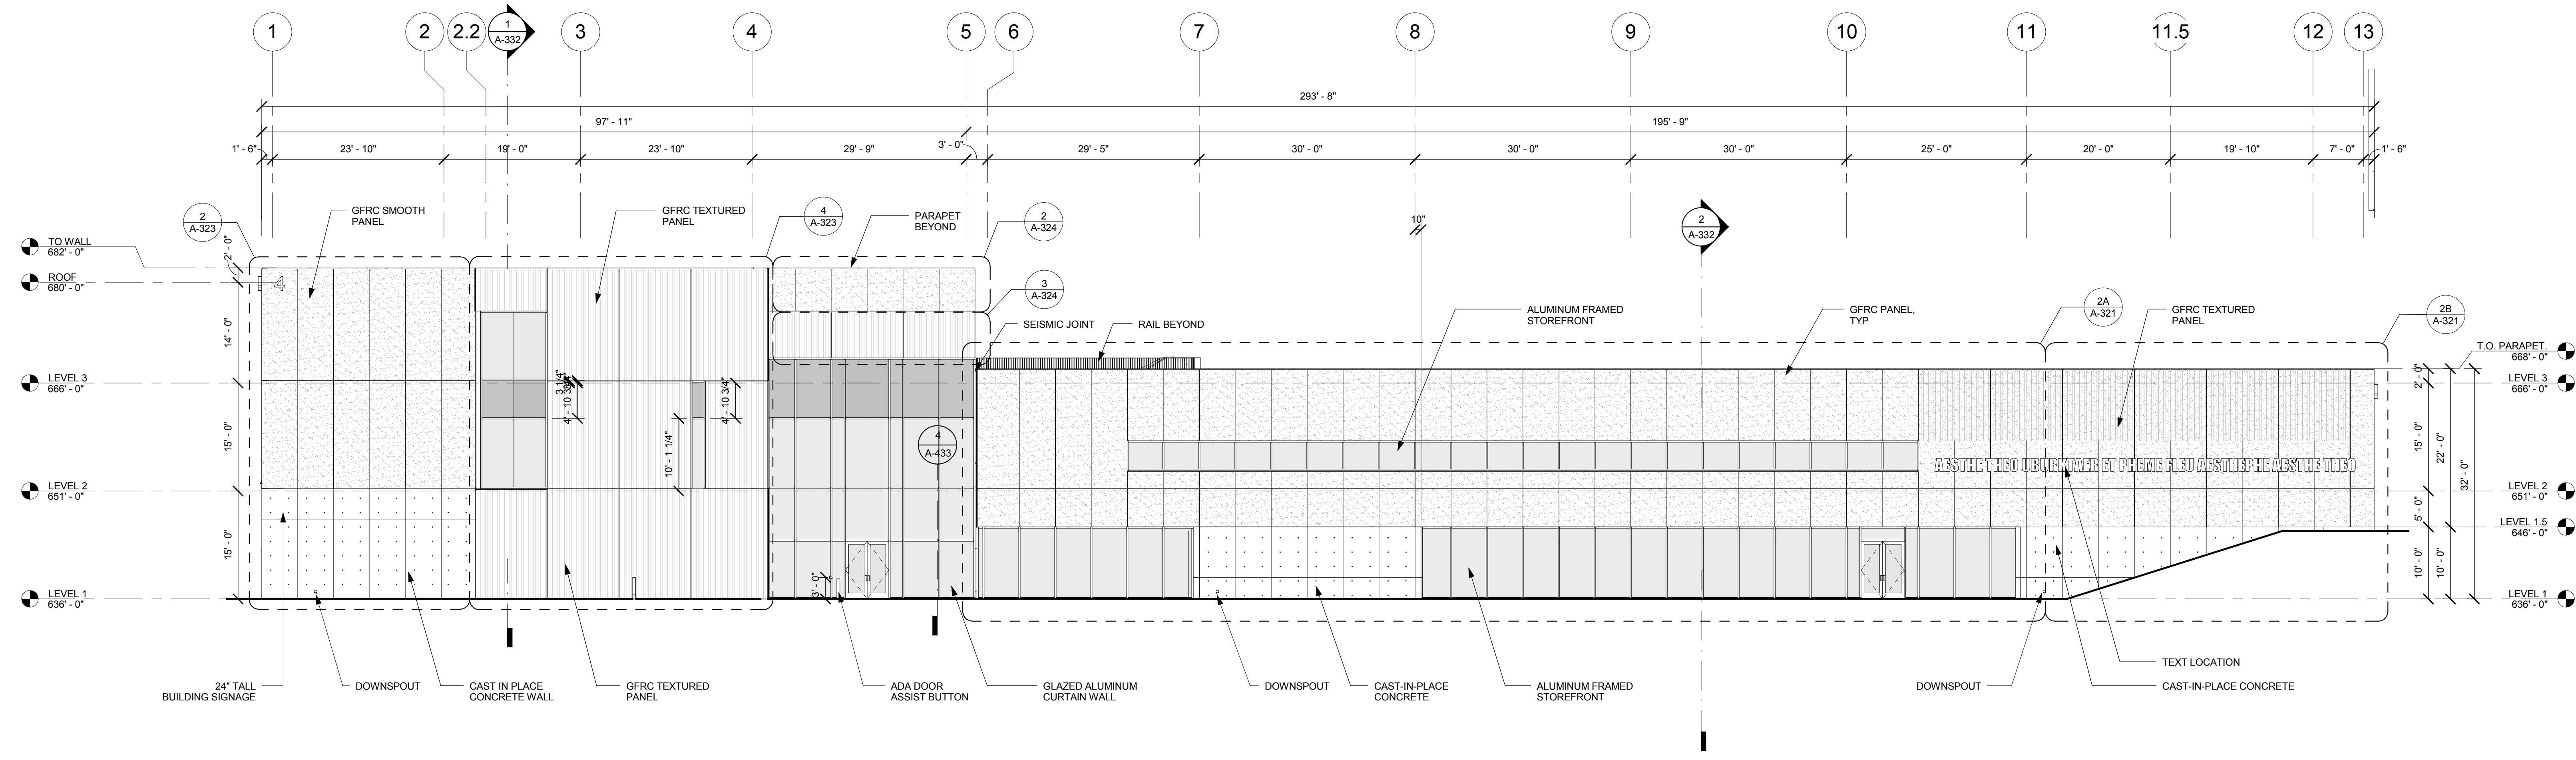

2 EXTERIOR EAST ELEVATION
3/32" = 1'-0"


NO.	ISSUES/REVISIONS	DATE

PROJECT
RECORD SET

BUILDING 4
SKYLINE COLLEGE

SAN MATEO COUNTY
COMMUNITY COLLEGE
DISTRICT

CIP2 DESIGN-BUILD
PROJECT
BUILDING 4

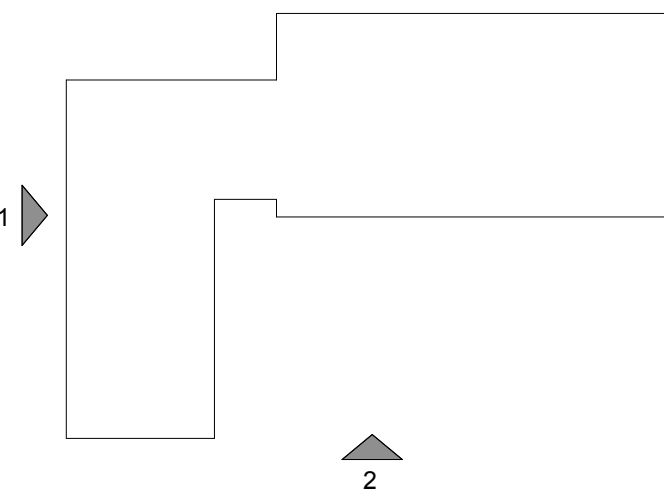

PROJECT NO.: 07012.00	DRAWN BY: MC
DATE: 04/28/08	CHECKED BY: LG
SCALE: As indicated	

SHEET TITLE:
EXTERIOR
BUILDING
ELEVATIONS

GENERAL NOTES:

- SEE A-320 SERIES FOR ENLARGED ELEVATIONS
- SEE A-740 SERIES FOR WINDOW DETAILS