

PROJECT
RECORD SET


BUILDING 4
SKYLINE COLLEGE

SAN MATEO COUNTY
COMMUNITY COLLEGE
DISTRICT

CIP2 DESIGN-BUILD
PROJECT
BUILDING 4

PROJECT NO: 07012.00 DRAWN BY: Author
DATE: 05/03/10 CHECKED BY: Checker
SCALE: 1/2" = 1'-0"

SHEET TITLE:
STAIR
ELEVATIONS

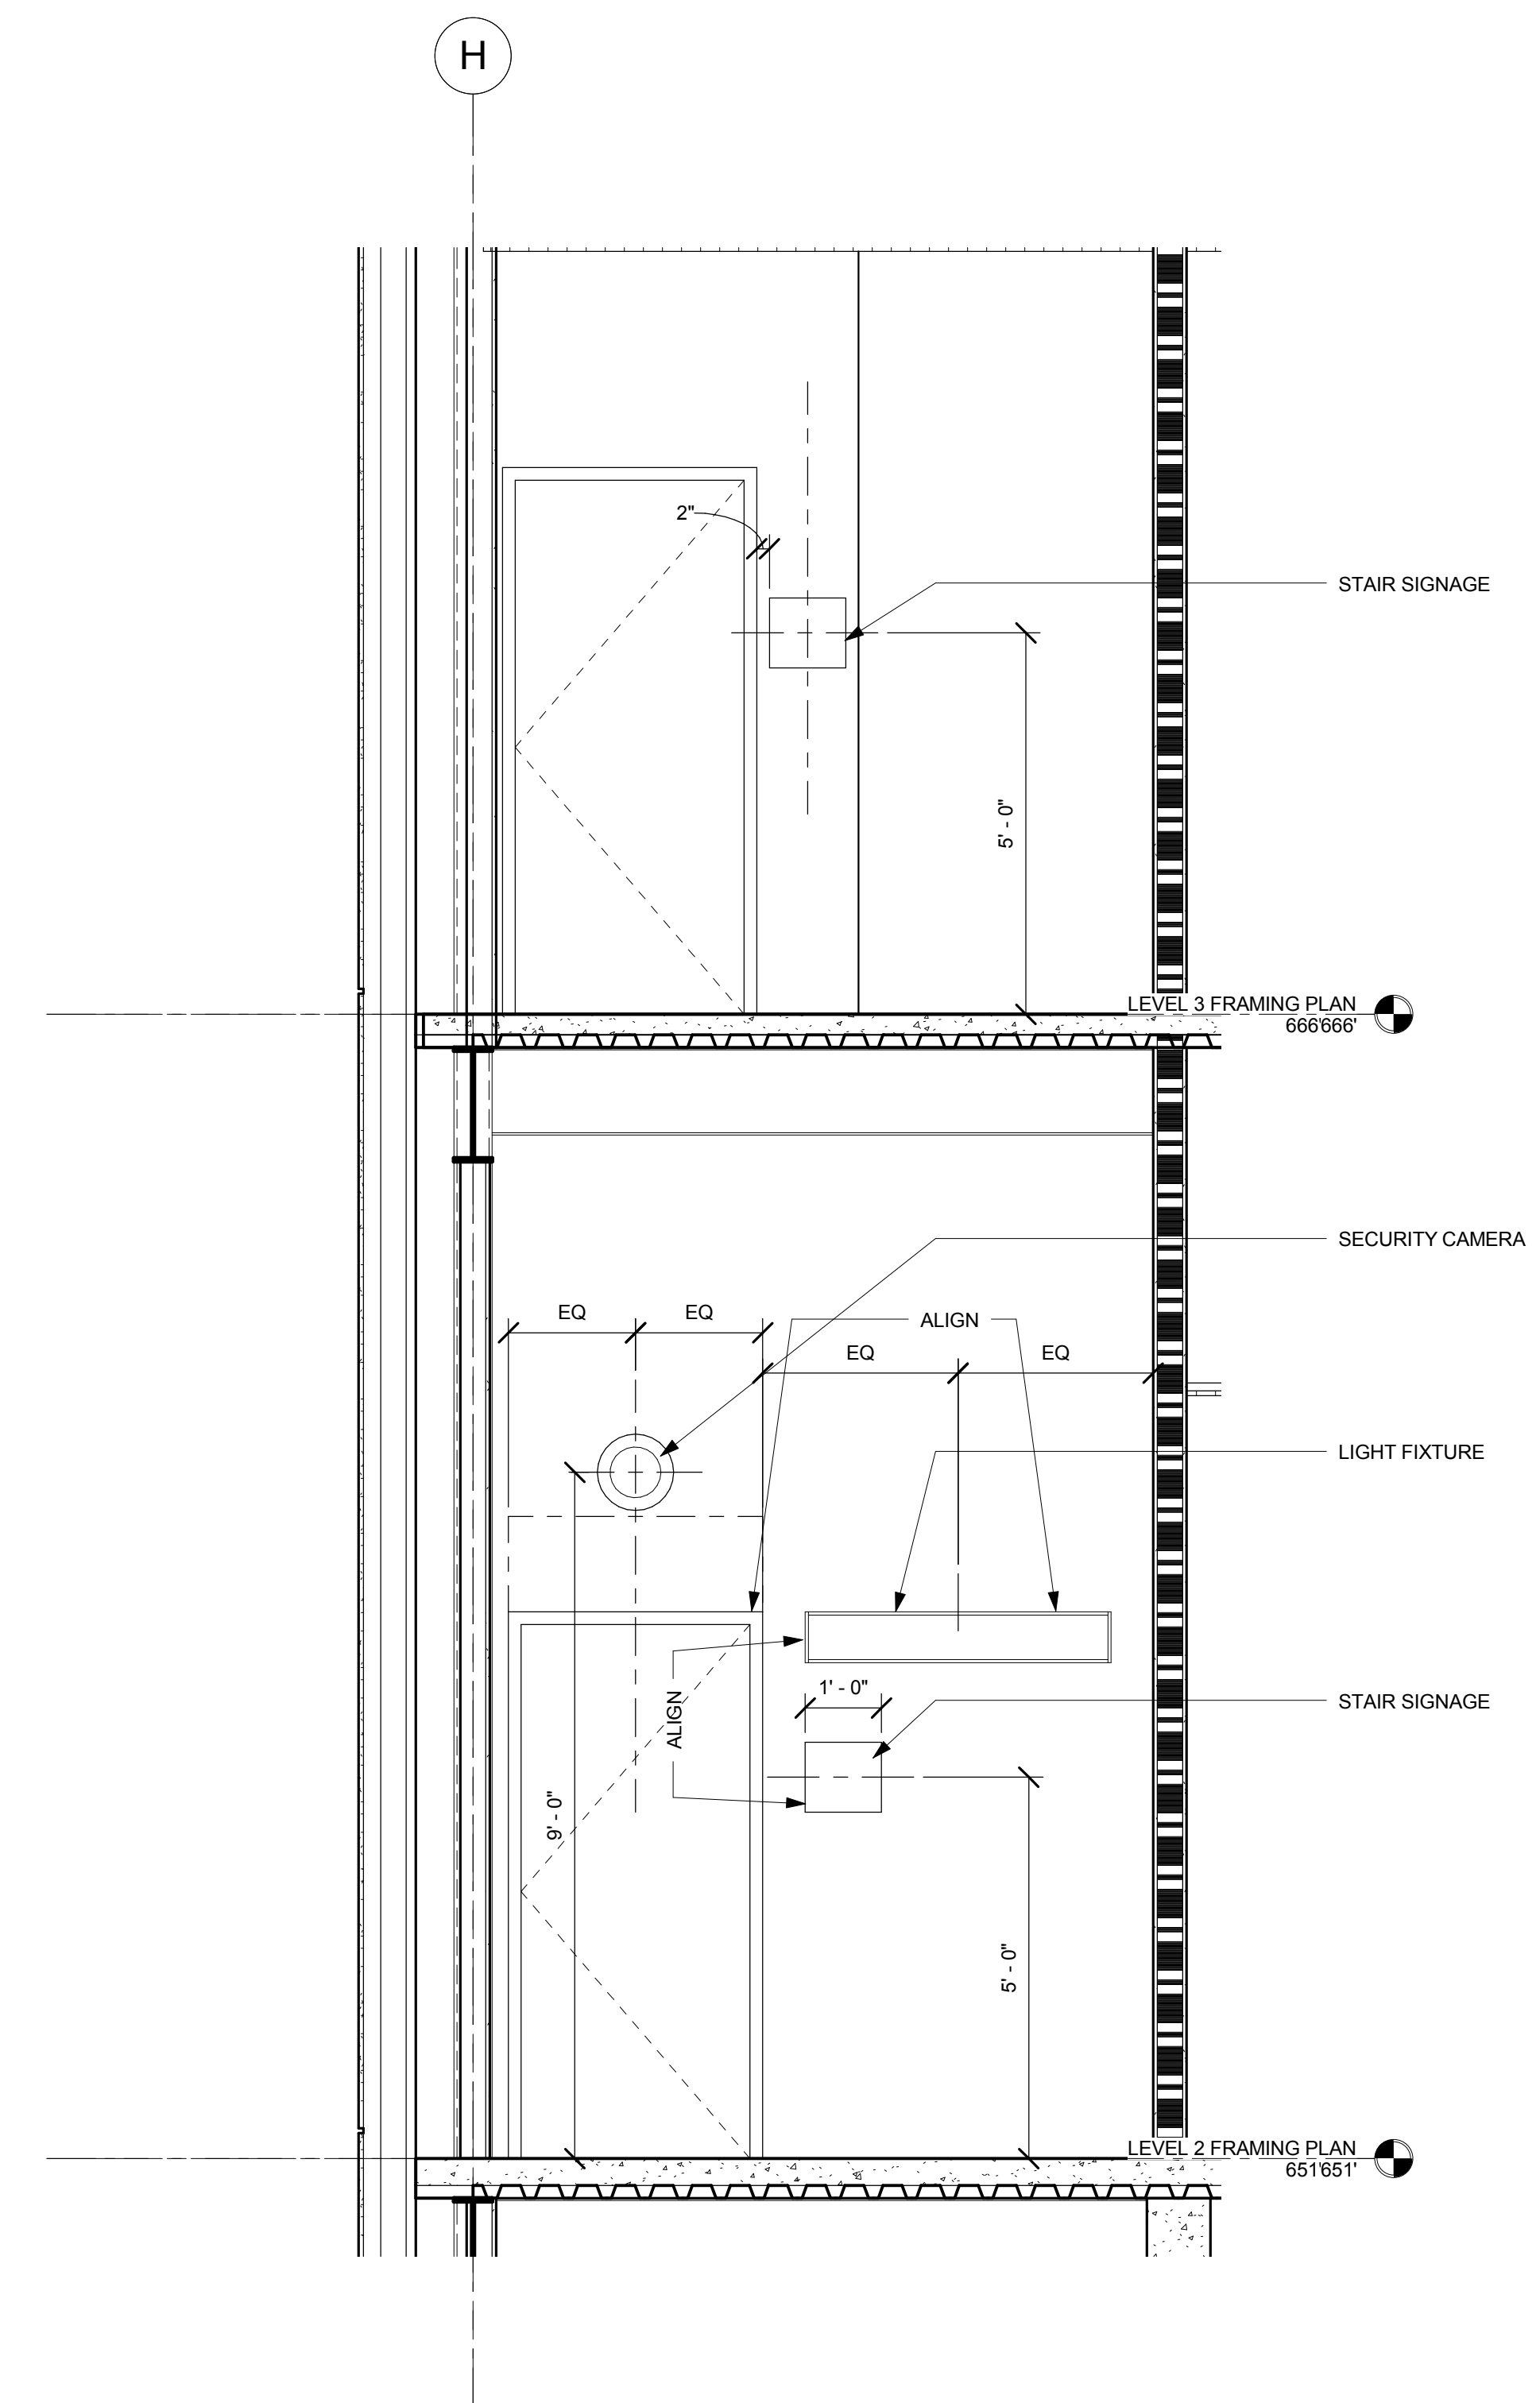

1 ST06 ELEVATIONS
1/2" = 1'-0"