


PROJECT
RECORD SET

BUILDING 4
SKYLINE COLLEGE

SAN MATEO COUNTY
COMMUNITY COLLEGE
DISTRICT

CIP2 DESIGN-BUILD
PROJECT
BUILDING 4

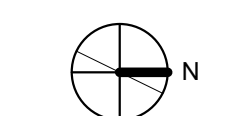

ROOF	

PROJECT NO: 07012.00 DRAWN BY: DG

DATE: 04.16.2009 CHECKED BY: EK


SCALE: As indicated

SHEET TITLE:

OVERALL ROOF
PLAN

SHEET NO:

AC-104

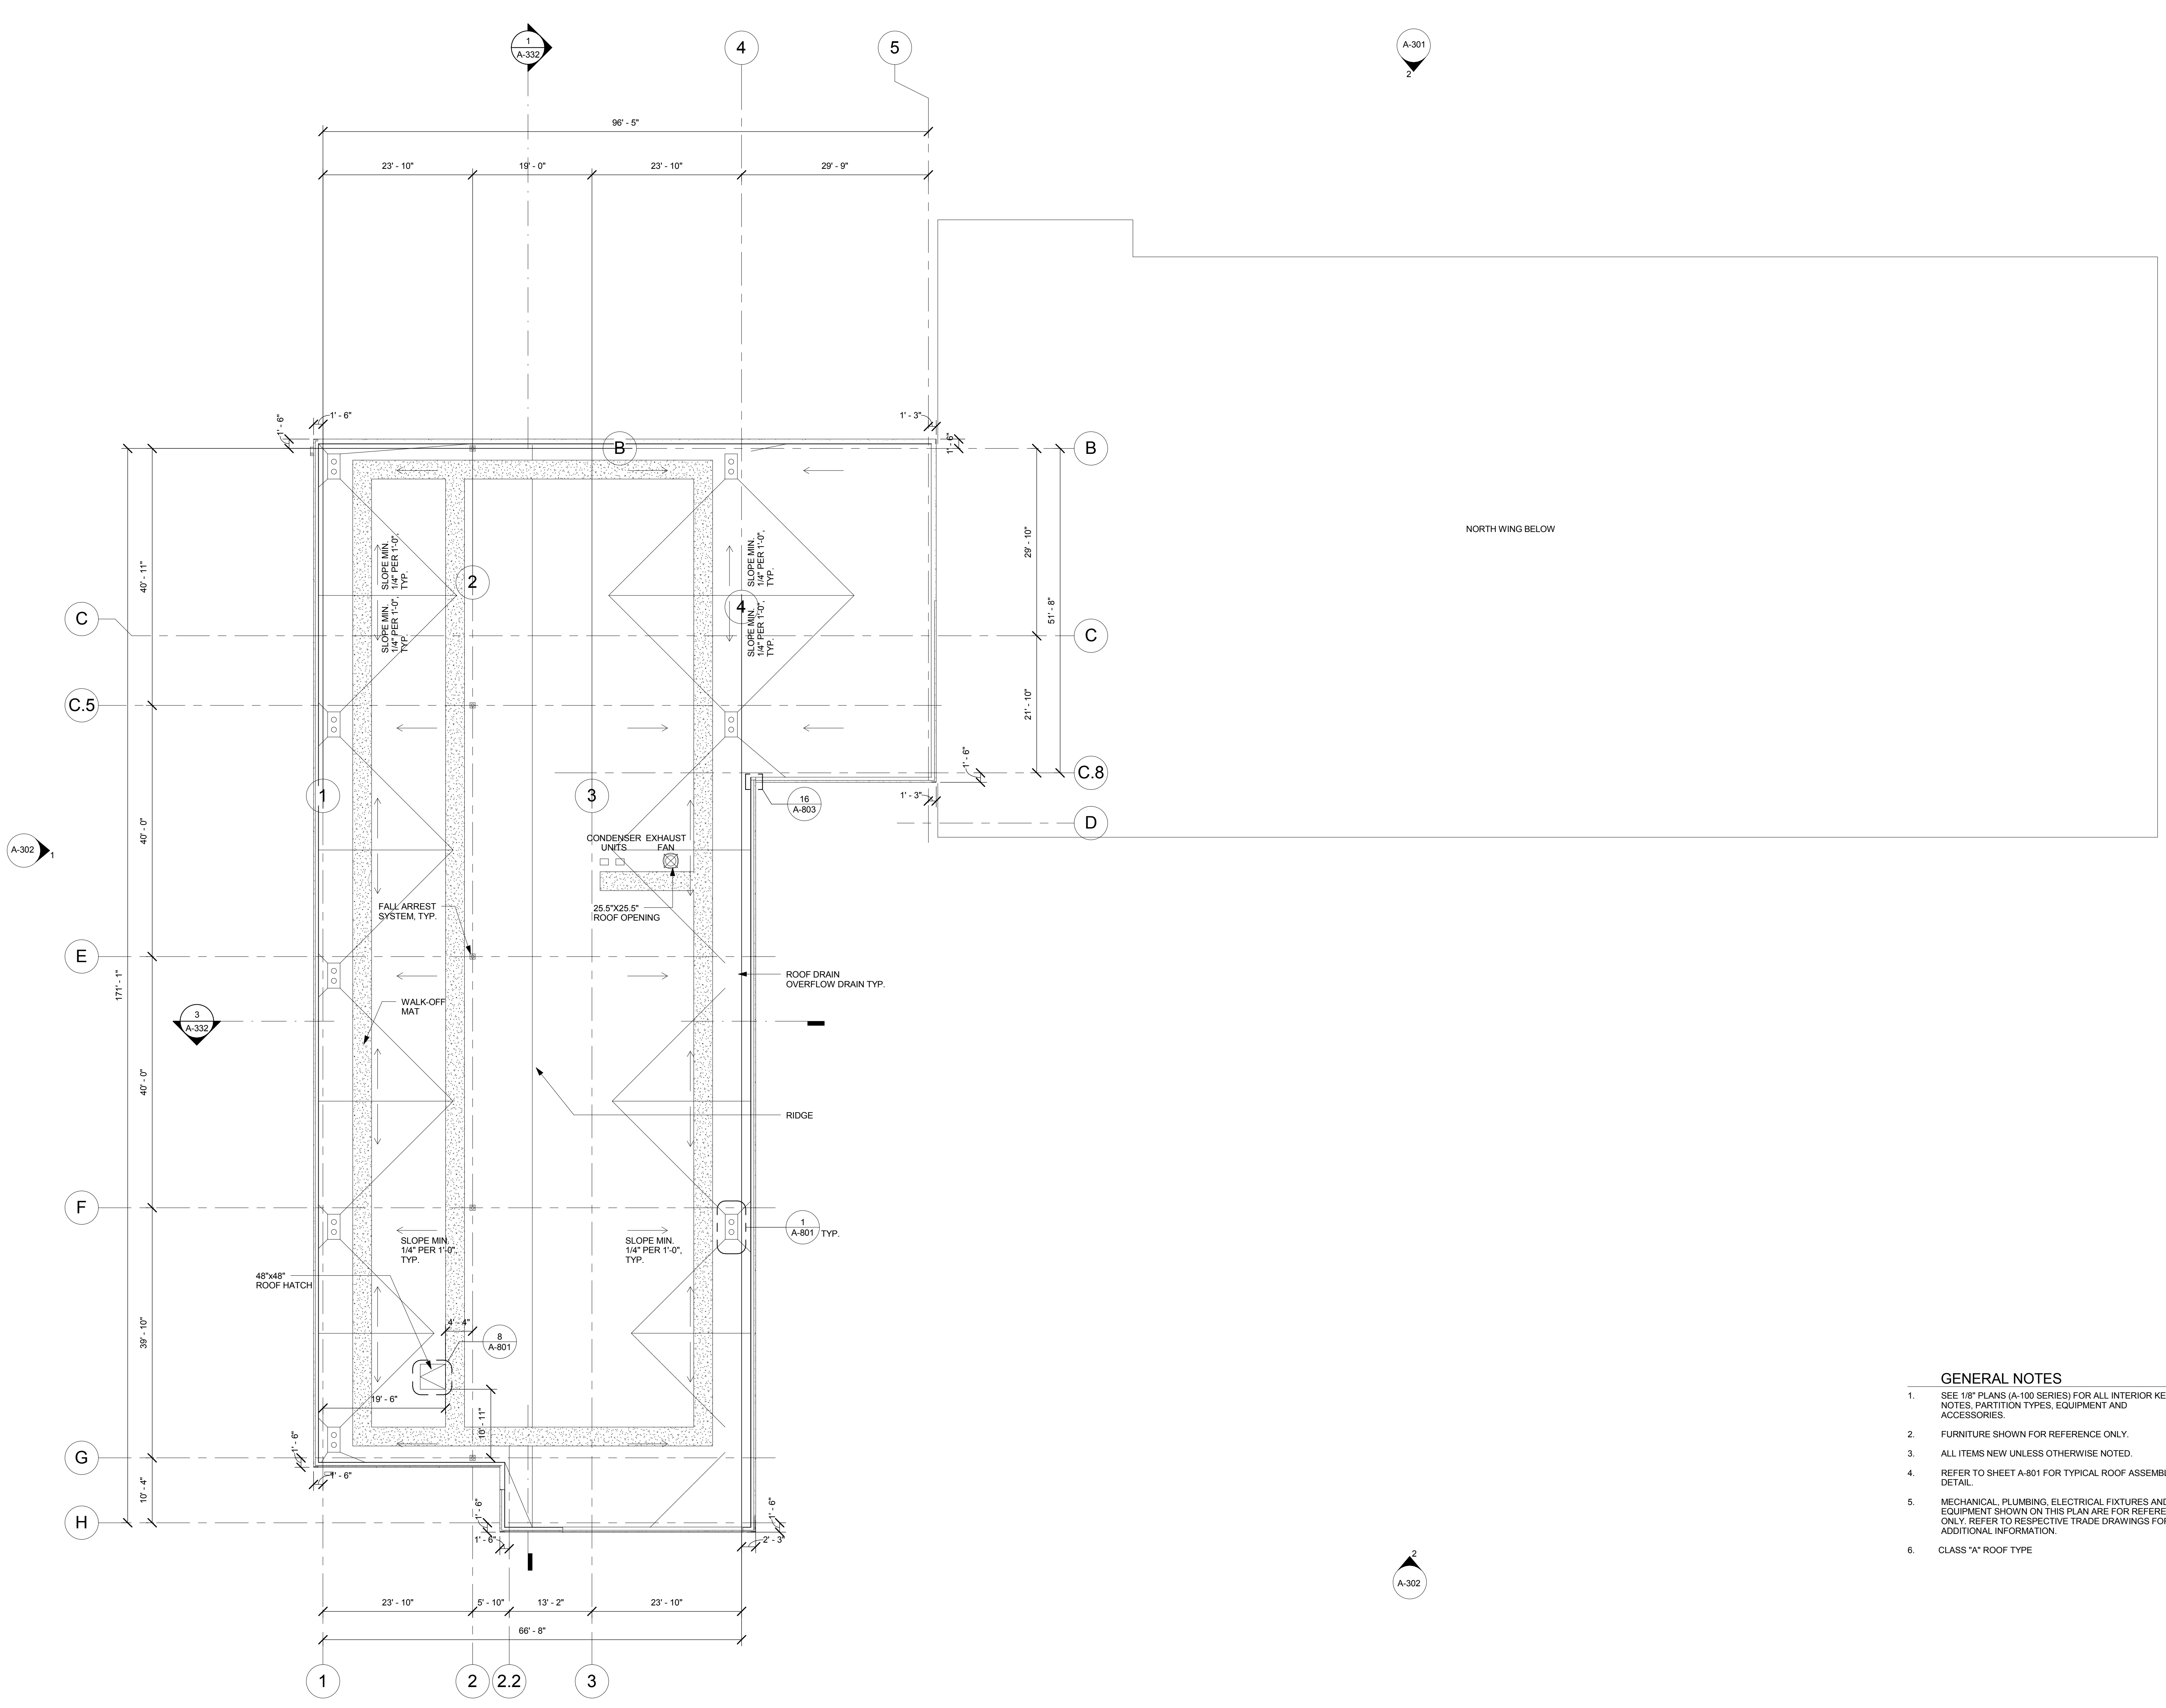

- GENERAL NOTES**
- SEE 1/8" PLANS (A-100 SERIES) FOR ALL INTERIOR KEY NOTES, PARTITION TYPES, EQUIPMENT AND ACCESSORIES.
 - FURNITURE SHOWN FOR REFERENCE ONLY.
 - ALL ITEMS NEW UNLESS OTHERWISE NOTED.
 - REFER TO SHEET A-801 FOR TYPICAL ROOF ASSEMBLY DETAIL.
 - MECHANICAL, PLUMBING, ELECTRICAL FIXTURES AND EQUIPMENT SHOWN ON THIS PLAN ARE FOR REFERENCE ONLY. REFER TO RESPECTIVE TRADE DRAWINGS FOR ADDITIONAL INFORMATION.
 - CLASS "A" ROOF TYPE

1 ROOF PLAN
3/32" = 1'-0"