


2 LEVEL 2 - EXITING PLAN
 1" = 20'-0"

3 LEVEL 3 - CODE/ LIFE SAFETY EXITING PLAN
 1" = 20'-0"

NOTE: DIMENSIONS ARE PROVIDED IN SHEET A-100 SERIES FOR THE PATH OF TRAVEL

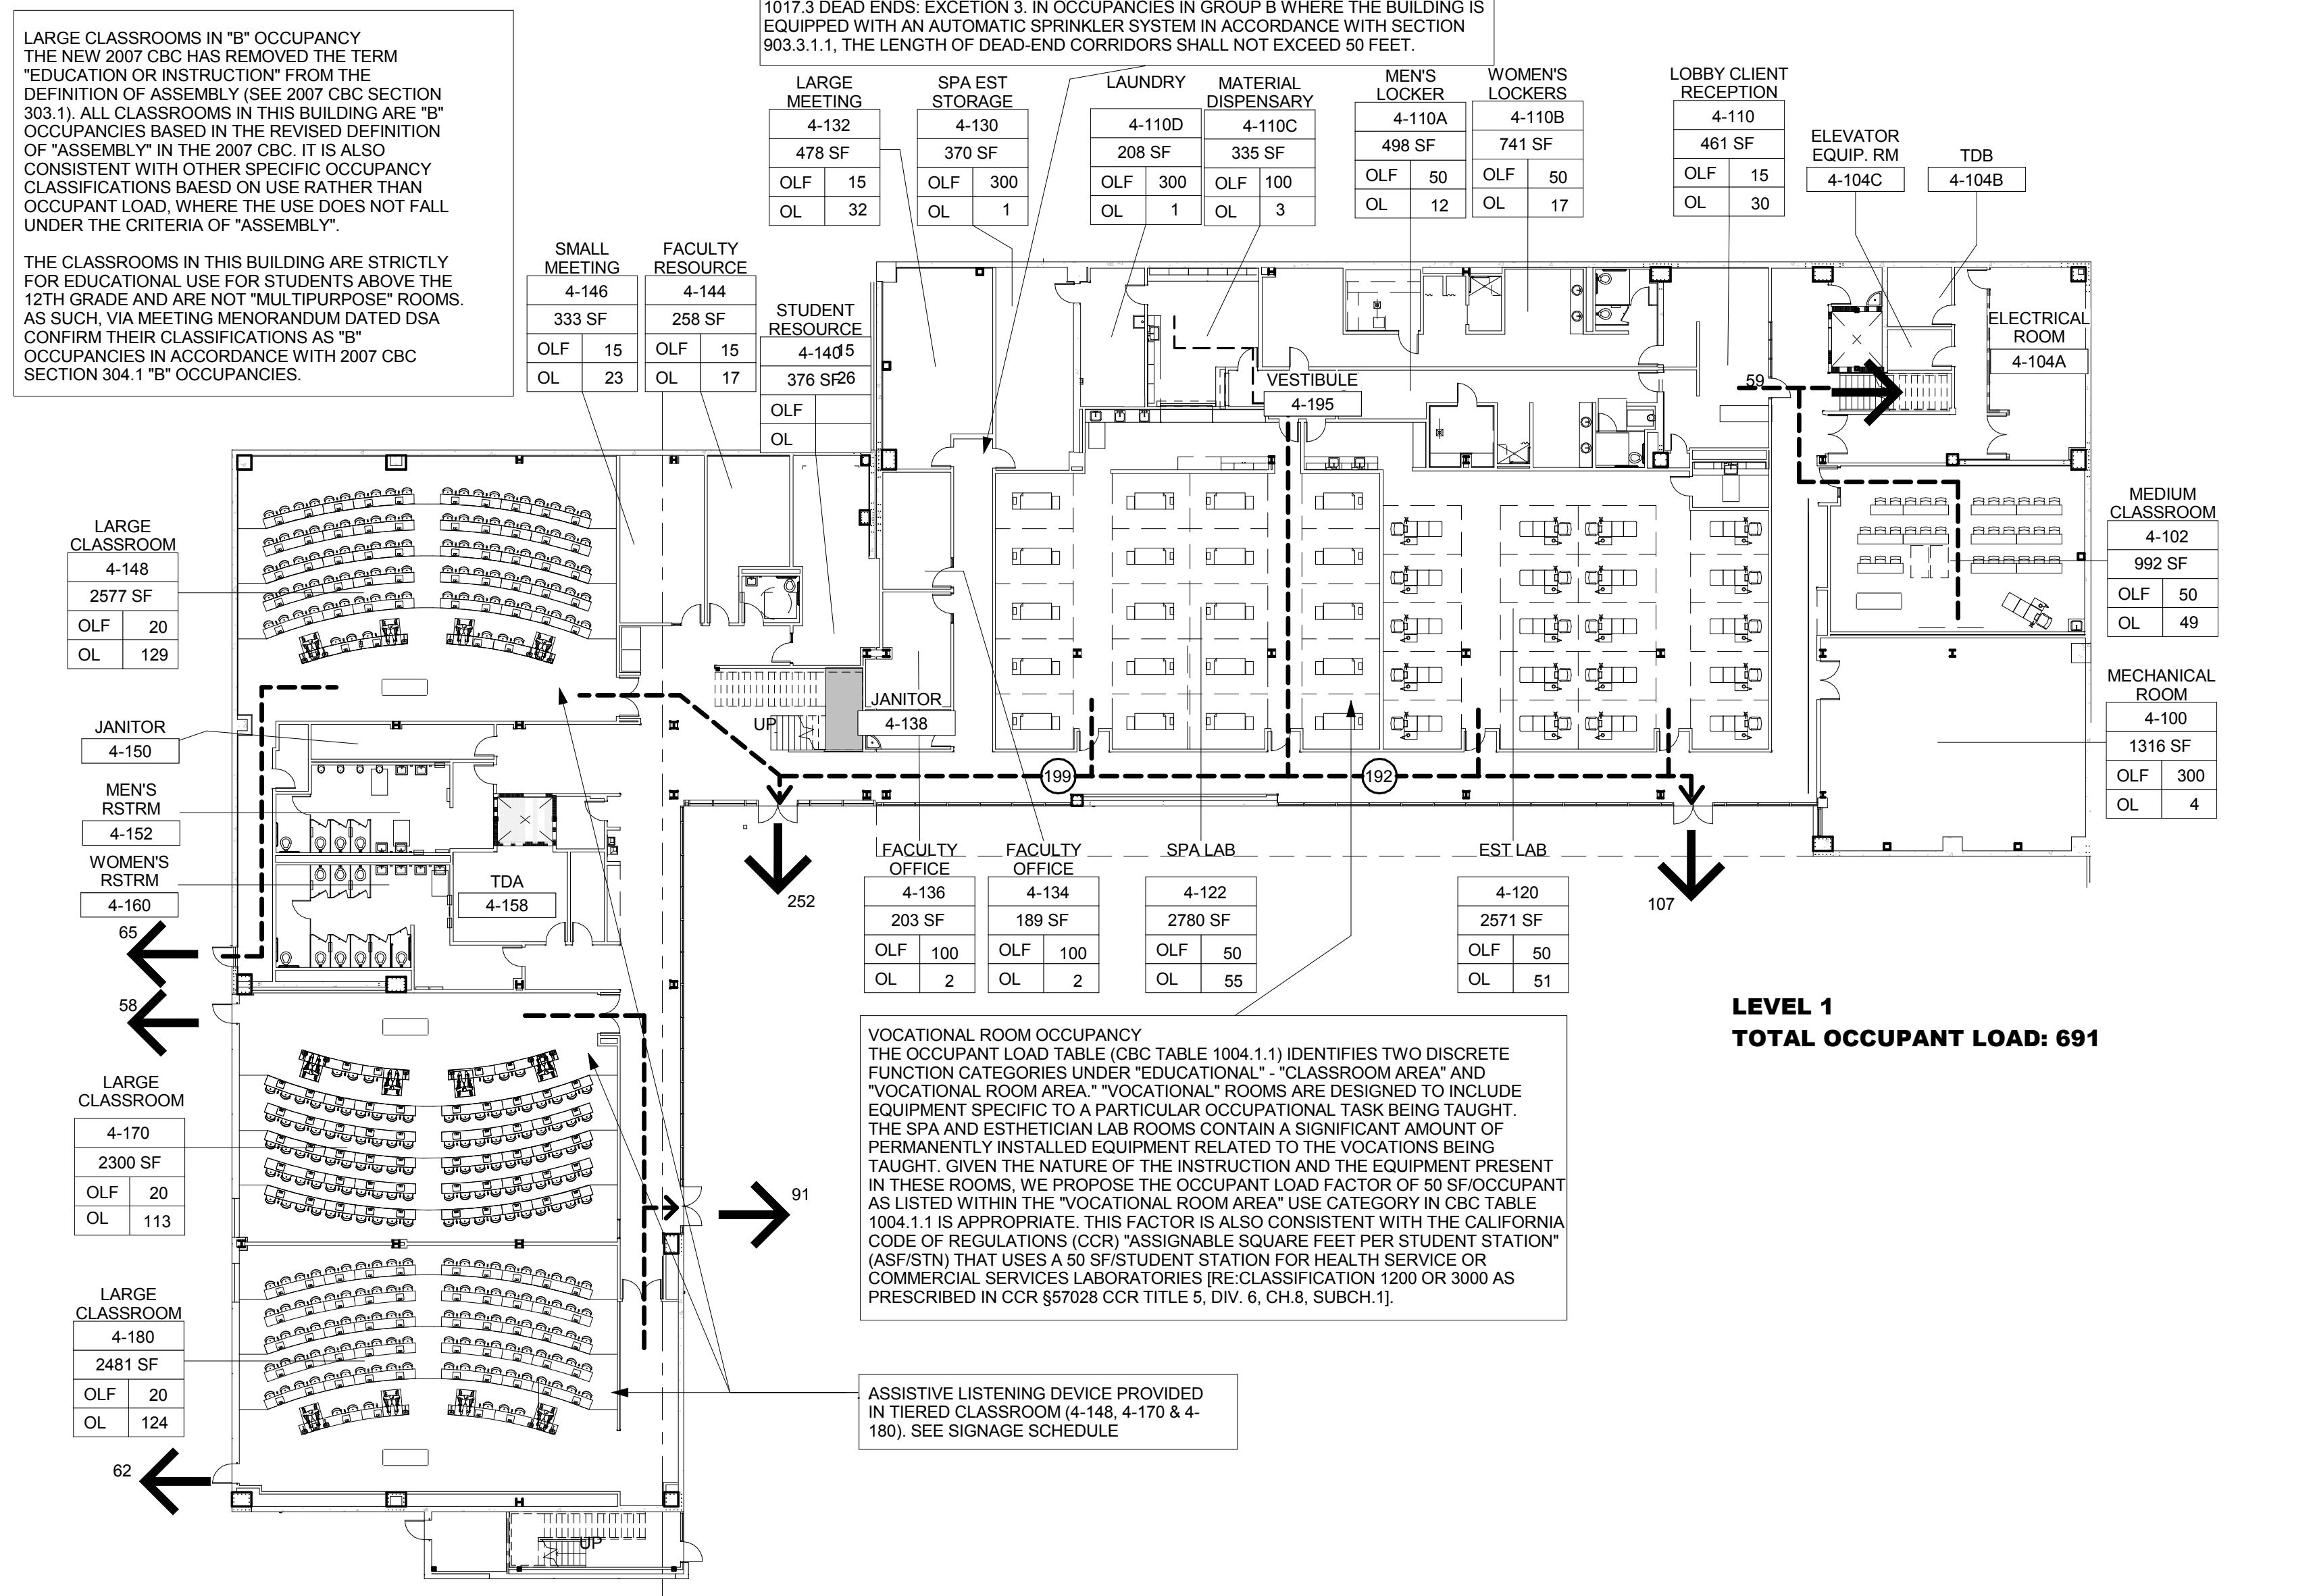

1 LEVEL 1 - EXITING PLAN
 1" = 20'-0"

CODE REVIEW SUMMARY

* SITE ACCESS AND CIRCULATION THE CAMPUS SITE IMPROVEMENTS PROJECT (APPLICATION # 01-11316) PROVIDES THE ACCESSIBLE PATH OF TRAVEL FROM BUILDING 4. THESE DOCUMENTS WERE SUBMITTED TO DSA ON DECEMBER 23, 2008

SECTION	DESCRIPTION	STATUS
A. BUILDING AND OCCUPANCY CLASSIFICATION	SKYLINE COMMUNITY COLLEGE BLDG 4N FUNCTIONS AS A VOCATIONAL SCHOOL OF COMMUNITY COLLEGE CLASSROOMS, AND CAMPUS ADMINISTRATION. THEREFORE COMPROMISED OF A MIXED USE OCCUPANCY OF B OCCUPANCIES WITH ACCESSORY ASSEMBLY AREA, THE HAIR, SPA, AND ESTHETICIAN LABS DO NOT CONTAIN QUANTITIES OF HAZARDOUS MATERIALS WHICH WOULD CLASSIFY IT AS H OCCUPANCY.	OKAY
C. LOCATION ON PROPERTY	SEE AS-101 SITE PLAN FOR LOCATION OF THE BUILDING AND CLEARANCES TO ALL PROPERTY LINES AND OTHER BUILDINGS.	OKAY
D. ALLOWABLE BUILDING HEIGHTS AND AREAS	SEE CBC TABLE 503 FOR BASIC ALLOWABLE BUILDING HEIGHTS AND BASIC ALLOWABLE FLOOR AREA FOR B OCCUPANCY AND TYPE II-B CONSTRUCTION.	OKAY
F. MEANS OF EGRESS	SEE CBC TABLE 1011.1 MINIMUM REQUIRED EGRESS WIDTH.	OKAY
G. FIRE RESISTANCE-RATED CONSTRUCTION	SEE CBC TABLE 601 FOR FIRE RESISTANCE RATING FOR BUILDING ELEMENTS.	OKAY
H. TYPE OF CONSTRUCTION	803.1 TYPE II: THE STRUCTURAL ELEMENTS OF SKYLINE COLLEGE BLDG 4 SHALL BE OF NON-COMBUSTIBLE MATERIALS. THE RETAINING WALLS SHALL BE CONCRETE. STRUCTURAL FRAME SHALL BE STEEL AND THE FLOOR CONSTRUCTION SHALL BE CONCRETE SLAB OVER METAL DECK.	OKAY

LEGEND

OFFICE	USE/OCCUPANT TYPE	NUMBER OF OCCUPANTS EXITING UPPER OR LOWER LEVEL EXITING
4-100	ROOM NUMBER	40 U
200 SF	SQUARE FOOTAGE	15 OCP
OLF 100	OCCUPANT LOAD FACTOR	NUMBER OF OCCUPANTS IN AREA OR SUITE
OL 2	OCCUPANT LOAD (SF/OLF)	

PROJECT RECORD SET

BUILDING 4 SKYLINE COLLEGE

CIP2 DESIGN-BUILD PROJECT BUILDING 4

CODE/LIFE SAFETY EXITING PLANS

PROJECT NO: 070120 DRAWN BY: BC
 DATE: 05.15.2009 CHECKED BY: LG
 SCALE: As indicated
 SHEET TITLE:
 SHEET NO:
 G-110

All drawings and written material appearing herein constitute original and unpublished work of the Architect/Engineer and may not be duplicated, used or disclosed without consent of Architect/Engineer. If this drawing is not 30"x42", then the drawing has been revised from its original size. Noted scales must be adjusted. This line should be equal to one inch.