



REFERENCE

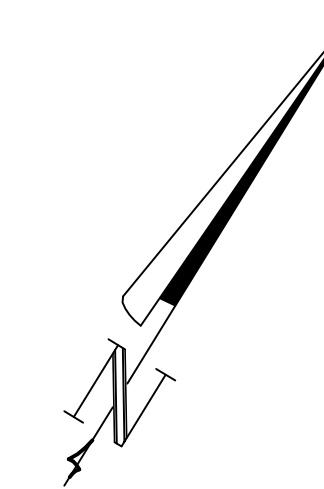

GRAPHIC SCALE

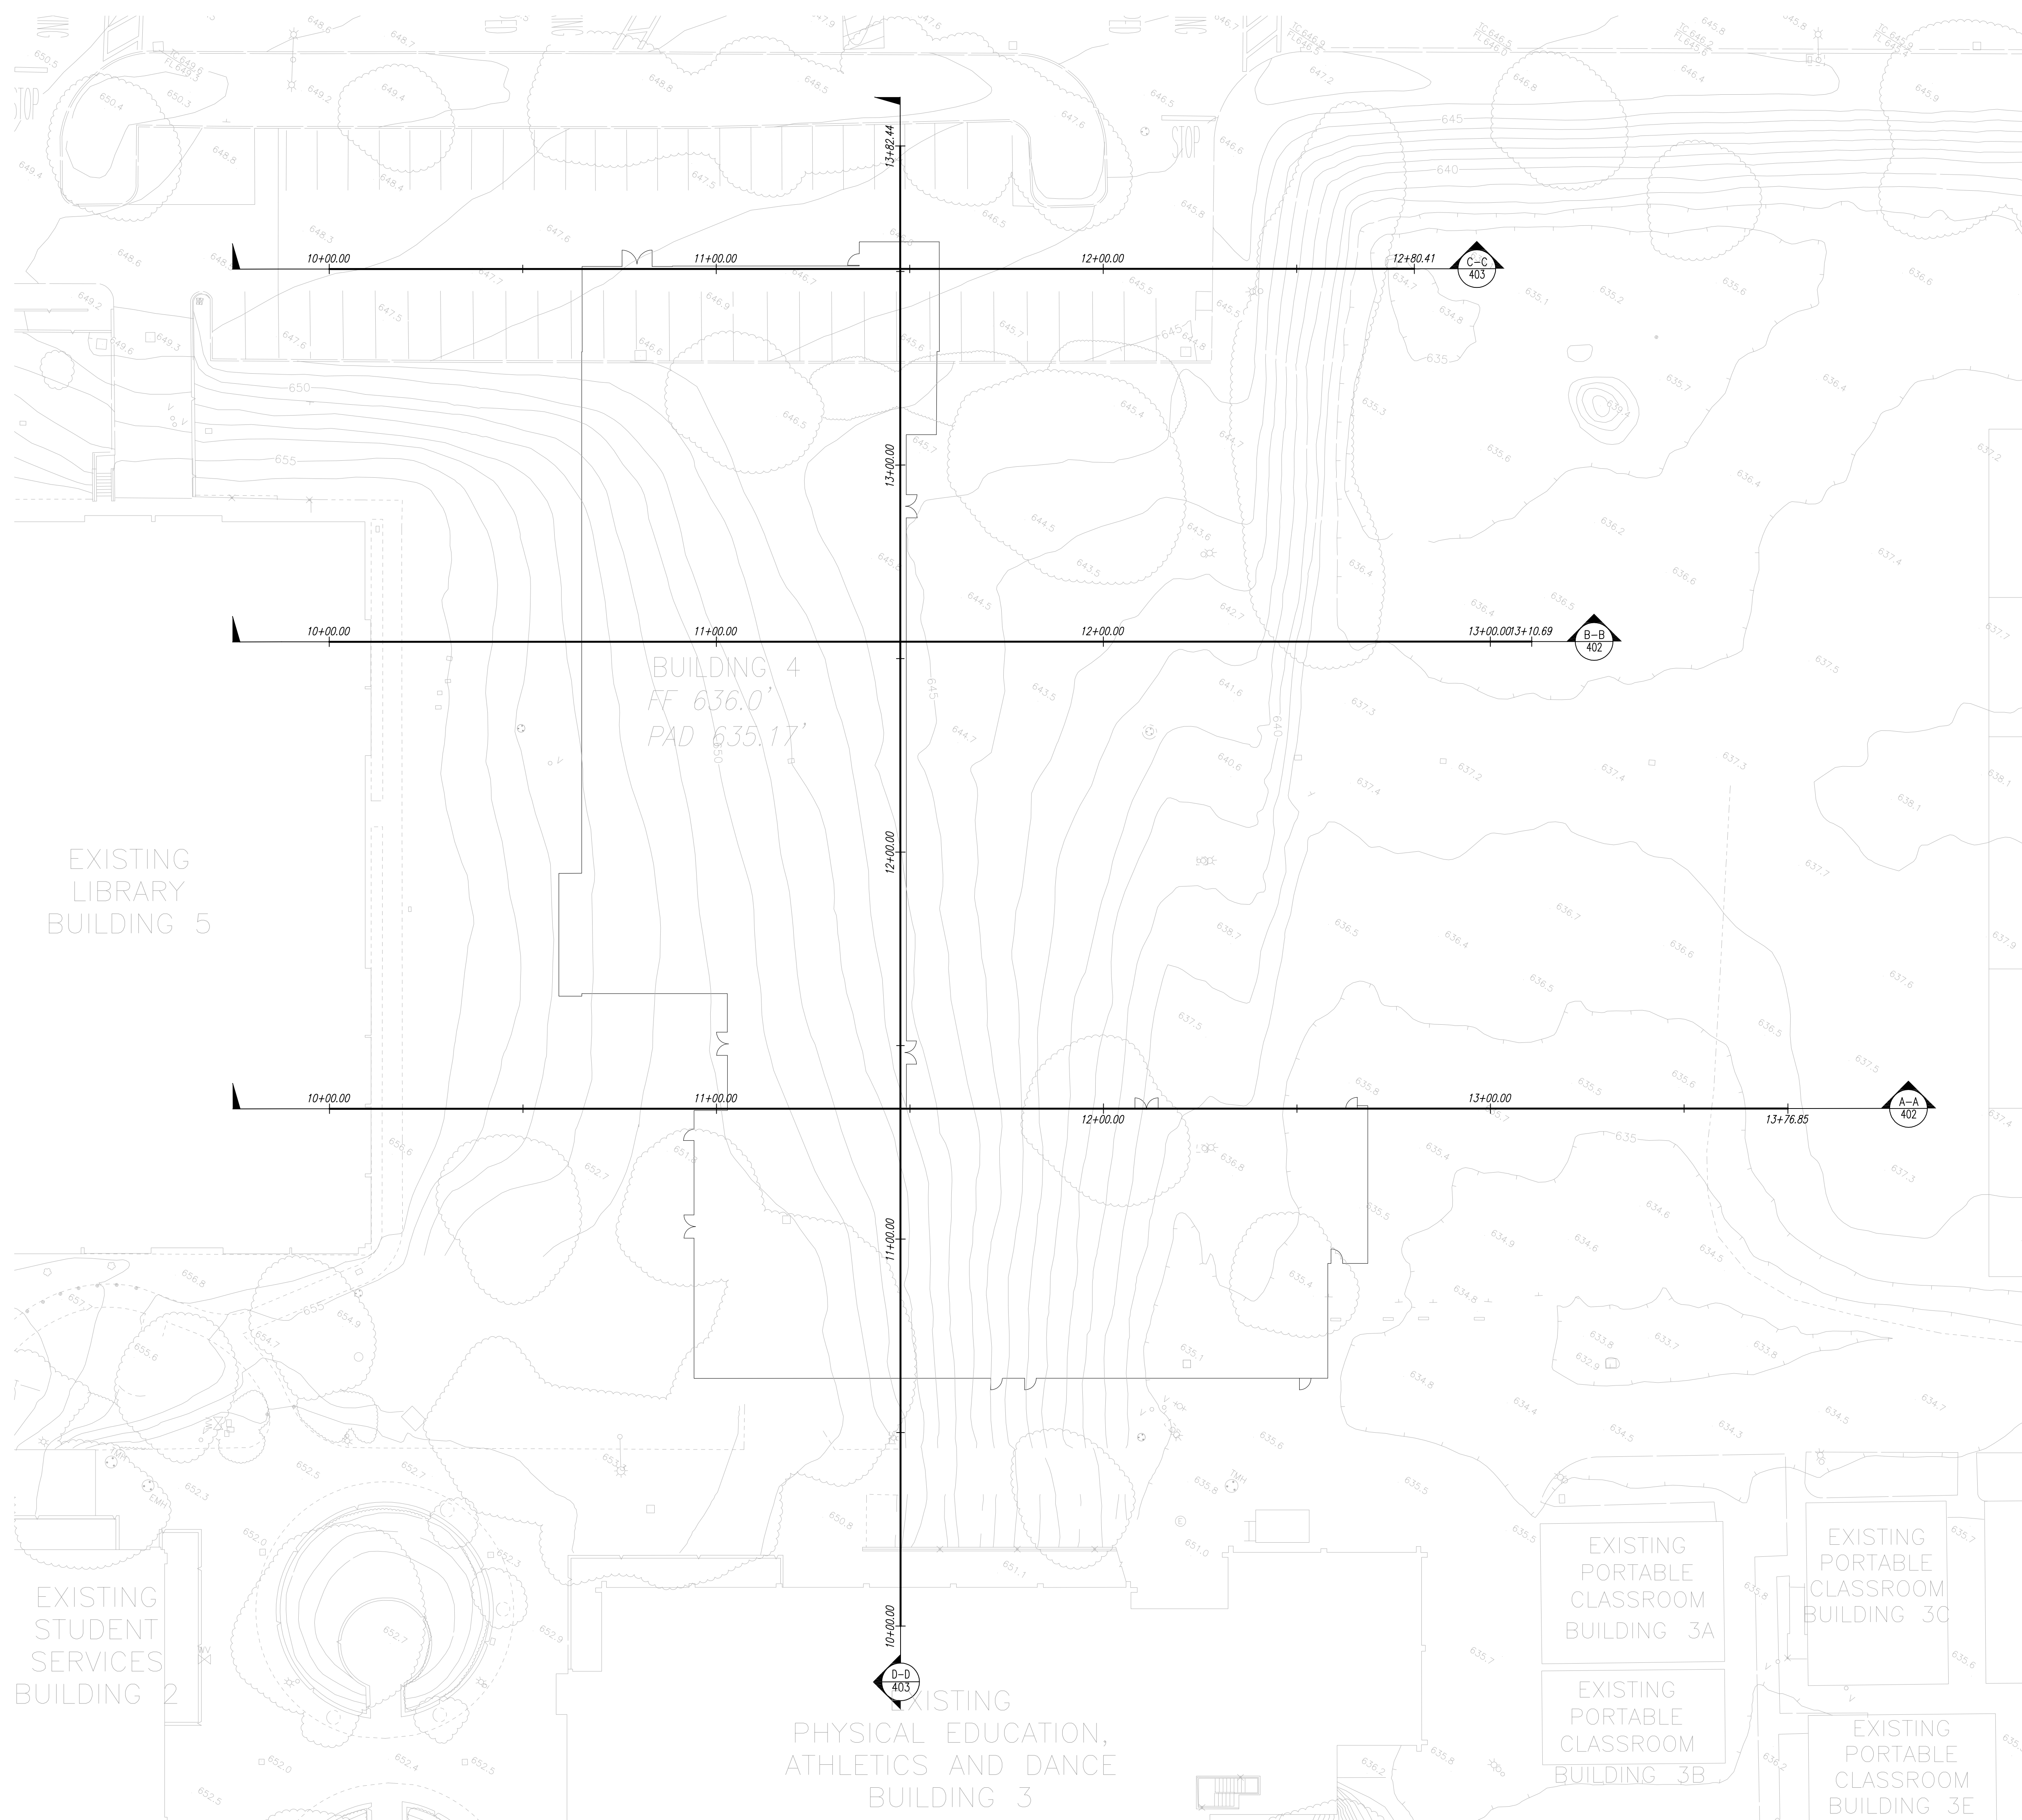

PROJECT
RECORD SET

SKYLINE COLLEGE
CIP2 DESIGN-BUILD
BUILDING 4

PROJECT NO: 07012.00 DRAWN BY: DZ
DATE: 01/31/11 CHECKED BY: MC
SCALE: AS SHOWN

SHEET TITLE:
**BUILDING 4
EARTHWORK
CROSS-SECTION
PLAN**