

NO.	REVISIONS	DATE
1	100% SCHEDULE DESIGN SUBMITTAL	03/20/10
2	90% DESIGN DEVELOPMENT SUBMITTAL	03/23/10
3	100% DESIGN DEVELOPMENT SUBMITTAL	03/23/10
4	FINAL DESIGN DEVELOPMENT SUBMITTAL	03/23/10
5	FINAL DESIGN DEVELOPMENT SUBMITTAL	03/23/10
6	PERMIT REVIEW #1	10/10/10
7	PERMIT REVIEW #2	10/10/10
8	PERMIT REVIEW #3	11/11/10
9	PERMIT REVIEW #4	03/11/10
10	PERMIT REVIEW #5	03/11/10
11	PERMIT REVIEW #6	03/11/10





DIVISION OF THE
 STATE ARCHITECT
 FILE # A-10117
 AG _____ RS _____
 SSS _____ DME _____
 IDENTIFICATION
 STAMP

SKYLINE COLLEGE
 SAN JUAN COUNTY
 COMMUNITY COLLEGE
 DESIGN
CIP2 DESIGN-BUILD
PROJECT
BUILDING 4
INCREMENT 2
 FORM NO.

PROJECT NO: 0701200 DRAWN BY: JDC/O
 DATE: 04/20/09 CHECKED BY:
 SCALE: -
 SHEET TITLE
OVERALL
ROOF PLAN

AS BUILT DRAWINGS
JANUARY 12, 2011

SHEET NO:
PC-104

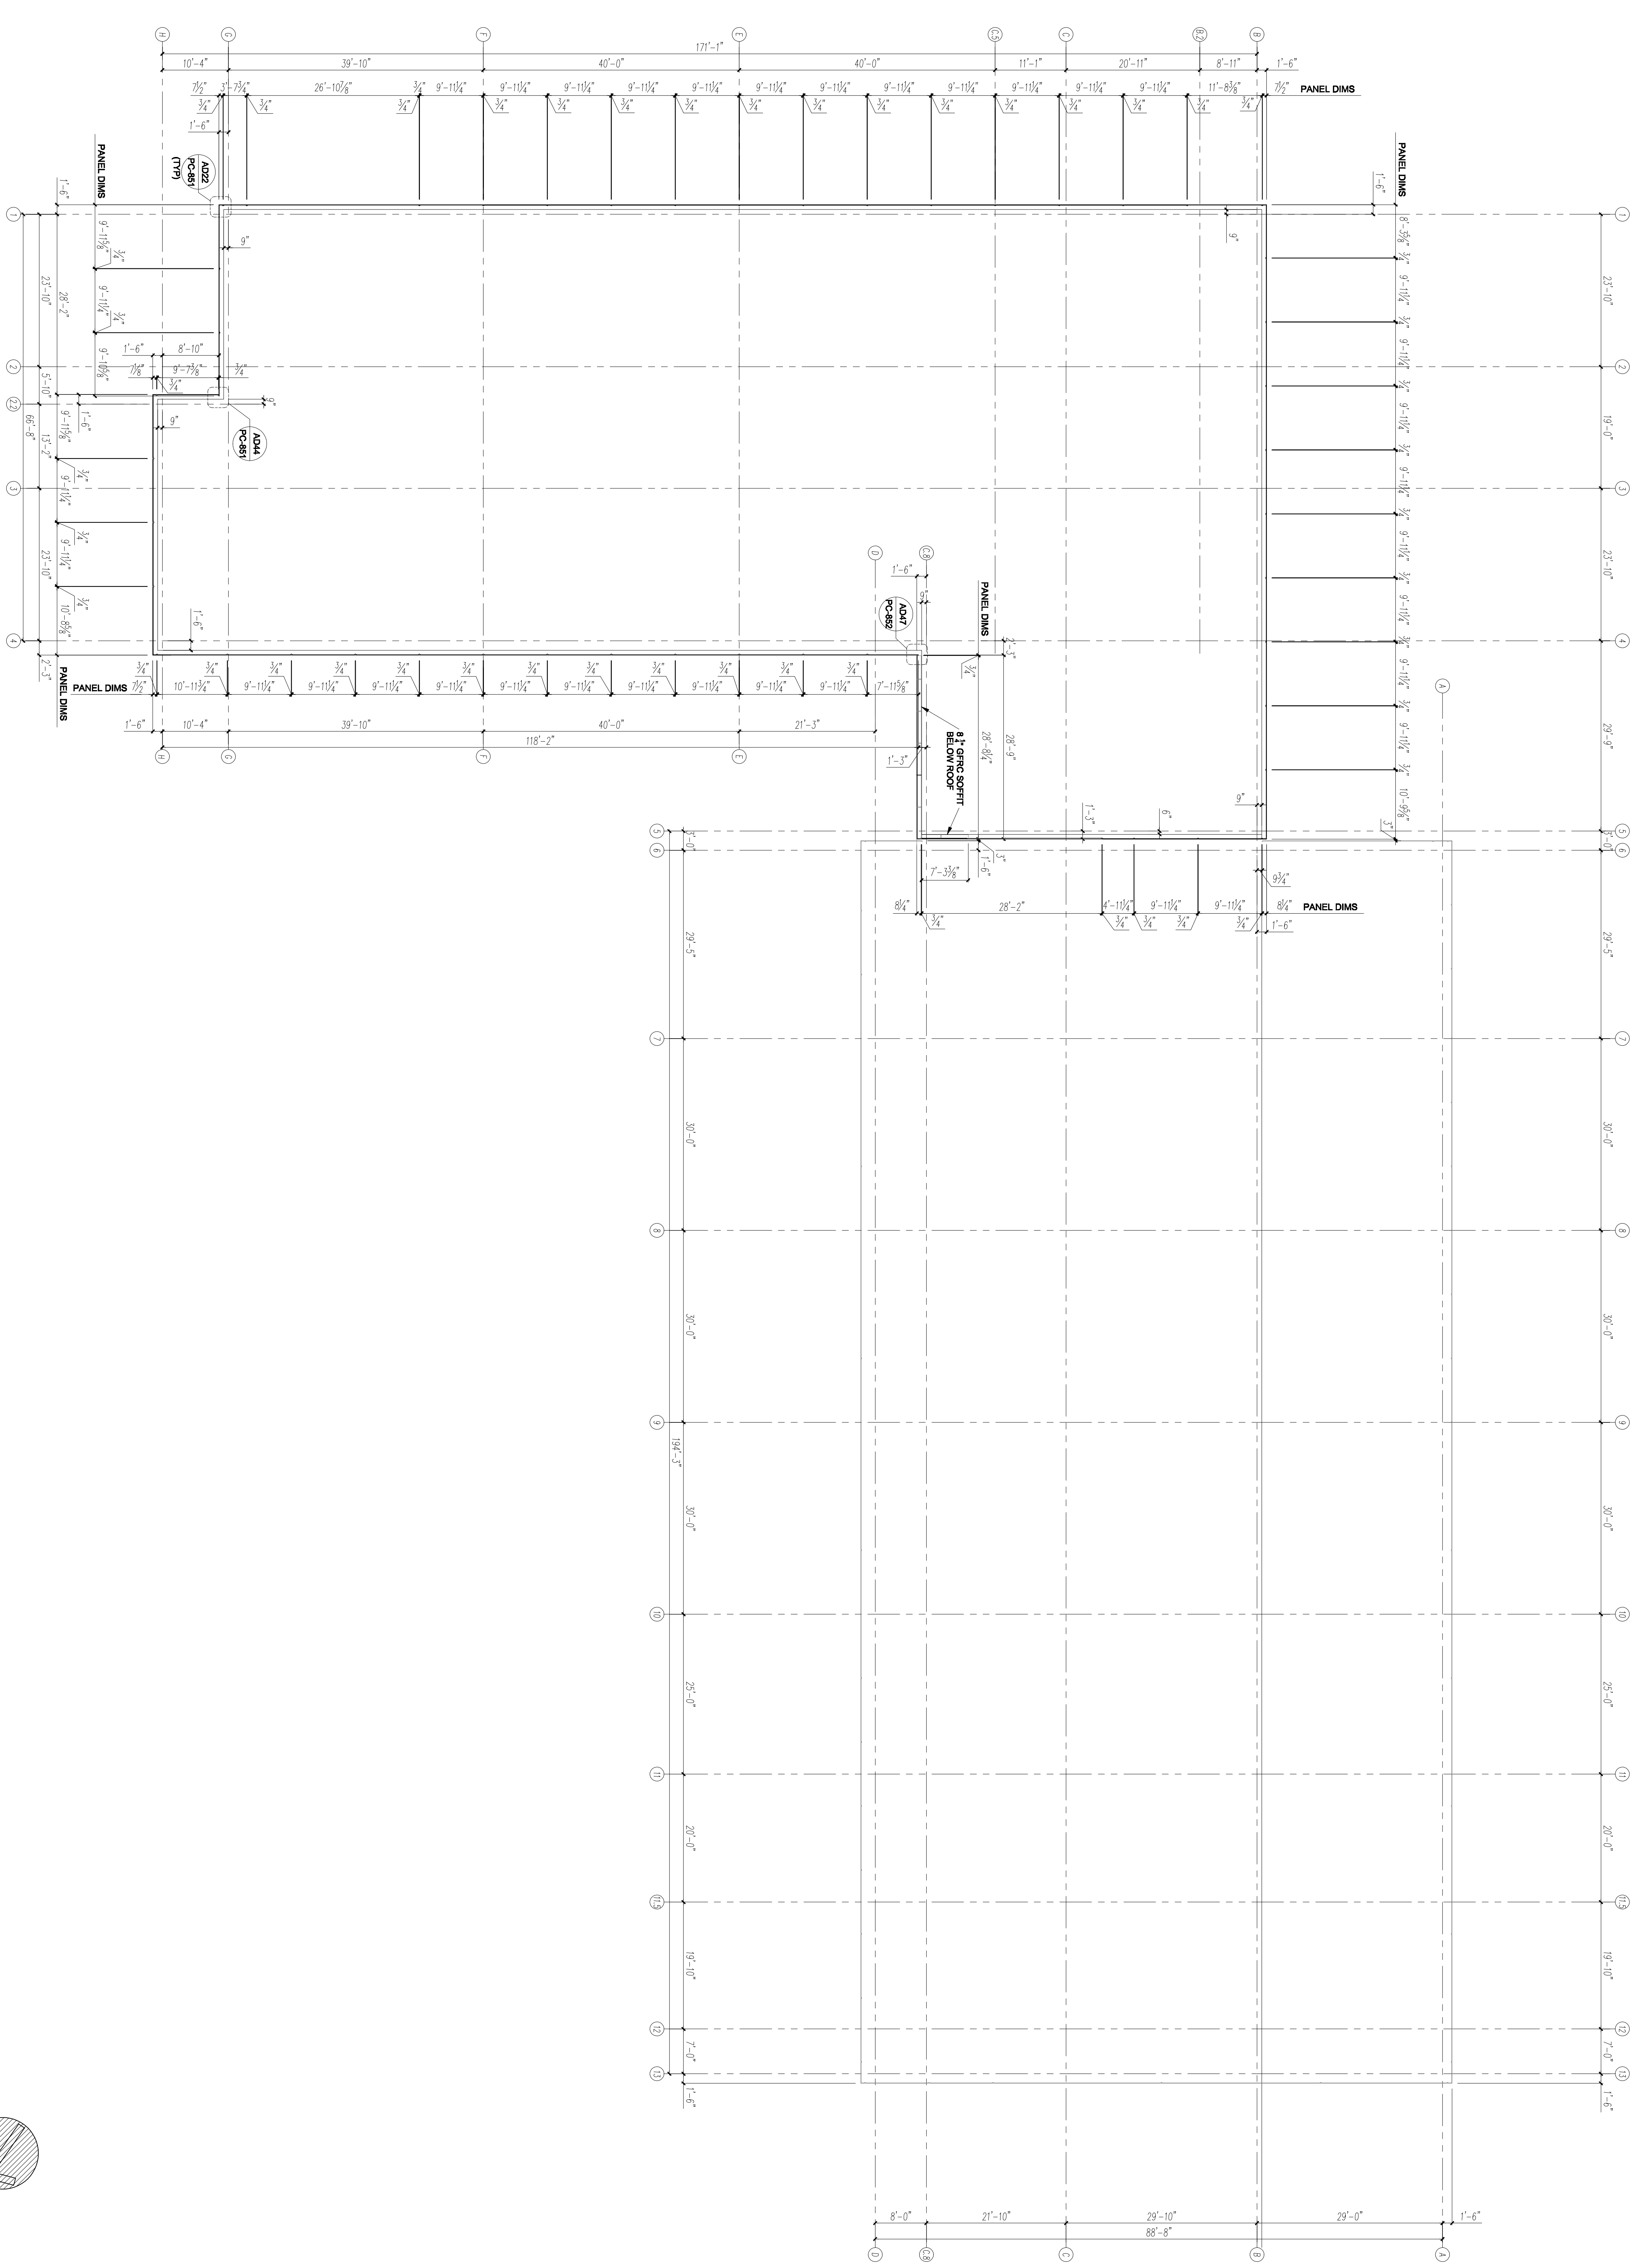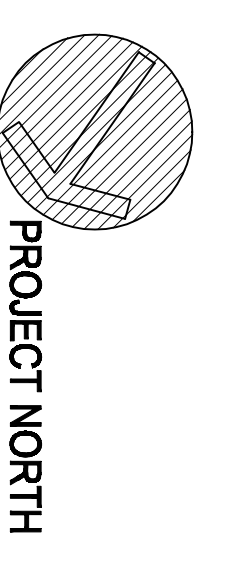

ROOF PLAN 1
 382' x 104'

All drawings and written material prepared by WRNS Studio are the property of WRNS Studio and shall remain the property of WRNS Studio. No part of this drawing may be reproduced, stored in a retrieval system, or transmitted in any form or by any means, electronic, mechanical, photocopying, recording, or by any information storage and retrieval system, without the prior written permission of WRNS Studio.

This drawing is not to scale. The drawing shall be used to verify dimensions. The original size shall be used for all dimensions. The drawing shall be used to verify dimensions. The original size shall be used for all dimensions.