

NO.	REVISIONS	DATE
1	ISSUE FOR PERMIT	02/08/11
2	FOR CONSTRUCTION	02/08/11
3	FOR CONSTRUCTION	02/08/11

DIVISION OF THE
 STATE ARCHITECT
 APPL # 01-110117
 REG # 44381
 AG _____ RS _____
 SSS _____ DNE _____
 IDENTIFICATION
 STAMP

SKYLINE COLLEGE
 SAN JUAN COUNTY
 COMMUNITY COLLEGE
 DESIGN
CIP2 DESIGN-BUILD
BUILDING 4
INCREMENT 2



PROJECT NO: 0701200
 DATE: 04/08/09
 DRAWN BY: JDC/CA
 CHECKED BY:
 SCALE: 1/8" = 1'-0"

AS BUILT DRAWINGS
JANUARY 12, 2011

PC-203

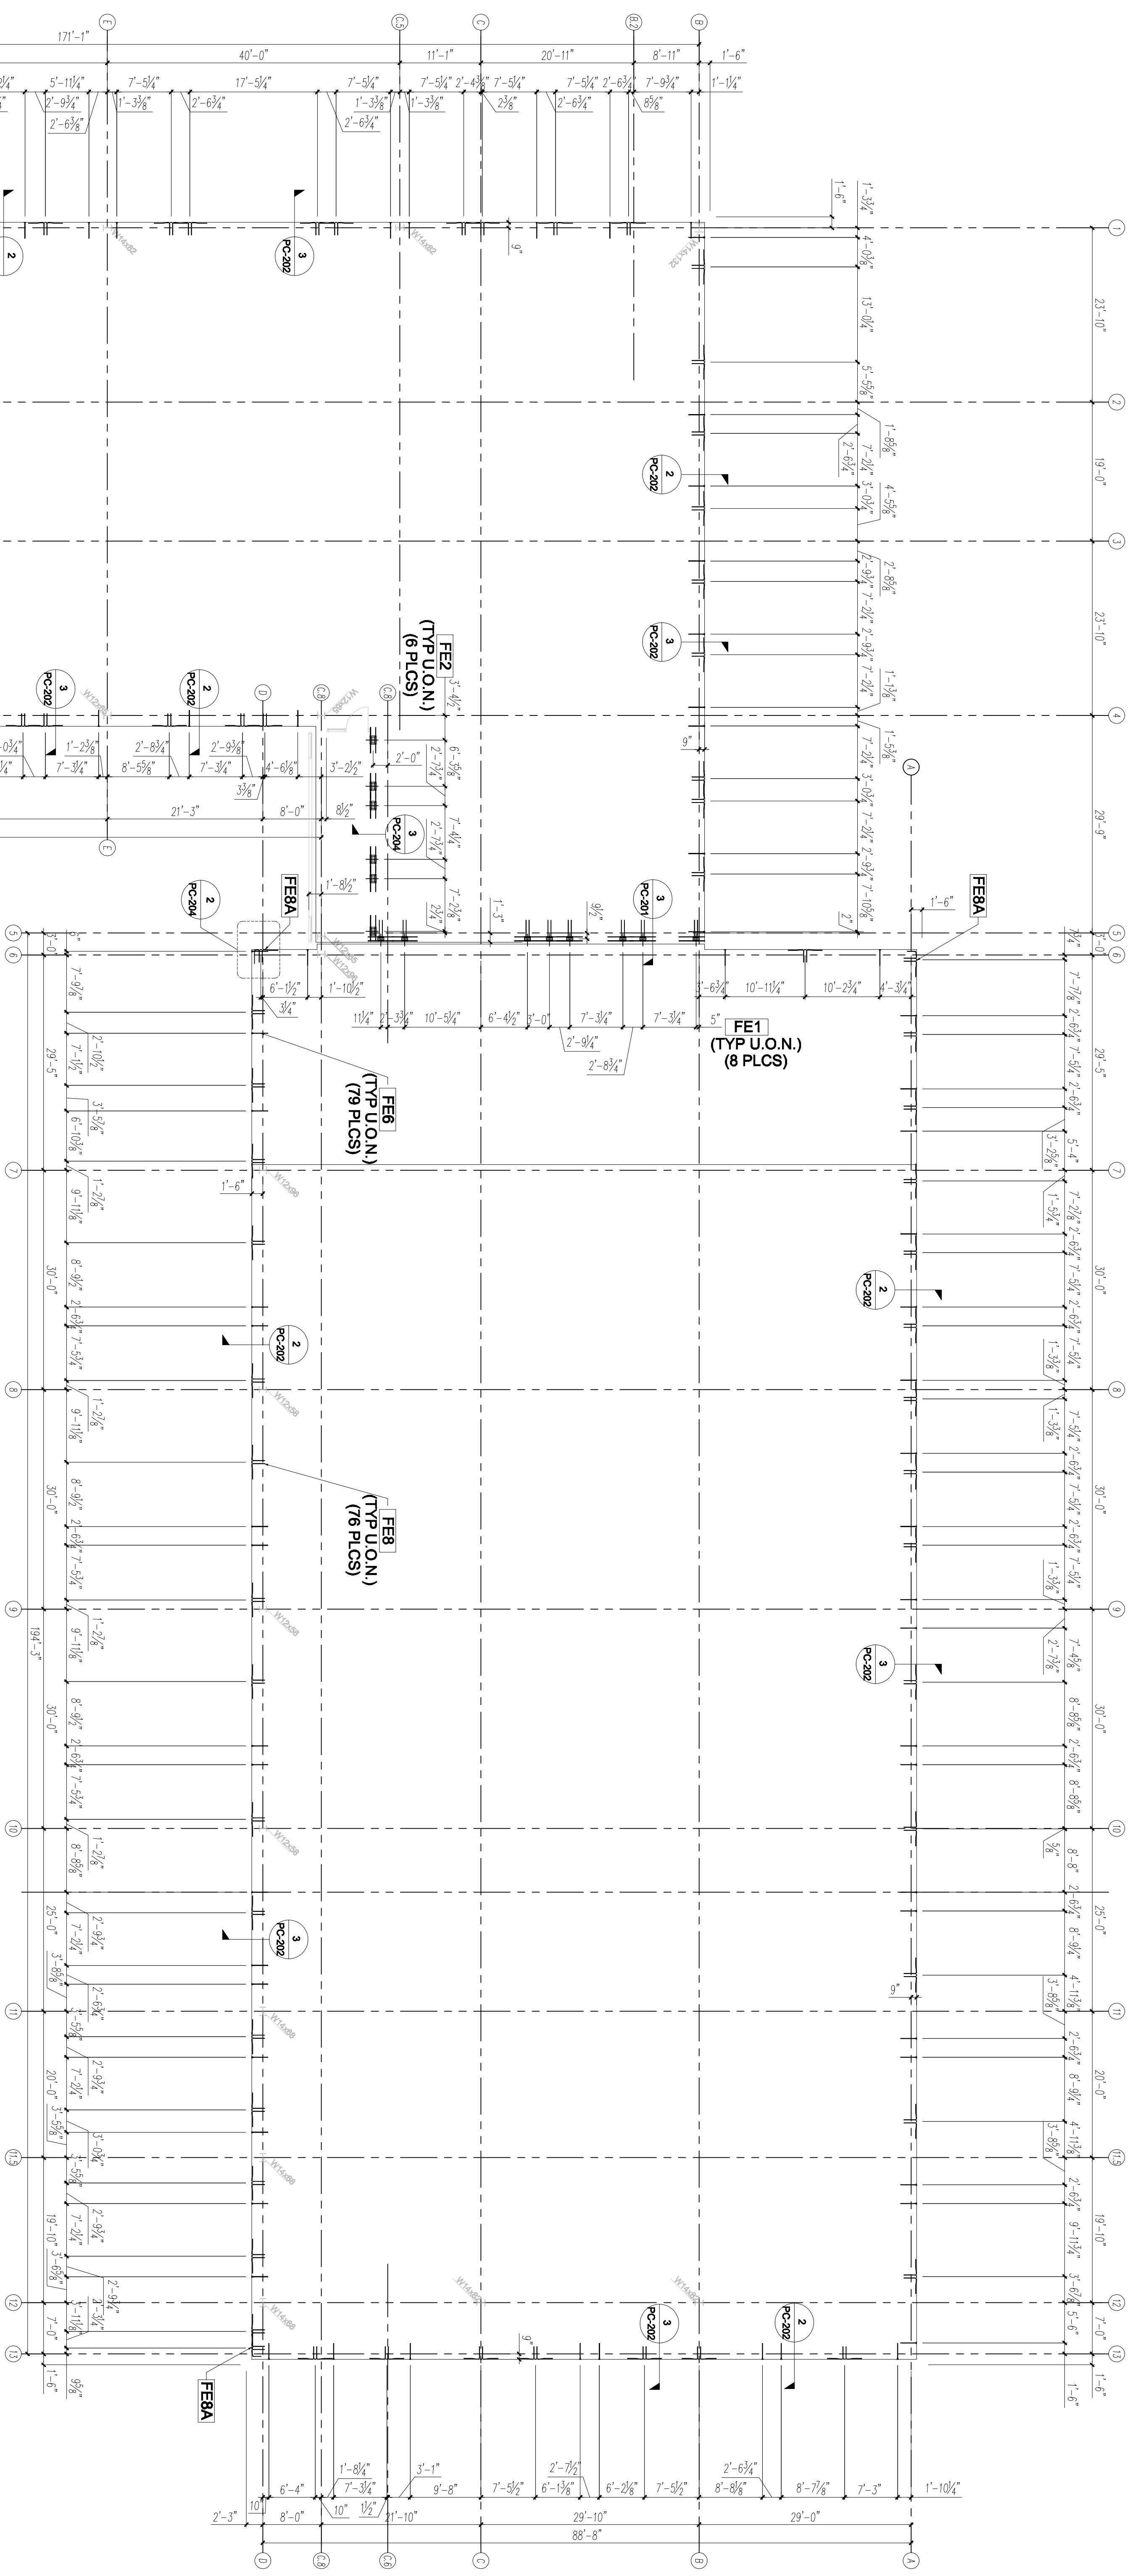

LEVEL 3 - EMBED PLAN 1
 3/32" = 1'-0"

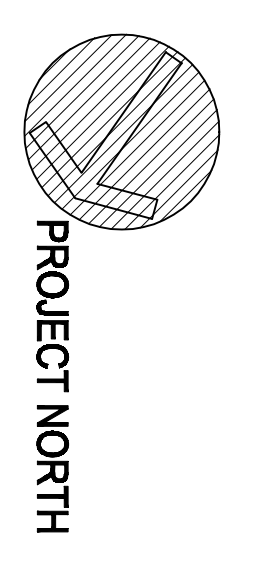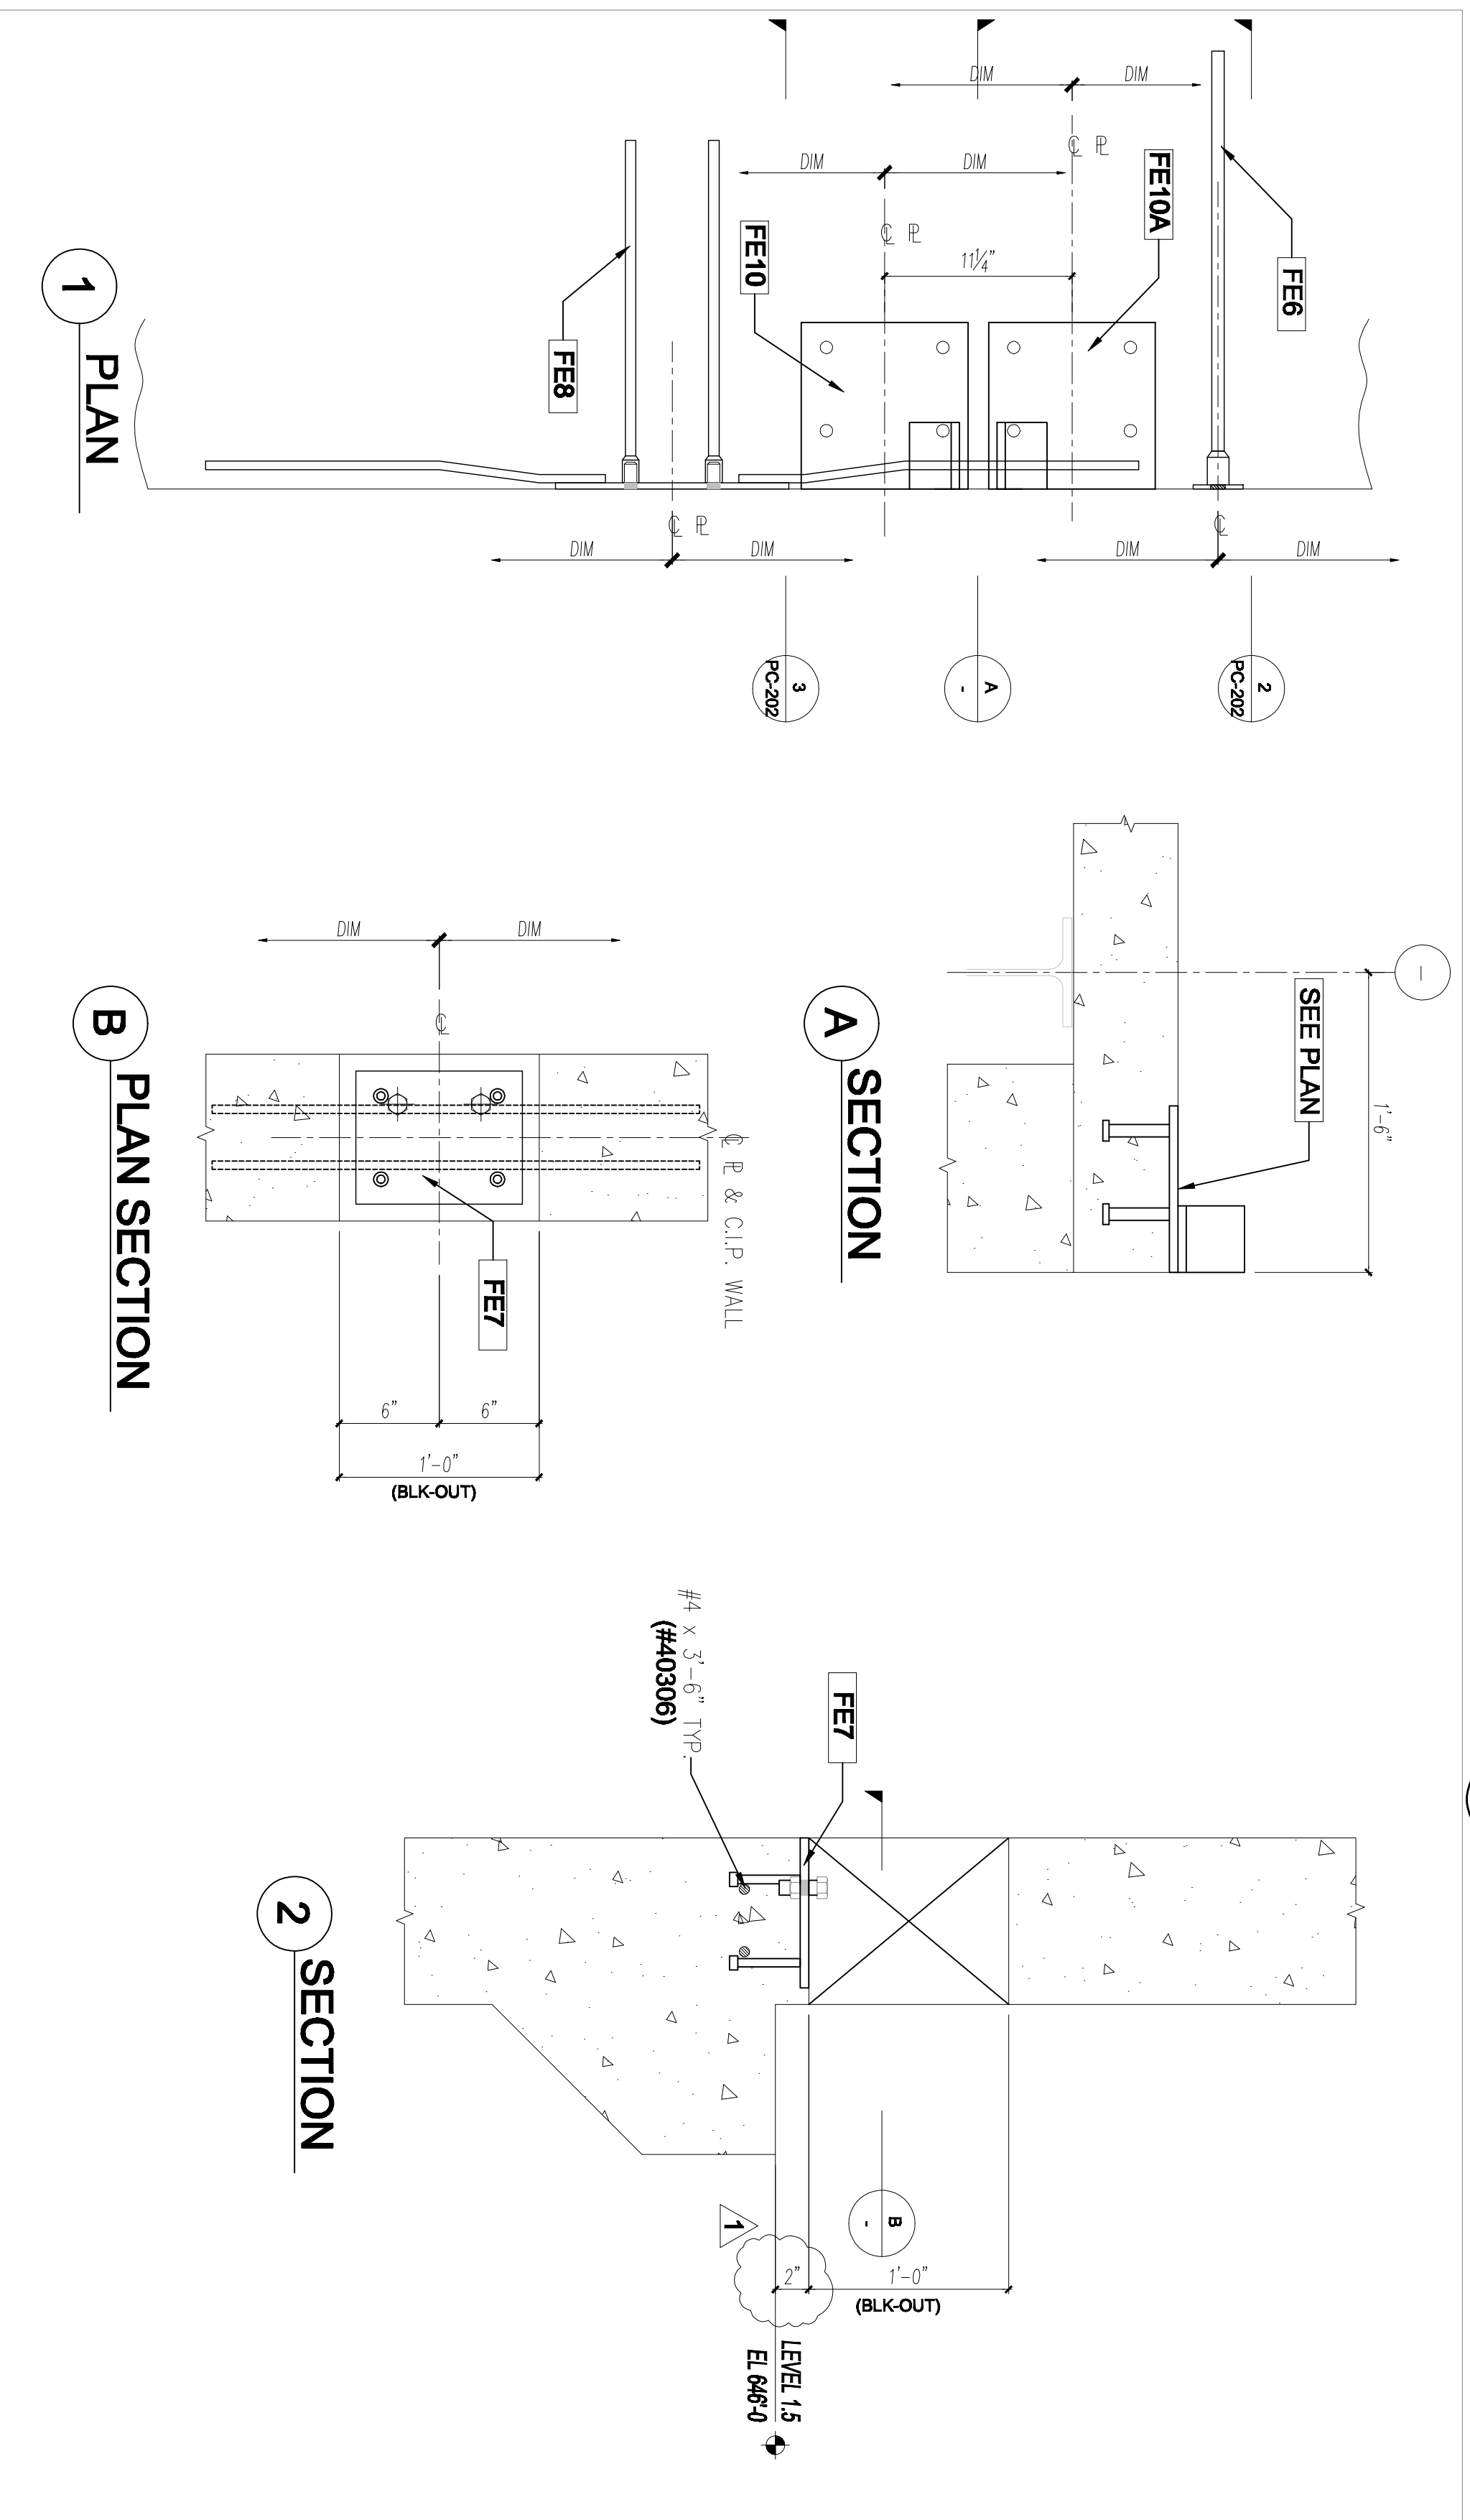

All drawings and notes are the property of Steinberg Architects and shall remain the property of Steinberg Architects. No part of these drawings may be reproduced, stored in a retrieval system, or transmitted in any form or by any means, electronic, mechanical, photocopying, recording, or by any information storage and retrieval system, without the prior written permission of Steinberg Architects.