

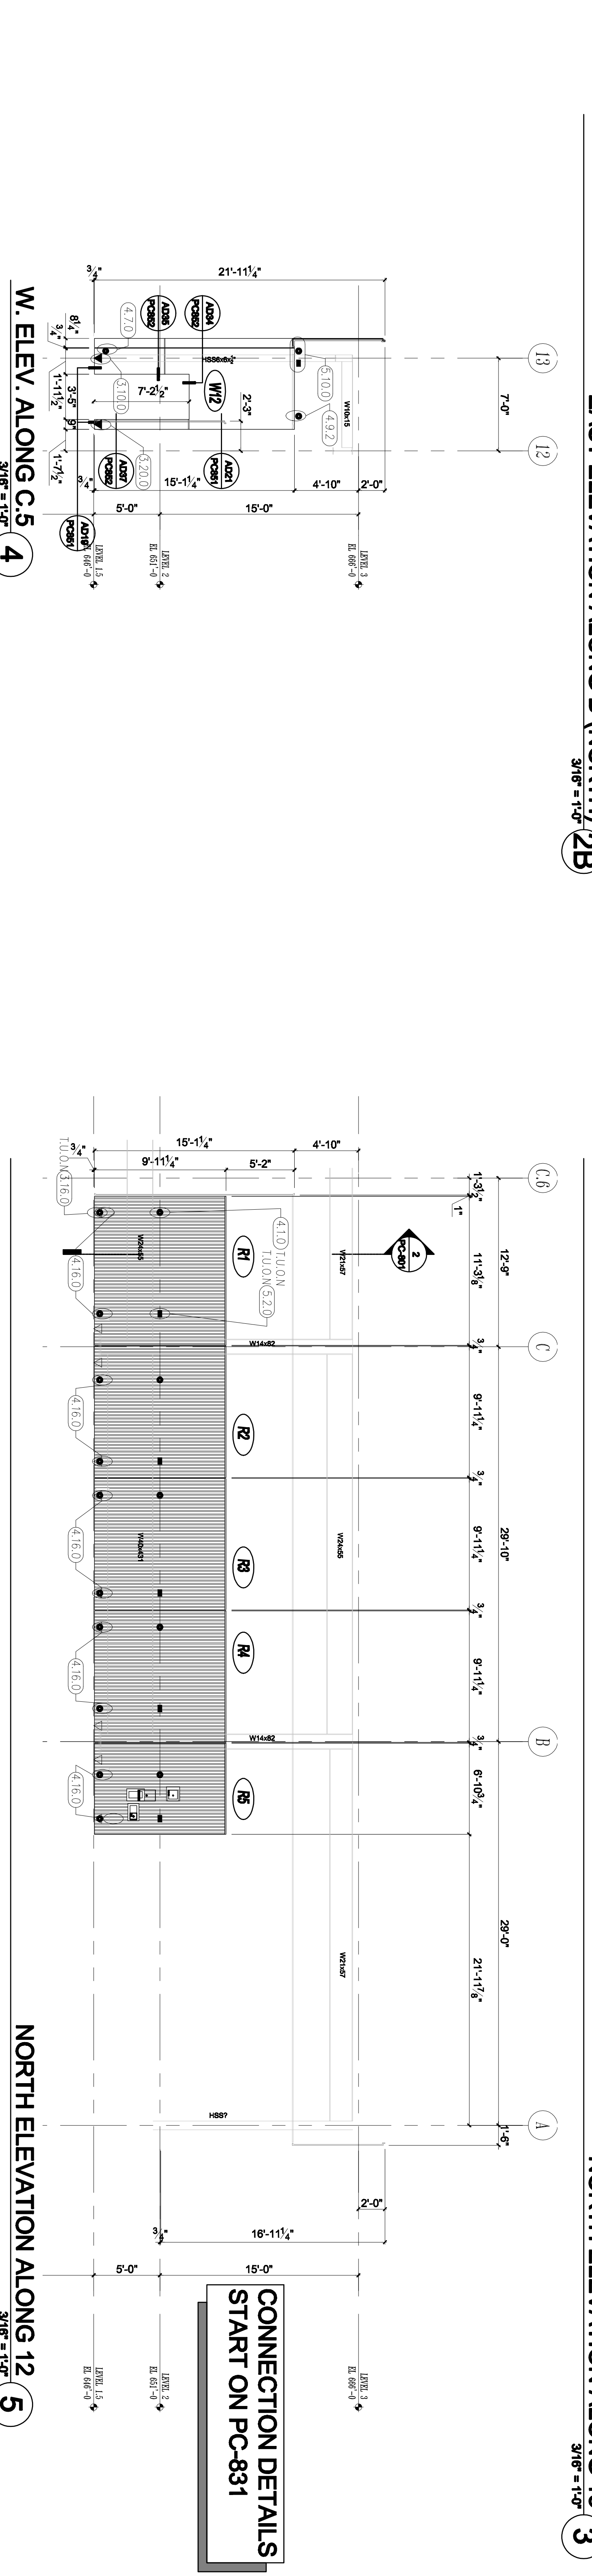



NO.	REVISIONS/DESCRIPTIONS	DATE
1	100% SCHEMATIC DESIGN SUBMITTAL	03/20/10
2	90% DESIGN DEVELOPMENT SUBMITTAL	07/20/10
3	100% DESIGN DEVELOPMENT SUBMITTAL	07/20/10
4	PERMITS	07/20/10
5	PERMITS	07/20/10
6	PERMITS	07/20/10
7	PERMITS	07/20/10
8	PERMITS	07/20/10
9	PERMITS	07/20/10
10	PERMITS	07/20/10
11	PERMITS	07/20/10

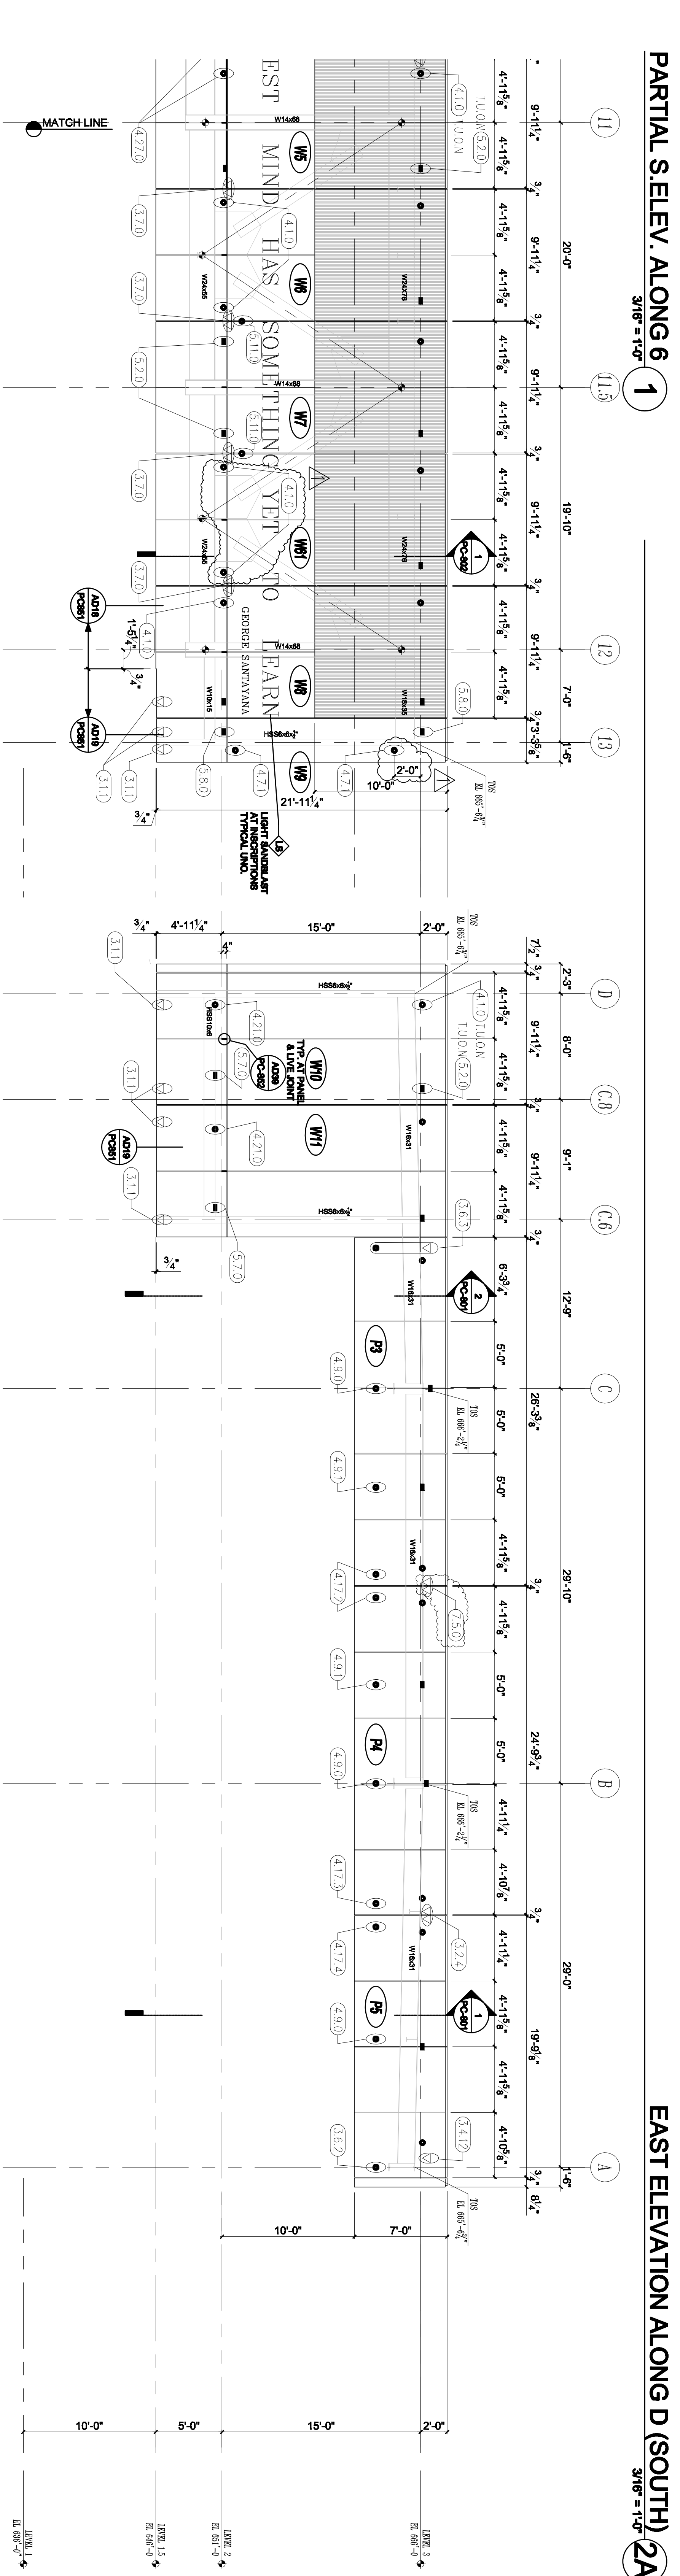

DIVISION OF THE STATE ARCHITECT
 FILE # A-101
 AG _____ RS _____
 SSS _____ DNE _____
 IDENTIFICATION STAMP

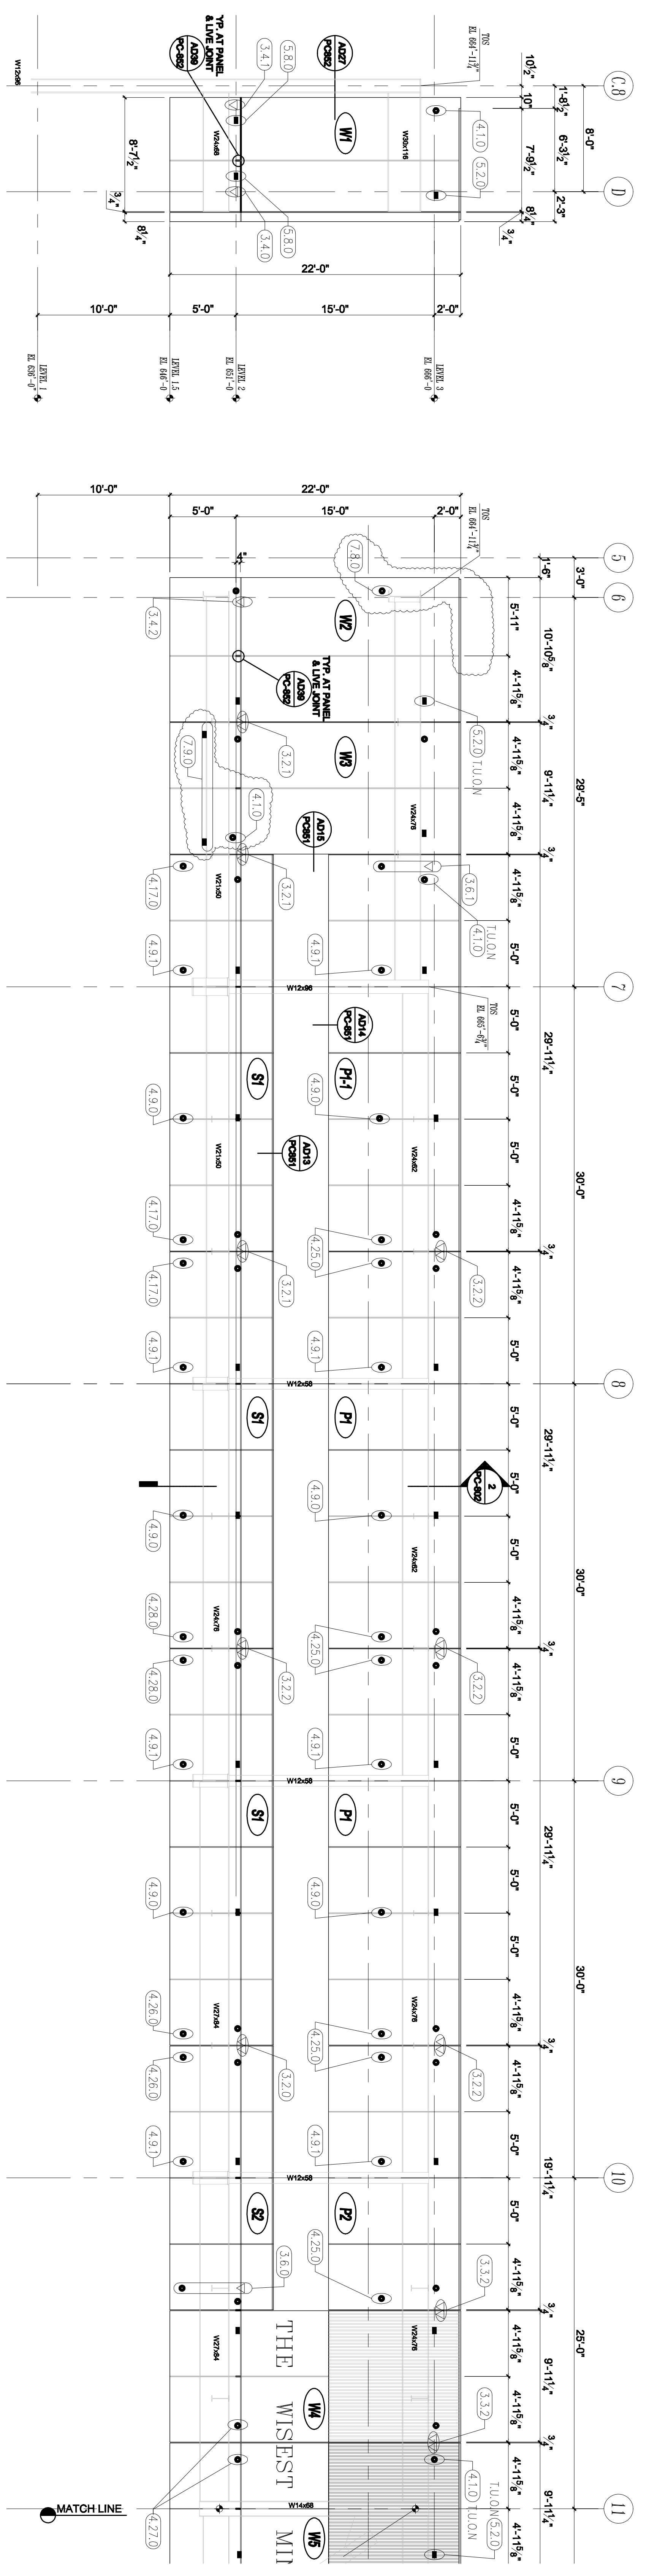

SKYLINE COLLEGE
 SAN MATEO COUNTY
 COMMUNITY COLLEGE
CIP2 DESIGN-BUILD
PROJECT BUILDING 4
INCREMENT 2

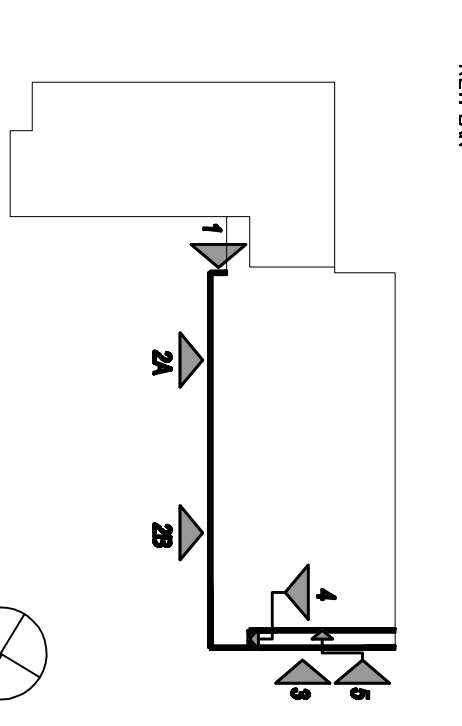

AS BUILT DRAWINGS
JANUARY 12, 2011

PC-321

All drawings and notes are the property of Steinberg Architects and shall remain the property of Steinberg Architects. No part of these drawings may be reproduced, stored in a retrieval system, or transmitted in any form or by any means, electronic, mechanical, photocopying, recording, or by any information storage and retrieval system, without the prior written permission of Steinberg Architects.

This drawing is not to scale. Dimensions shall be taken from the original size. Notes shall be indicated. This drawing shall be used to construct the building.