



WILIS CONSTRUCTION CO. INC. PRE-CAST CONCRETE PRODUCTS	
2201 SAN JUAN AVENUE • SAN JUAN BATISTIA, CA 95045 (925) 423-2900 • FAX (925) 423-2948	
NO.	DATE
1	ISSUE FOR PERMIT
2	10% SUBMITTAL DESIGN SUBMITTAL
3	30% DESIGN DEVELOPMENT SUBMITTAL
4	NON DESIGN DEVELOPMENT SUBMITTAL
5	FINAL DESIGN DEVELOPMENT SUBMITTAL
6	FINAL DESIGN DEVELOPMENT SUBMITTAL
7	REVISION #1
8	REVISION #2
9	REVISION #3
106	REVISION #100

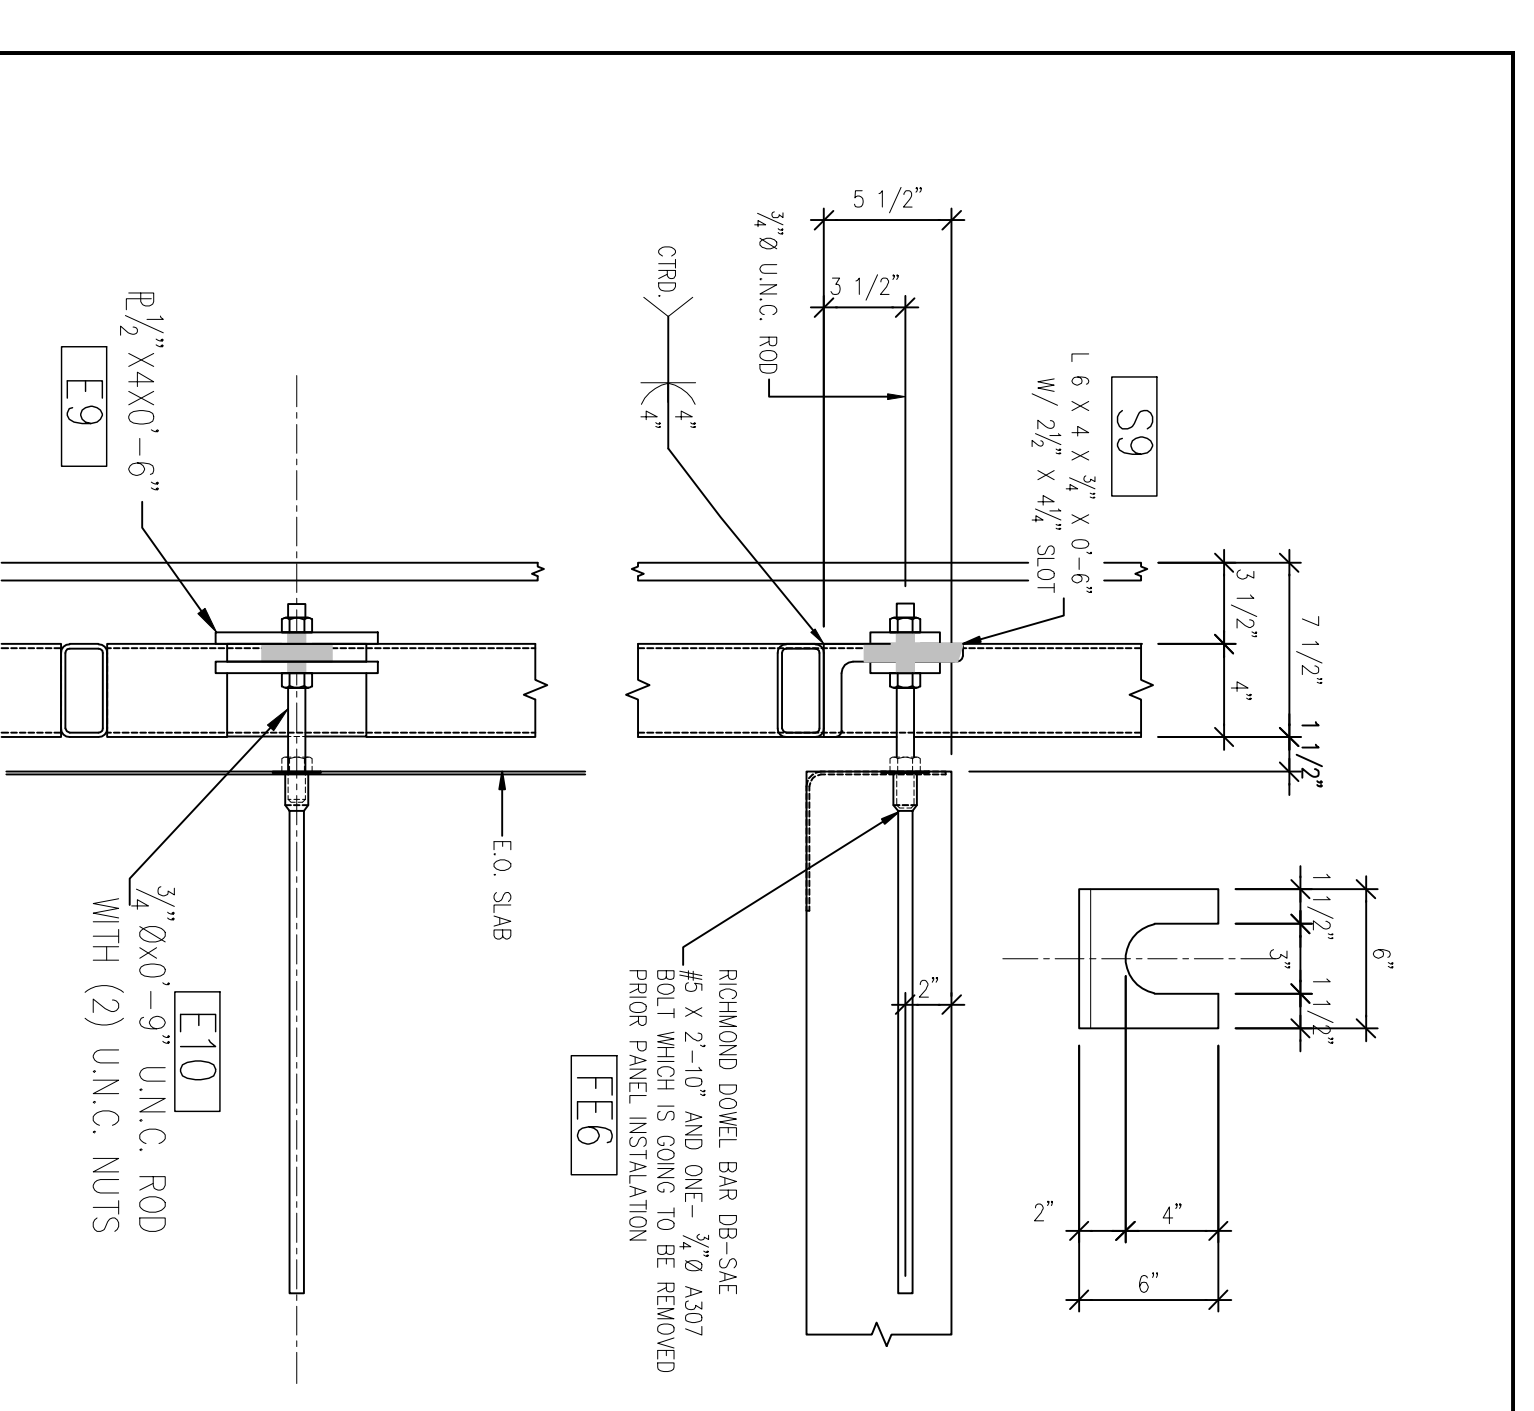


WILIS CONSTRUCTION CO. INC.
PRE-CAST CONCRETE PRODUCTS
 2201 SAN JUAN AVENUE • SAN JUAN BATISTIA, CA 95045
 (925) 423-2900 • FAX (925) 423-2948

JOB NAME:	Skyline Bldg. 4N	JOB NO.	858
PROJECT:	M.A.	DATE:	
CONNECTION:	CONNECTION	SCALE:	4:1.0

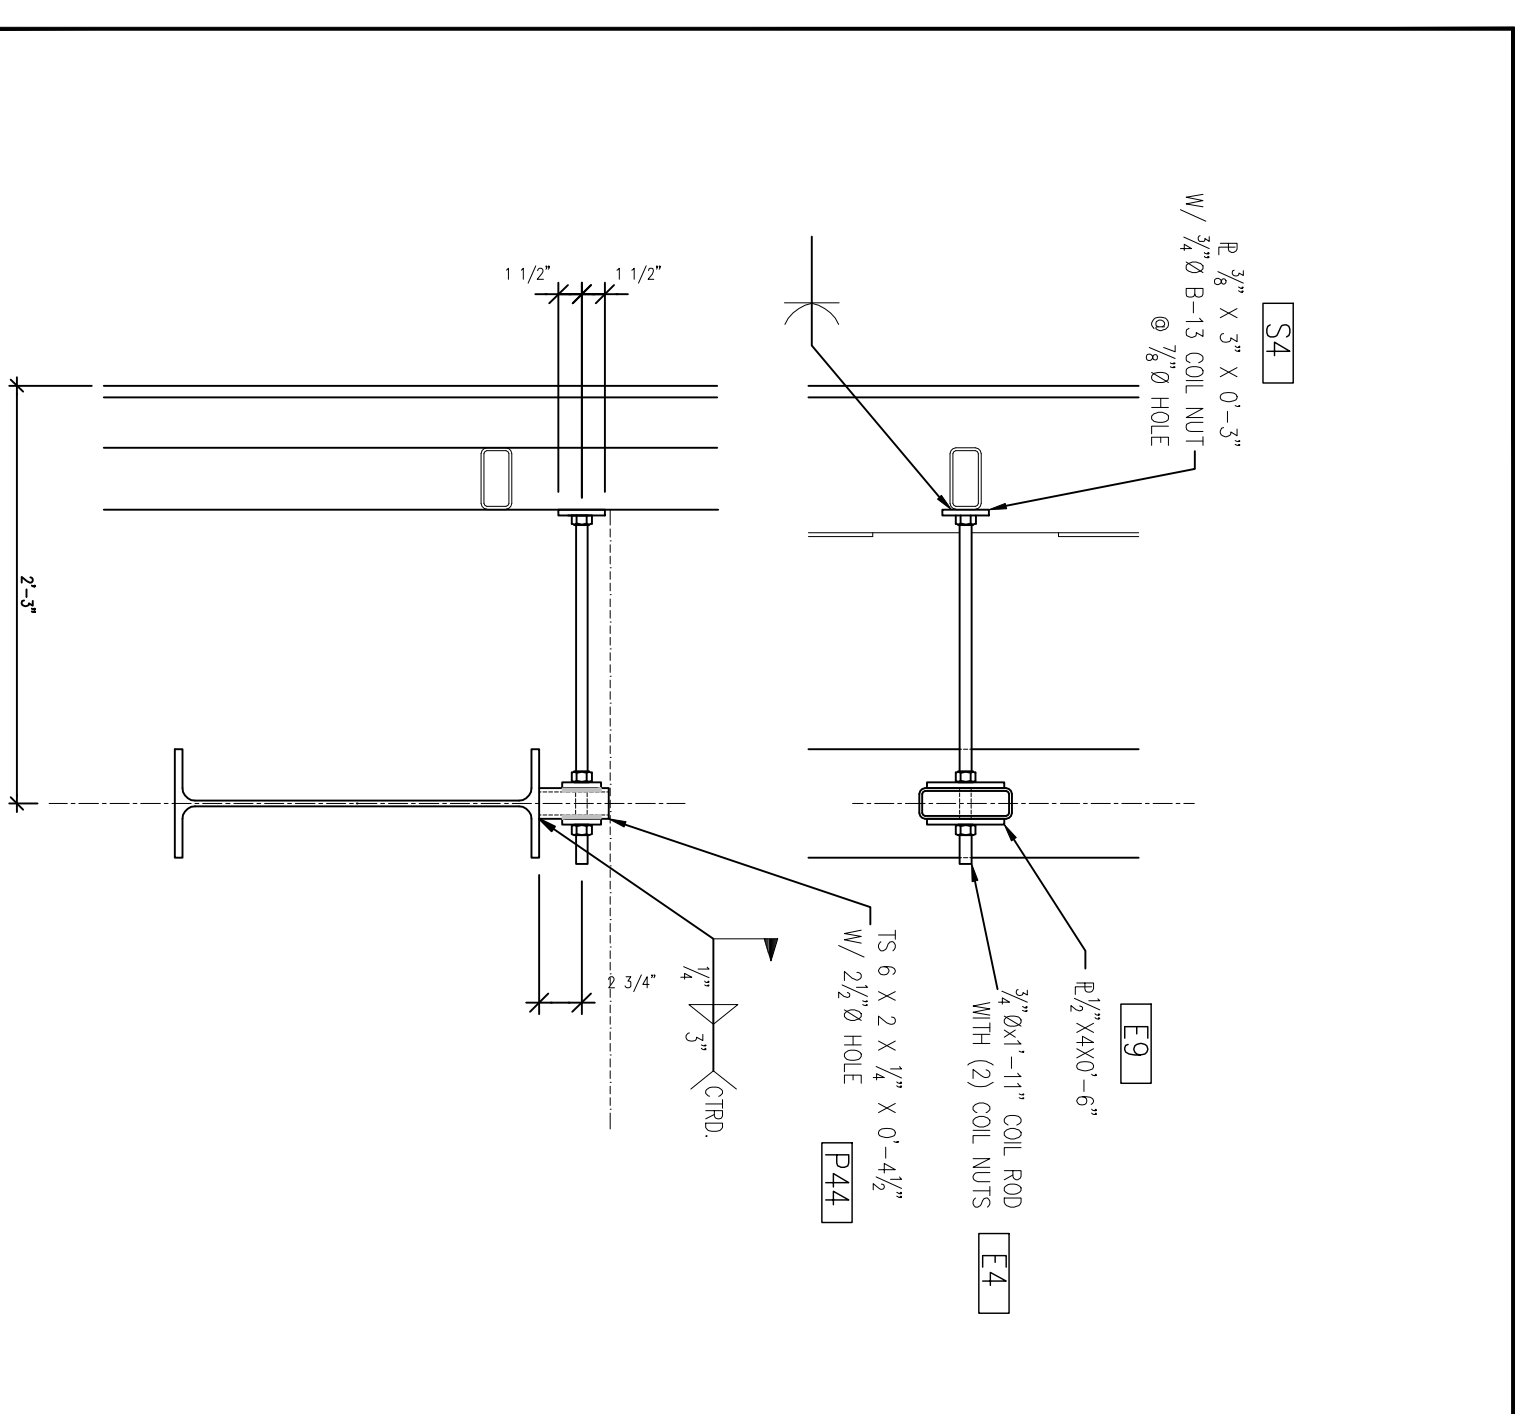


WILIS CONSTRUCTION CO. INC.
PRE-CAST CONCRETE PRODUCTS
 2201 SAN JUAN AVENUE • SAN JUAN BATISTIA, CA 95045
 (925) 423-2900 • FAX (925) 423-2948

JOB NAME:	Skyline Bldg. 4N	JOB NO.	858
PROJECT:	M.A.	DATE:	
CONNECTION:	CONNECTION	SCALE:	4:3.0

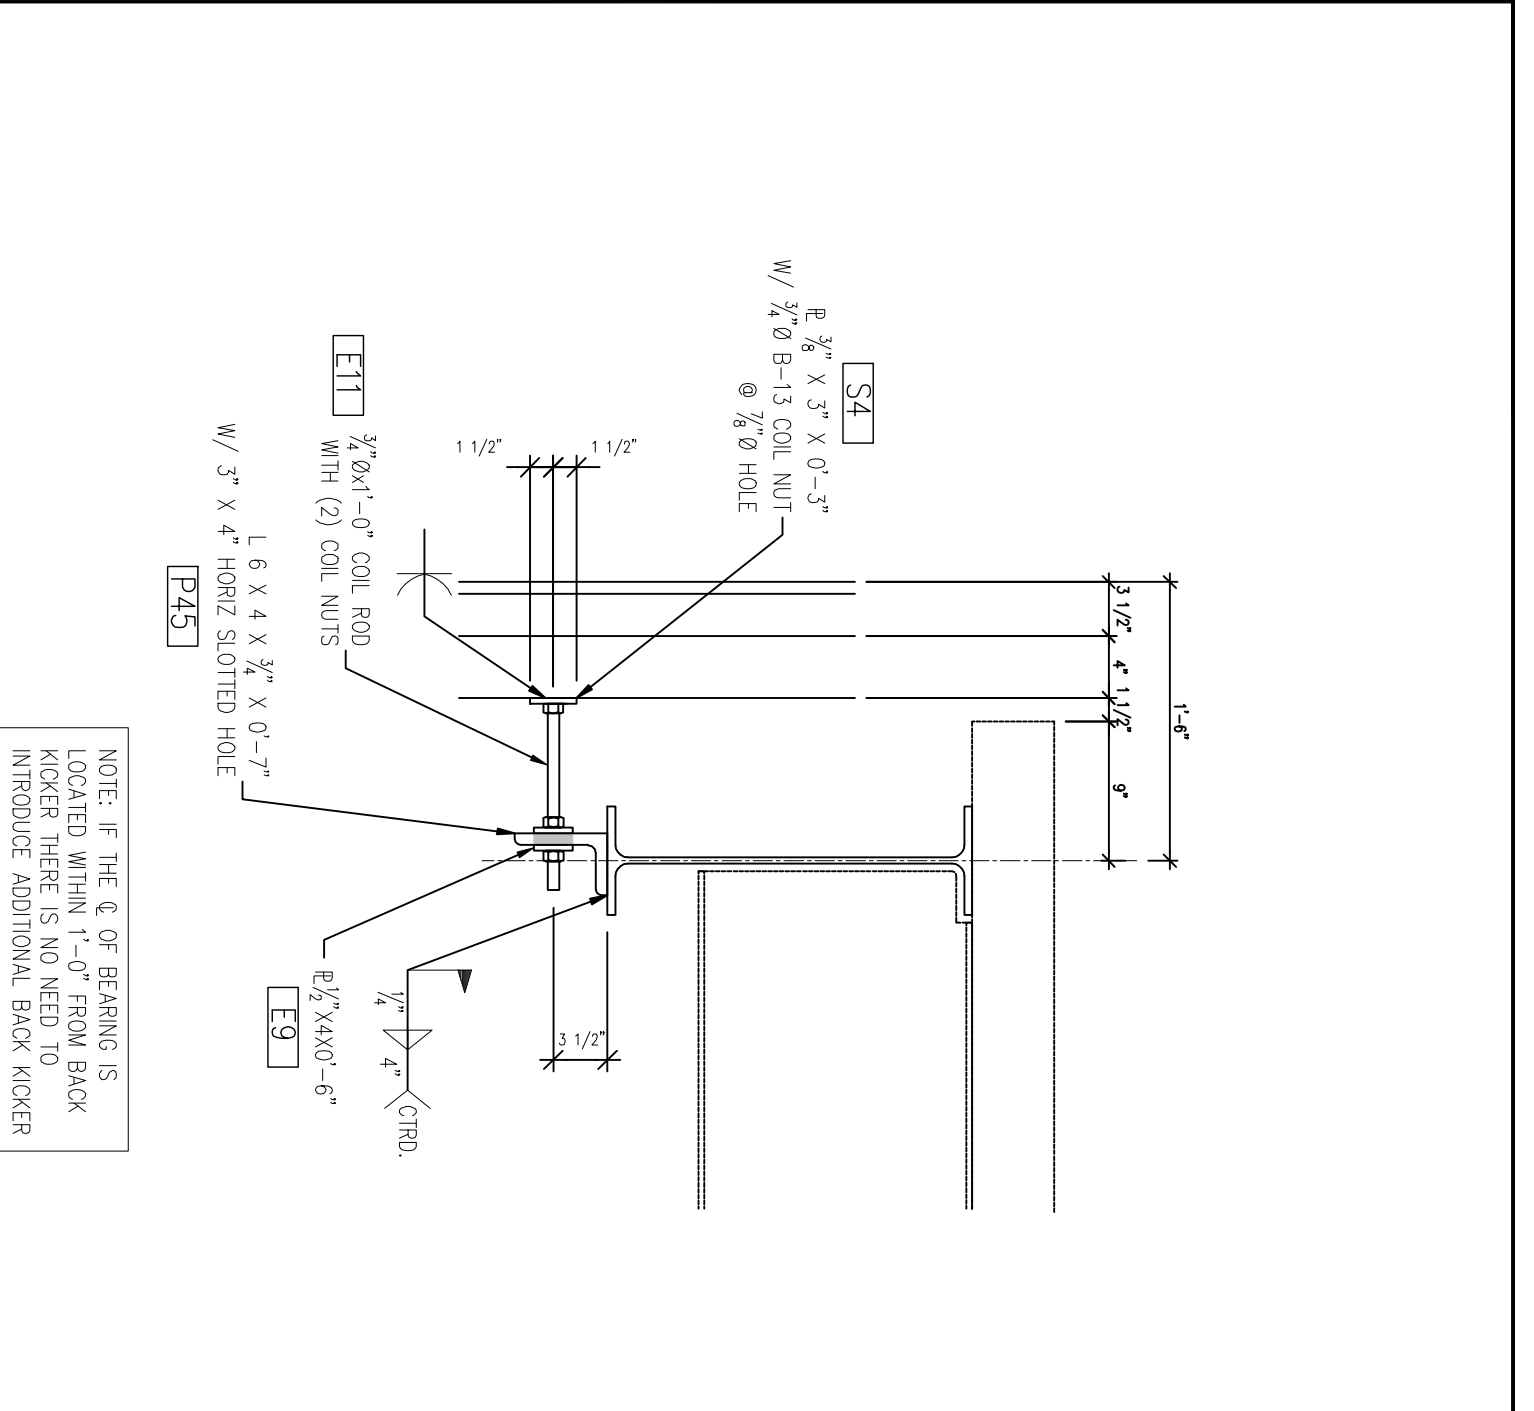


WILIS CONSTRUCTION CO. INC.
PRE-CAST CONCRETE PRODUCTS
 2201 SAN JUAN AVENUE • SAN JUAN BATISTIA, CA 95045
 (925) 423-2900 • FAX (925) 423-2948

JOB NAME:	Skyline Bldg. 4N	JOB NO.	858
PROJECT:	M.A.	DATE:	
CONNECTION:	CONNECTION	SCALE:	4:4.0

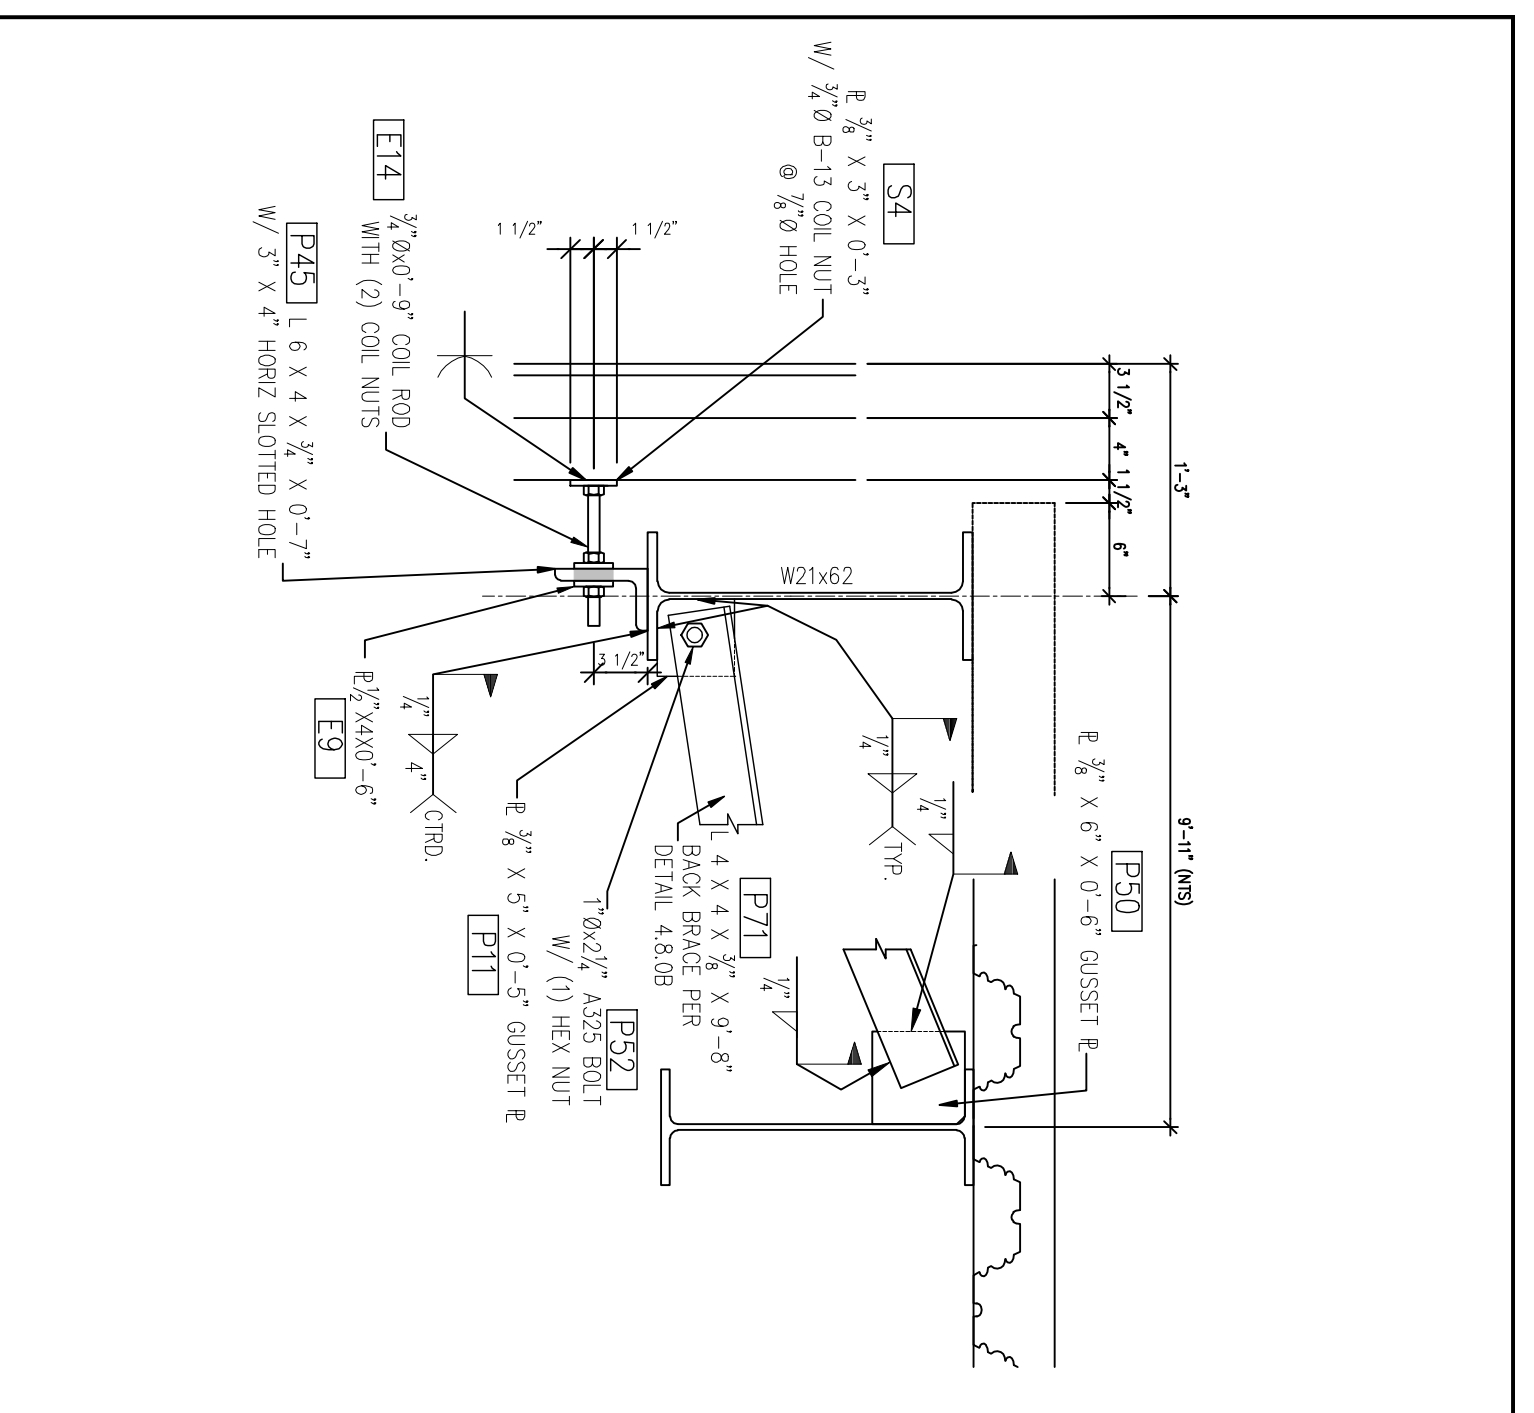


WILIS CONSTRUCTION CO. INC.
PRE-CAST CONCRETE PRODUCTS
 2201 SAN JUAN AVENUE • SAN JUAN BATISTIA, CA 95045
 (925) 423-2900 • FAX (925) 423-2948

JOB NAME:	Skyline Bldg. 4N	JOB NO.	858
PROJECT:	M.A.	DATE:	
CONNECTION:	CONNECTION	SCALE:	4:4.2

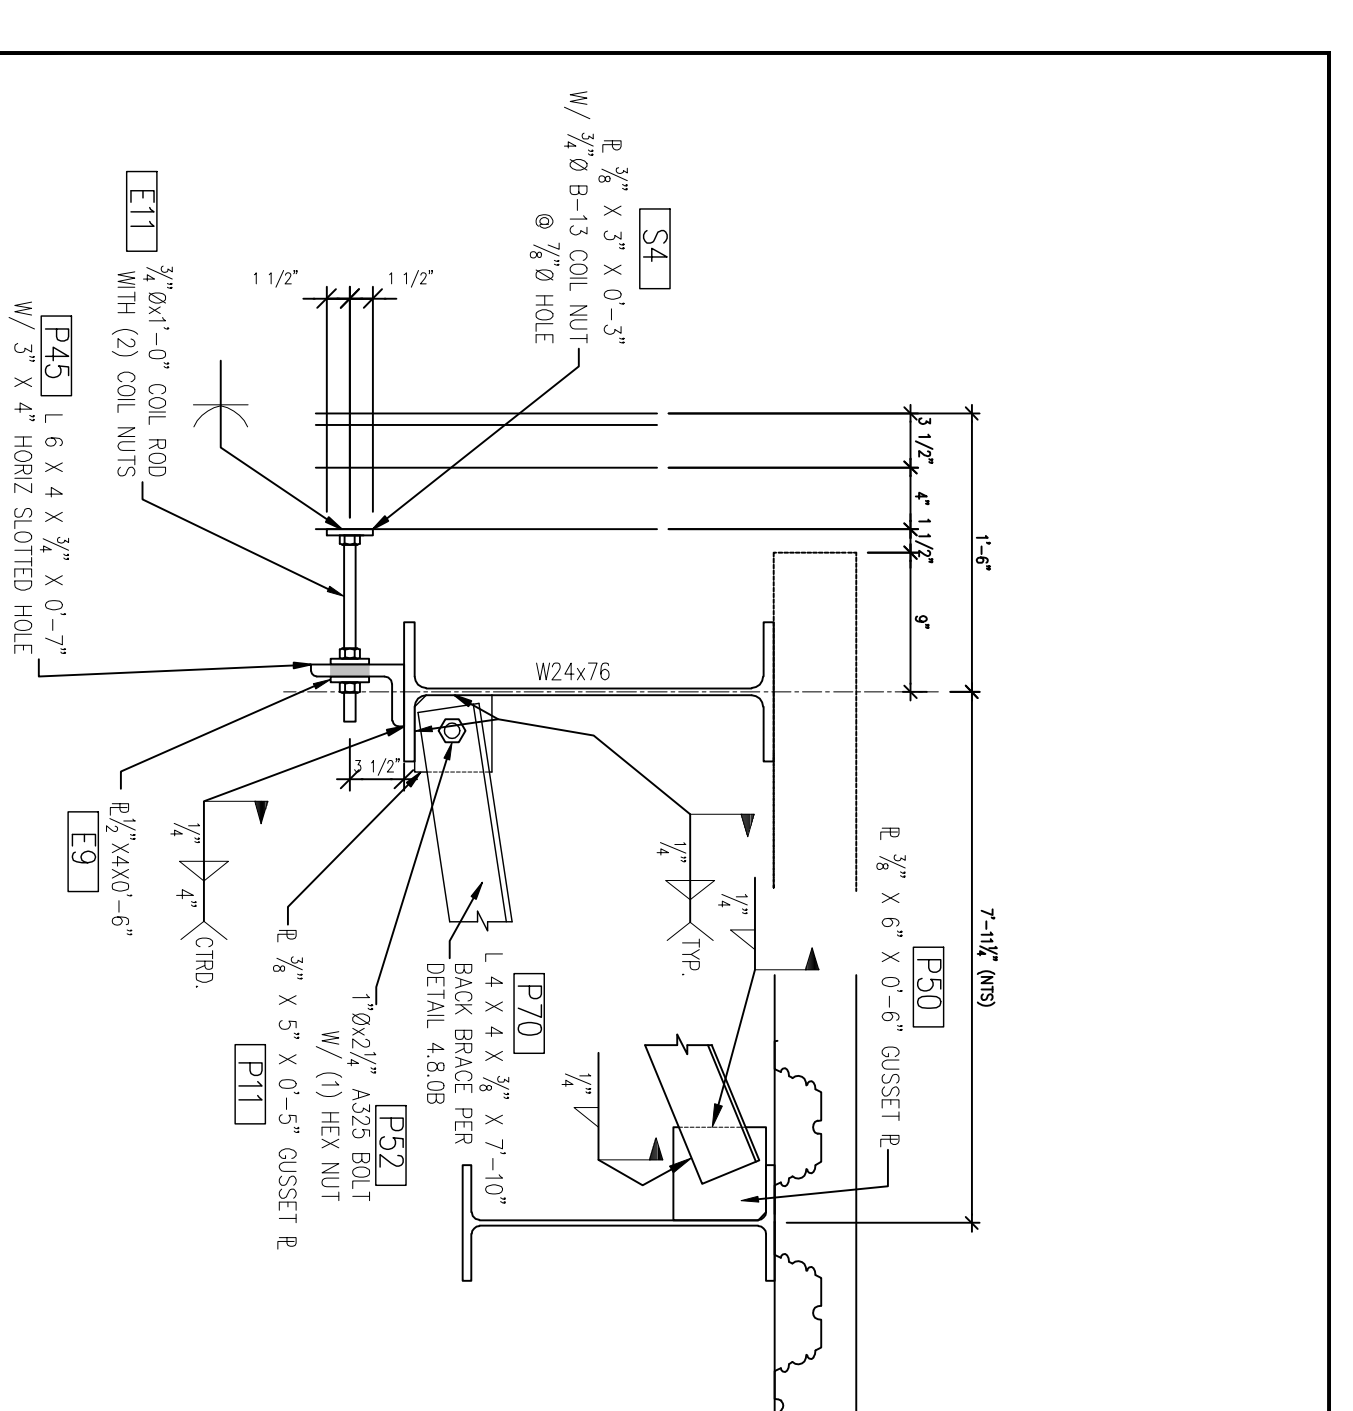


WILIS CONSTRUCTION CO. INC.
PRE-CAST CONCRETE PRODUCTS
 2201 SAN JUAN AVENUE • SAN JUAN BATISTIA, CA 95045
 (925) 423-2900 • FAX (925) 423-2948

JOB NAME:	Skyline Bldg. 4N	JOB NO.	858
PROJECT:	M.A.	DATE:	
CONNECTION:	CONNECTION	SCALE:	4:4.3

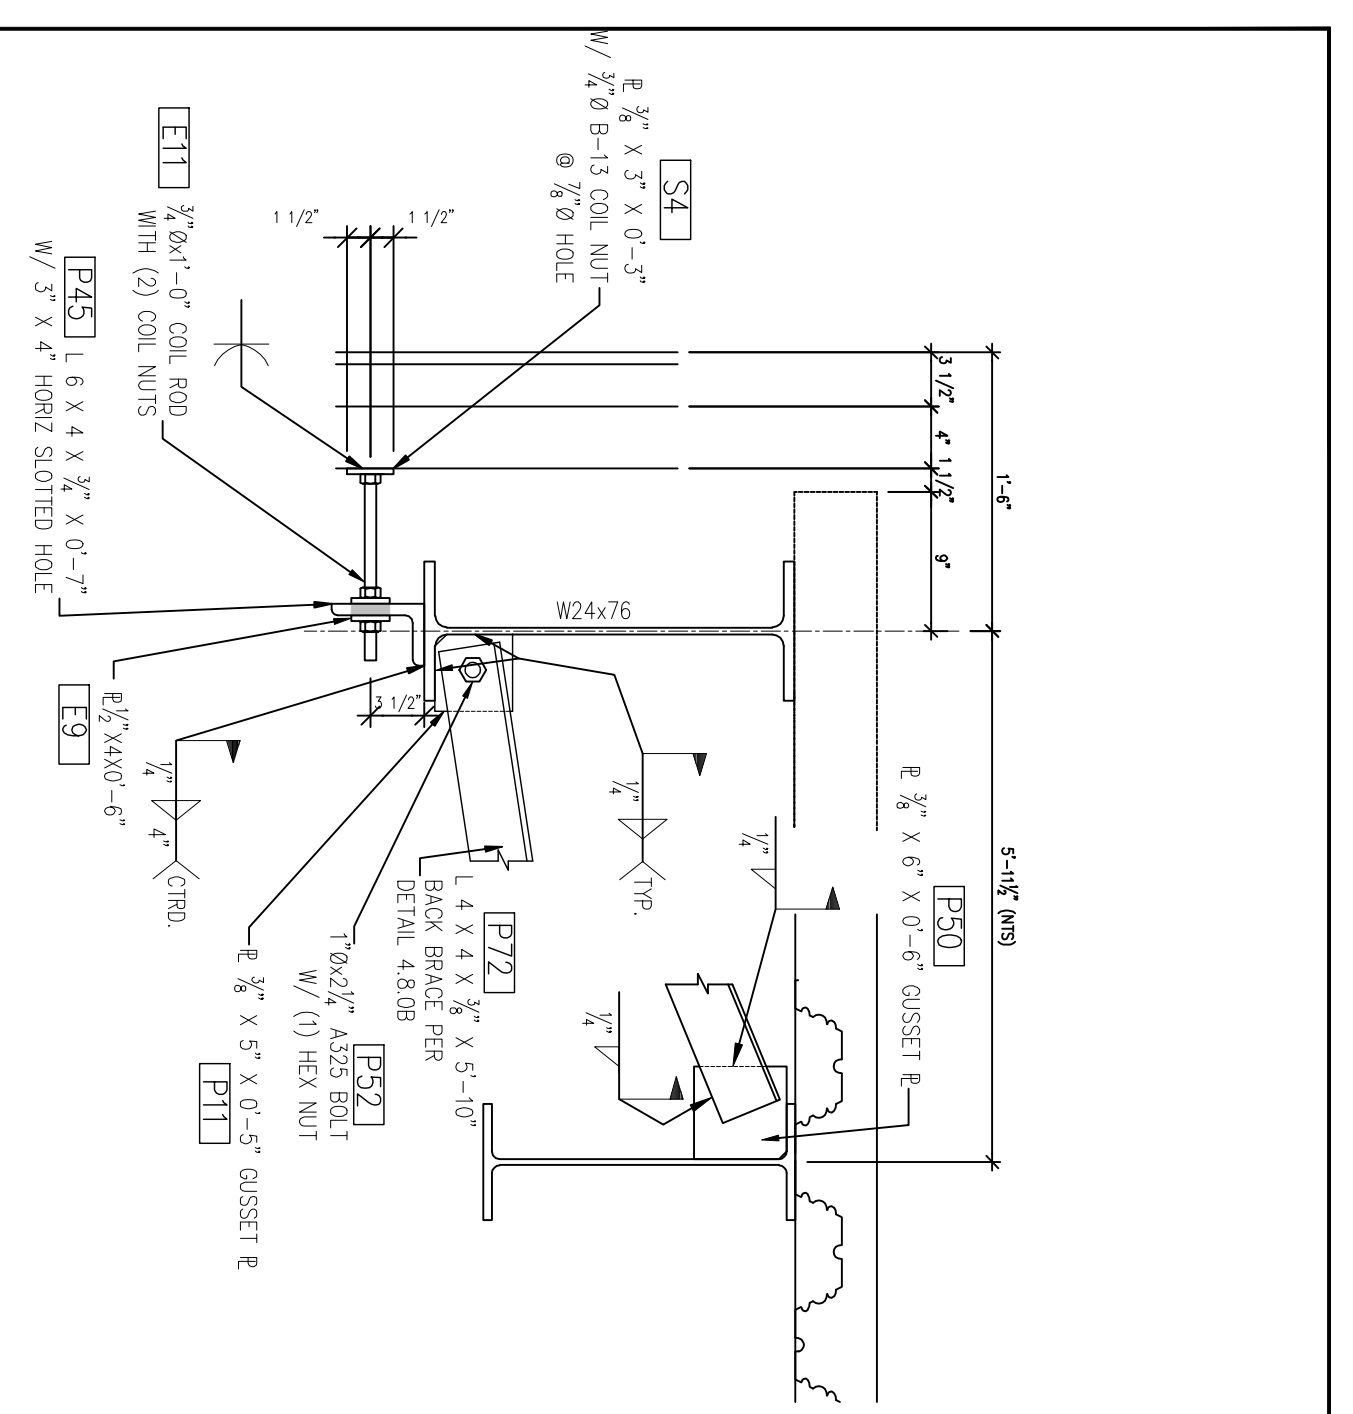


WILIS CONSTRUCTION CO. INC.
PRE-CAST CONCRETE PRODUCTS
 2201 SAN JUAN AVENUE • SAN JUAN BATISTIA, CA 95045
 (925) 423-2900 • FAX (925) 423-2948

JOB NAME:	Skyline Bldg. 4N	JOB NO.	858
PROJECT:	M.A.	DATE:	
CONNECTION:	CONNECTION	SCALE:	4:4.4

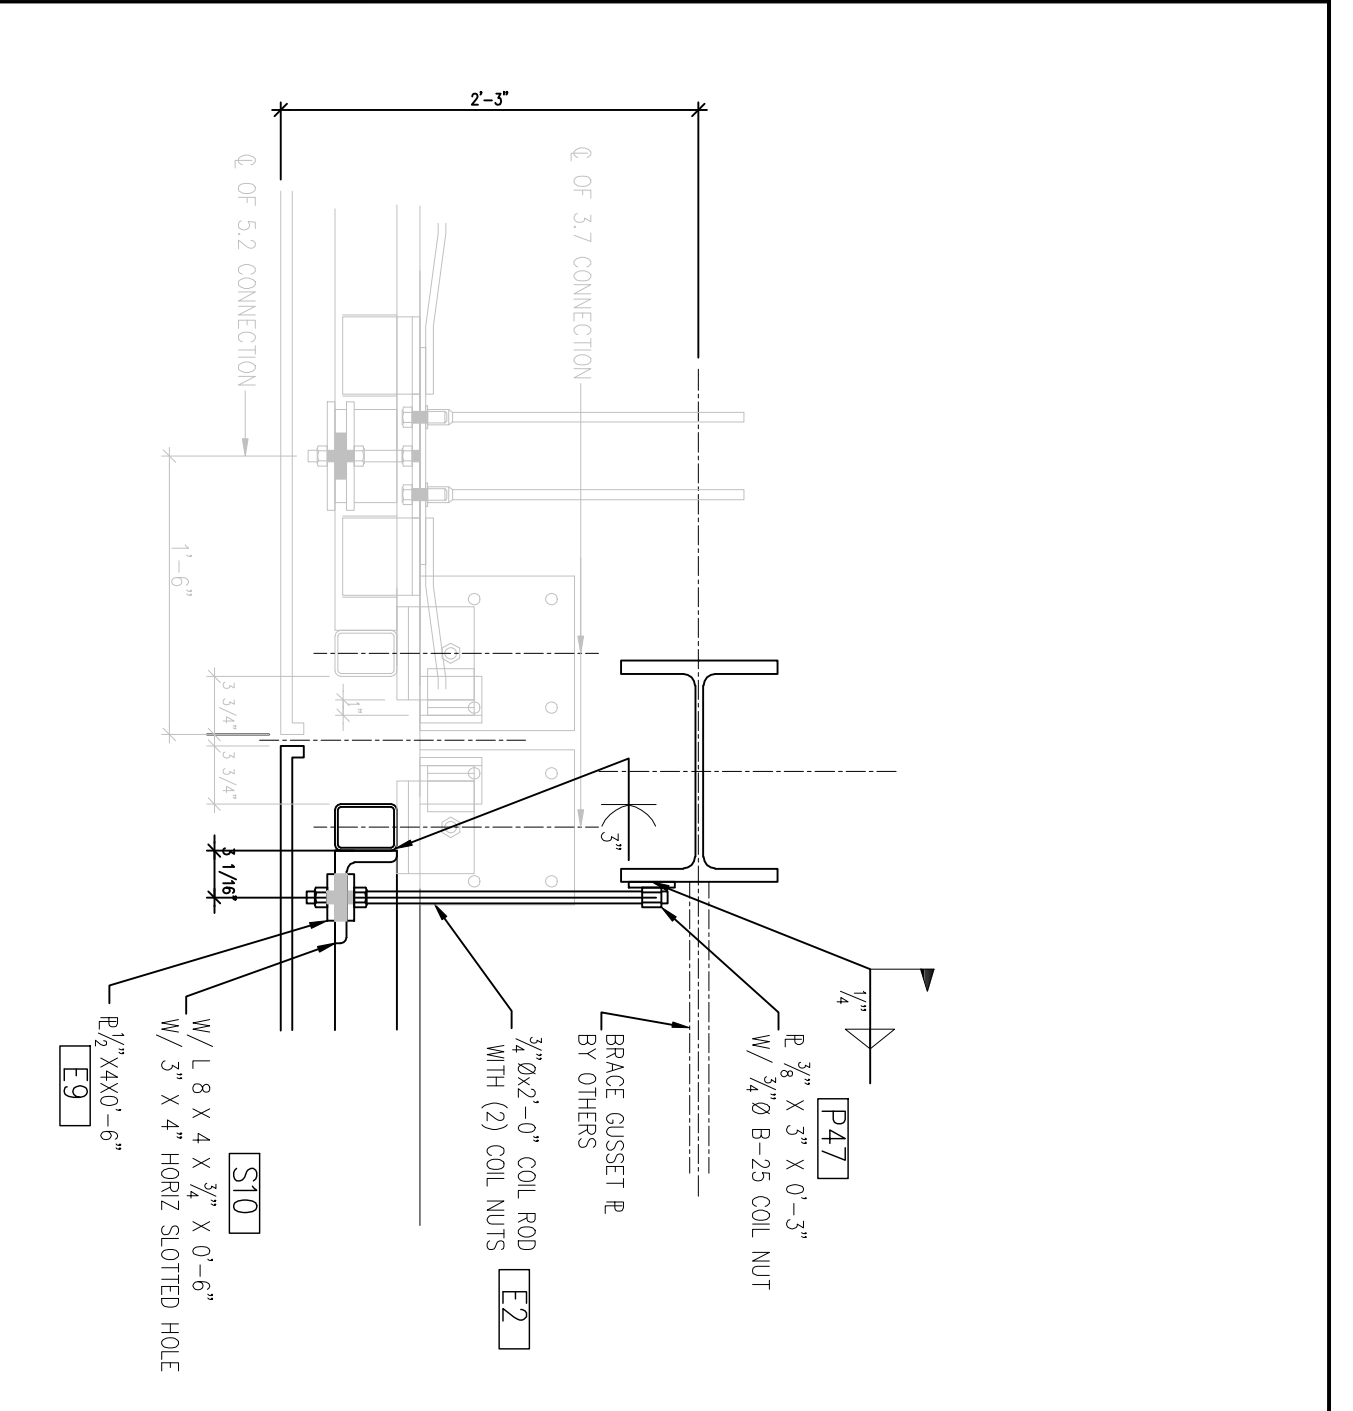

WILIS CONSTRUCTION CO. INC.
PRE-CAST CONCRETE PRODUCTS
 2201 SAN JUAN AVENUE • SAN JUAN BATISTIA, CA 95045
 (925) 423-2900 • FAX (925) 423-2948

JOB NAME:	Skyline Bldg. 4N	JOB NO.	858
PROJECT:	M.A.	DATE:	
CONNECTION:	CONNECTION	SCALE:	4:5.0

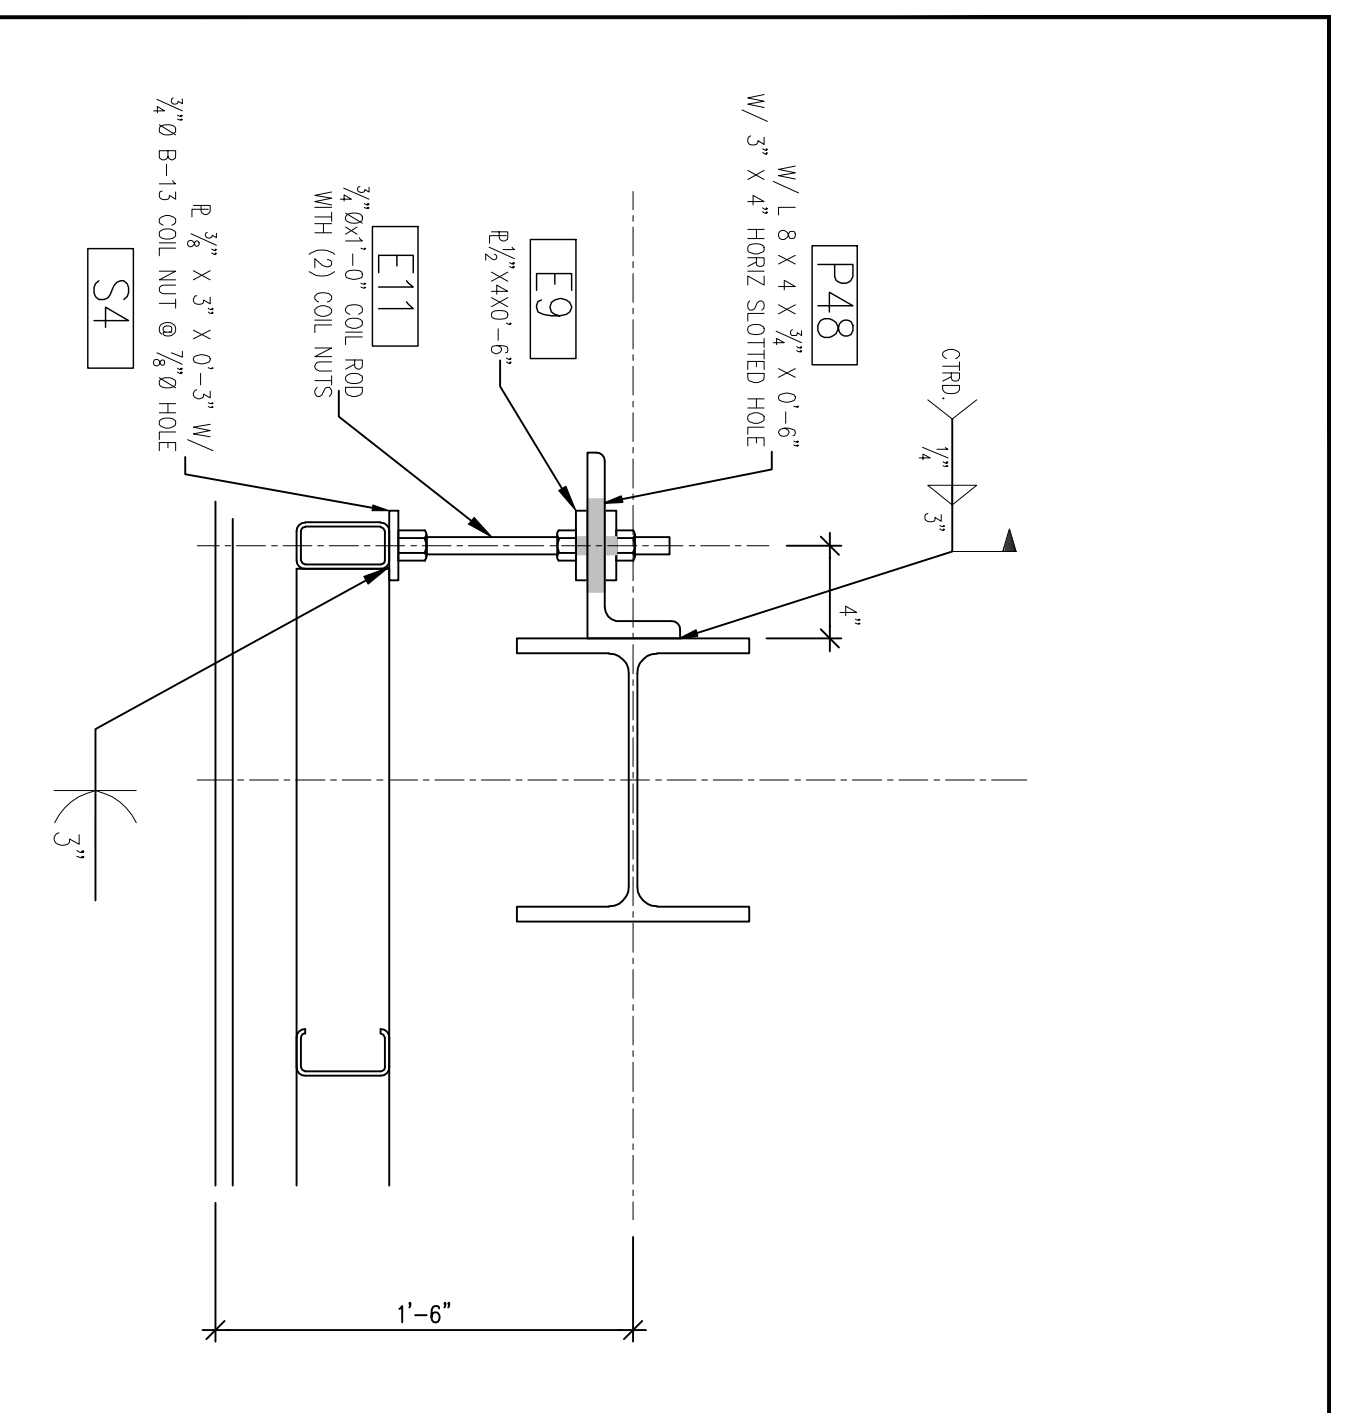

WILIS CONSTRUCTION CO. INC.
PRE-CAST CONCRETE PRODUCTS
 2201 SAN JUAN AVENUE • SAN JUAN BATISTIA, CA 95045
 (925) 423-2900 • FAX (925) 423-2948

JOB NAME:	Skyline Bldg. 4N	JOB NO.	858
PROJECT:	M.A.	DATE:	
CONNECTION:	CONNECTION	SCALE:	4:6.0

DIVISION OF THE
 STATE ARCHITECT
 APPL # 01-110117
 FILE # A-10-1
 AG _____ RS _____
 SSS _____ DME _____
 IDENTIFICATION
 STAMP



SKYLINE COLLEGE
 SAN JUAN COUNTY
 COMMUNITY COLLEGE
 DESIGN
CIP2 DESIGN-BUILD
PROJECT BUILDING 4
INCREMENT 2

AS BUILT DRAWINGS
JANUARY 12, 2011

PC-838