


SHEET NOTES

- 81 MODIFY (E) METAL GUARDRAIL (SEE DET. 8/110.21). EXTEND FRAME AND MESH FABRIC TO LEAVE LESS THAN 4" OPEN SPACE TO WALLS/FLOOR SLAB.
- 82 ACCESSIBLE ENTRANCE SIGN (SEE FINISH/SIGNAGE PLANS)




architecture
planning
interiors

Bunton Clifford Associates, Inc.
210 Hammond Ave.
Fremont, California 94539
[T] 510.445.1000
[F] 510.445.1005
www.BCAincOnline.com

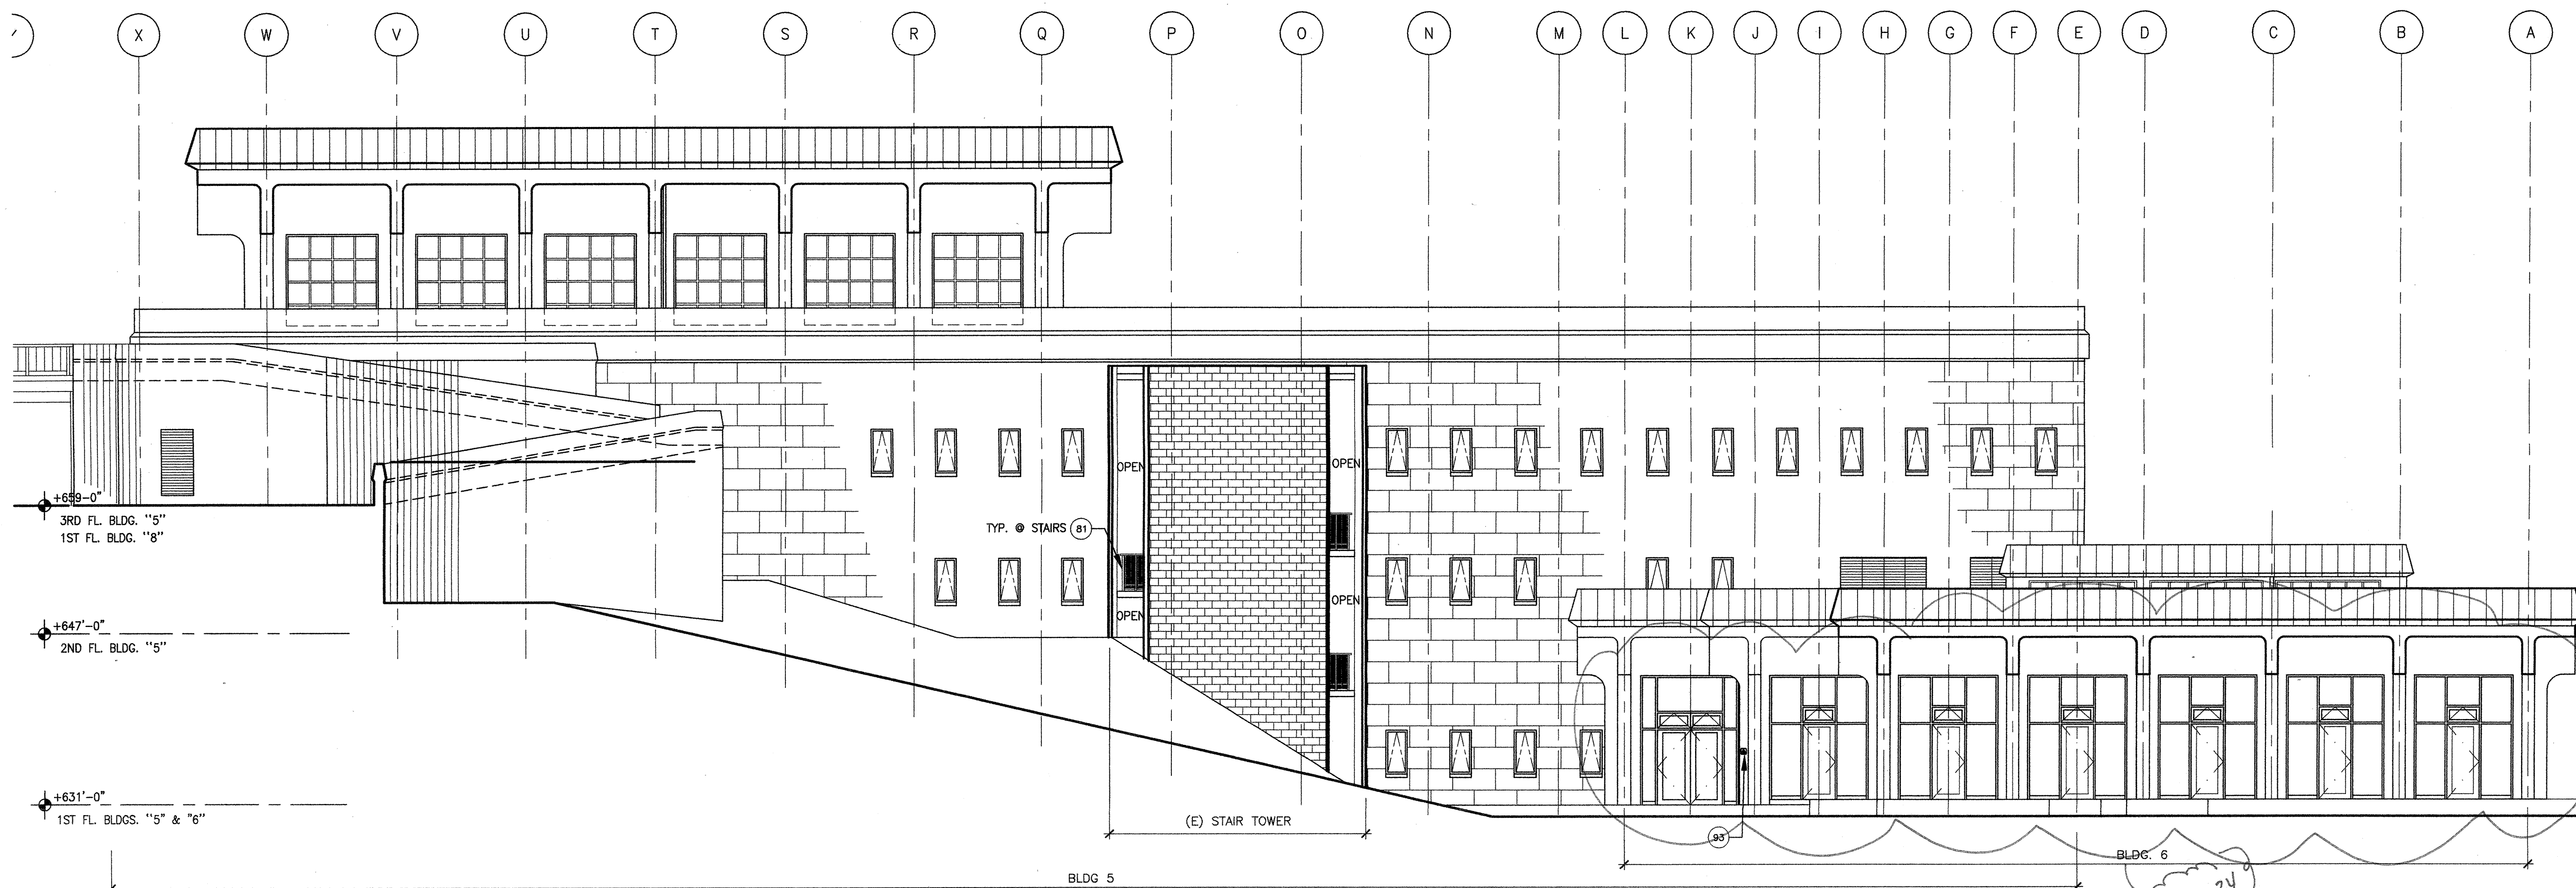


NORTH ELEVATION 1

SCALE 1/8" = 1'-0"

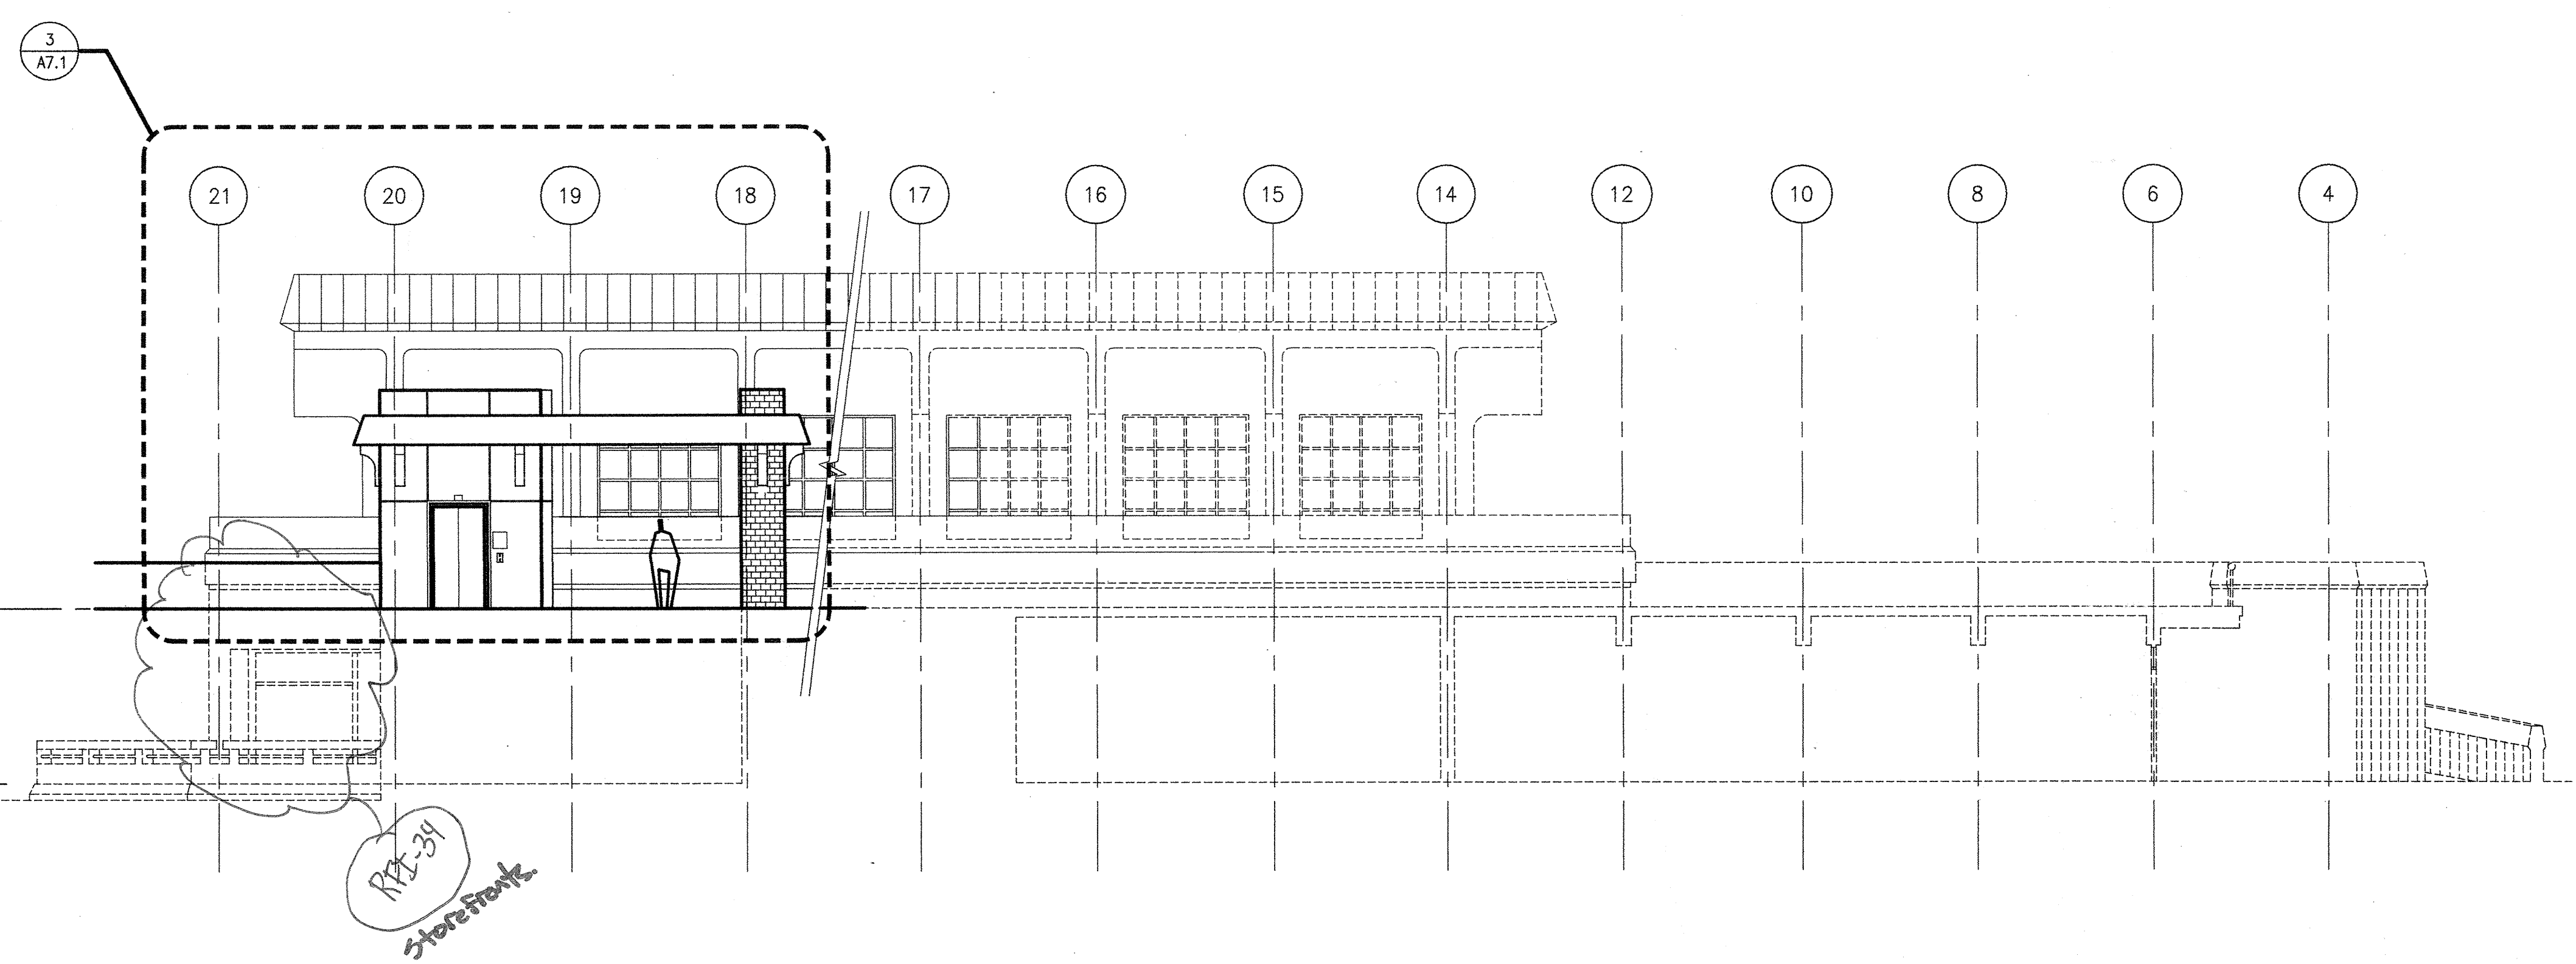

EAST ELEVATION 2


SCALE 1/8" = 1'-0"

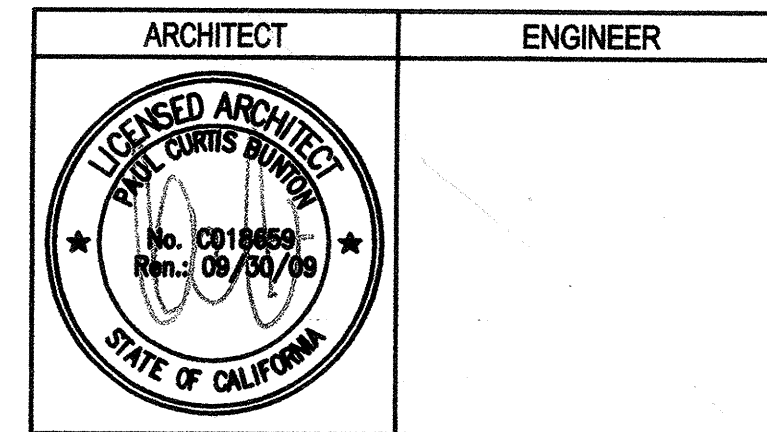

- GENERAL NOTES
1. This sheet is part of a set and is not to be used alone.
 2. This sheet is not to be used for construction unless the architect's stamp and signature appear on the drawings and the status box indicates drawings have been released for construction.
 3. These plans and prints hereof, as instruments of service, are owned by the architect and are for use on this project only. Reproduction and/or distribution without the prior written consent of the architect is forbidden.
 4. Copyright Bunton Clifford Associates, 2007

REVISION HISTORY	REMARKS	DATE

DRAWING STATUS	DATE
● DSA PLAN CHECK	08/29/08
● DSA BACK CHECK	11/22/08
○ BIDDING	
○ CONSTRUCTION	

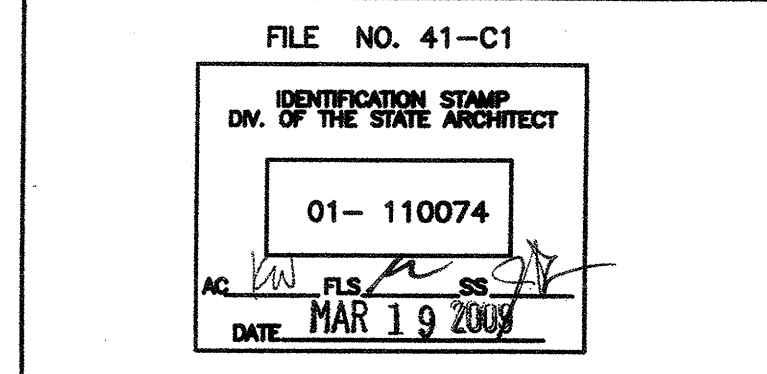

GENERAL NOTES

LEGEND

BUILDINGS 5 & 6 RENOVATIONS

San Mateo County Community College District

DSA SUBMITTAL

CAÑADA COLLEGE
4200 Farm Hill Boulevard
Redwood City, CA 94061

EXTERIOR ELEVATIONS

Date: 08/29/08
Scale: AS NOTED
Project Number: 07013
Drawing Number: **A5.1**