

REVISIONS	DATE

DRAWING STATUS	DATE
<input type="radio"/> DSA PLAN CHECK	
<input type="radio"/> DSA BACK CHECK	
<input type="radio"/> BIDDING (BID PRESENT)	
<input type="radio"/> CONSTRUCTION	

FILE NO. 41-C1
IDENTIFICATION STAMP
DIV. OF THE STATE ARCHITECT
01-110074
DATE MAR 19 2009

BUILDINGS 5 & 6 RENOVATIONS


San Mateo County Community College District

DSA BACK-CHECK

CAÑADA COLLEGE
4200 Farm Hill Boulevard
Redwood City, CA 94061

MECHANICAL PIPING
DIAGRAMS

Date	01/22/09	Drawing Number	M3.2
Scale	AS NOTED	Project Number	07013

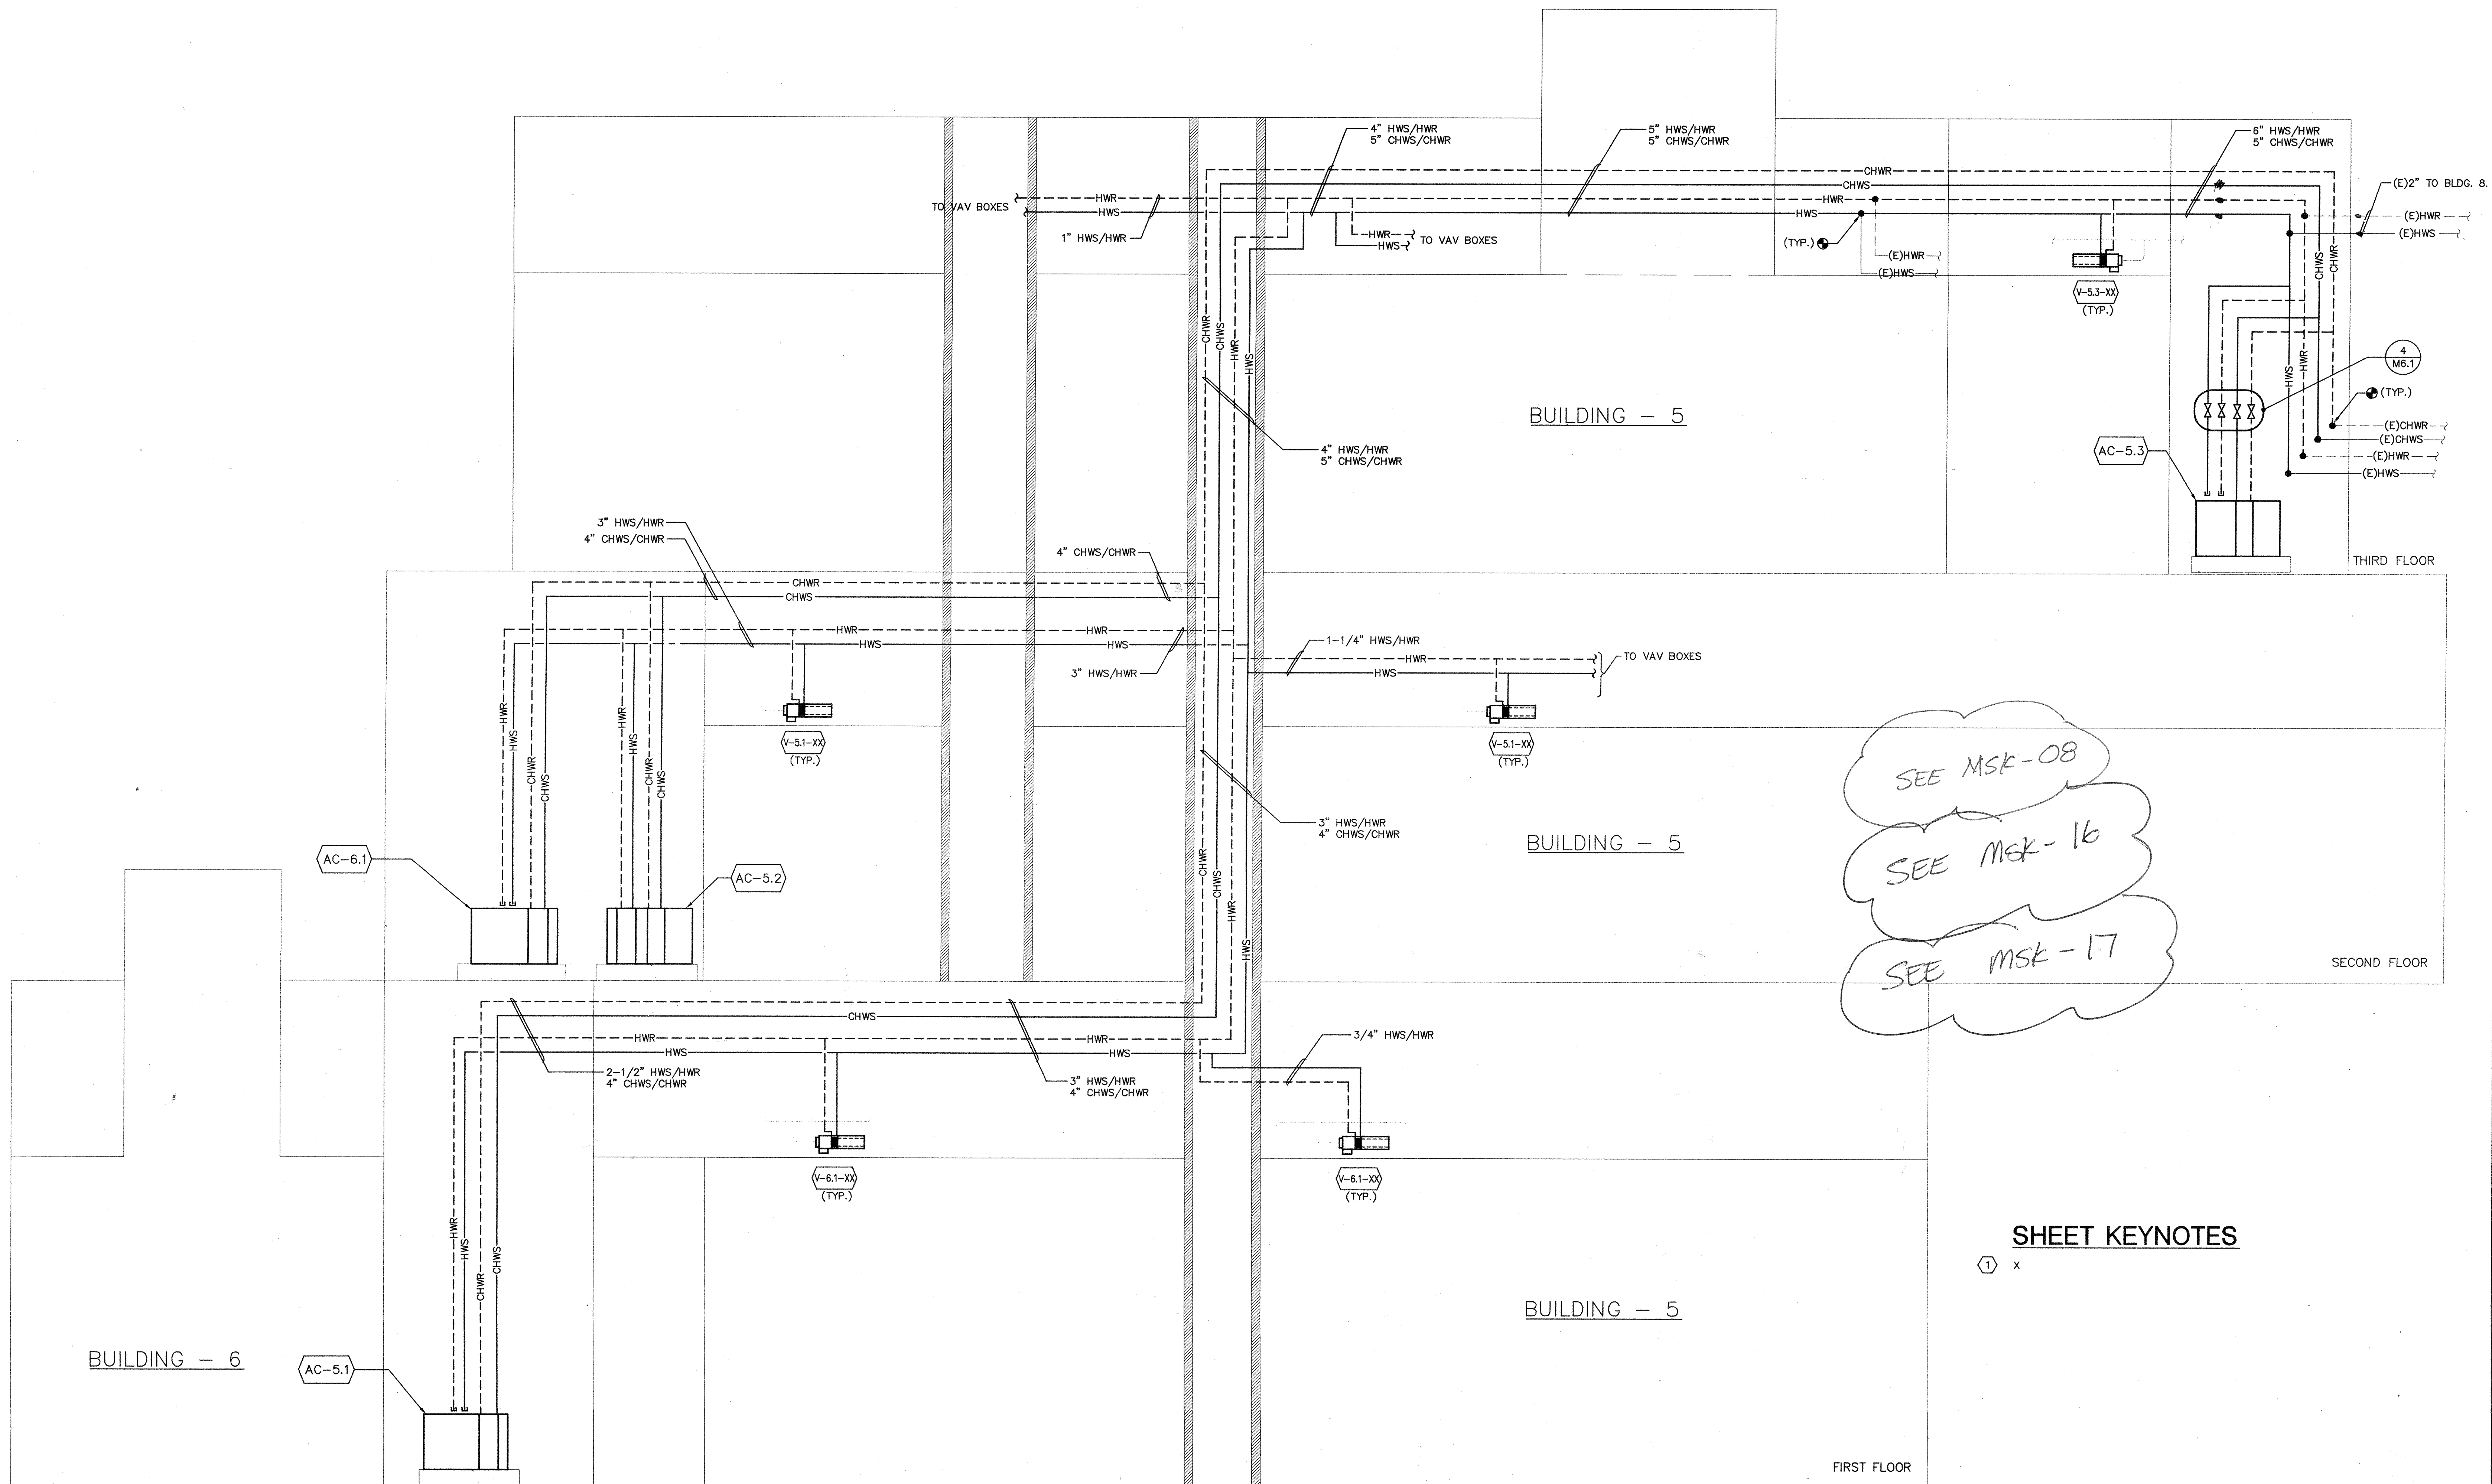

1 PIPING RISER DIAGRAM
NO SCALE