


NOTES:  
 1. ACCESSIBLE PATH OF TRAVEL AS INDICATED ON PLAN IS A BARRIER FREE ACCESS ROUTE WITHOUT ANY ABRUPT LEVEL CHANGES EXCEEDING 1/2" BEYOND A 1:2 MAX SLOPE, OR AT LEAST 48" WIDE SURFACE IS SLP RESISTANCE STABLE FIRM AND SMOOTH, CROSS SLOPE DOES NOT EXCEED 2% AND SLOPE OTHERWISE INDICATED.  
 2. CONTRACTOR TO VERIFY THAT ALL BARRIERS IN THE 24TH OF THIS PROJECT AND PATH OF TRAVEL COMPLES WITH OBC 11338.

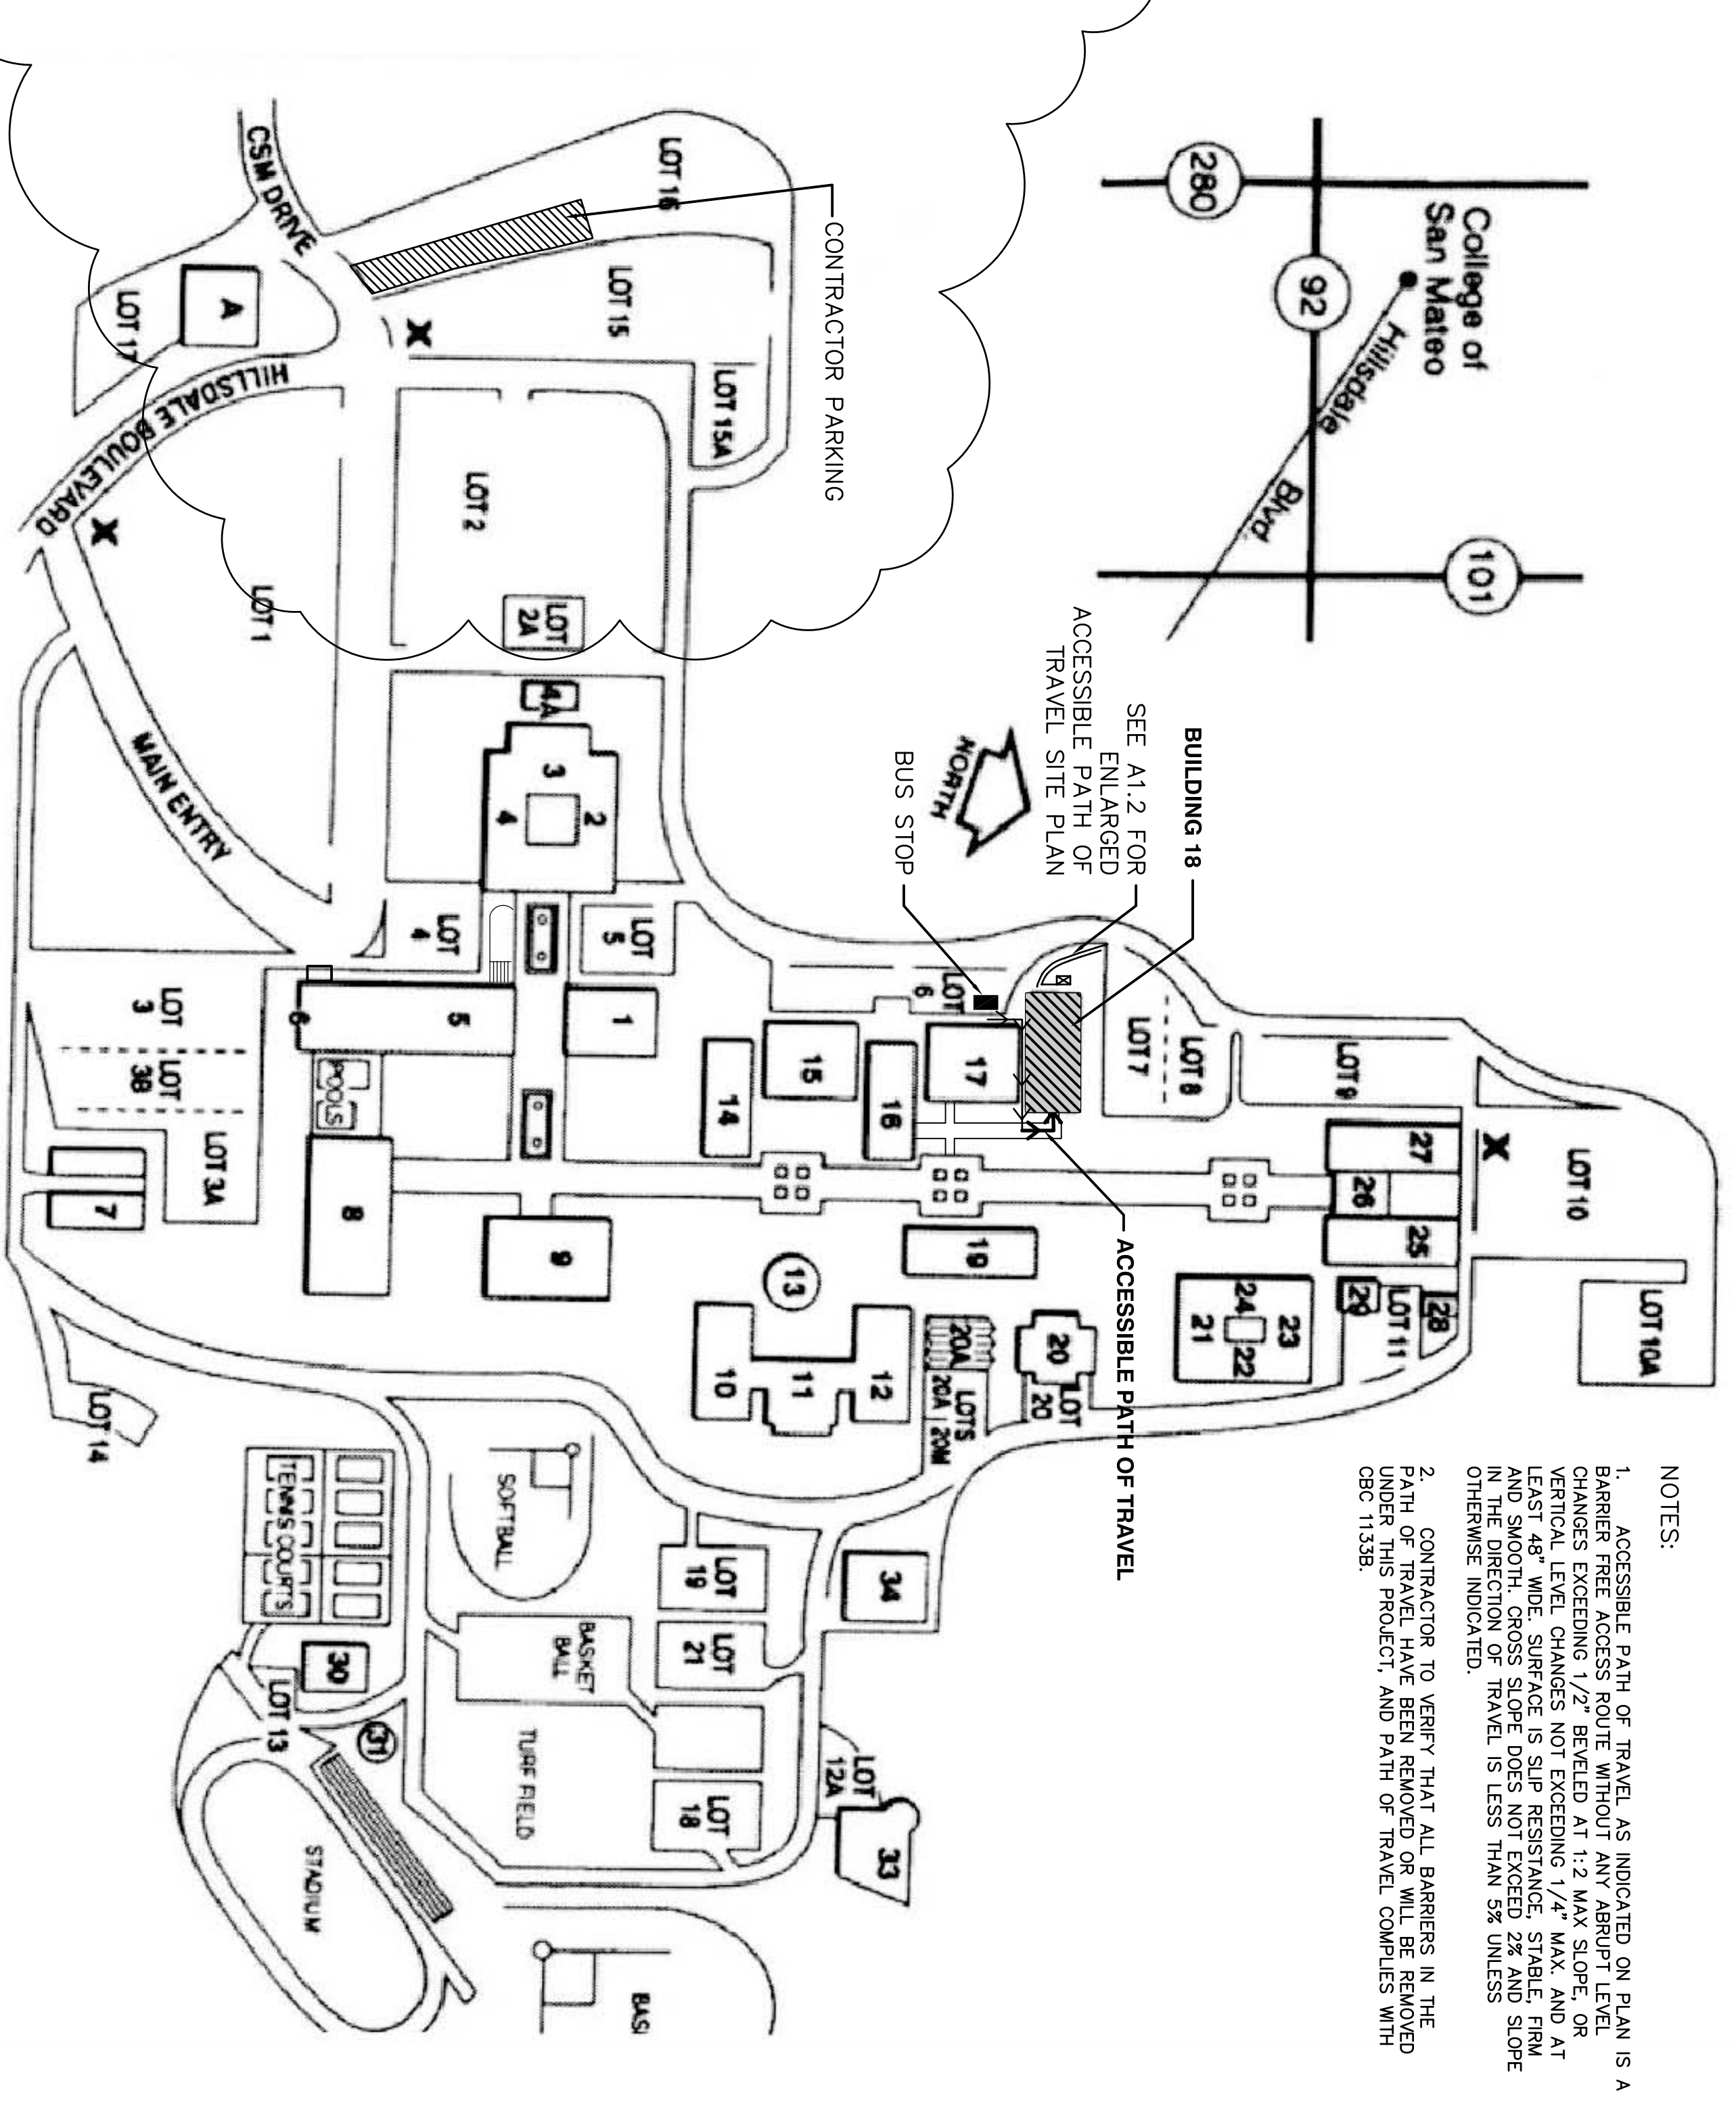

17L (E) ACCESSIBLE PATH OF TRAVEL  
SCALE AS NOTED

**OCCUPANT LOAD**

ROOM NO.	NAME	AREA SQT.	OCCUPANT LOAD FACTOR	NO. OF OCCUPANTS PROVIDED
76	RECEPTION CENTER	50	20	1000
77	OFFICE	100	20	2000
78	OFFICE	100	20	2000

- ACCESSIBLE PARKING NOTES:**
- BUILDING 18 IS SERVED BY THREE ADJACENT PARKING LOTS - 6, 7, AND 8, WITH A TOTAL OF 180 SPACES.
  - 180 SPACES REQUIRE 6 ACCESSIBLE SPACES.
  - OF THE 6 REQUIRED SPACES, 3 SPACES INCLUDING ONE VAN SPACE, ARE PROVIDED IN AN ADJACENT LOT AND UPGRADED FOR FULL COMPLIANCE IN THIS PROJECT SCOPE OF WORK.
  - FOUR ADDITIONAL SPACES ARE EXISTING IN PARKING LOT 6.
  - NO STUDENTS OCCUPANCY IN BUILDING WHILE FENCING IN PLACE.

**PLUMBING FIXTURES REQUIREMENTS**

TYPE OF BUILDING OR OCCUPANCY	WC FIXTURES PER PERSON	URINALS PER PERSON	LAVATORIES PER PERSON
SCHOOLS - FOR STUDENT USE	1/100	1/100	1/100
OFFICE	1/100	1/100	1/100
RETAIL	1/100	1/100	1/100
RESTAURANT	1/100	1/100	1/100
THEATER	1/100	1/100	1/100
CONVENTION CENTER	1/100	1/100	1/100
RECREATION CENTER	1/100	1/100	1/100
INDUSTRIAL	1/100	1/100	1/100
LABORATORY	1/100	1/100	1/100
WATER TREATMENT PLANT	1/100	1/100	1/100
WATER SUPPLY PLANT	1/100	1/100	1/100
WATER TOWER	1/100	1/100	1/100
WATER PUMP HOUSE	1/100	1/100	1/100
WATER STORAGE TANK	1/100	1/100	1/100
WATER DISTRIBUTION SYSTEM	1/100	1/100	1/100
WATER TREATMENT PLANT	1/100	1/100	1/100
WATER SUPPLY PLANT	1/100	1/100	1/100
WATER TOWER	1/100	1/100	1/100
WATER PUMP HOUSE	1/100	1/100	1/100
WATER STORAGE TANK	1/100	1/100	1/100
WATER DISTRIBUTION SYSTEM	1/100	1/100	1/100

**ACCESSORY USE AREAS INCLUDING CORRIDORS, TRUNK ROOMS, VESTIBULE STORAGE, MEN, MEN, SHOWERS, HUBBERS AND VAN LIFT AND STORAGE.**

**NOTE:** COMPANIES SHOWING ARE LESS THAN ALLOWABLE UNDER TABLE 101-A & 101-B, SO THE TOTAL OCCUPANT LOAD FROM EACH FLOOR WILL NOT EXCEED THAT ALLOWED BY THE TABLE. MAXIMUM OCCUPANCY SHALL BE POSTED. **NOTE:** ONE TABLE 4-1 WORTH FOR EACH PERSON ADDED IN EXCESS OF MIN. REQUIRE. ONE WATER CLOSET SHALL BE PROVIDED. **NOTE:** WATER CLOSET SHALL BE SUBSTITUTED BY 3 ADDITIONAL SINKS, AS REQUIRED BY O.C.

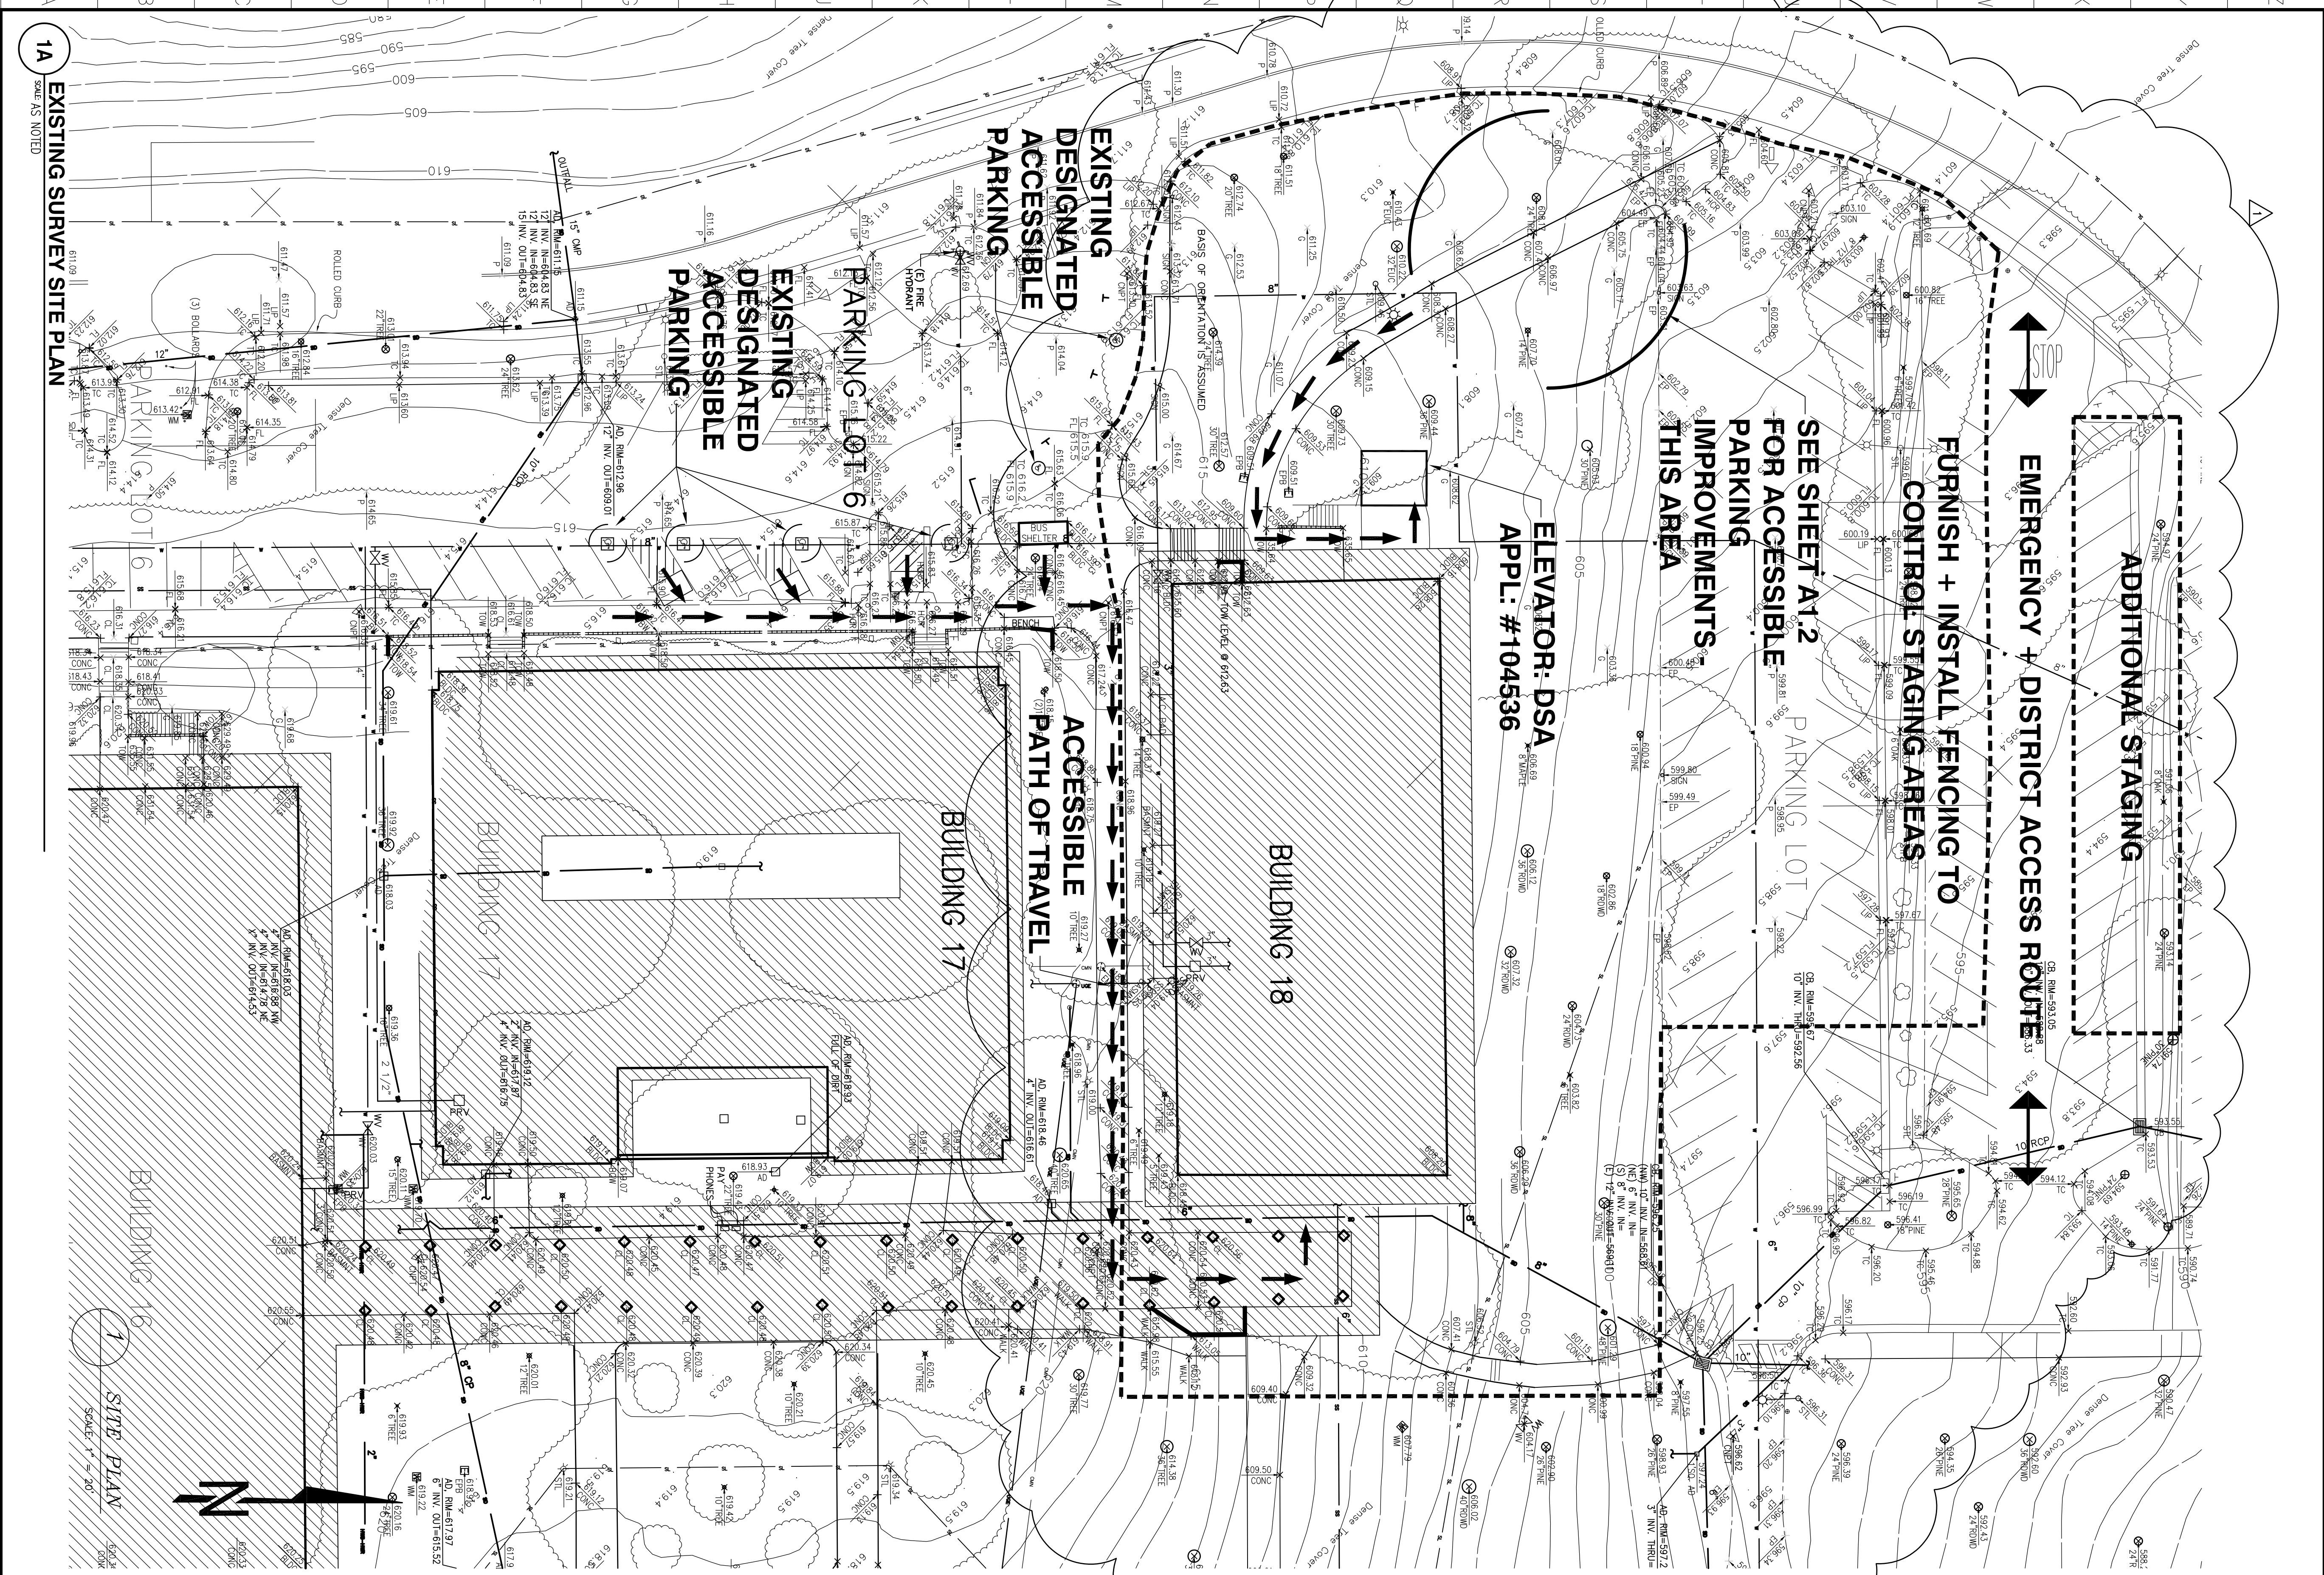

1A EXISTING SURVEY SITE PLAN  
SCALE AS NOTED

**PARKING LOT 7 TO BUILDING 18 AREA TOPOGRAPHIC SURVEY**  
 SAN MATEO CALIFORNIA

**College Of San Mateo**  
 1700 Hillsdale Boulevard  
 San Mateo, CA 94402

**SANDIS HUMBER JONES**  
 CIVIL ENGINEERS SURVEYORS PLANNERS

1700 Broadway, Suite 200, San Mateo, CA 94402 (415) 873-8866 (415) 873-8868

**INTERACTIVE**  
 ARCHITECTURE • PLANNING • ENGINEERING

117 PARK PLACE  
 POINT RICHMOND  
 CALIFORNIA 94801  
 (910) 238-7435  
 (FAX) 232-5325  
 http://www.interac.com

**BUILDING NO. 18 (NORTH HALL) MODERNIZATION**

**SAN MATEO CO. COMMUNITY COLLEGE DISTRICT**

**DR. SANDIS HUMBER JONES**  
 OFFICE OF RESOLUTION SERVICES  
 APPL 106047  
 DATE: 11-13-10

**DR. SANDIS HUMBER JONES**  
 APPROVED  
 APPL 106047  
 DATE: 11-13-10

**EXISTING SURVEY SITE PLAN AND ACCESSIBLE PATH OF TRAVEL**

**MOD A1.1**

REVISION	DESCRIPTION	INITIAL	DATE
ADDENDUM	K18 4/1/04		
PRE-APPLICATION REVIEW	02/26/04		
ISSUED FOR PLAN CHECK	03/03/04		
ISSUED FOR PERMIT	03/03/04		
ISSUED FOR CONSTRUCTION			