

10. SENSOR WIRE FROM CONTROLLER TO VALVE BOX IS TO BE INSTALLED IN A

1.5" SCHEDULE 80 PVC CONDUIT WITH PULL BOXES AT 200' OR LESS..

THE CONTRACTOR SHALL INSTALL FLOW SENSOR TO ALLOW STRAIGHT-FLOW

(X) SIDE AND FIVE TIMES THE DIAMETER OF MAINLINE PIPE ON THE OUTLET


(Y) SIDE OF THE SENSOR. REFER TO DATA INDUSTRIAL INSTALLATION


FLOW SENSOR


CALE: NONE ET: FL_SENSOR_DAT

RECOMMENDATIONS.

OF A MINIMUM OF TEN TIMES THE DIAMETER OF MAINLINE PIPE ON THE INLET

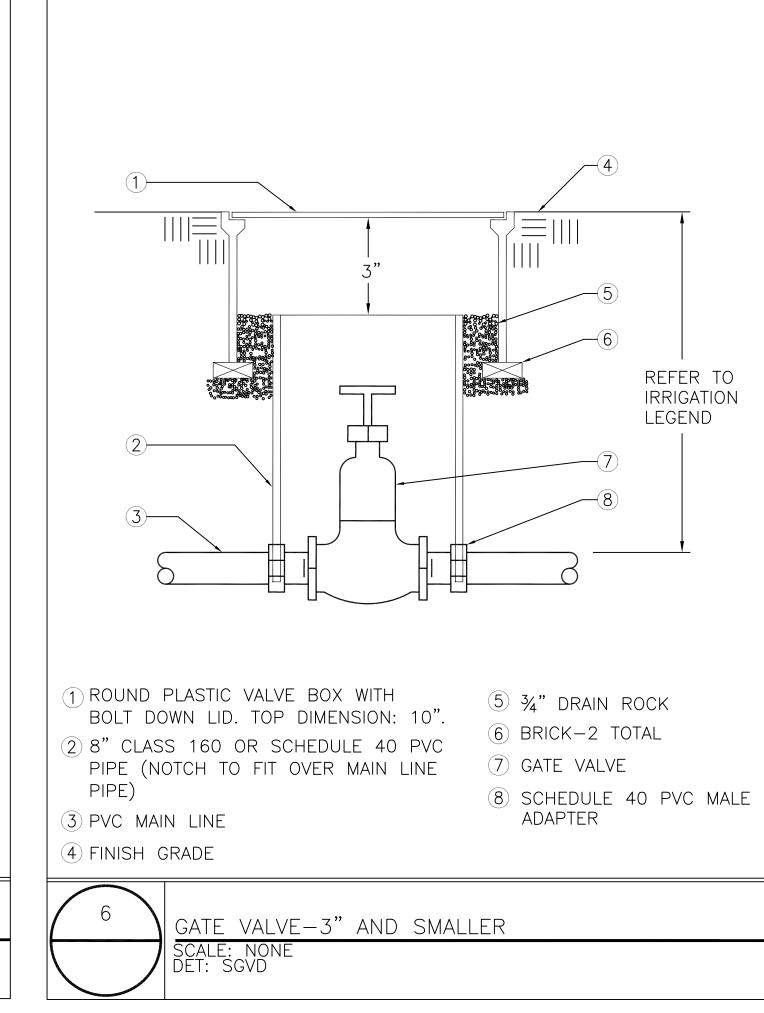

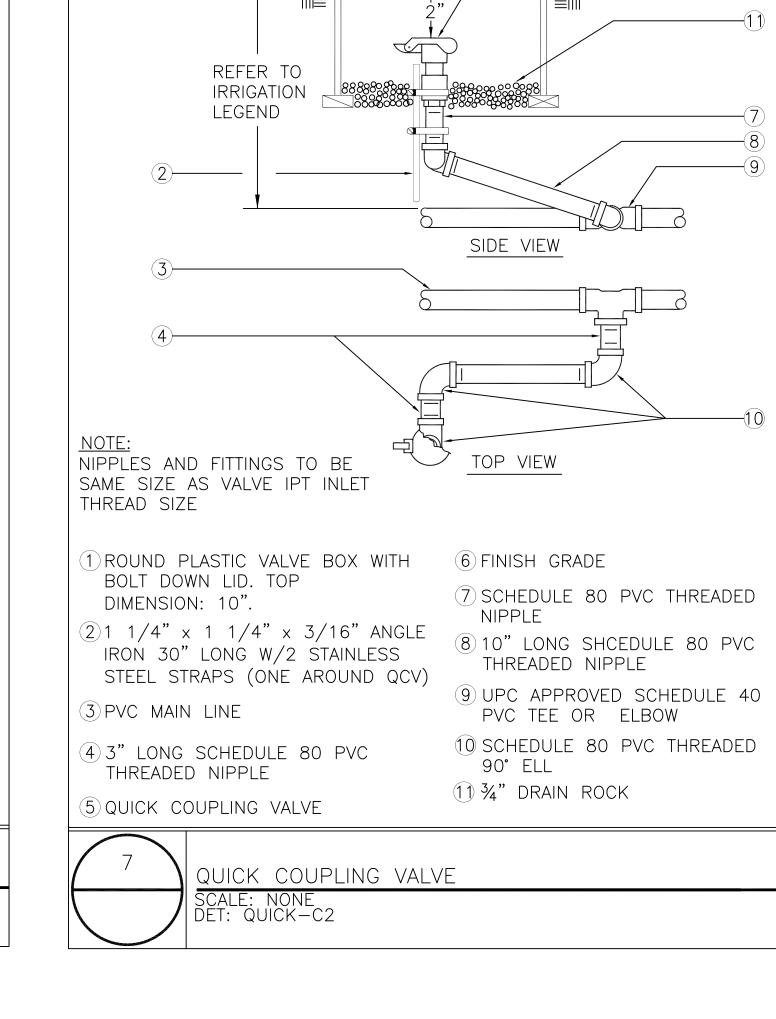

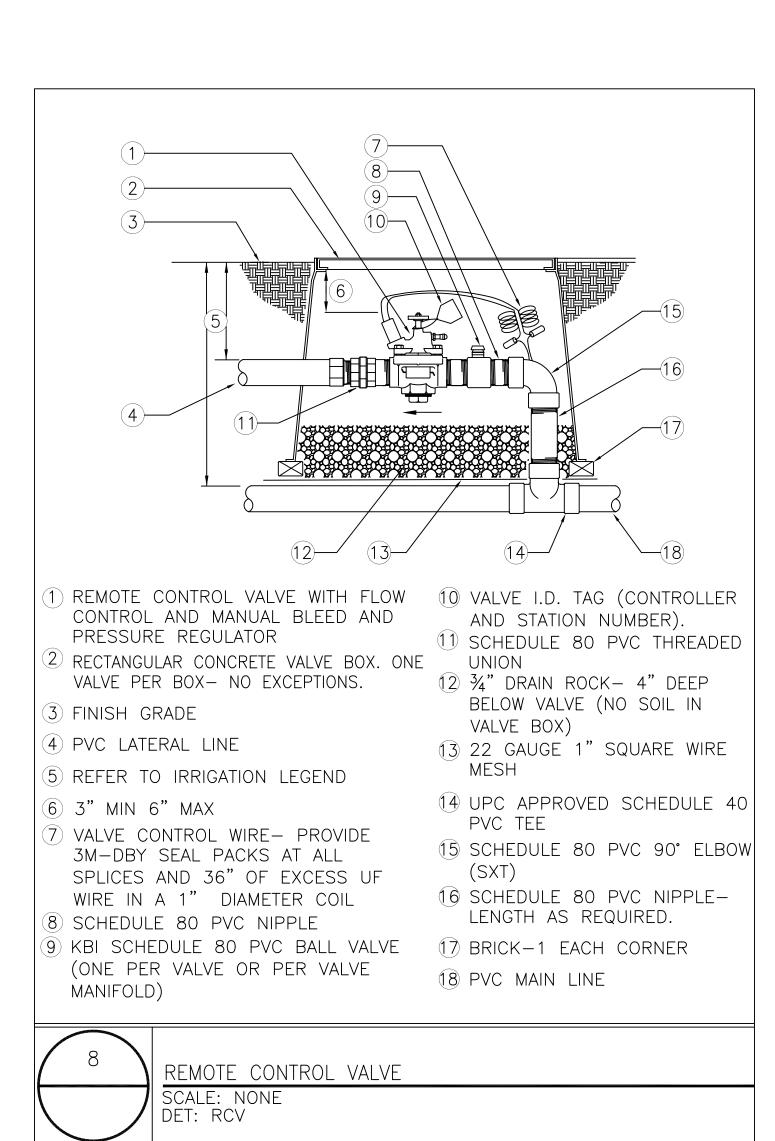

Irrigation Consultant:
Russell D. Mitchell Associates, Inc.

2760 Camino Diablo
Walnut Creek, CA 94597

Phone (925) 939–3985
Fax (925) 932–5671

Email:
RMA©RMAIRRIGATION.COM

FEBRUARY 2012 RECORD DRAWING NOTE: THESE AS-BUILT RECORD DRAWINGS HAVE BEEN PREPARED BASED ON INFORMATION PROVIDED BY THE GENERAL CONTRACTOR / OTHERS. LPA AND ITS CONSULTANTS HAVE NOT VERIFIED THE ACCURACY AND/OR COMPLETENESS OF THIS INFORMATION

AND ARE NOT RESPONSIBLE FOR ANY ERRORS OR OMISSIONS THAT MAY BE INCORPORATED AS A RESULT. LPA DOES NOT ASSUME ANY RESPONSIBILTIY FOR THE FIELD MODIFICATIONS TO THE PLANS.

L5.05

DATE FEBRUARY 24, 2012

729 Heinz Avenue

510.649.8295

Architecture

Interior Design

Graphics

Landscape Architecture

1548 Eureka Road

P 916 | 772-4300

F 916 772-4330

E lpa@lpainc.com

W www.lpainc.com

Roseville, California 95661

and designs incorporated therein are instruments of service. All project documents are the registered property of LPA, INC. (LPA) and cannot be lawfully used in whole or in part for any

project or purpose except as described in the contractual agreement between Noll & Tam and the District. LPA hereby gives formal notice that any such project document use,

automatically binds all parties involved with misuse to fully

are not a representation of as-built or existing conditions

CALIFORNIA STATE FIRE MARSHAL

PPROVAL OF THIS PLAN DOES NOT AUTHORIZE OR APPROVE AN APPROVAL IS SUBJECT TO FIELD INSPECTION. ONE SET OF APPROVPLANS SHALL BE AVAILABLE ON THE PROJECT SITE AT ALL TIMES.

CSM

NORTH

GATEWAY

LOAD CENTER

& SITE WALL

1700

West Hillsdale Blvd

San Mateo, CA

94402

Signature

NO. 2188 RENEWAL 5-31-12

PROJECT

RECORD

DOCUMENT

IRRIGATION DETAILS

SHEET TITLE

REVISIONS

DRAWN KFRF CHECKED KS

SHEET NUMBER

SCALE NONE JOB NO. 28066.10

NO. DATE DESCRIPTION

fax 510.649.3008

Berkeley, CA 94710