

**SMCCCD
COLLEGE OF SAN MATEO
FINE ARTS COMPLEX
BUILDINGS 2 & 4
RENOVATIONS
INCREMENT 2**

344 CSM DRIVE
SAN MATEO, CA 94402

agency approvals
IDENTIFICATION STAMP
DIVISION OF THE STATE
ARCHITECT


APPL. No. 01-109243
AC: _____ FLS: _____ SS: _____
DATE: _____

date	description
03.13.2008	PRICING SET
05.08.2008	INCREMENT 2 DSA SUBMITTAL
10.14.2008	DSA RESPONSE
11.04.2010	RECORD DRAWINGS

sheet title
ELEVATIONS

project no. 2707.01

sheet no. **S2.3**

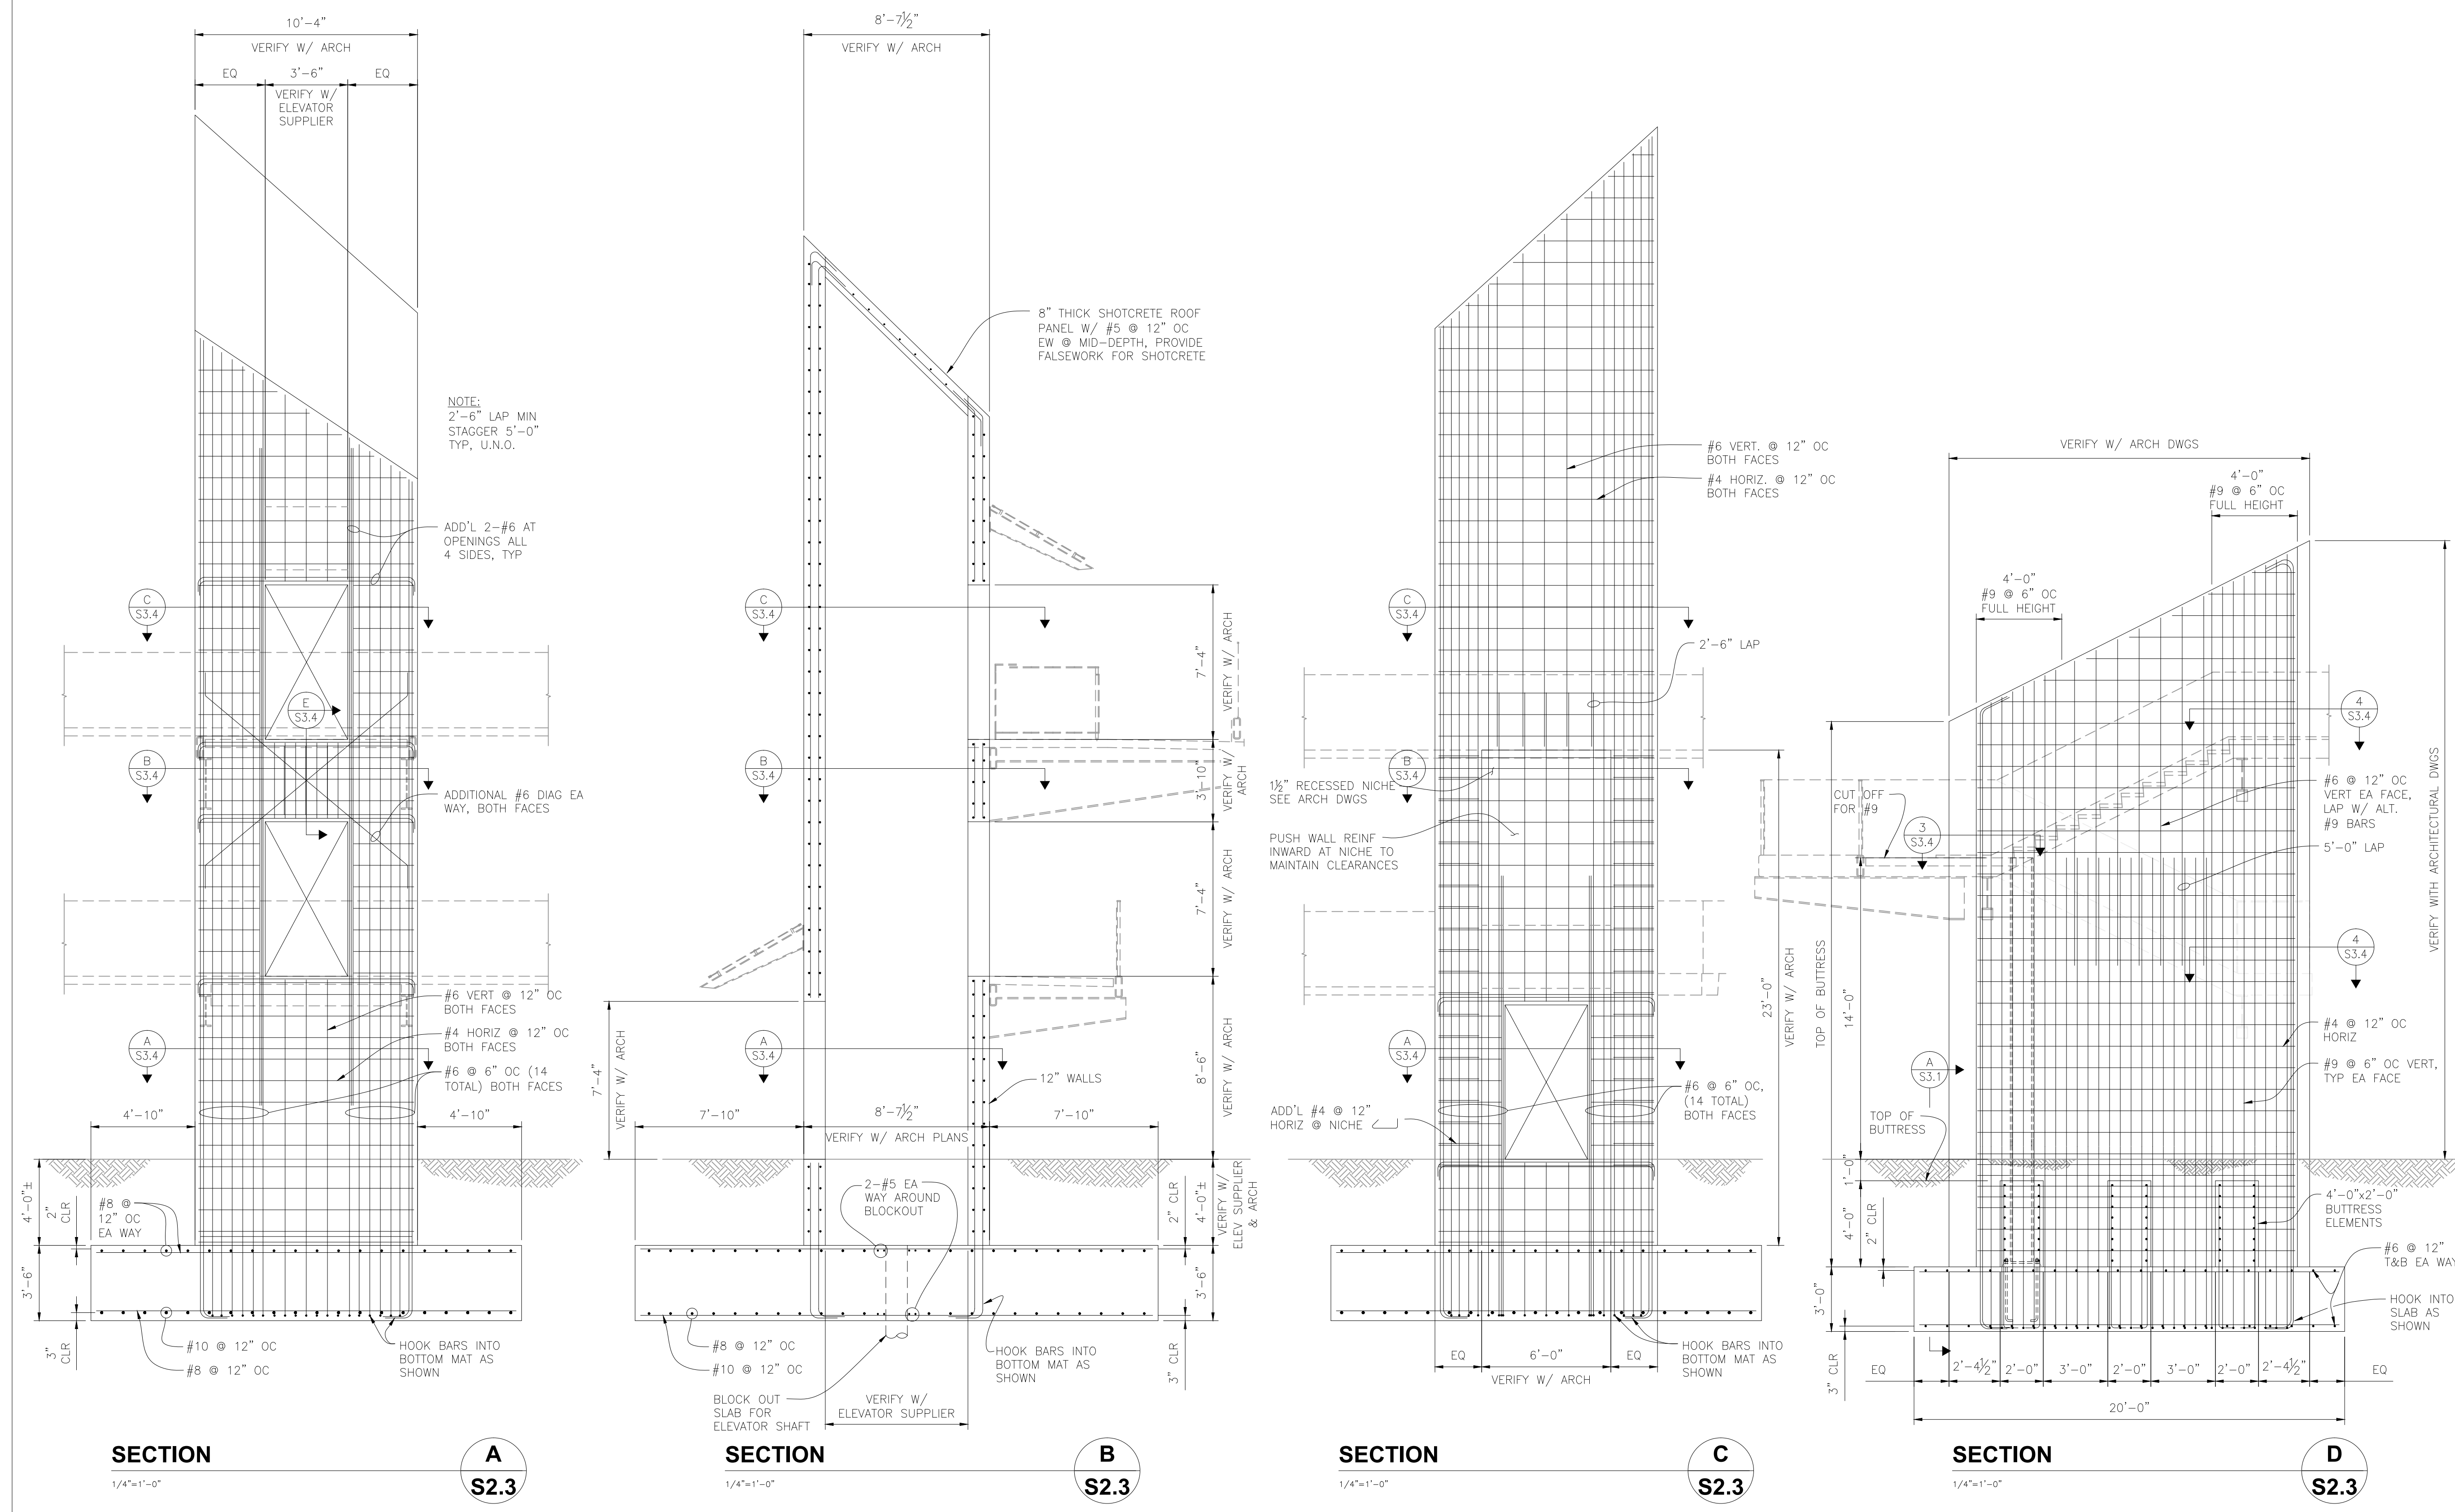

SECTION A
1/4"=1'-0"
S2.3

SECTION B
1/4"=1'-0"
S2.3

SECTION C
1/4"=1'-0"
S2.3

SECTION D
1/4"=1'-0"
S2.3