


222 SUTTER STREET, 9TH FLOOR
SAN FRANCISCO, CALIFORNIA 94108
phone 415.777.9422 fax 415.777.2755 24/7 bparch.com

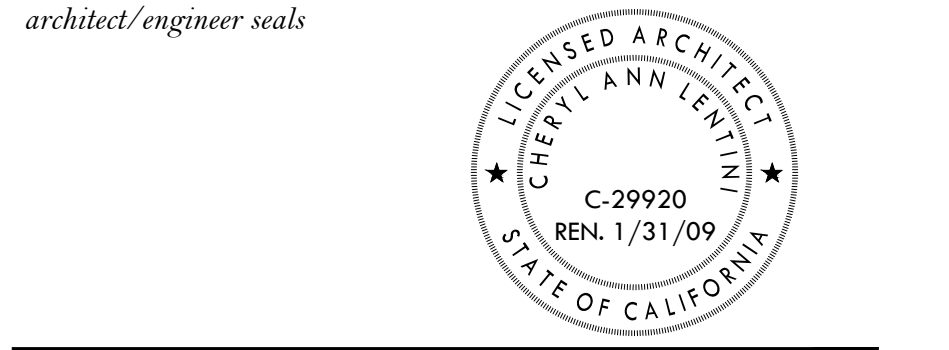

consultant
CORNERSTONE structural engineering group
40 Federal Street
San Francisco, California 94107
415.369.9100
fax 415.369.9101

project title
SMCCCD COLLEGE OF SAN MATEO FINE ARTS COMPLEX BUILDINGS 2 & 4 RENOVATIONS INCREMENT 2
344 CSM DRIVE
SAN MATEO, CA 94402

agency/approvals
IDENTIFICATION STAMP
DIVISION OF THE STATE ARCHITECT
APPL. No. 01 - 109243
AC: _____ FLS: _____ SS: _____
DATE: _____

date	description
03.13.2008	PRICING SET
05.08.2008	INCREMENT 2 DSA SUBMITTAL
10.14.2008	DSA RESPONSE
11.04.2010	RECORD DRAWINGS

sheet title
DETAILS No.3

project no. 2707.01

sheet no. **S3.2**
© Beverly Prior Architects, Inc. 2007 | All Rights Reserved

C:\Users\pripri\Documents\2707_01\07_1108_BPA_Architects_CAD\CSDM_Bldg4_mec_02 - 310x450.dwg (28/04/2010) 2:53:28