

REVISIONS	
1	
2	
3	
4	
5	
6	


COPYRIGHT © 2003 SARAMARK, INCORPORATED
 THESE PLAN DRAWINGS ARE PROPRIETARY DOCUMENTS OF SARAMARK, INCORPORATED & ARE NOT TO BE DISTRIBUTED, PUBLISHED OR REPRODUCED WITHOUT THE WRITTEN CONSENT OF SARAMARK INCORPORATED.

EC CONSULTING GROUP
 1280 AVIATION AVE
 SUITE 200-F
 SAN JOSE, CA 95110
 TEL: (408) 254-8312

COLLEGE of SAN MATEO
 SAN MATEO UNIFIED SCHOOL DISTRICT

SARAMARK INCORPORATED
 SERIES
 NEW
 P.O. BOX 24369
 SAN JOSE, CALIFORNIA 95154
 TEL: (408) 971-3881
 FAX: (408) 971-3534


BUILDING B HALL OF FAME ROOF FRAMING PLAN

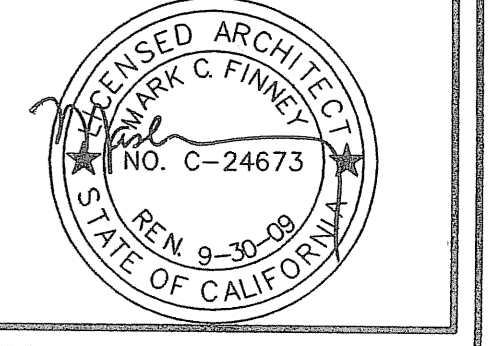


IDENTIFICATION STAMP
 DIV. OF THE STATE ARCHITECT
 OFFICE OF REGULATION SERVICES
 01-108848
 AC 20 FLS. (L) SS. (S)
 DATE: 10 2007

DRAWN: 4.11.07
 CHECKED: FAV
 SCALE: AS NOTED
 PROJECT: 1615


B-S-3

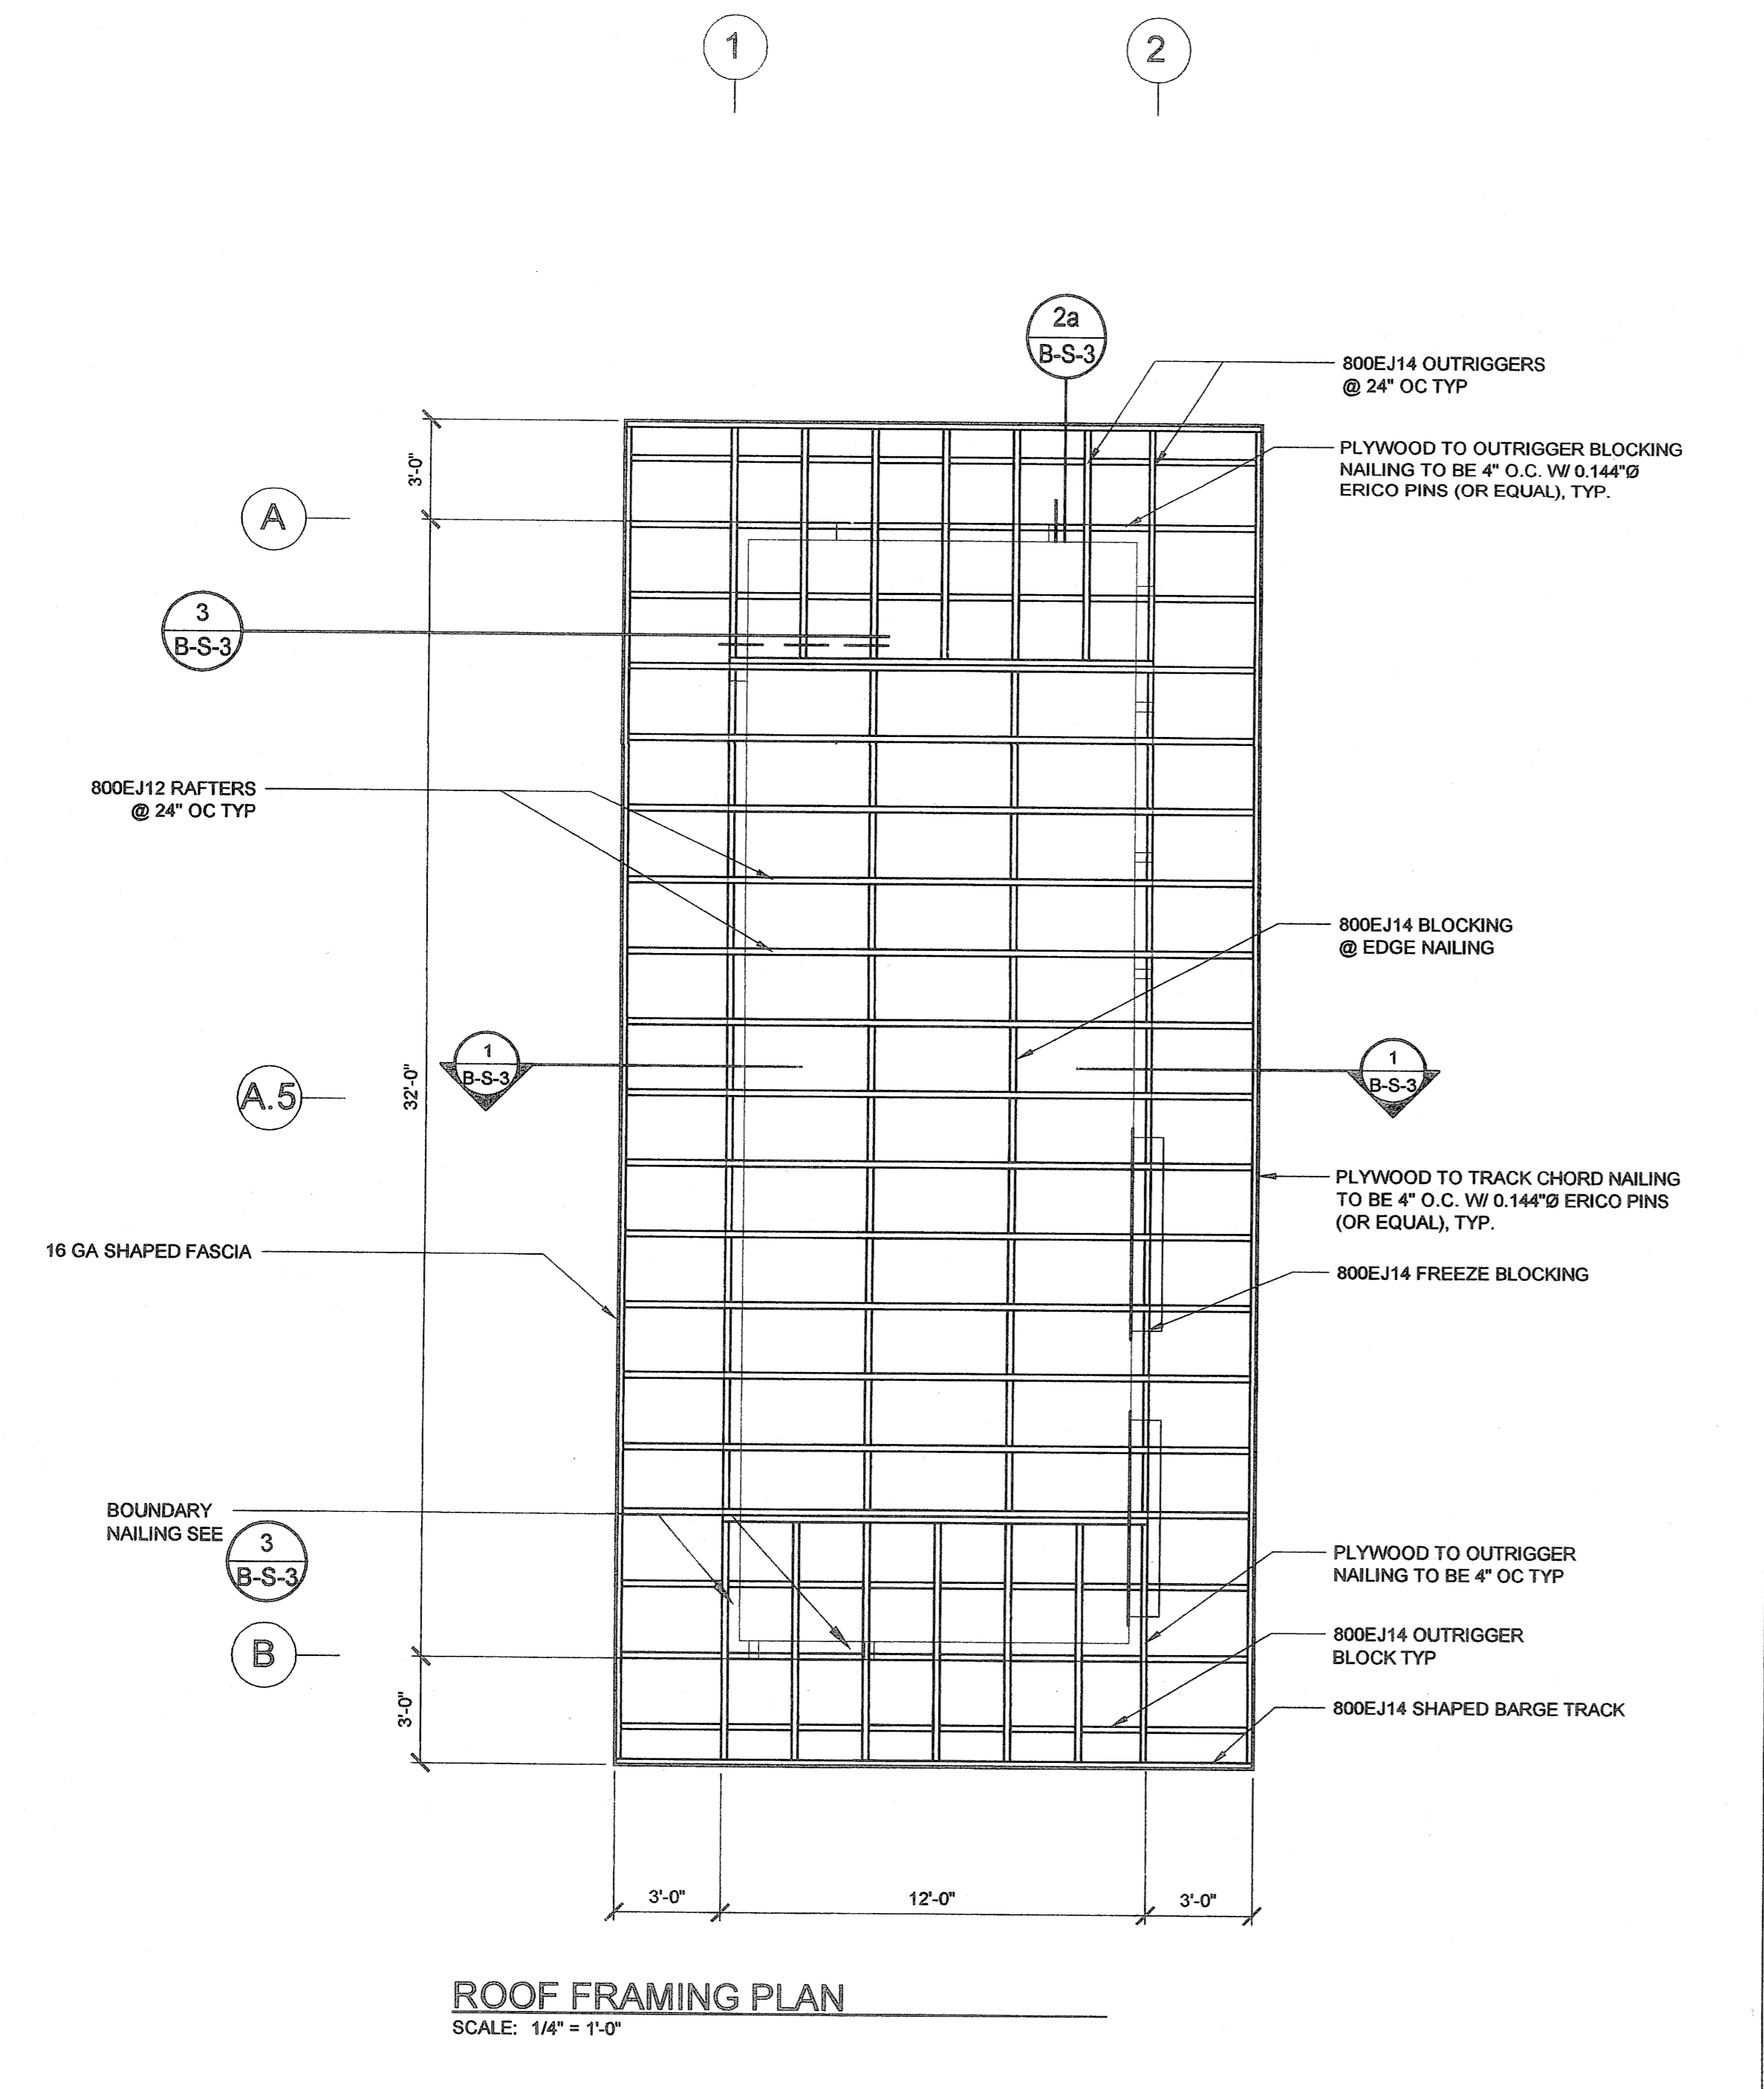


ROOF FRAMING PLAN
 SCALE: 1/4" = 1'-0"

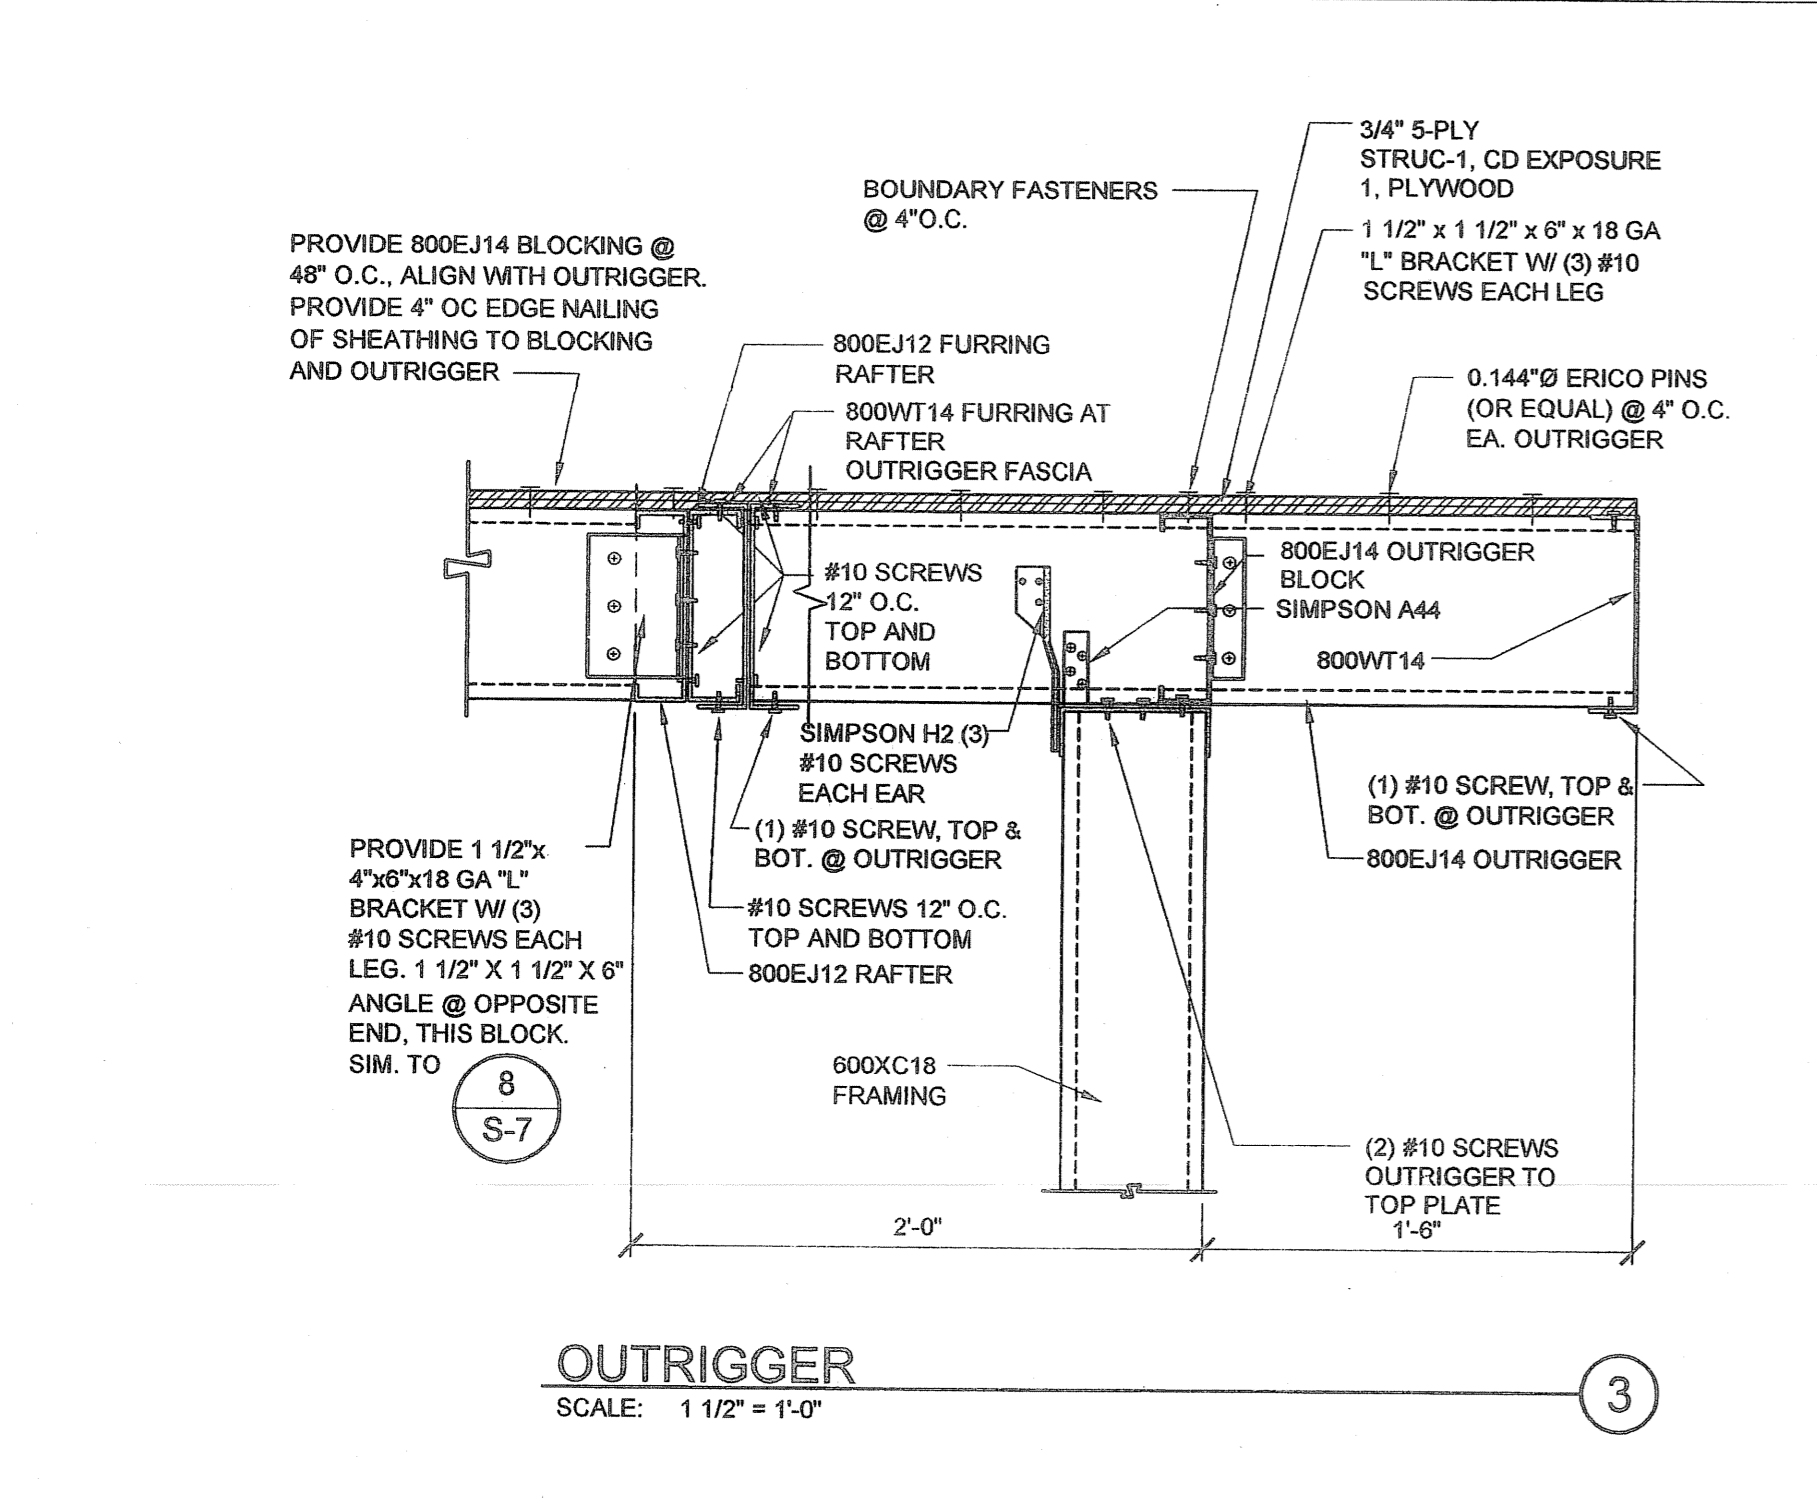


OUTRIGGER
 SCALE: 1 1/2" = 1'-0"

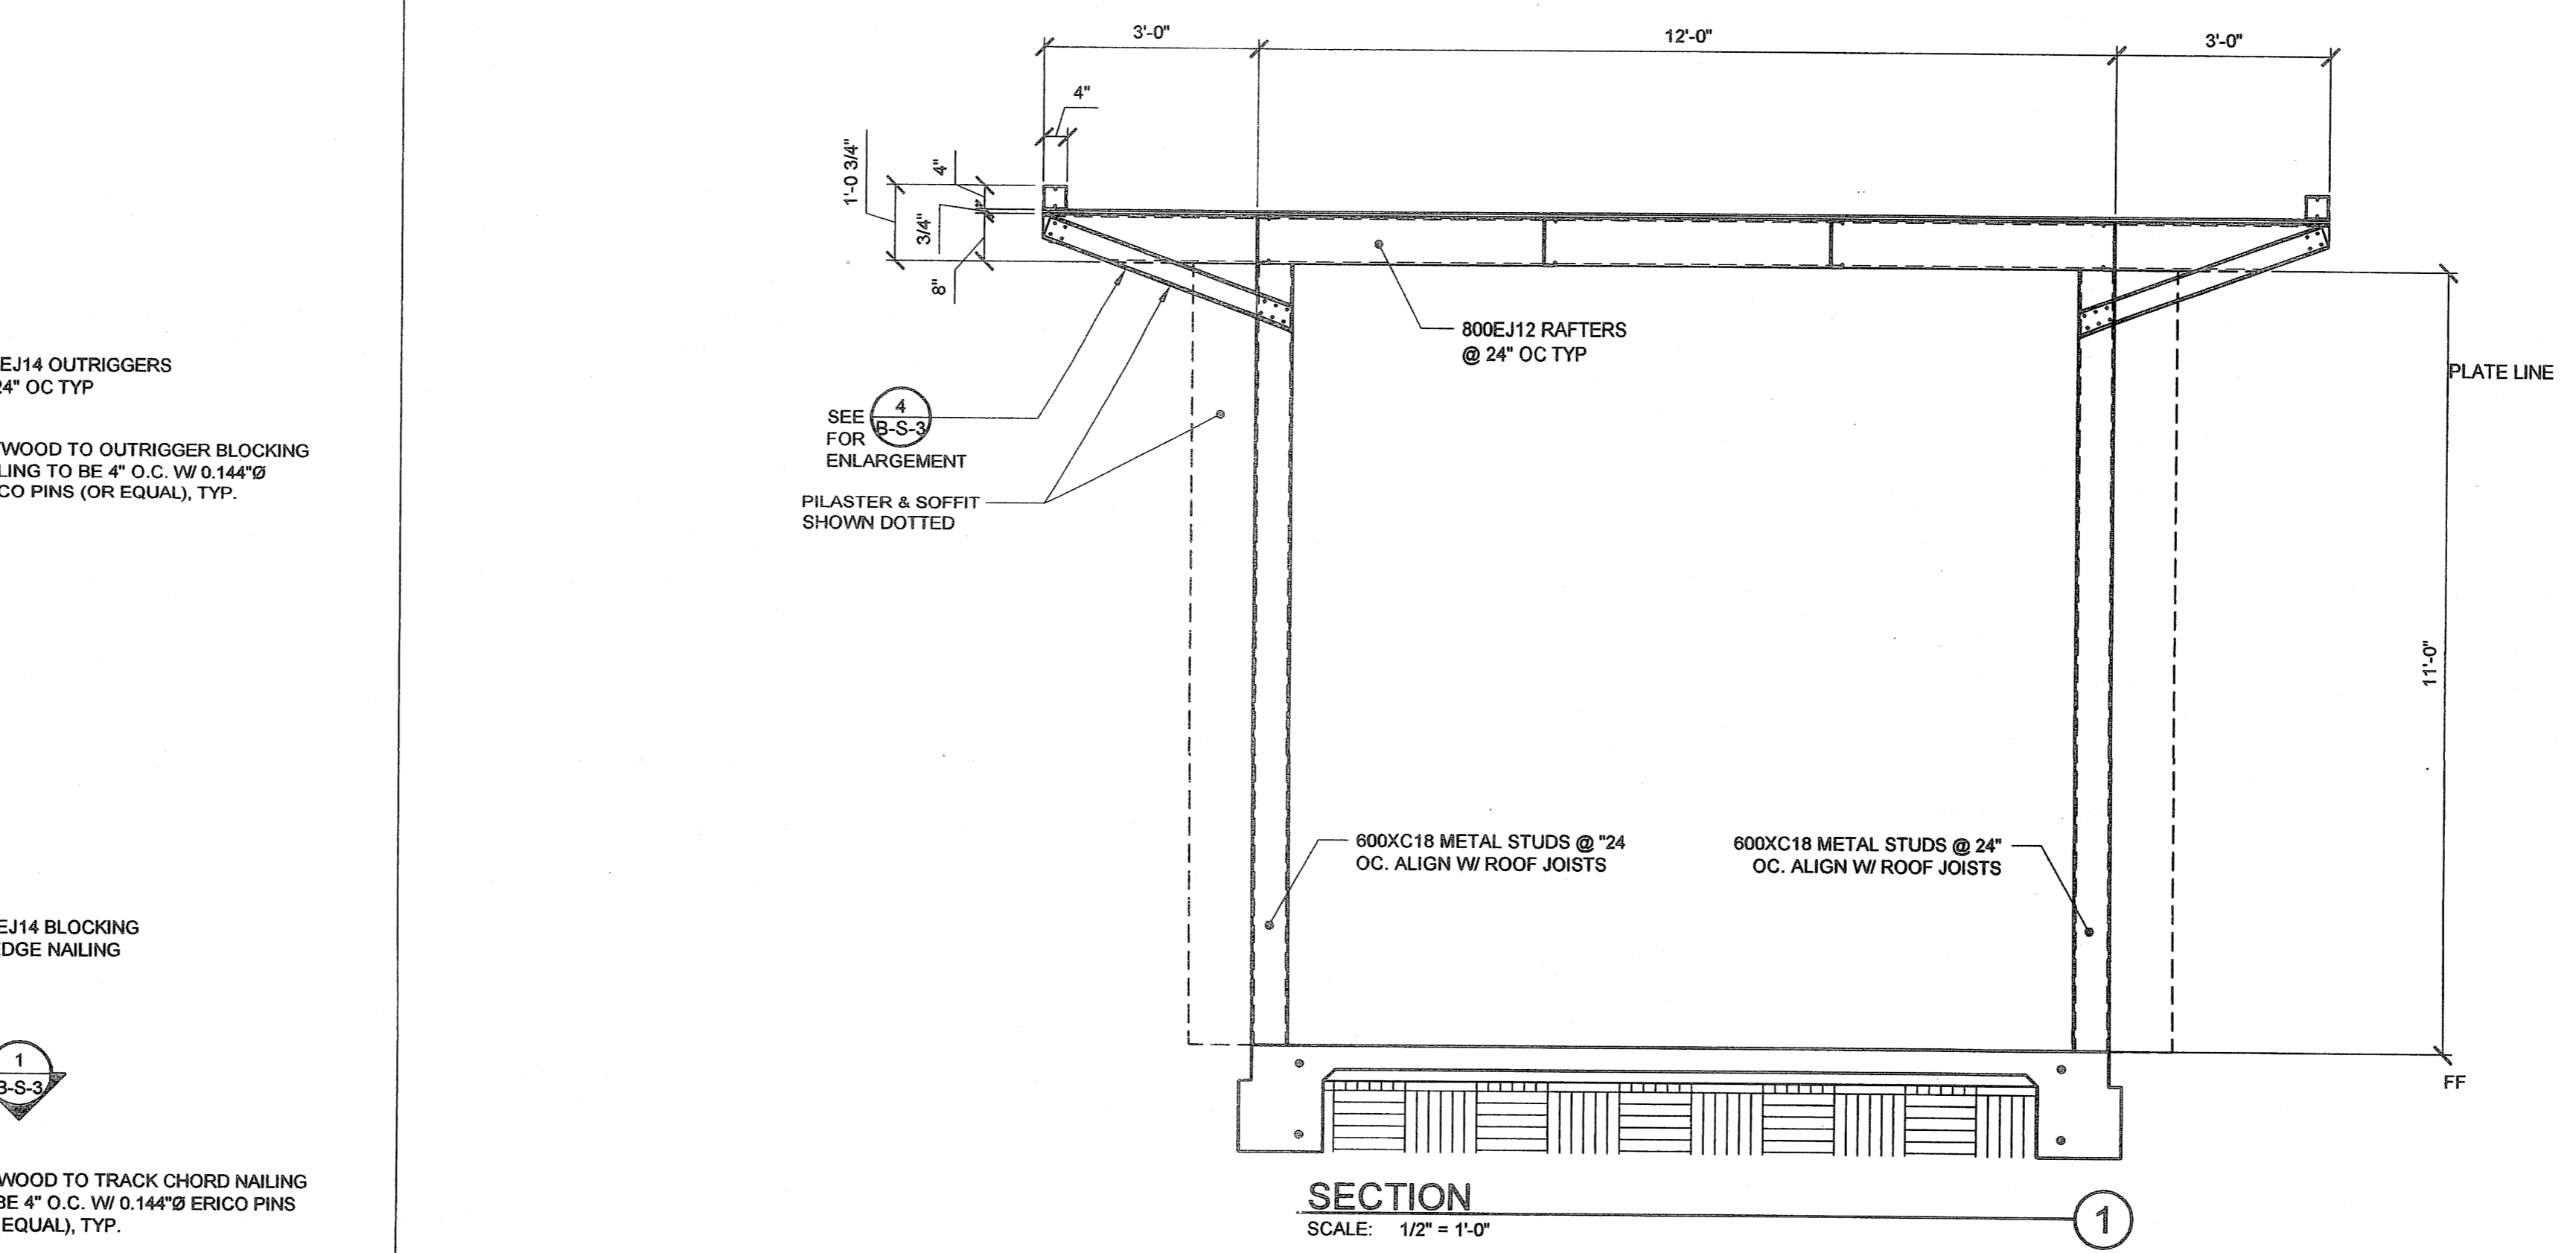


SECTION
 SCALE: 1/2" = 1'-0"

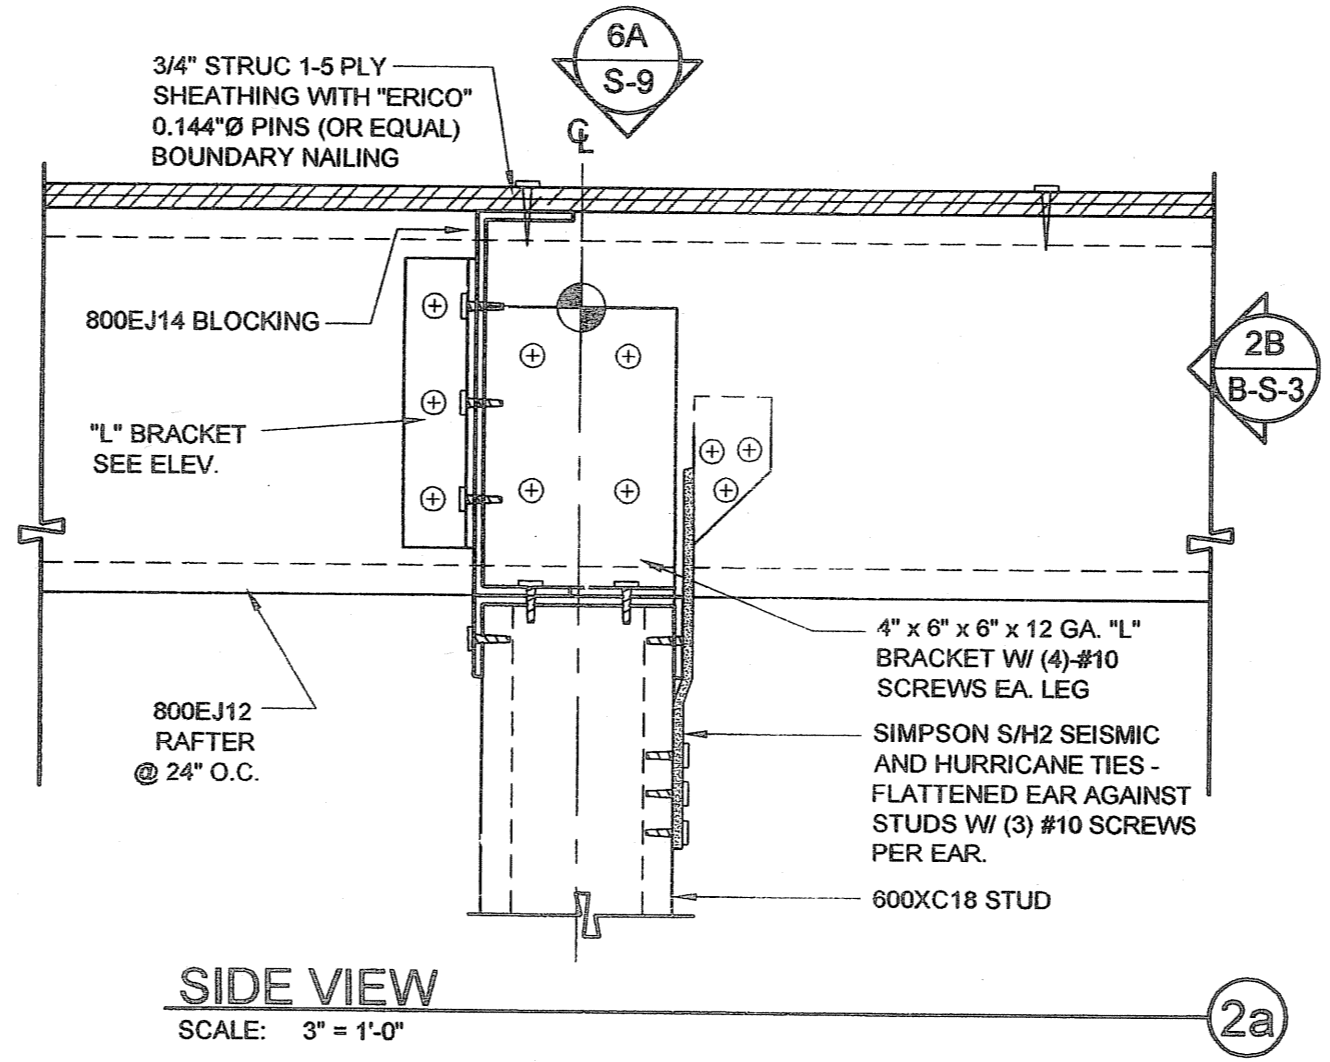


SIDE VIEW
 SCALE: 3" = 1'-0"

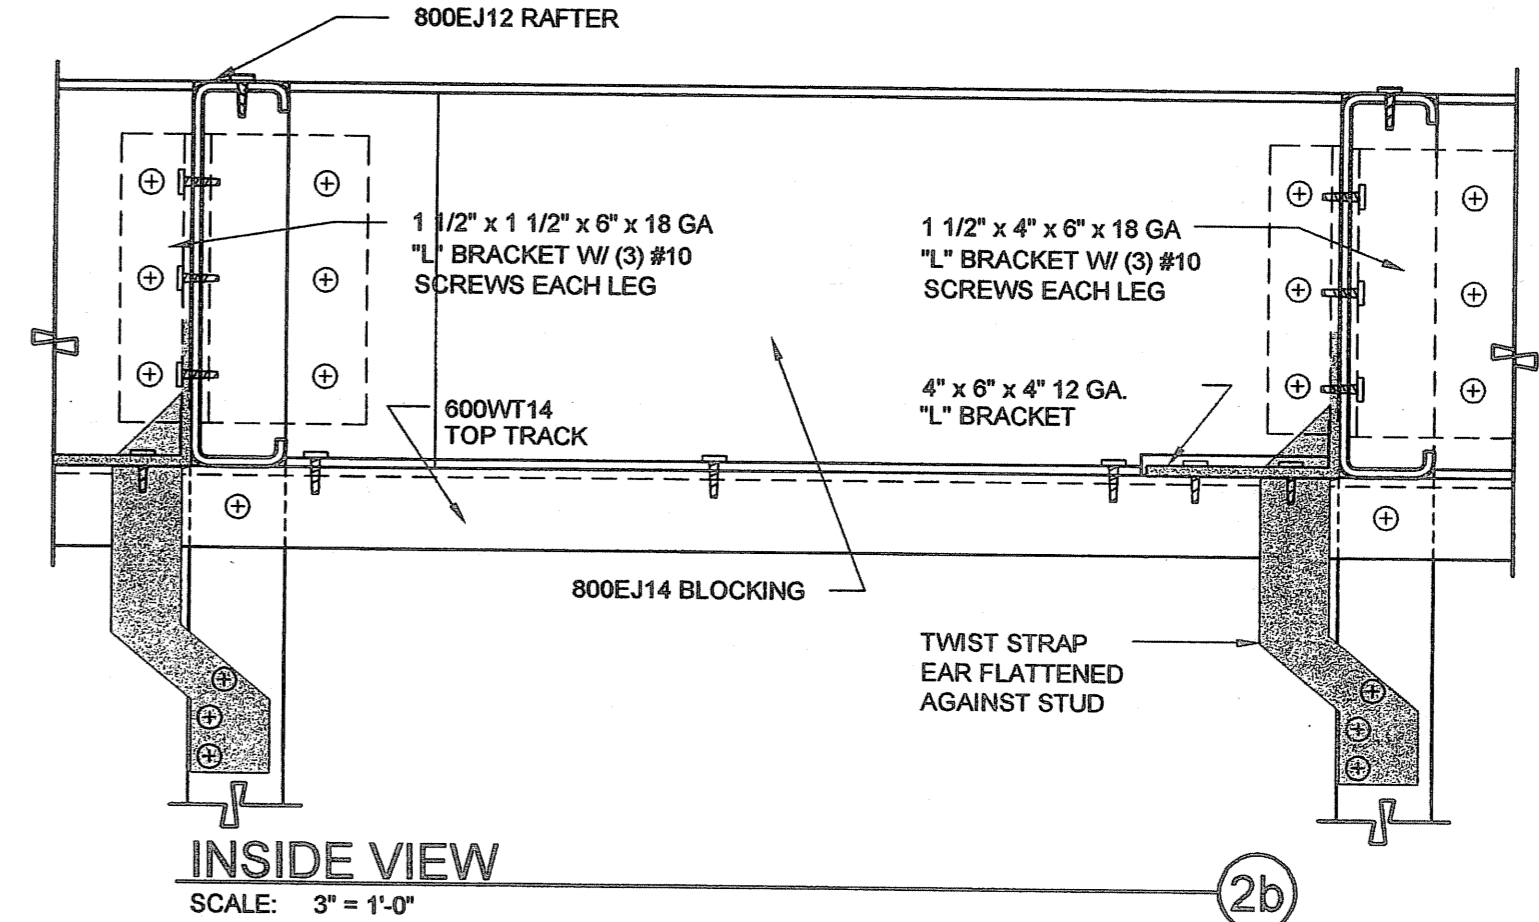

INSIDE VIEW
 SCALE: 3" = 1'-0"

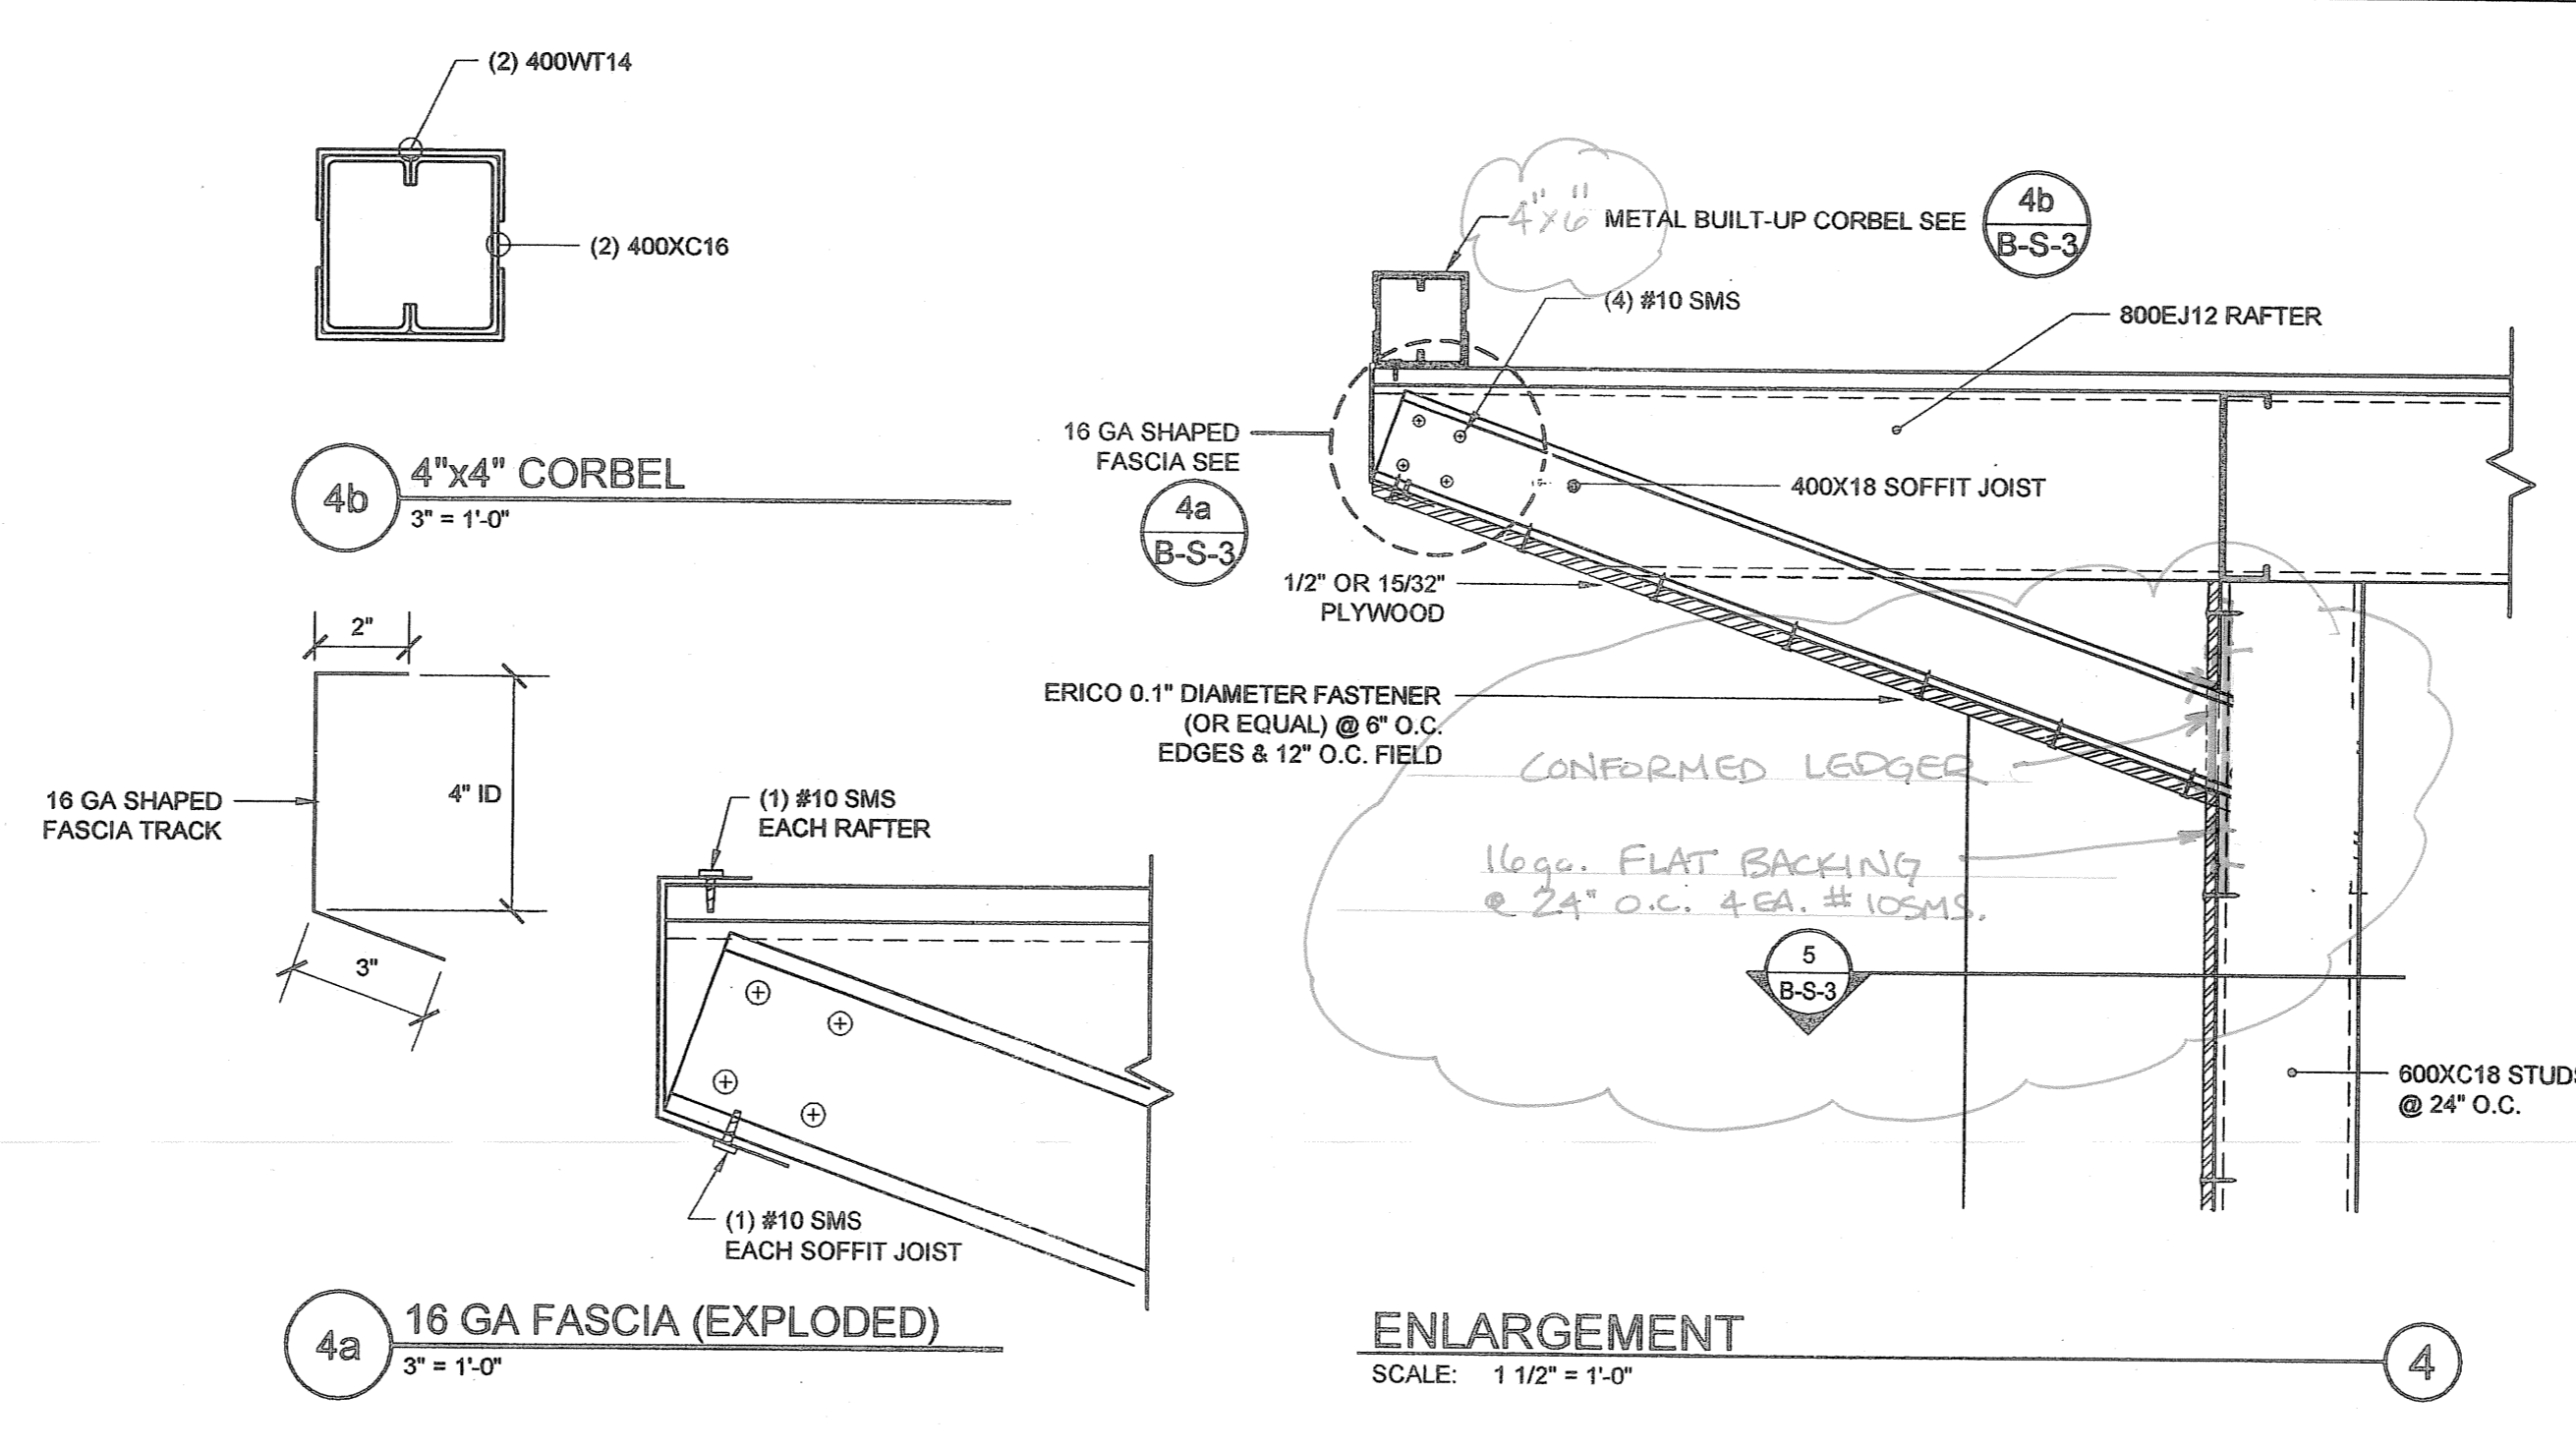

ENLARGEMENT
 SCALE: 1 1/2" = 1'-0"

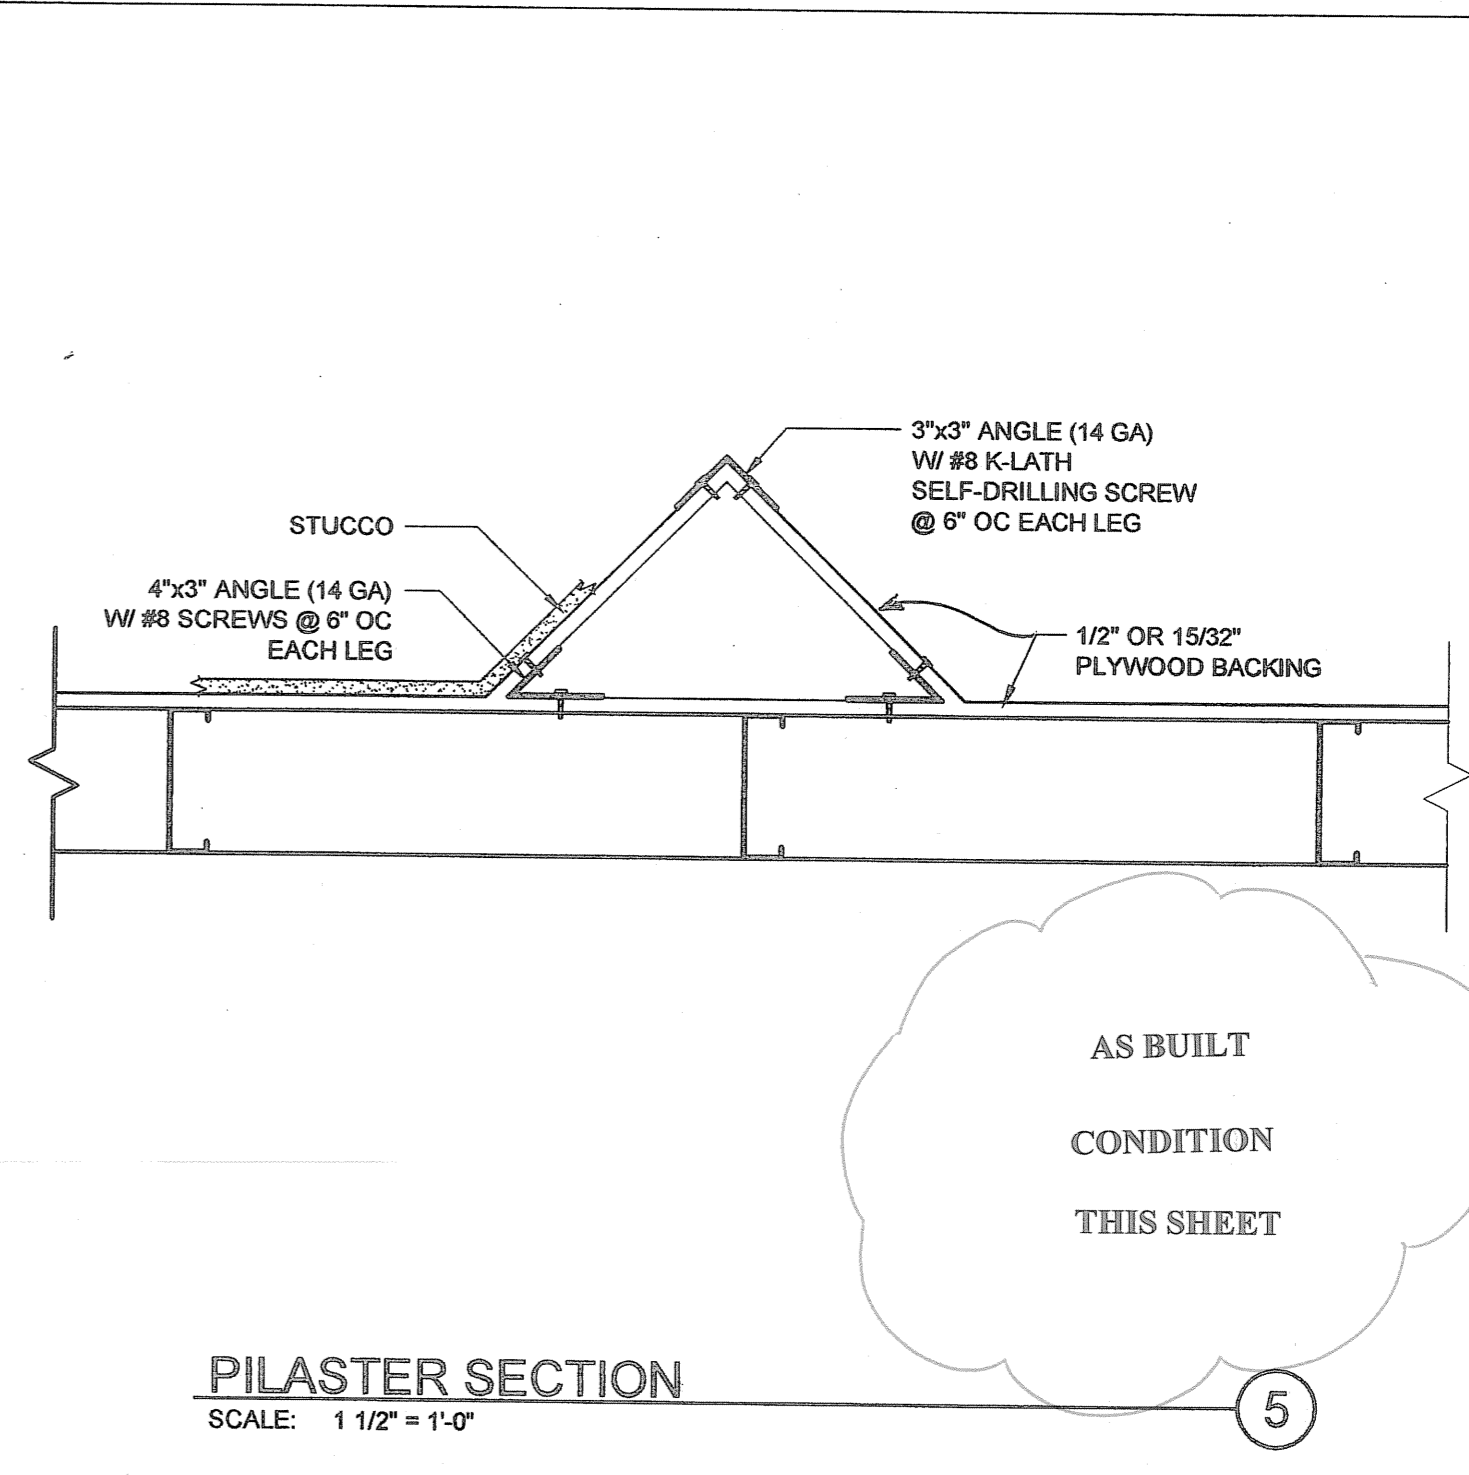

PILASTER SECTION
 SCALE: 1 1/2" = 1'-0"

AS BUILT
 CONDITION
 THIS SHEET