



drawings\PROJECTS\OPEN PROJECTS\San Mateo Community College\Drawing Set\B-S-3a.dwg, 10/9/2007 3:24:31 PM, 6050 - Bond-24.pc3

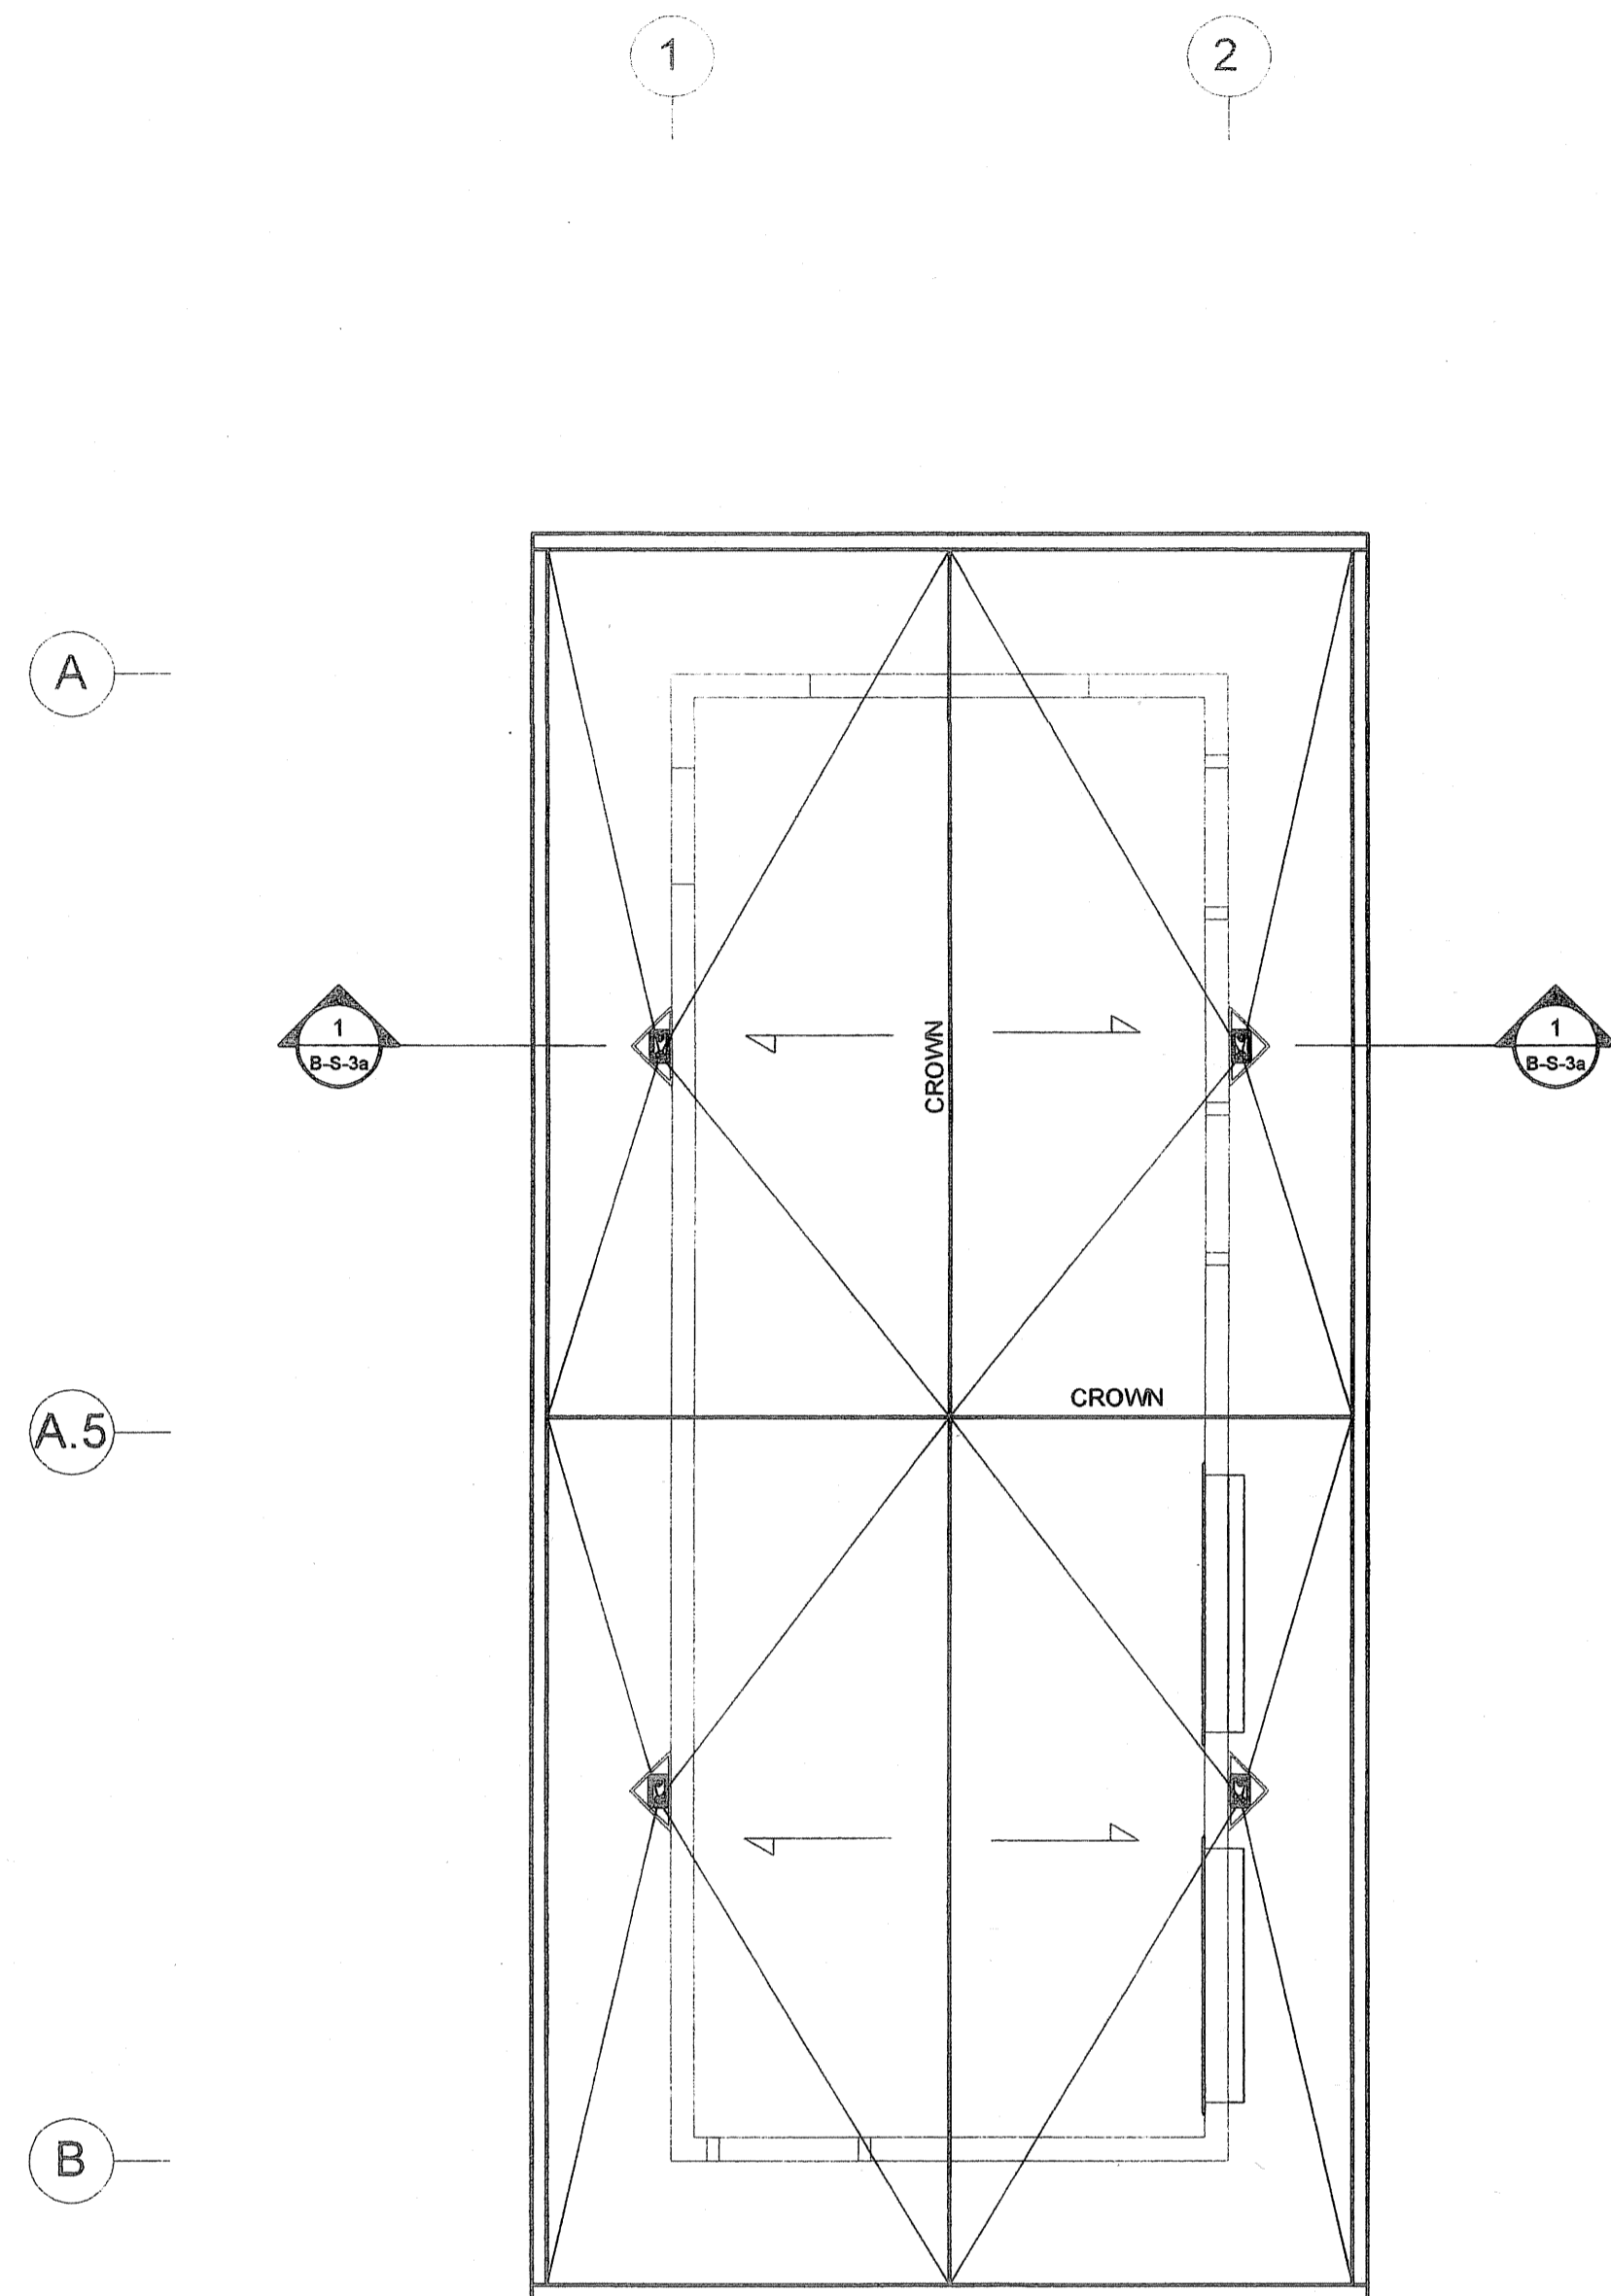

ROOFING PLAN
SCALE: 1/4" = 1'-0"

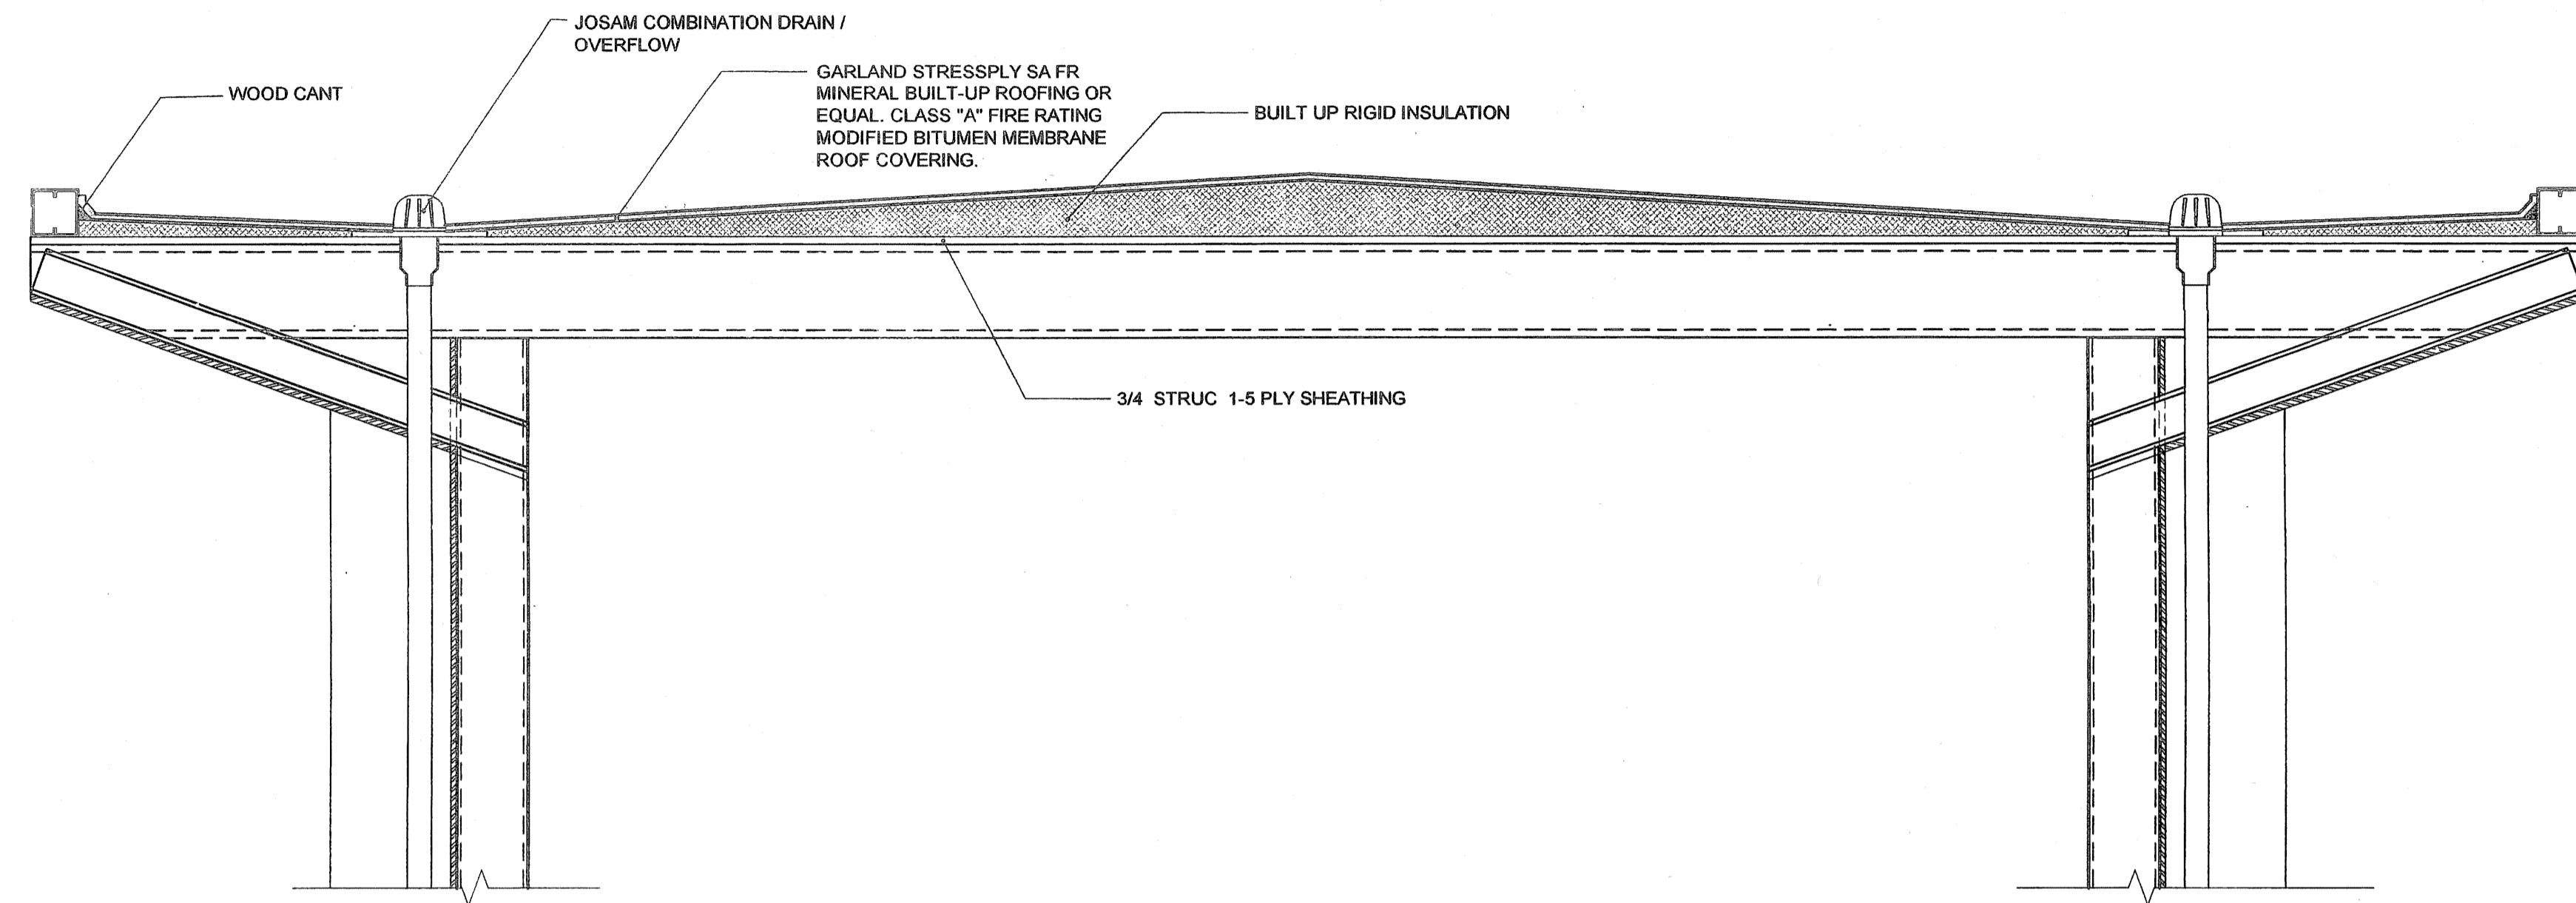

ROOFING SECTION
SCALE: 1" = 1'-0"

REVISIONS

1		
2		
3		
4		
5		
6		

COPYRIGHT © 2003
SARAMARK, INCORPORATED
THESE PLAN DRAWINGS ARE
PROPRIETARY DOCUMENTS
OF SARAMARK, INCORPORATED
& ARE NOT TO BE DISTRIBUTED,
PUBLISHED OR REPRODUCED
WITHOUT THE WRITTEN
CONSENT OF SARAMARK,
INCORPORATED.

**EC
CONSULTING
GROUP**

1890 AVIATION AVE
SUITE 500-F
SAN JOSE, CA 95110
TEL: (408) 294-0810

**COLLEGE
of
SAN MATEO**


**SAN MATEO
UNIFIED SCHOOL
DISTRICT**

**SARAMARK
INCORPORATED
SERIES**

NEW

P.O. BOX 24369
SAN JOSE, CALIFORNIA 95114
TEL: (408) 971-3861
FAX: (408) 971-3534

**BUILDING B
HALL OF FAME
ROOFING
PLAN**

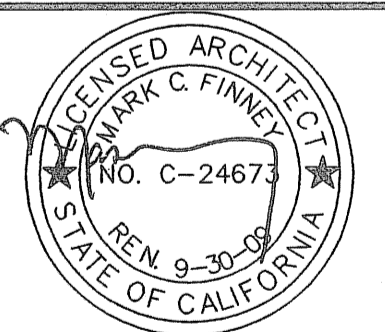

IDENTIFICATION STAMP
DIV. OF THE STATE ARCHITECT
OFFICE OF REGULATION SERVICES

01-108848
AC. FL. SS.
DATE OCT 10 2007

DRAWN:
DATE: 4.11.07
CHECKED: FAV
SCALE: AS NOTED
PROJECT: 1615

B-S-3a

AS-BUILTS