


- ① REFRIDGERATOR (NIC)
- ② POPCORN MACHINE (NIC)
- ③ ICE MAKER (NIC)
- ④ FOUNTAIN DRINK MACHINE (NIC)
- ⑤ HOT DOG MACHINE (NIC)
- ⑥ COFFEE MAKER (NIC)

**P.O.C. TRENCHING & PLUMBING PLAN - BUILDING B**  
SCALE: 1/8" = 1'-0"

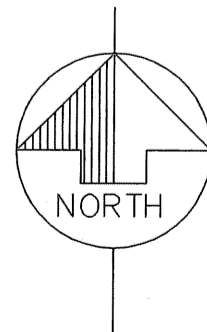

**LEGEND**

- (CYAN) \_\_\_\_\_ CW - AS NOTED
- (ORANGE) \_\_\_\_\_ 2" CAST IRON
- (GREEN) \_\_\_\_\_ 3" CAST IRON
- (MAGENTA) - - - - - ELEC. FEED - AS NOTED (24" RAD. SWEEPS)
- (YELLOW) - - - - - LOW VOLT. FEED - AS NOTED (48" RAD. SWEEPS)
- ELECTRICAL (POWER) - POINT OF CONNECTION
- LOW VOLTAGE - POINT OF CONNECTION
- SANITARY SEWER - POINT OF CONNECTION
- DOMESTIC COLD WATER - POINT OF CONNECTION
- EP-B - ELECTRICAL PANEL
- TC - TIMECLOCK FOR RELAY EXTERIOR LIGHTS
- 13" ROUND WALL MOUNTED EXTERIOR FLUORESCENT LIGHT FIXTURE, MOUNTED @ 92" TO CENTER A.F.F. MOUNTING DETAIL PER MANUFACTURER'S RECOMMENDATION
- F.D. FLOOR DRAIN (F.D.)
- FLOOR SINK
- PLUMBING PIPE IN WALL
- C.O. CLEAN-OUT

**NOTE:**  
NO ENLARGEMENT PLAN IS PROVIDED FOR THIS BUILDING.

**NOTE:**  
FIELD VERIFY ALL POINTS OF CONNECTION AND INVERTS BEFORE TRENCHING TO MATCH FIELD CONDITIONS. DO NOT TRENCH PARALLEL TO BUILDING FOUNDATION WITHIN ANGLE OF INFLUENCE OF FOOTING.

REVISIONS		
FIELD ORDER #1		
△	JC	11.6.07
△		
△		
△		

COPYRIGHT © 2007  
SARAMARK, INCORPORATED  
THESE PLAN DRAWINGS ARE PROPRIETARY DOCUMENTS OF SARAMARK, INCORPORATED & ARE NOT TO BE DISTRIBUTED, PUBLISHED OR REPRODUCED WITHOUT THE WRITTEN CONSENT OF SARAMARK INCORPORATED.


**EC CONSULTING GROUP**  
  
1250 AVIATION AVE  
SUITE 200-F  
SAN JOSE, CA 95110  
TEL: (408) 264-5315

**COLLEGE of SAN MATEO**  
  
SAN MATEO UNIFIED SCHOOL DISTRICT

**BRUNS BELMONT CONSTRUCTION**  
SERIES NEW  
P.O. BOX 812707  
SAN JOSE, CALIFORNIA 95161  
TEL: (408) 971-1708  
FAX: (408) 971-3534

**BUILDING 'B' HALL OF FAME**

**UNDERSLAB SHOP DRAWINGS**

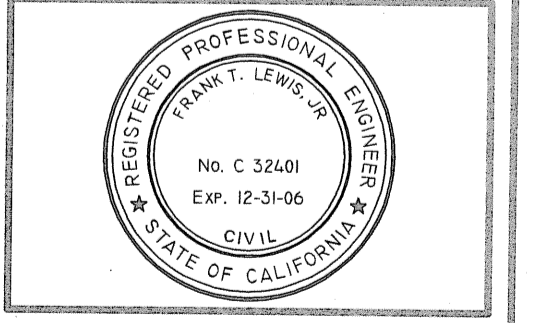

DRAWN:	JC
DATE:	11.6.07
CHECKED:	FAV/FTL
SCALE:	AS SHOWN
PROJECT:	1615

**SHEET 2**  
**P.O.C. TRENCHING & PLUMBING PLAN**  
**F.O. #1**