


1 LEVEL 2 - ENLARGED FLOOR PLAN - SECTOR B  
1/8" = 1'-0"

LEGEND

- CONCRETE WALL; S.S.D.
- METAL STUD WALL FOR INTERIOR PARTITION SCHEDULE, SEE A-902
- RATED PARTITION FOR INTERIOR PARTITION SCHEDULE, SEE A-902

GENERAL NOTES

1. SEE INTERIOR ELEVATIONS FOR EXTENT OF SPECIAL WALL FINISHES.
2. SEE INTERIOR ELEVATIONS FOR ACCESSORIES AND EQUIPMENT LOCATIONS.
3. ALL ITEMS NEW UNLESS OTHERWISE NOTED.
4. ALL DIMENSIONS ARE TO FACE OF FINISH U.O.N.
5. SEE SHEET A-900 FOR ACCESSIBILITY STANDARDS.
6. LOCATE DOOR OPENING FROM ADJACENT PERPENDICULAR WALLS, AS SHOWN, U.O.N.  
18" MIN. INT.  
24" MIN. EXT.
7. S.S.D. FOR EDGE OF SLAB LOCATION AND DIMENSIONS.
8. FURNITURE SHOWN FOR REFERENCE ONLY.
9. DIMENSIONS OF TIERS IN LARGE CLASSROOM 4-70 IS SIMILAR TO LARGE CLASSROOM 4-180.
10. FURNITURE LAYOUT IN LARGE CLASSROOMS 4-180 AND 4-148 IS SIMILAR TO LARGE CLASSROOM 4-170.
11. SEE A1 SERIES FOR ACOUSTICAL WALL PANEL, WALL PROTECTION, AND CORNER GUARD LOCATIONS AND TYPES.

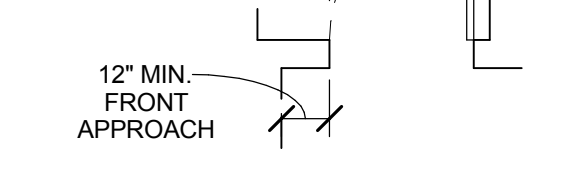


NO.	ISSUES/REVISIONS	DATE

PROJECT RECORD SET

BUILDING 4  
SKYLINE COLLEGE  
SAN MATEO COUNTY  
COMMUNITY COLLEGE  
DISTRICT

CIP2 DESIGN-BUILD  
PROJECT  
BUILDING 4

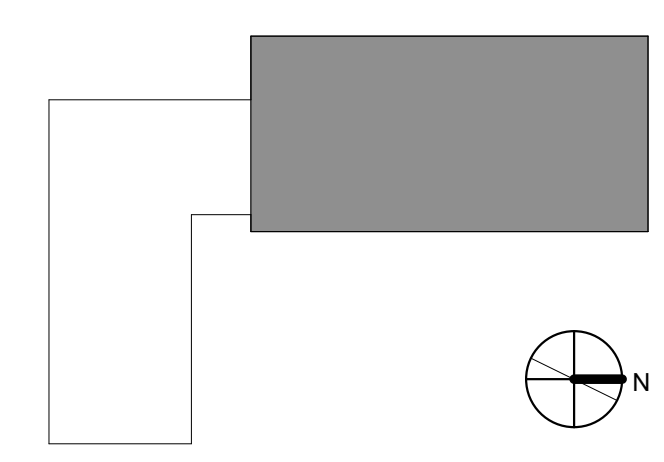

PROJECT NO.: 07012.00 DRAWN BY: LT  
DATE: 05/01/08 CHECKED BY: LG  
SCALE: As indicated

SHEET TITLE:  
LEVEL 2 - ENLARGED FLOOR PLAN - SECTOR B

All drawings and written material appearing herein constitute original and unpublished work of the Architect/Engineer and may not be duplicated, used or disclosed without consent of Architect/Engineer. If this drawing is not 30"x42", then the drawing has been revised from its original size. Note: scales must be adjusted. This line should be equal to one inch.