



1 PARTIAL S.ELEV. ALONG 6
3/16" = 1'-0"


2A EAST ELEVATION ALONG D (SOUTH)
3/16" = 1'-0"

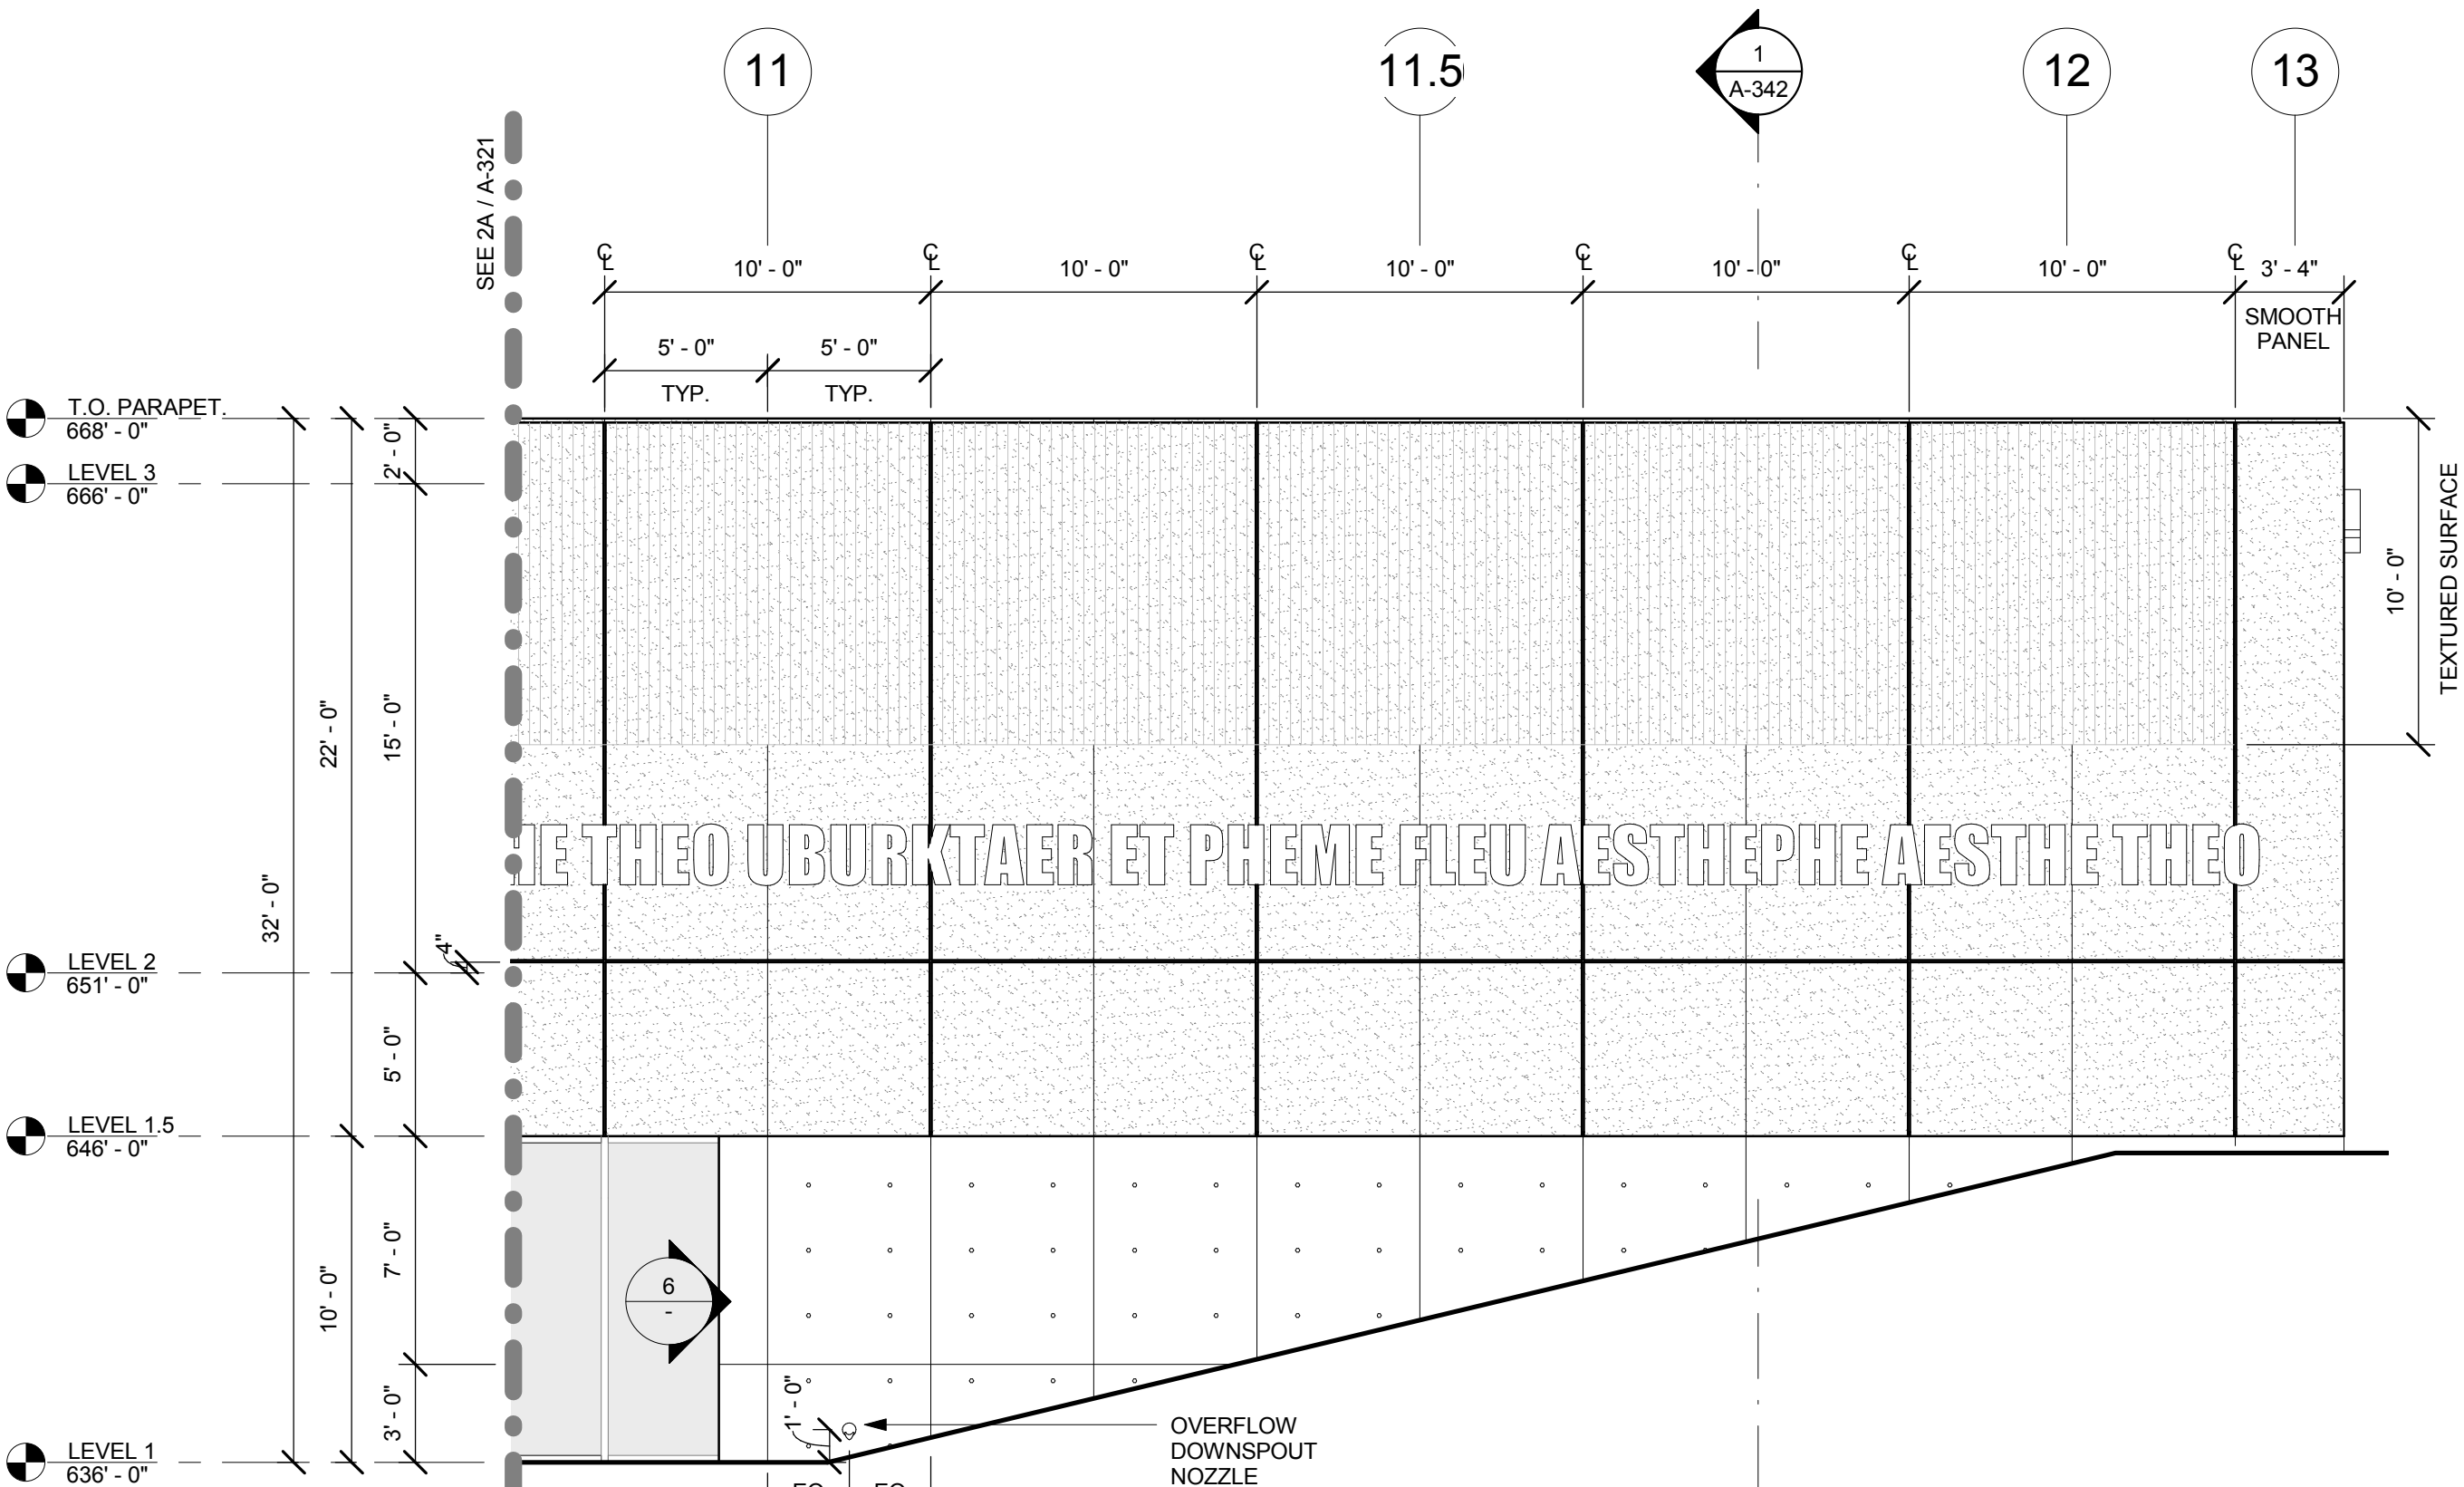


2B EAST ELEVATION ALONG D (NORTH)
3/16" = 1'-0"

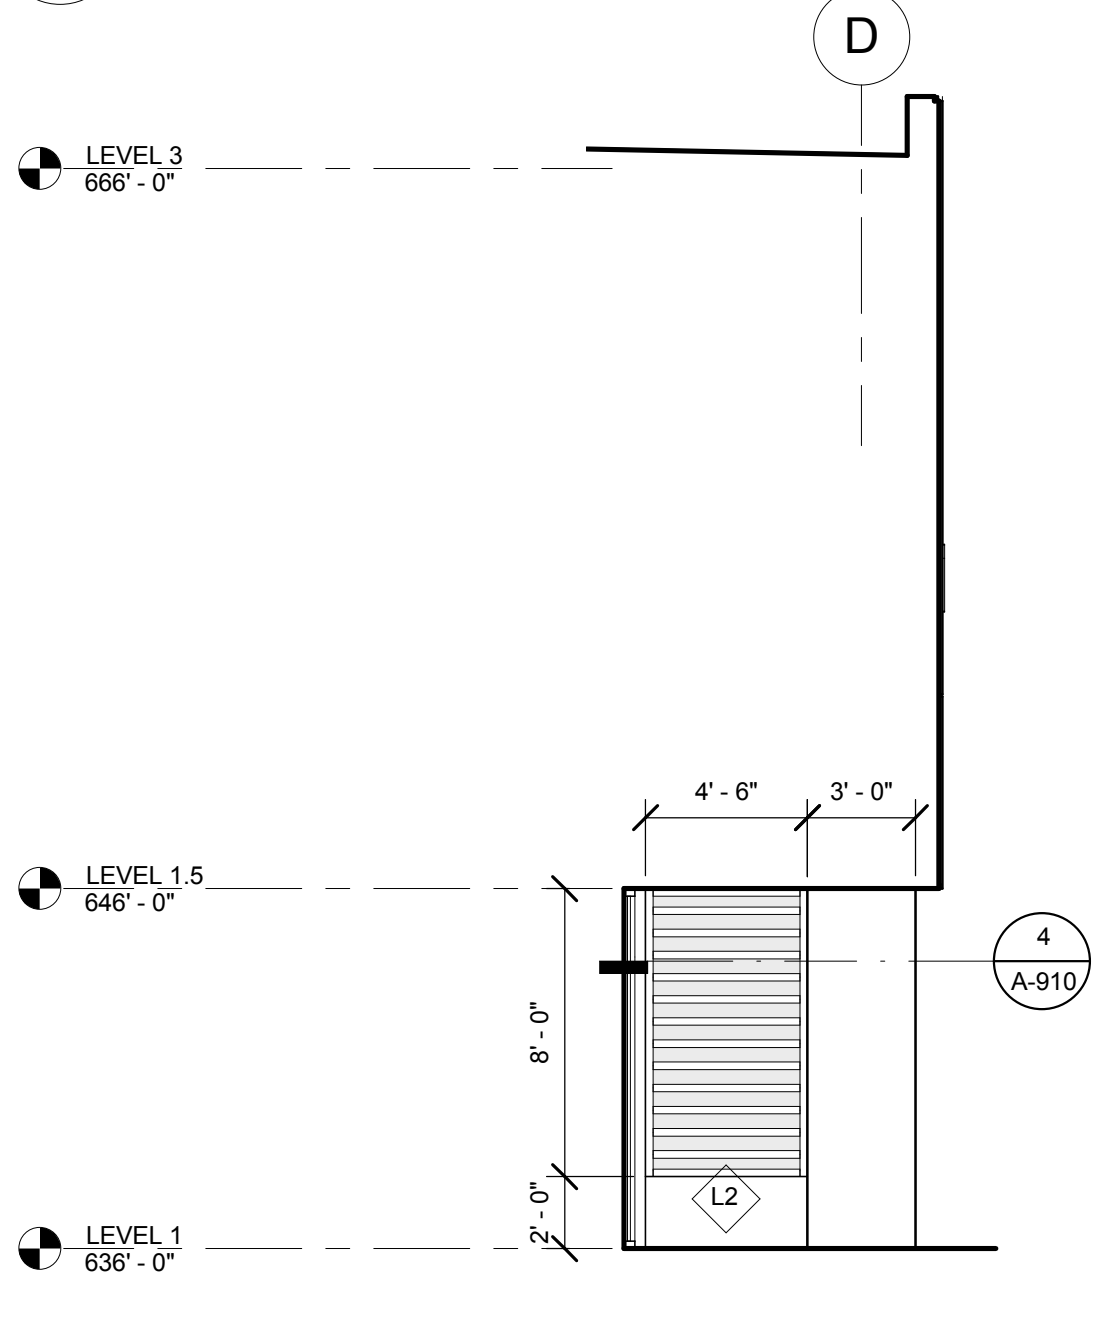


6 PARTIAL S. ELEV. ALONG 11
3/16" = 1'-0"

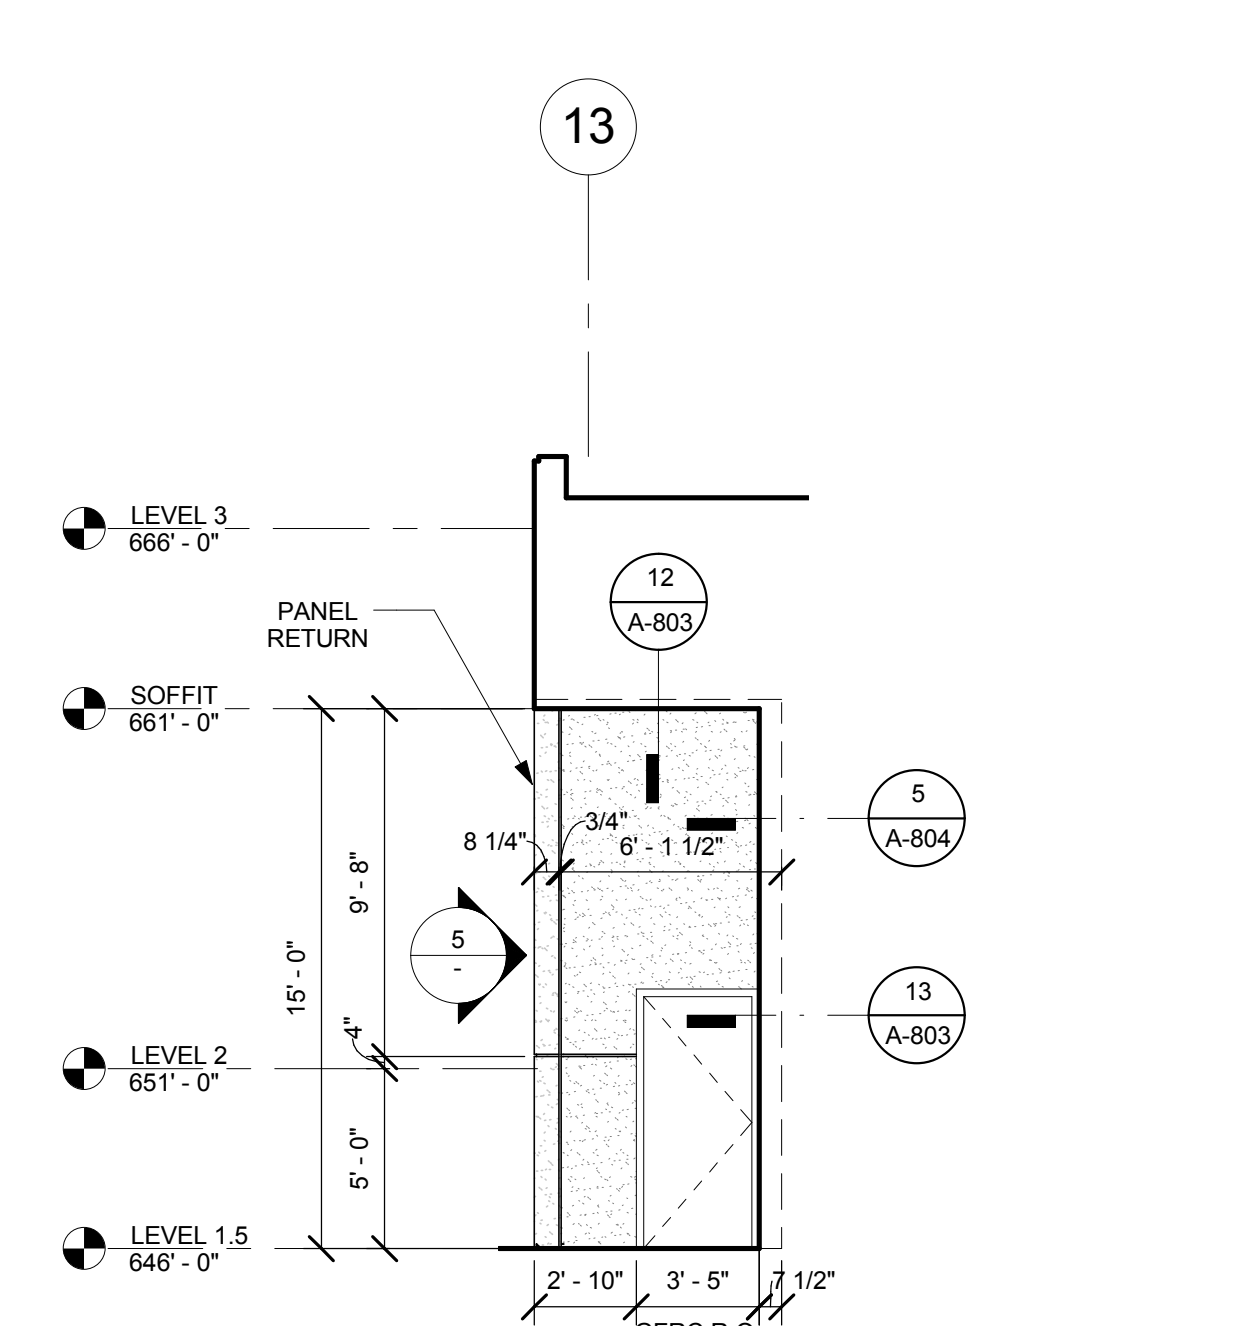

4 W. ELEV. ALONG C.5
3/16" = 1'-0"

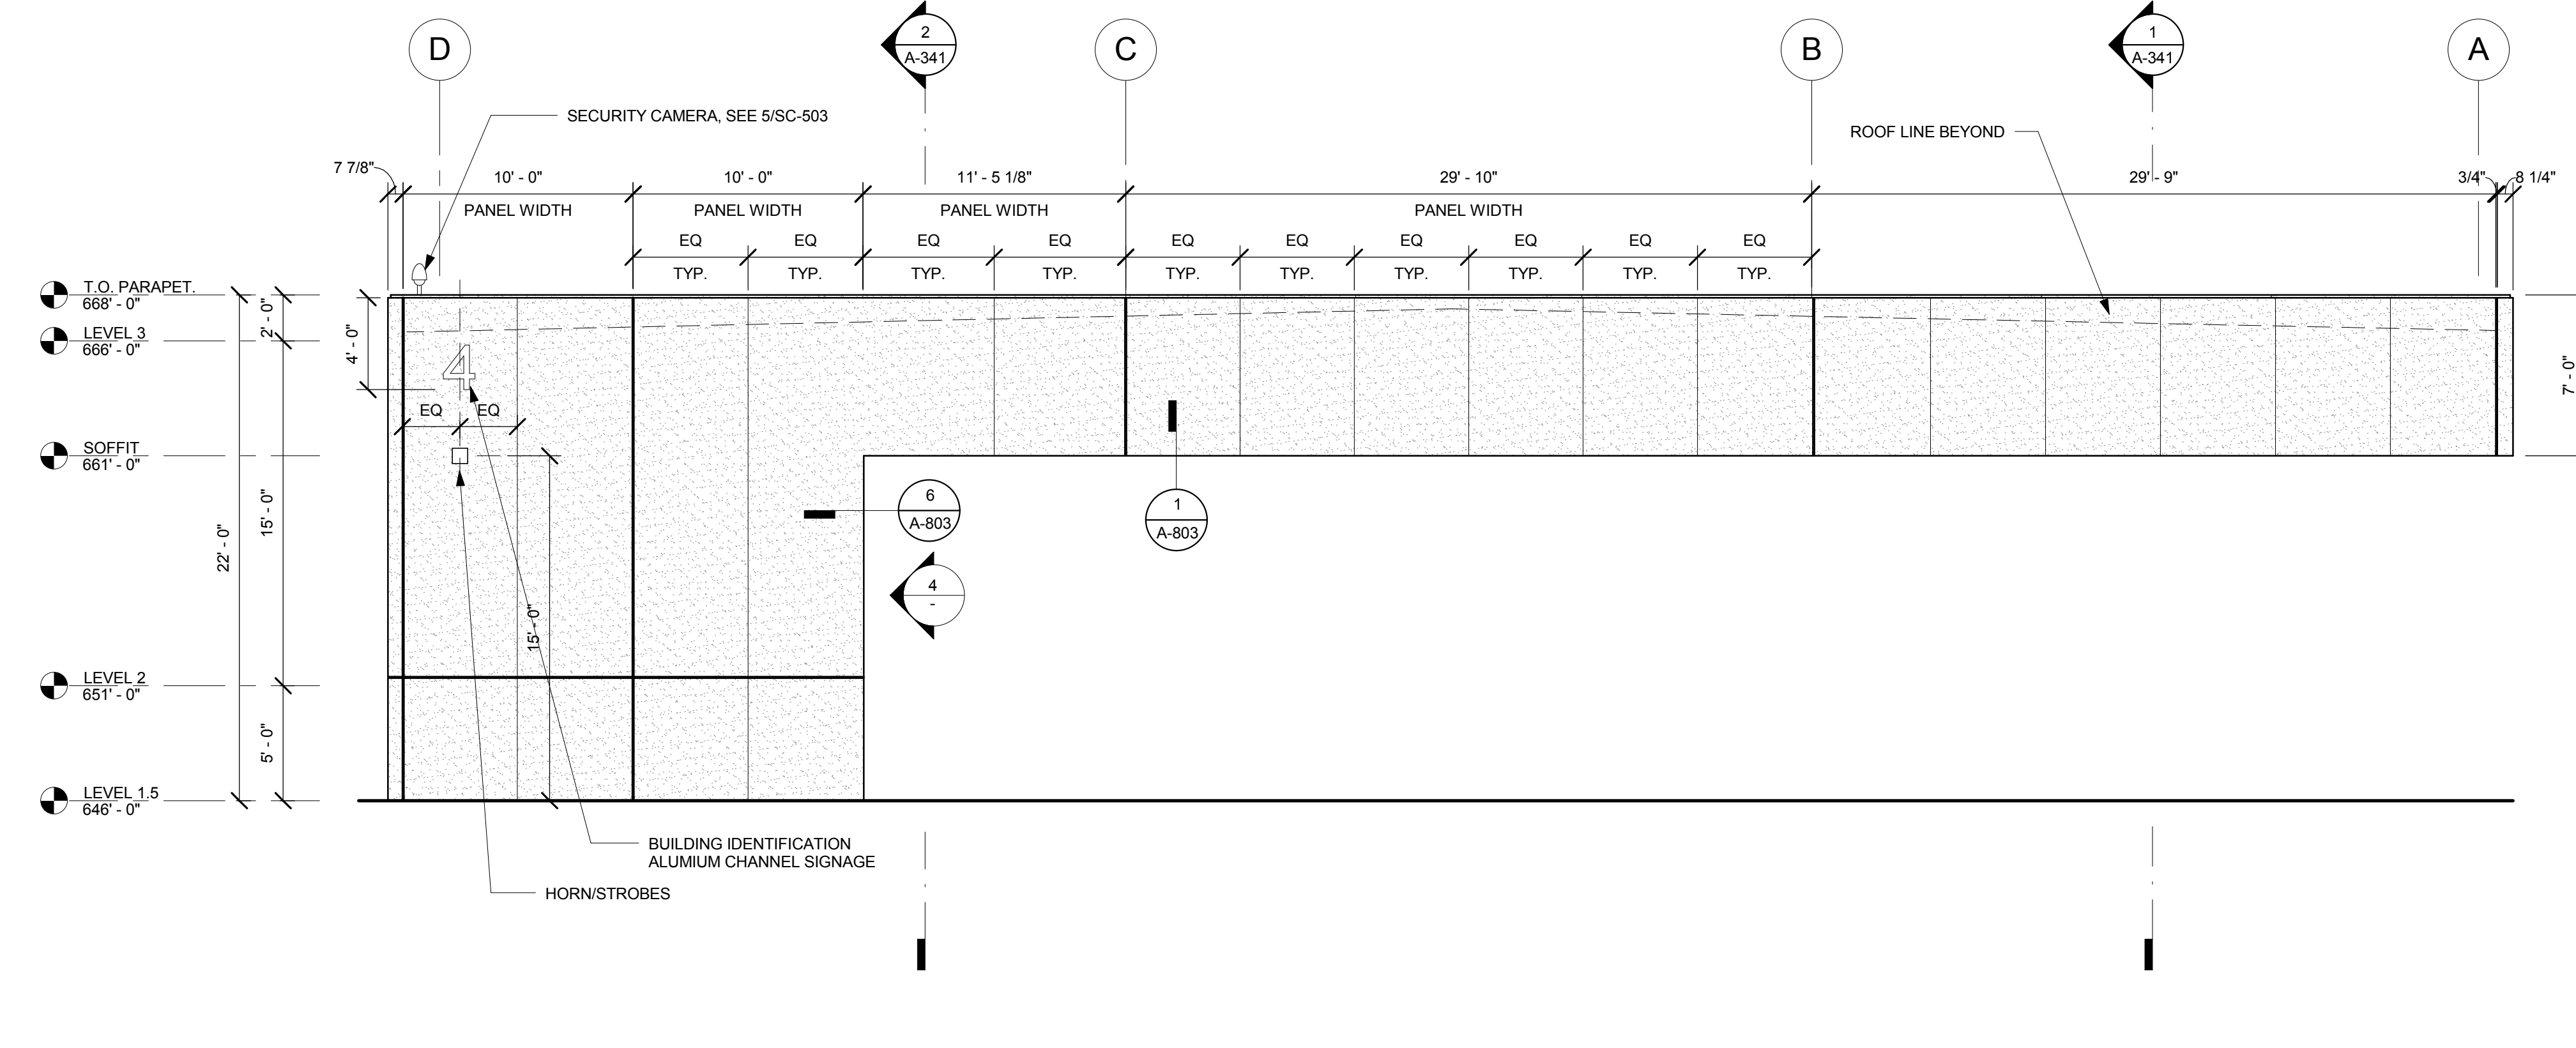

3 NORTH ELEVATION ALONG 13
3/16" = 1'-0"

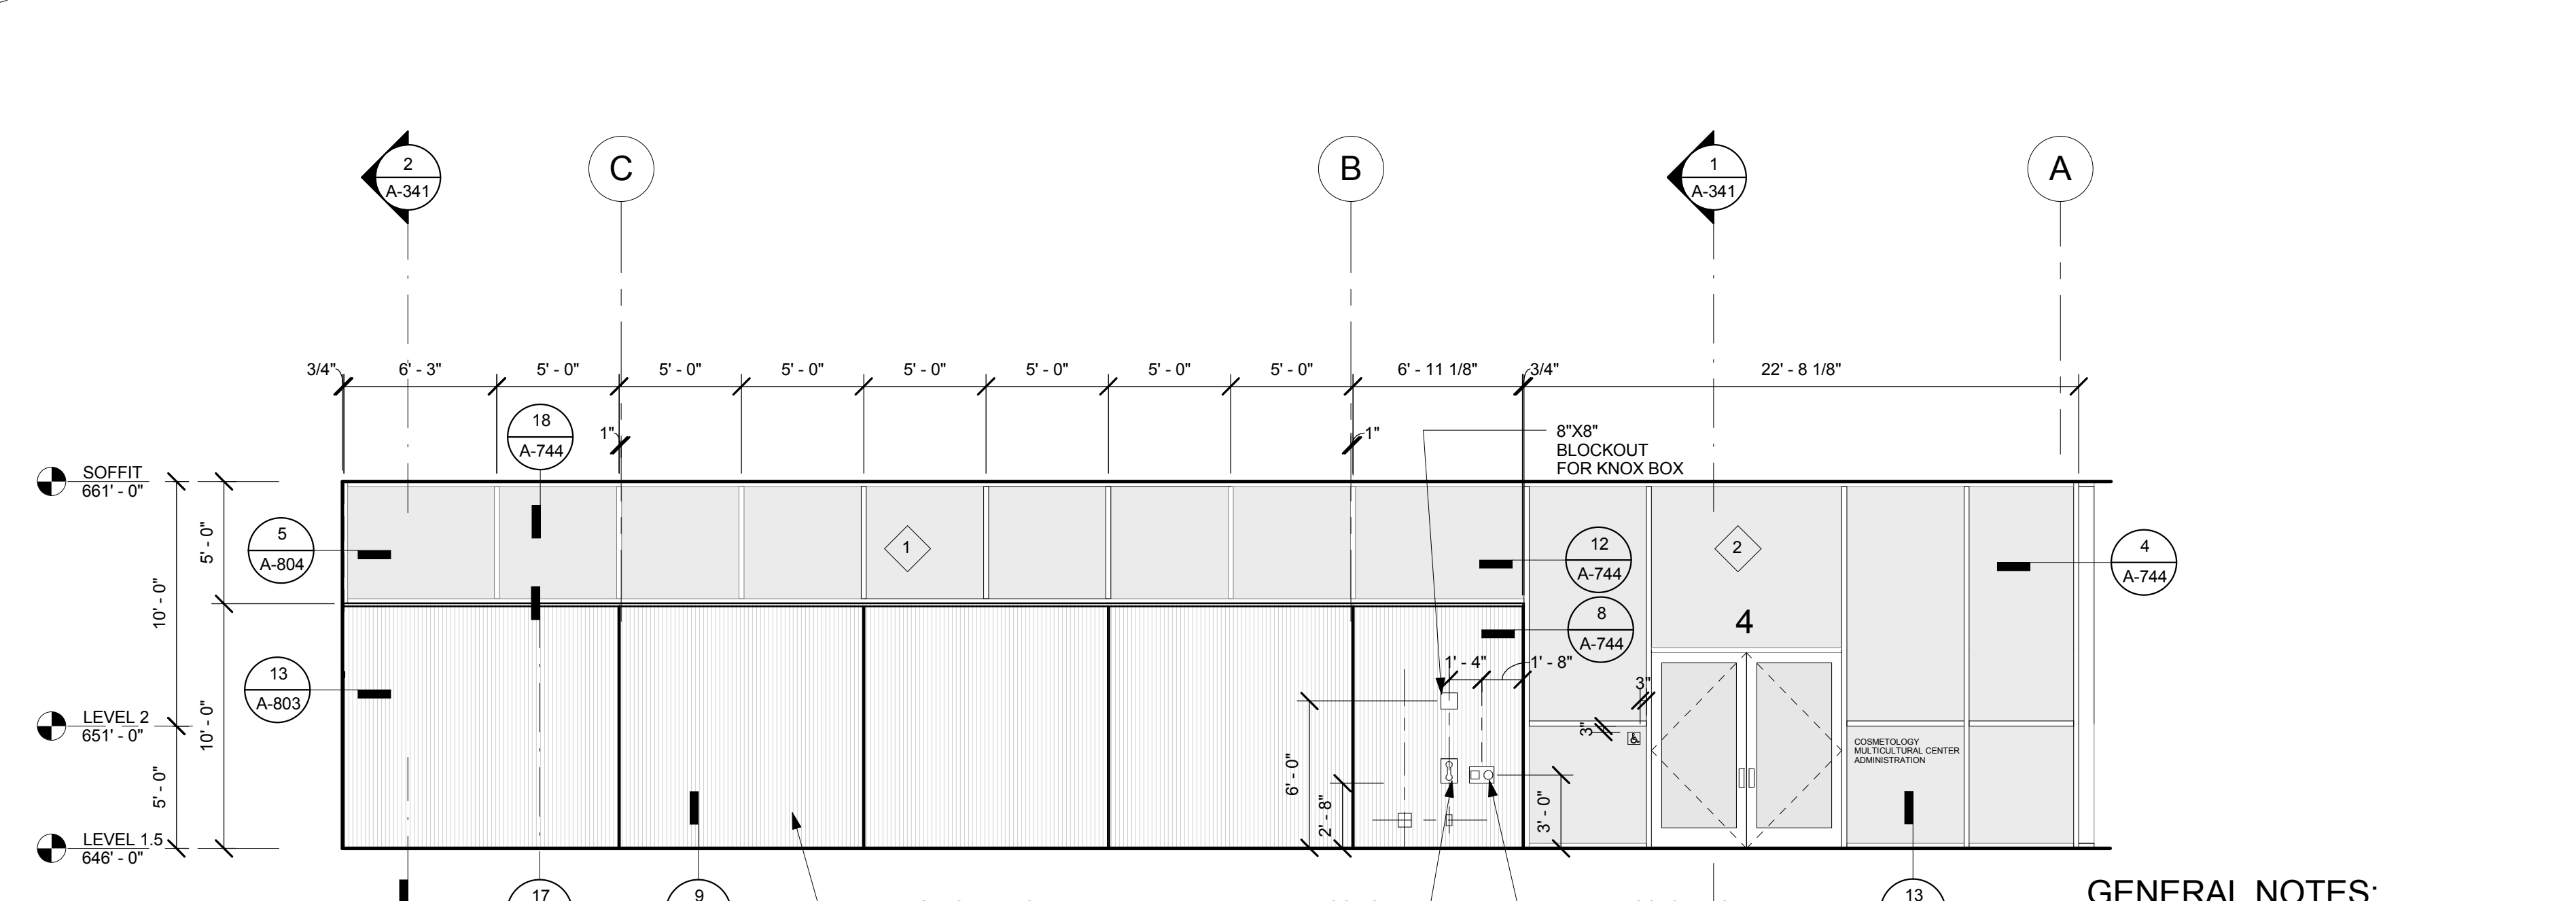

5 NORTH ELEVATION ALONG 12
3/16" = 1'-0"

GENERAL NOTES:

1. SEE A-740 SERIES FOR WINDOW DETAILS

PROJECT RECORD SET

BUILDING 4
SKYLINE COLLEGE
SAN MATEO COUNTY
COMMUNITY COLLEGE
DISTRICT

CIP2 DESIGN-BUILD
PROJECT
BUILDING 4

PROJECT NO.: 07012.00 DRAWN BY: MC
DATE: 06/23/08 CHECKED BY: LG
SCALE: As indicated

SHEET TITLE:
ENLARGED ELEVATIONS

SHEET NO. A-321